




EAST ELEVATION SCALE 1/8"=1'-0"

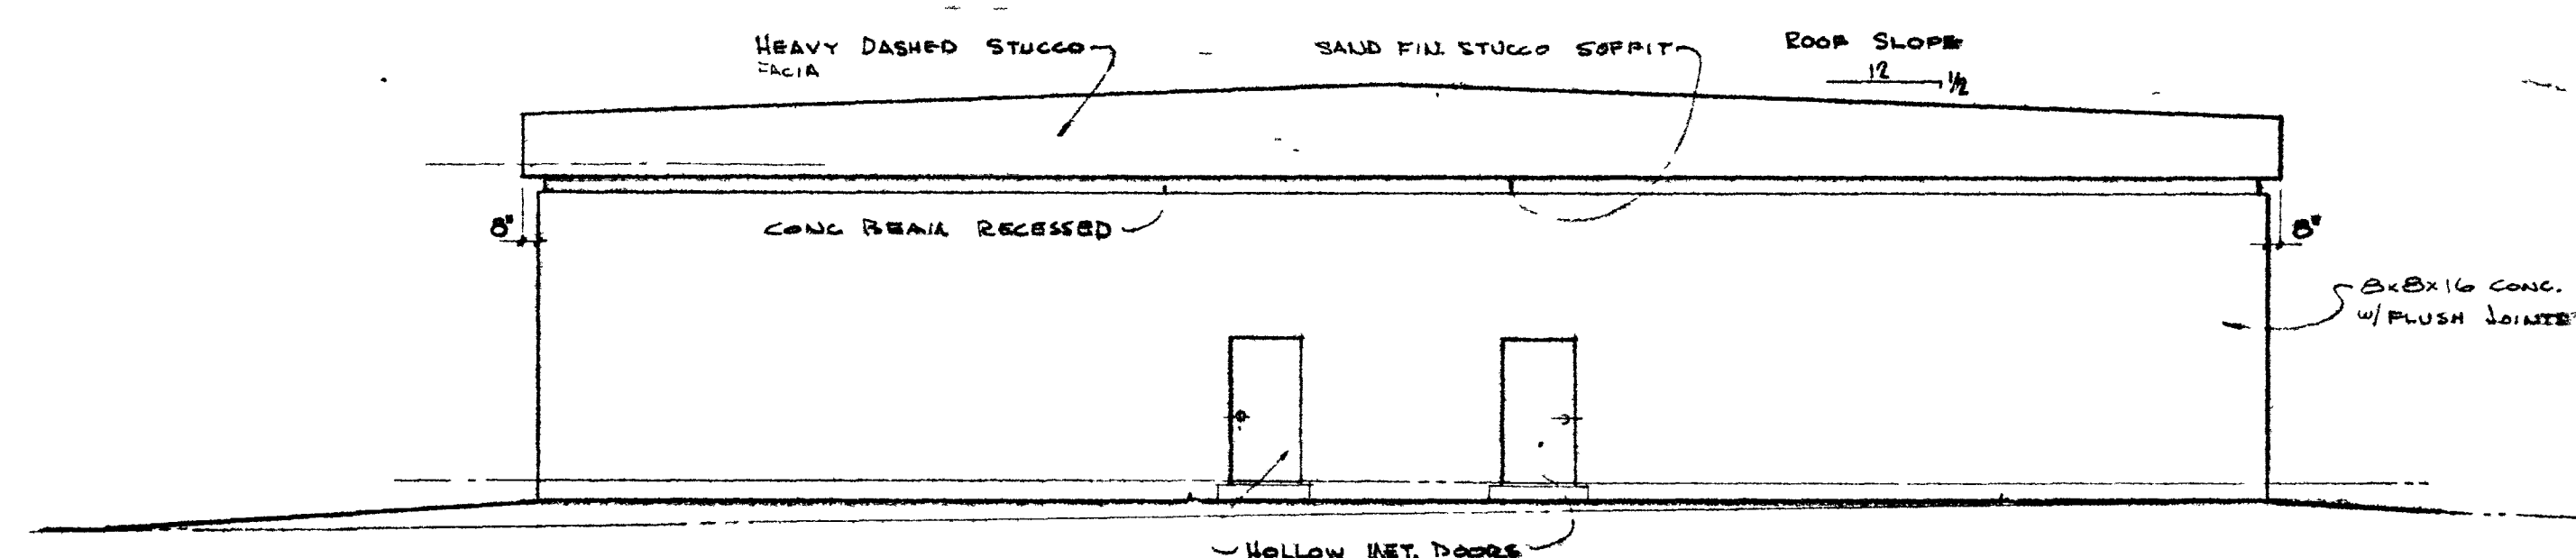

NORTH ELEVATION SCALE 1/8"=1'-0"

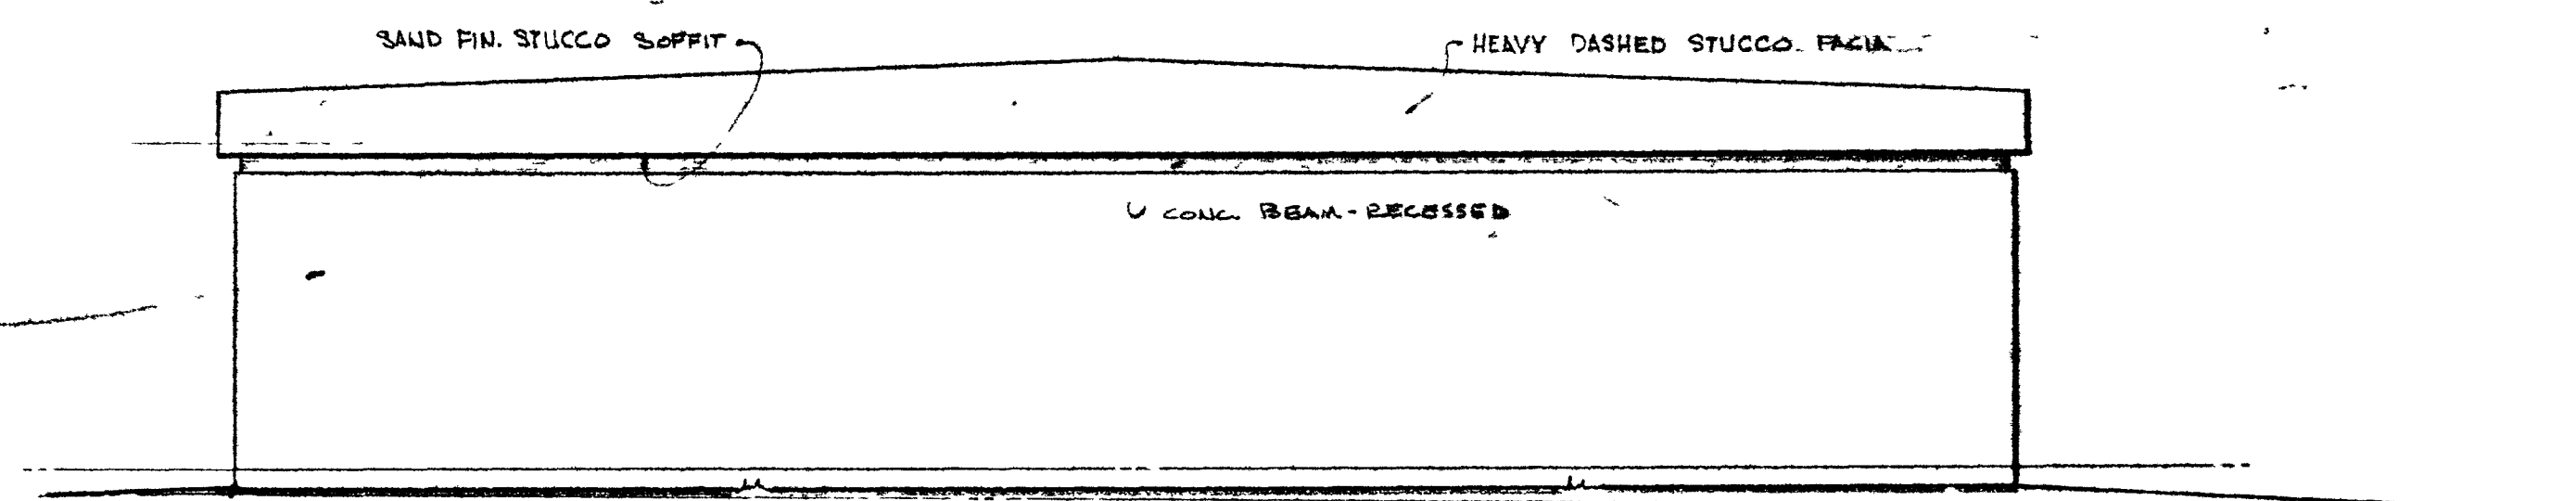

SOUTH ELEVATION SCALE 1/8"=1'-0"

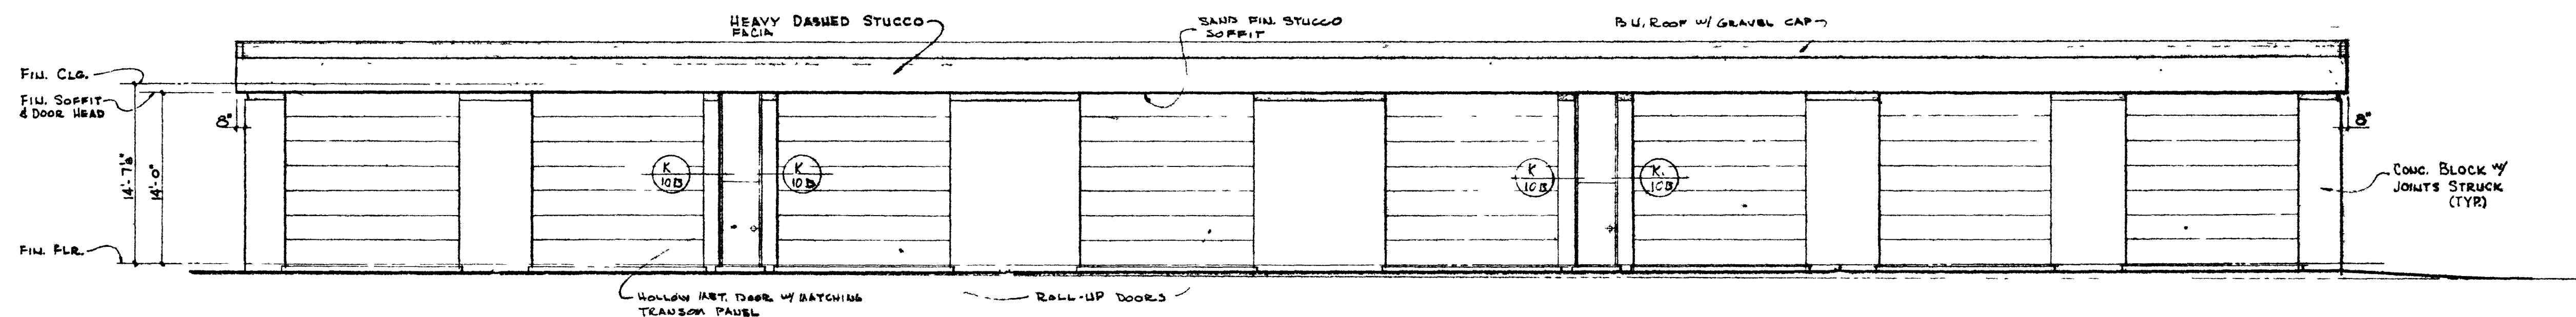

WEST ELEVATION SCALE 1/8"=1'-0"

AS BUILT

AS BUILT DRAWING AS SUBMITTED BY CONTRACTOR (NO CHANGE)

REVISIONS	
1	10 MAY 66
2	
3	
4	
5	
6	
7	
8	

DATE 3-15-66

DRAWN BY A.K.P.

CHECKED BY

JACK T. Borchert
AIA
LAS VEGAS, NEVADA
217 GARCIA AVE.
FOR THE CITY OF LAS VEGAS, NEVADA

SHEET TITLE
EXTERIOR ELEVATIONS
BUILDING "B"
JOB TITLE
CITY YARD FACILITIES

JOB
6510

SHEET
4B

OF 30 TOTAL

522-29

42



EAST ELEVATION



NORTH ELEVATION



SOUTH ELEVATION



WEST ELEVATION

AS BUILT

1	REVISION
2	
3	
EXTERIOR ELEVATIONS
 6510
 4b
 CITY YARD FACILITIES, 1000 1000, CITY OF LAS VEGAS, NEVADA