




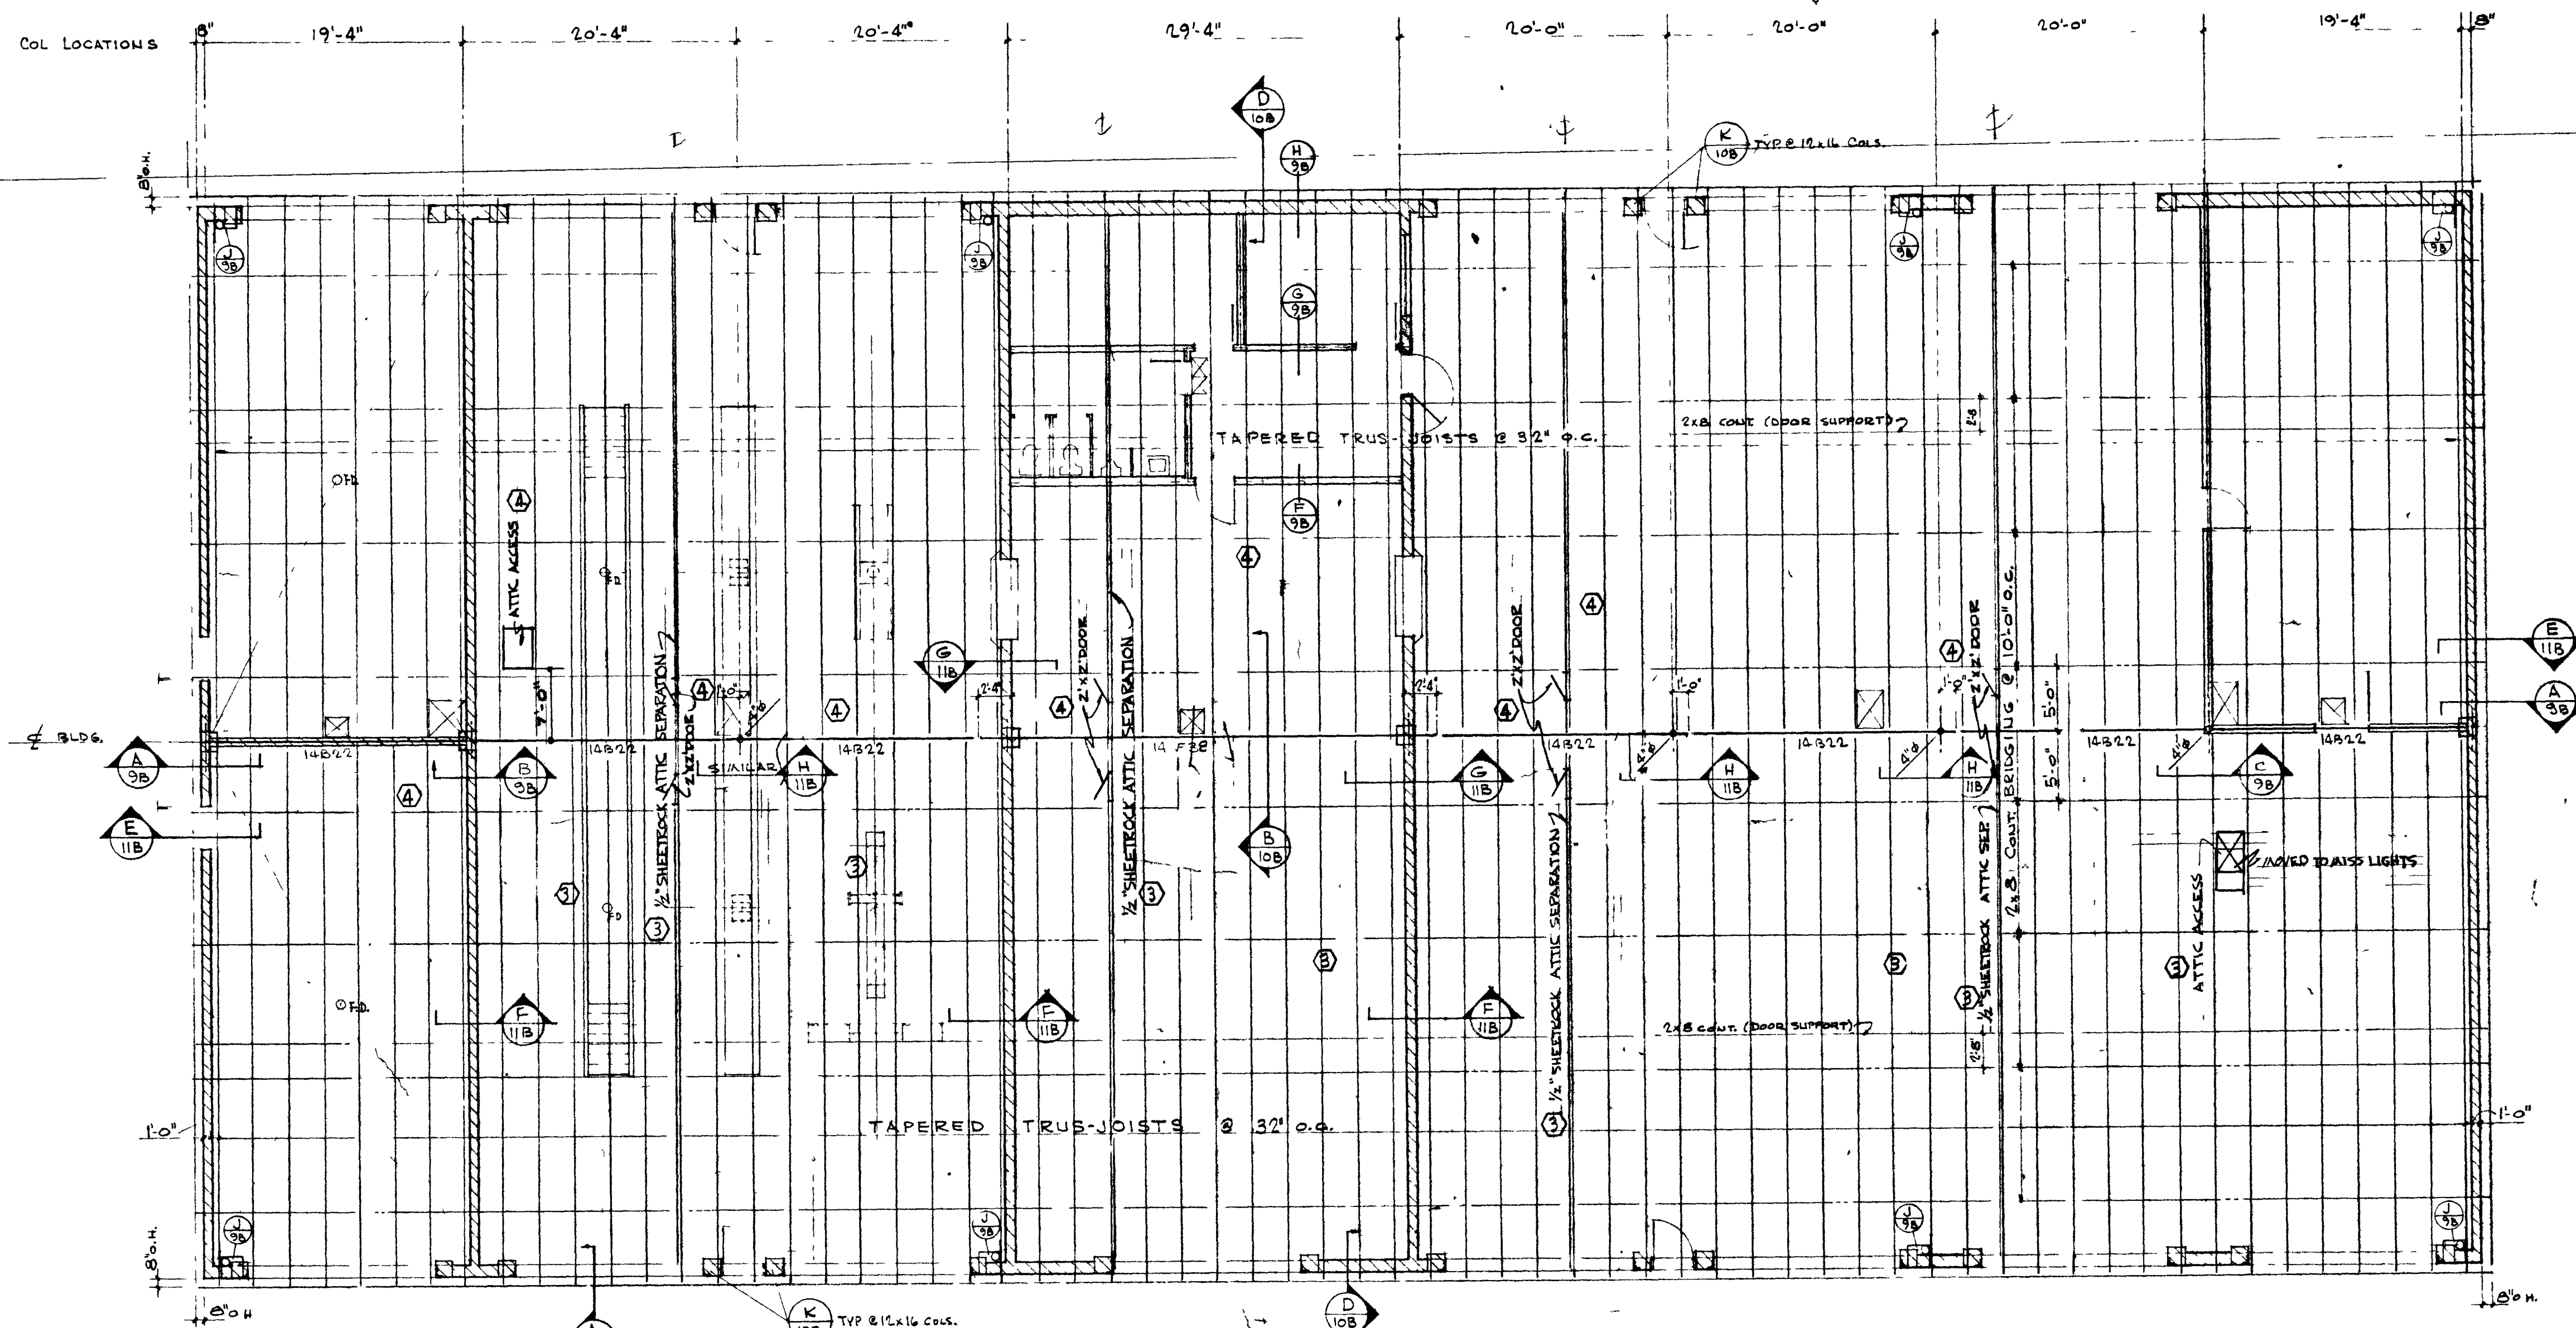

ROOF FRAMING PLAN BUILDING "B"
SCALE: 1/8"=1'-0"

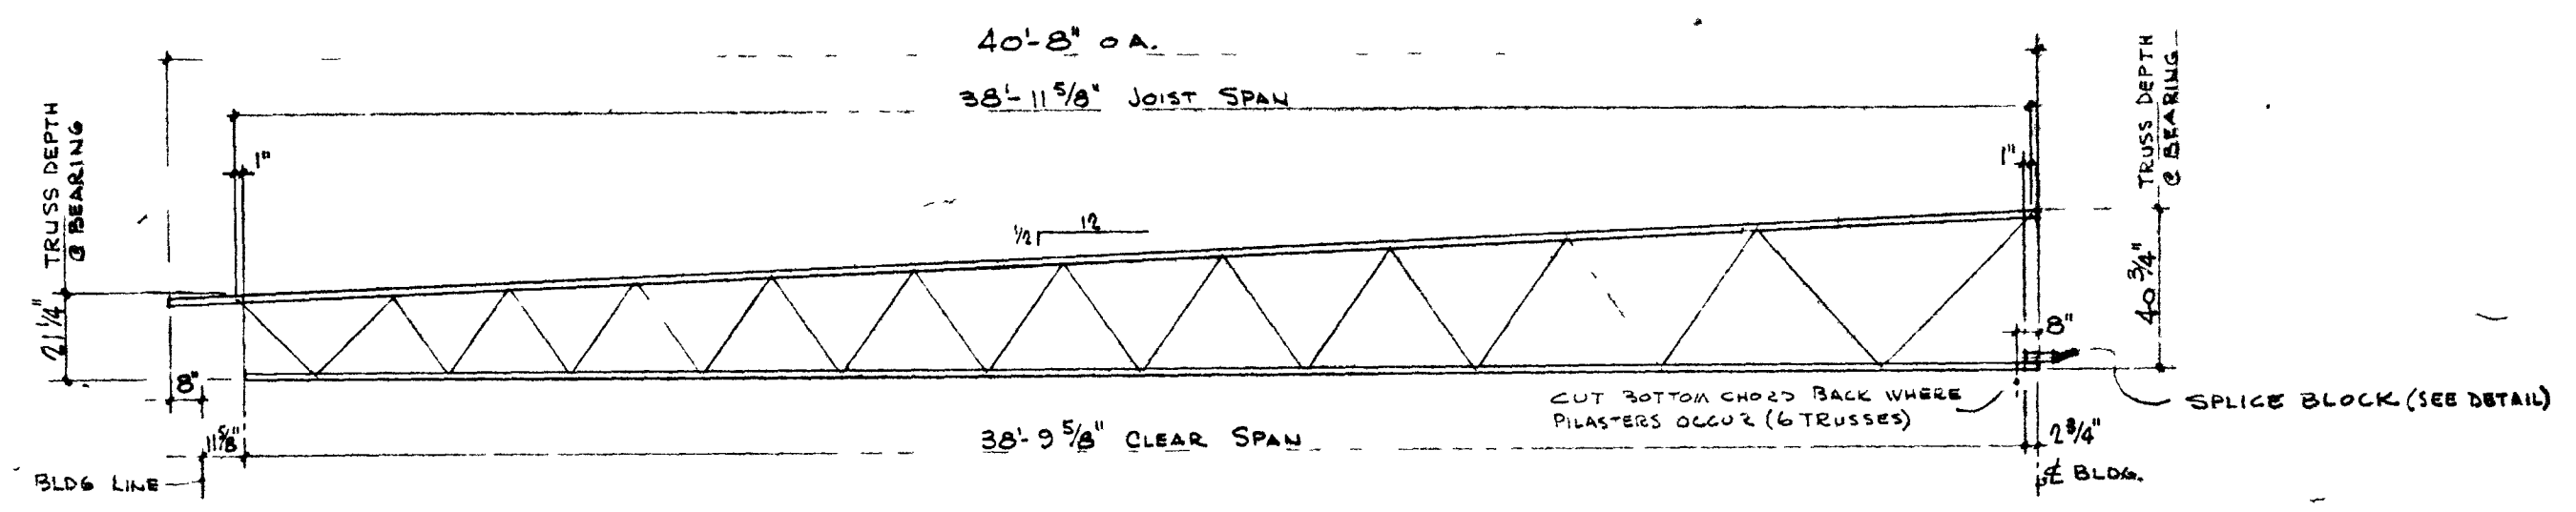

TAPERED TRUS-JOIST DETAIL
SCALE: 1/4"=1'-0"

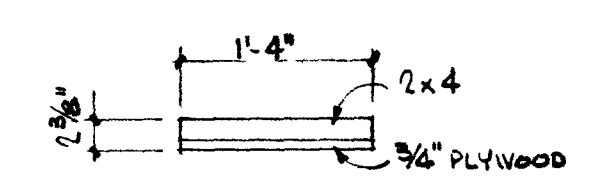

SPLICE BLOCK DETAIL
SCALE: 3/4"=1'-0"

TRUS-JOIST W/FE. TO FURNISH SHOP DRAWINGS & STRUCTURAL LOAD DIAGRAMS & CALCULATIONS.



SPLICE BLOCK TO BE FURN. BY TRUSS JOIST MFR. FOR EX. CONNECTION OF BOTTOM CHORDS & 2x4 BLOC.

AS BUILT

- ③ SEE SHEET 8 A FOR CONST. DETAILS - ACCESS PANELS - ATTIC SEPARATION - 2x2 DOORS
- ④

AS BUILT DRAWING AS SUBMITTED BY CONTRACTOR

REVISIONS	
1	5/6/66
2	26 MAY 66
③	ADD ATTIC SEP. & ACCESS PANELS
④	REVISE REVISION ③
5	
6	
7	
8	
DATE 3-15-66	
DRAWN BY AKP	
CHECKED BY	
SHEET TITLE ROOF FRAMING PLAN	
JOB TITLE CITY YARD FACILITIES	
DRAWN BY JACK T. Belcher A.I.A.	
FOR THE CITY OF LAS VEGAS, NEVADA	
217 GARCES AVE. 355-1464 LAS VEGAS, NEVADA	
JOB	6510
SHEET	8B
OF 30 TOTAL	
522-29	

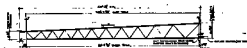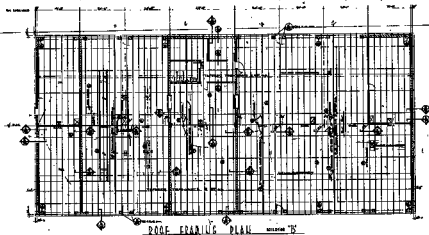

SEE SHEET 10 FOR
DETAILS OF
TRUSS JOINTS

AS BUILT

1	2	3	100
---	---	---	---	---	---	---	---	---	----	----	-----

ROOF FRAMING PLAN

CITY YARD FACILITIES TO THE CITY OF LAS VEGAS, NEVADA

8510

06