




| REVISIONS   |                             |
|-------------|-----------------------------|
| 1           | 26 MAY 66                   |
| 2           | ADD BLOCK VENEER / DOOR     |
| 3           | ADD BLOCK VENEER / PILASTER |
| 4           |                             |
| 5           |                             |
| 6           |                             |
| 7           |                             |
| 8           |                             |
| DATE        |                             |
| 3-15-66     |                             |
| DRAWN BY    |                             |
| AKP         |                             |
| CHECKED BY  |                             |
|             |                             |
| JOB         |                             |
| 6510        |                             |
| SHEET       |                             |
| 6B          |                             |
| OF 30 TOTAL |                             |

JACK T. BELCHER  
 ARCHT.  
 LAS VEGAS, NEVADA  
 217 GARCES AVE.  
 BUILDING "B"  
 CITY YARD FACILITIES FOR THE CITY OF LAS VEGAS, NEVADA  
 522-29

AS BUILT DRAWING AS SUBMITTED BY CONTRACTOR (NO CHANGE)

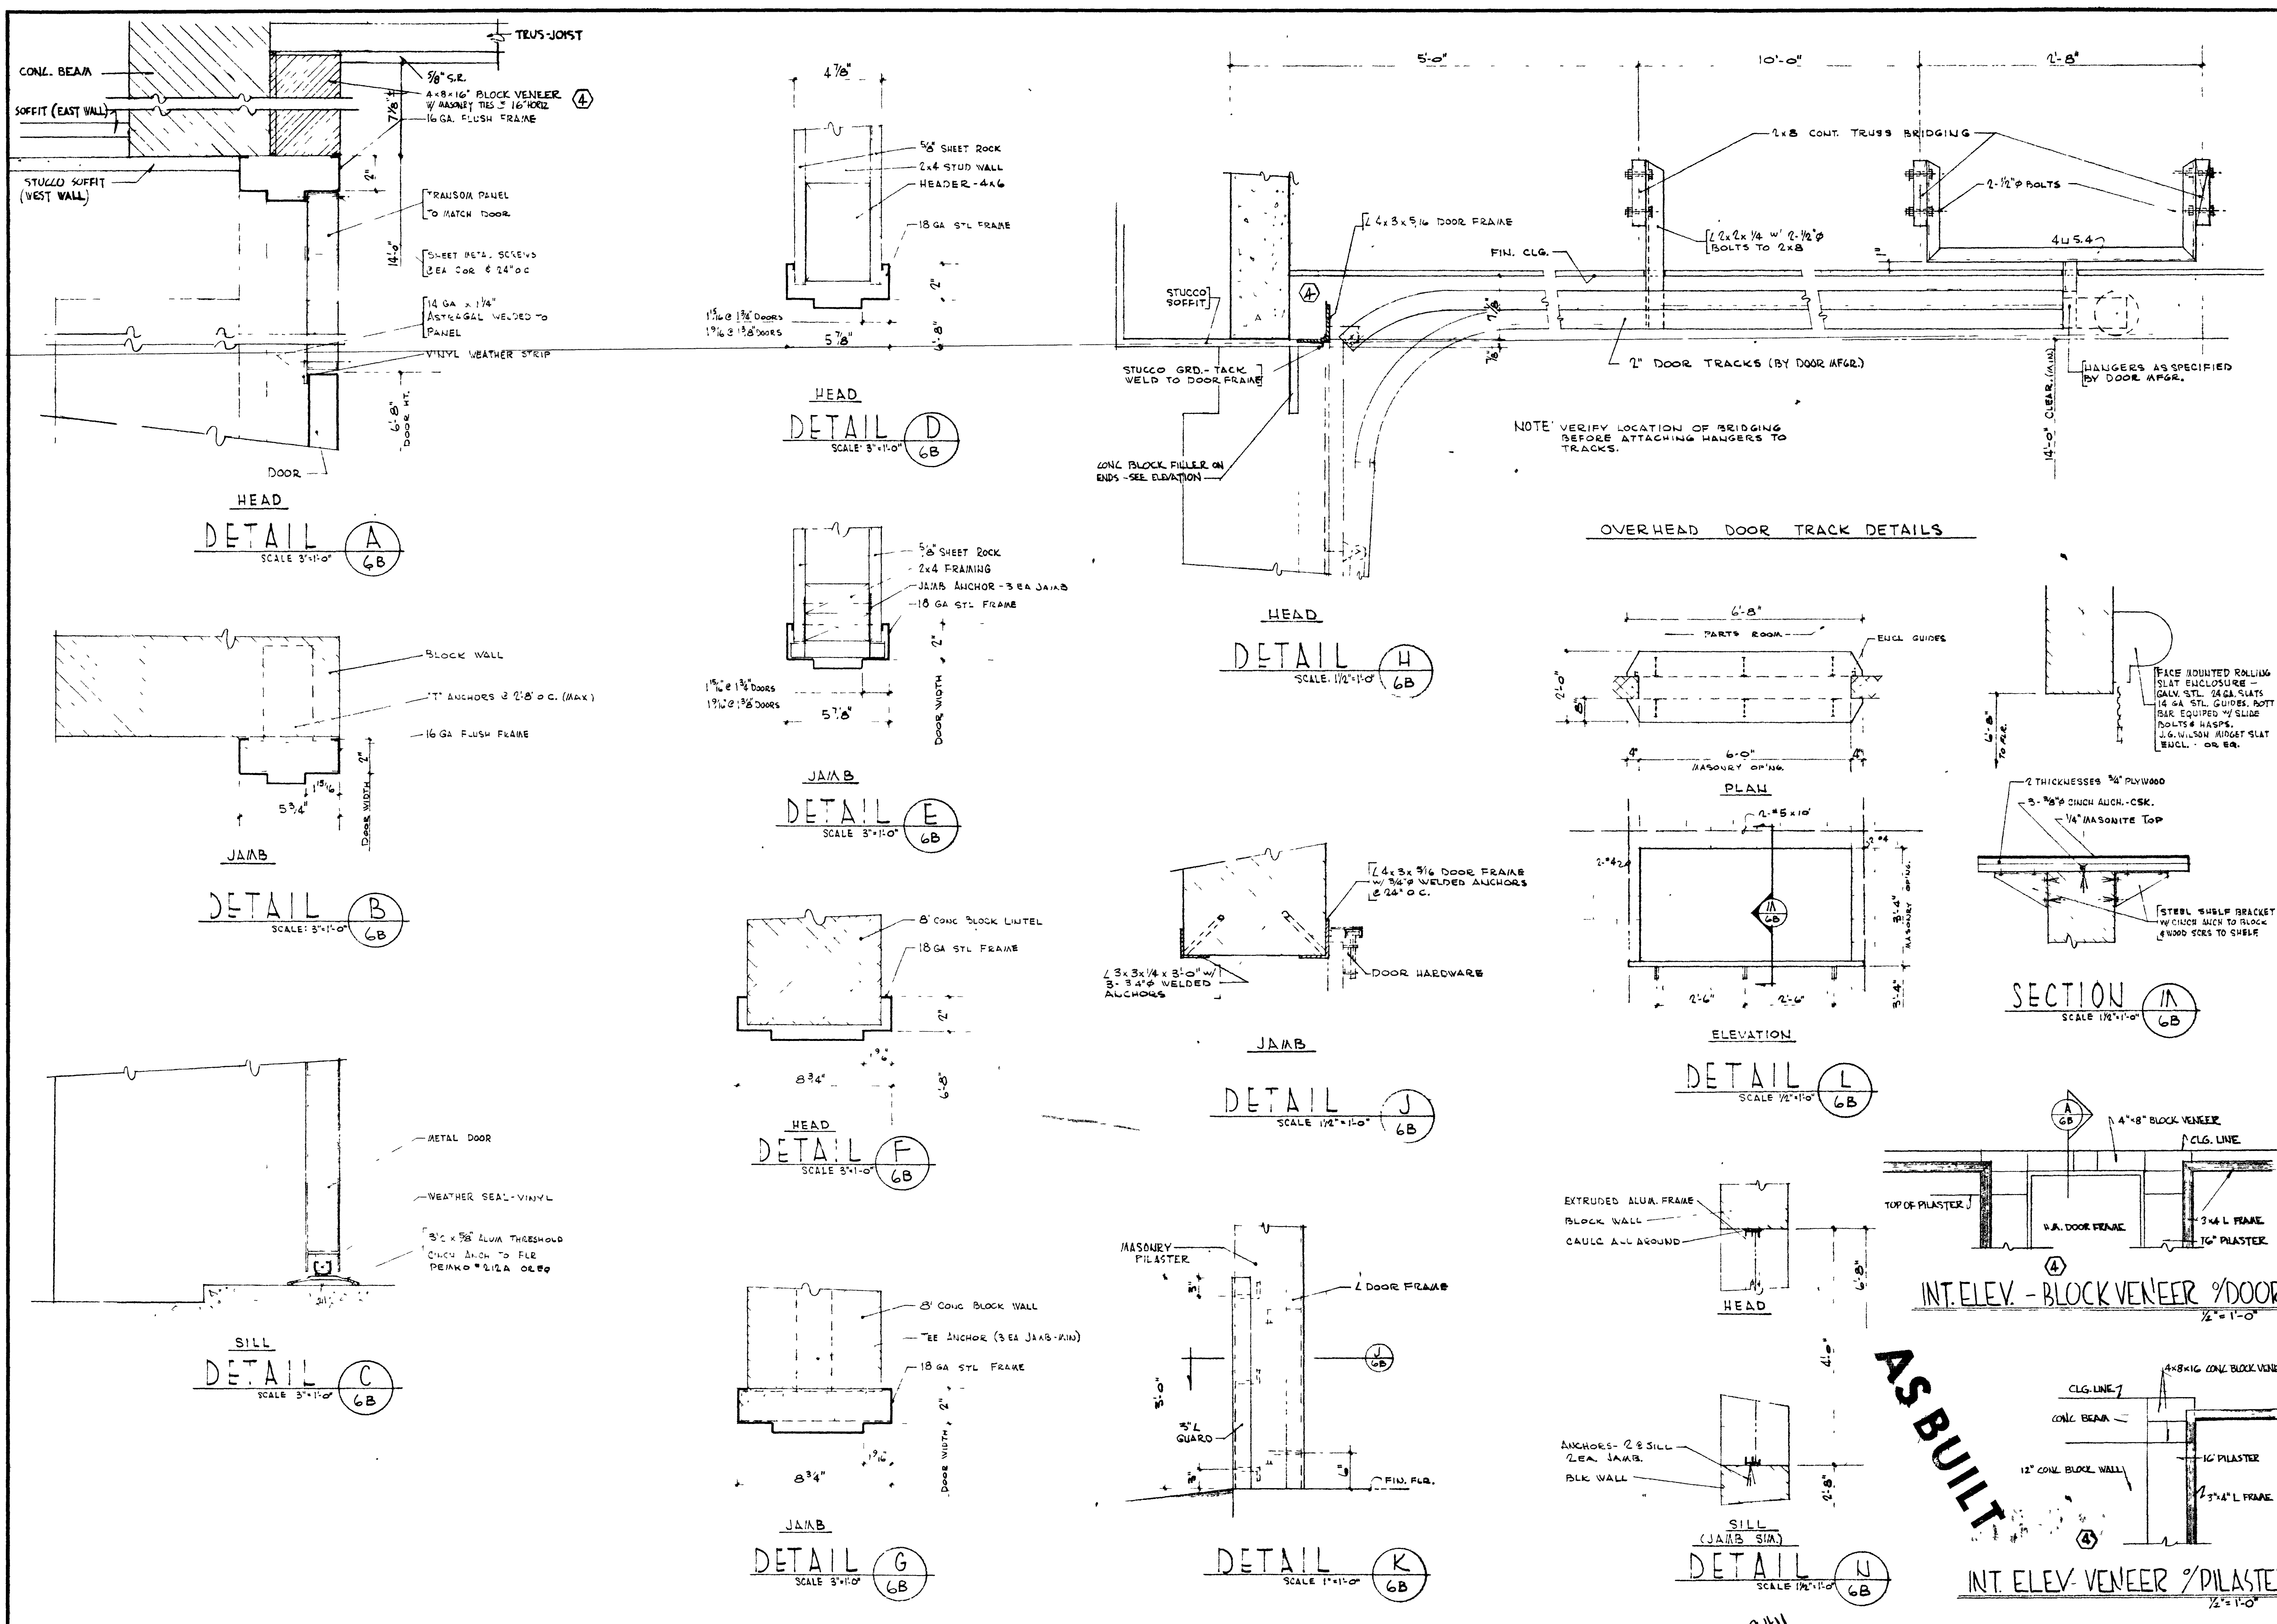