
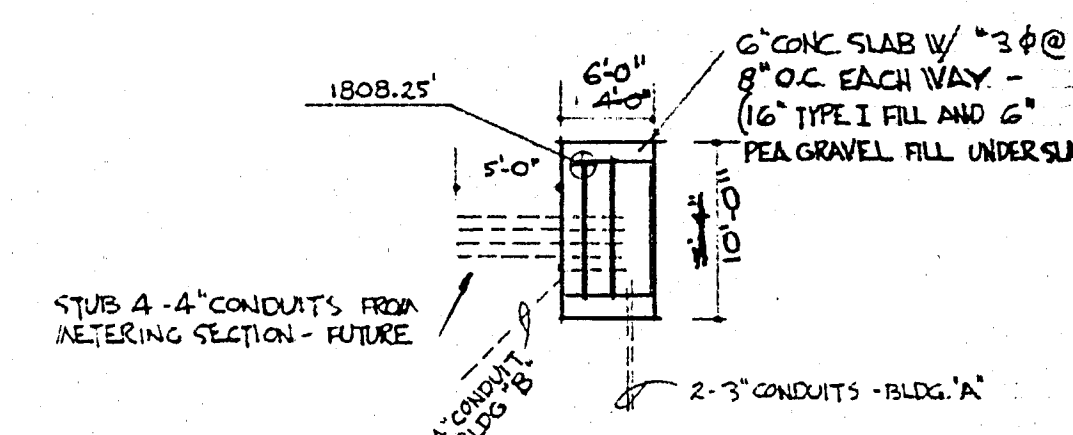
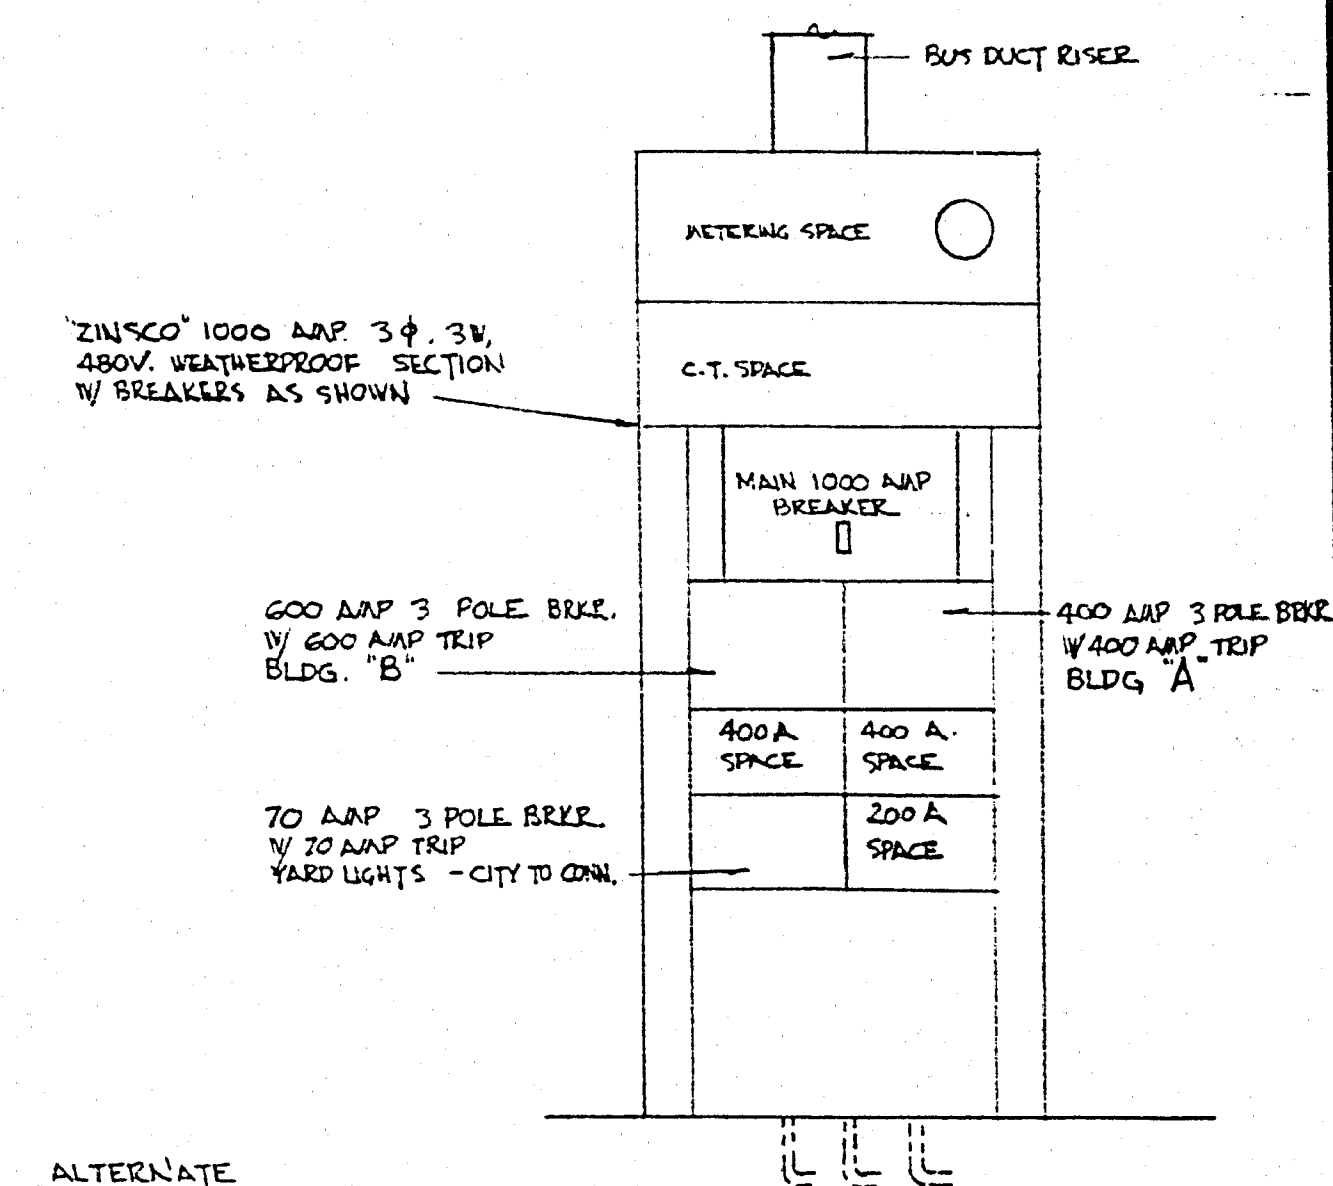


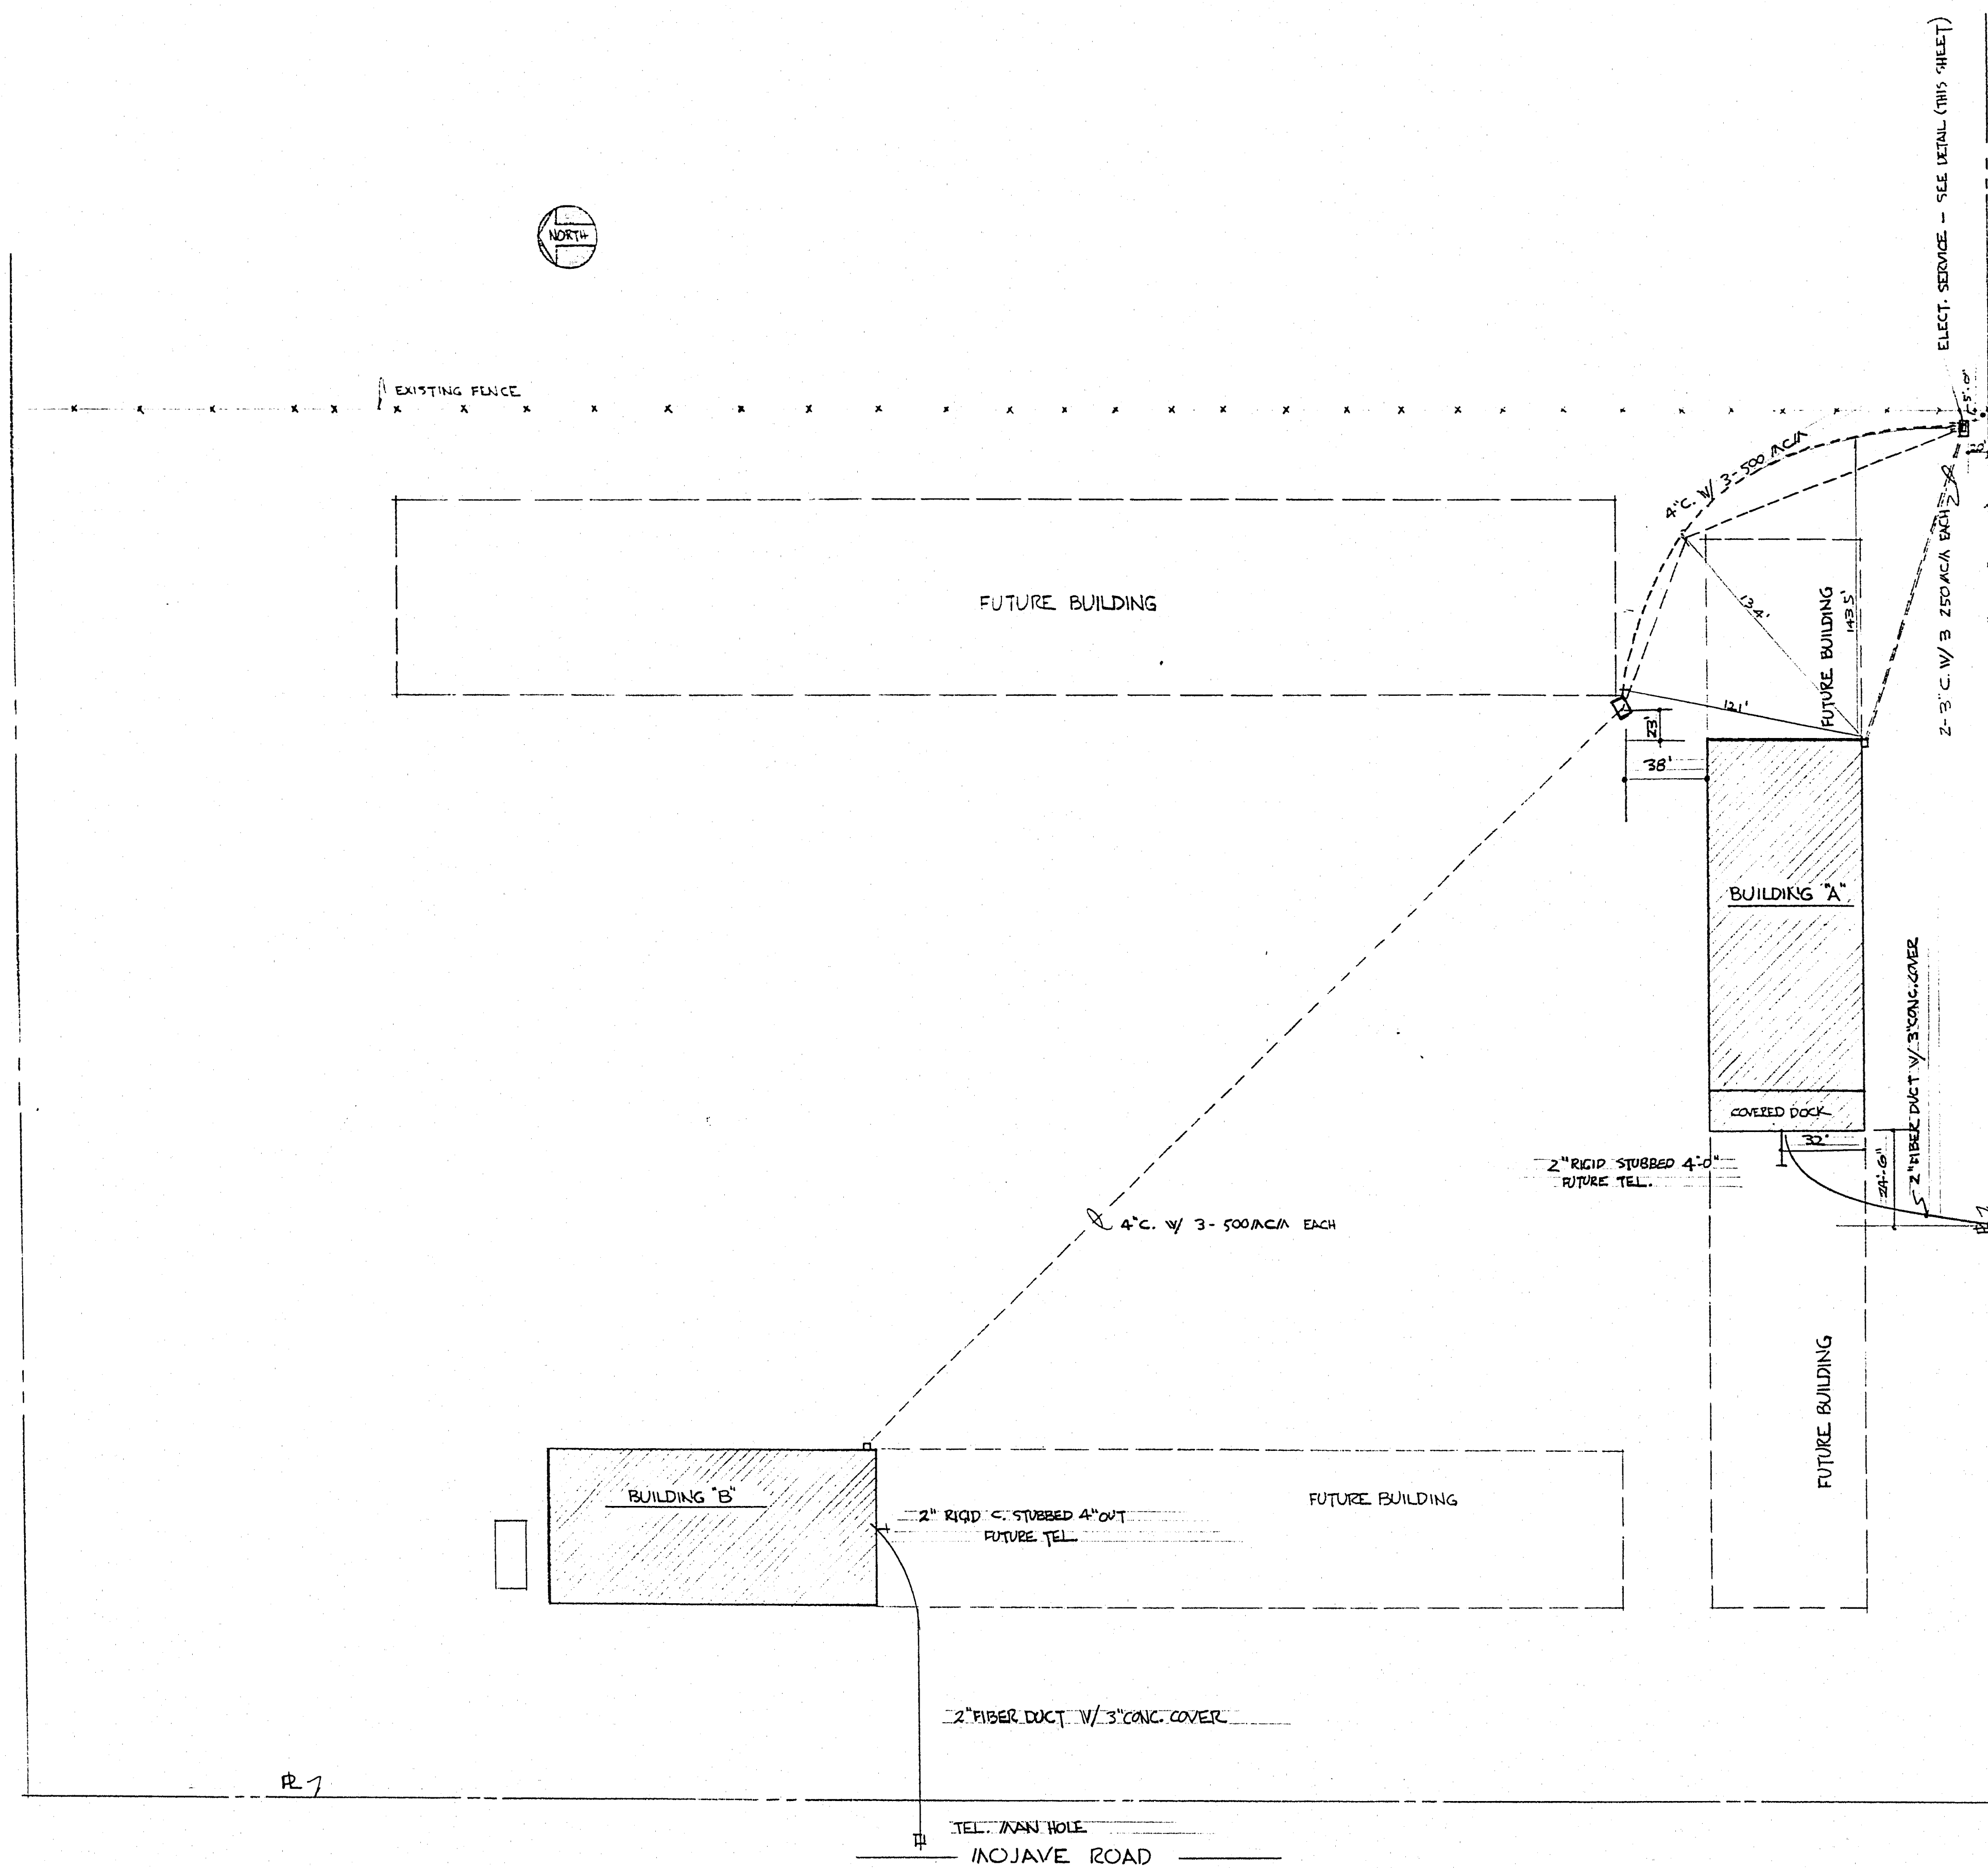

AS BUILT

REVISIONS	
①	29-12-10
2	
3	
4	
5	
6	
7	
8	
DATE 10-21-66	
DRAWN BY _____	
CHECKED BY _____	
SHEET TITLE PLOT PLAN - ELECTRICAL DISTRIBUTION	JACK T. B 217 GARCES AVE. J.A.C.B. 385-1464 LAS VEGAS, NEVADA CITY OF LAS VEGAS, NEVADA
JOB 6510	JOB TITLE CITY YARD FACILITIES FOR THE
SHEET I-E	OF