

REVISIONS	
1	5/6/66
2	10/1/66
3	
4	
5	
6	
7	
8	

DATE
3-15-66

DRAWN BY
LD/AP

CHECKED BY
P.

JACK T. Borchert
LAS VEGAS, NEVADA

FOUNDATION PLAN
BUILDING "A"


JACK T. Borchert
217 GARCES AVE.
LAS VEGAS, NEVADA

CITY YARD FACILITIES FOR THE CITY OF LAS VEGAS, NEVADA

JOB
6510

SHEET
2A







OF 30 TOTAL

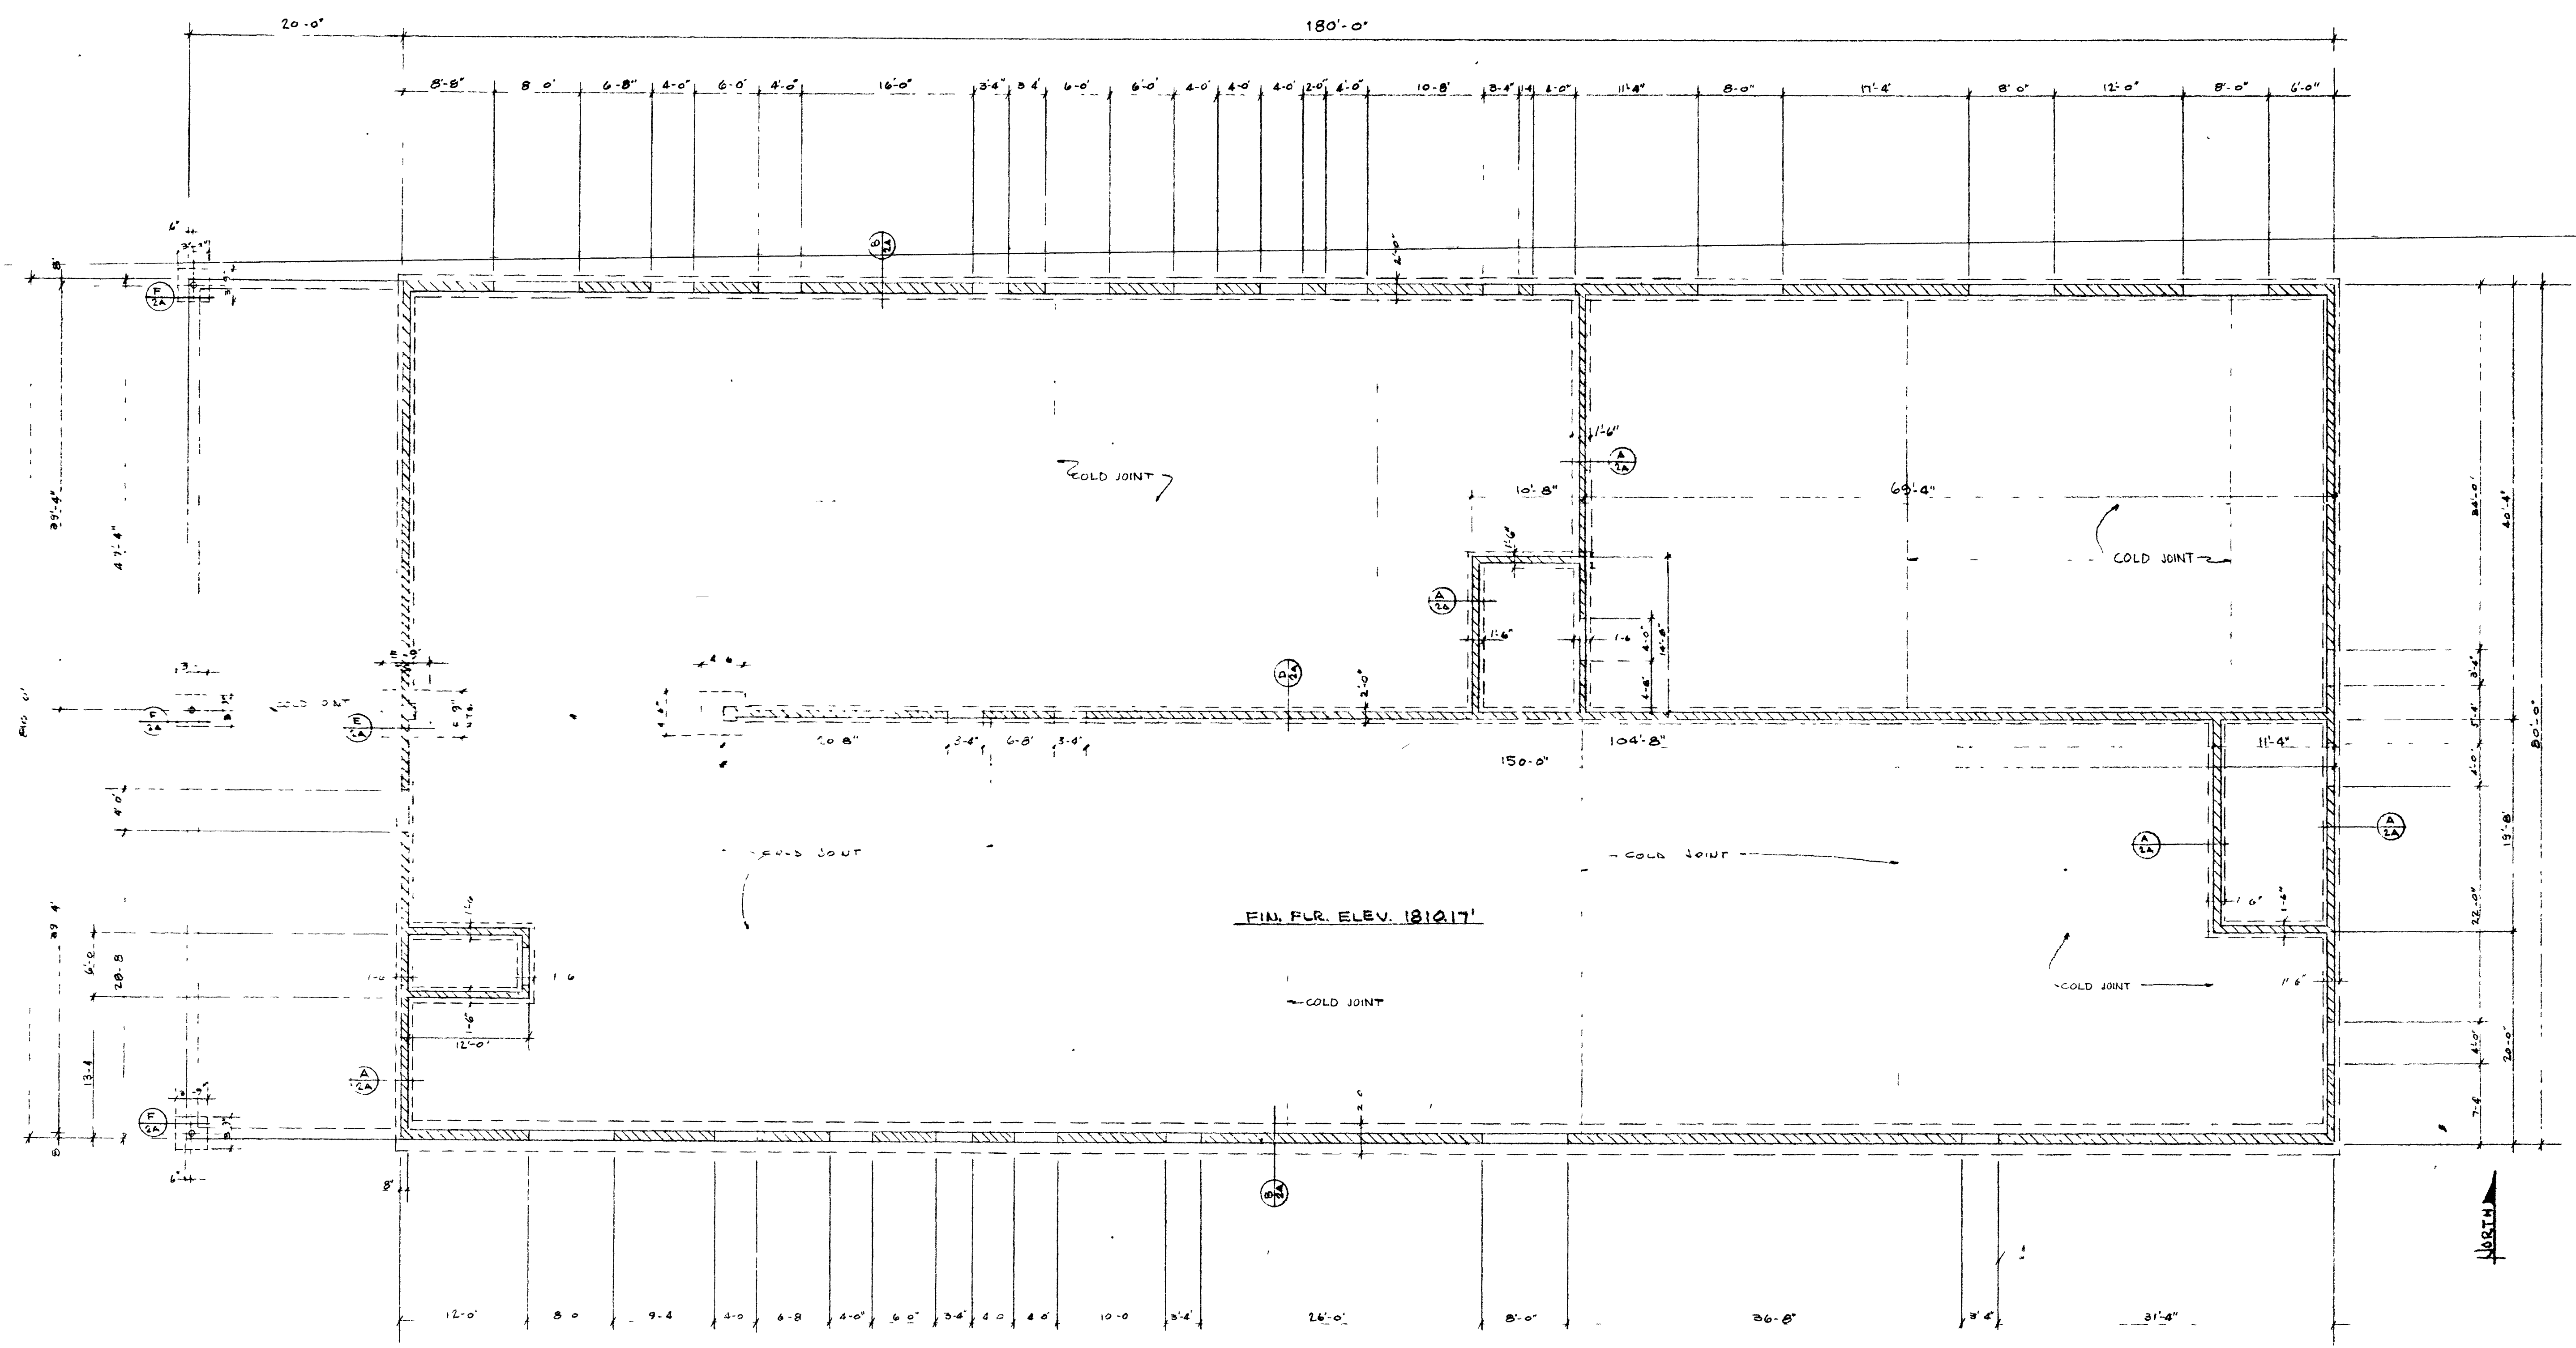

FOUNDATION PLAN
SCALE 1/8" = 1'-0"

AS BUILT


NOTE:
BOTTOM OF FOOTINGS TO BE 1'-2" MIN.
ABOVE BASE OF COMPACTED GRAVEL FILL (N.I.C.)
FOOTING EXCAVATIONS TO BE TAMPED
W/ TAMPING MACHINE TO INSURE COMPACTION
TO MIN 95% DRY DENSITY

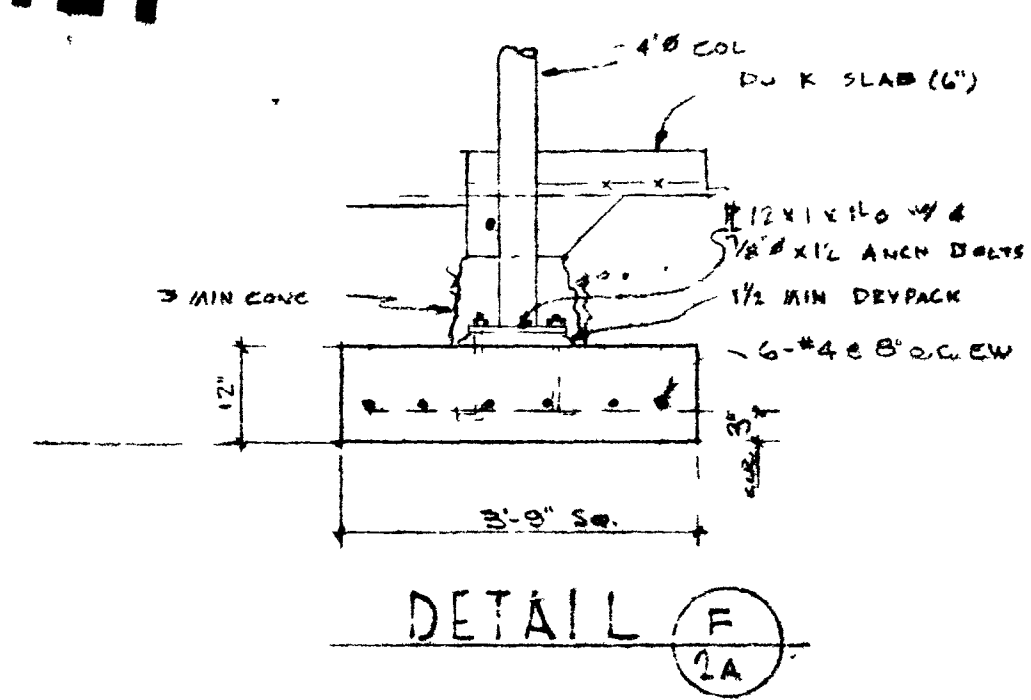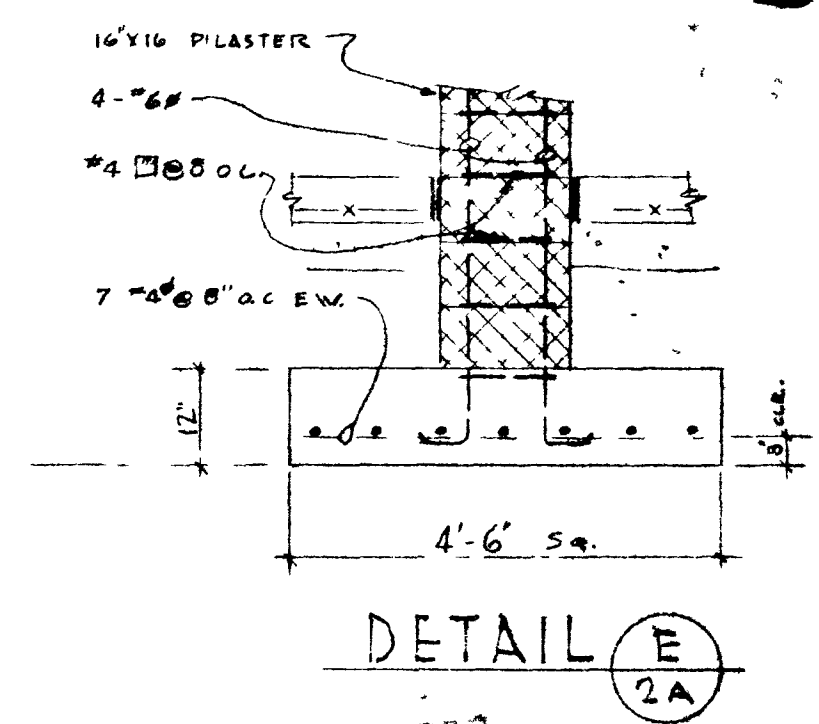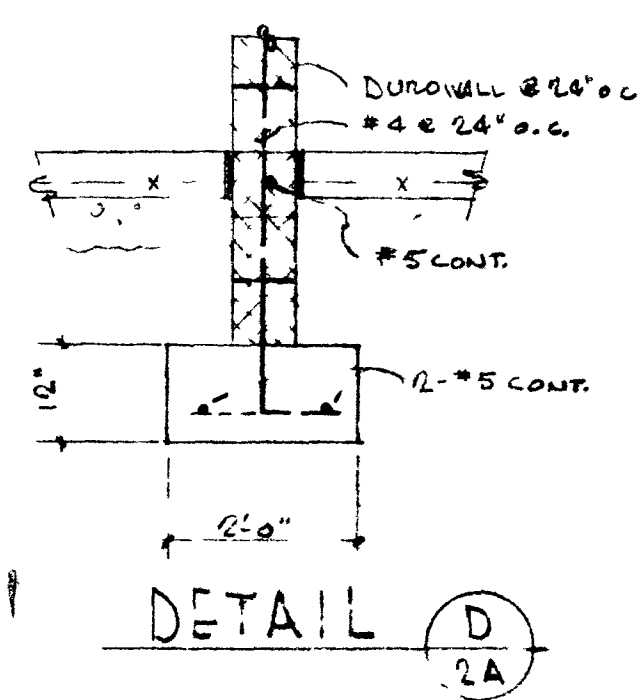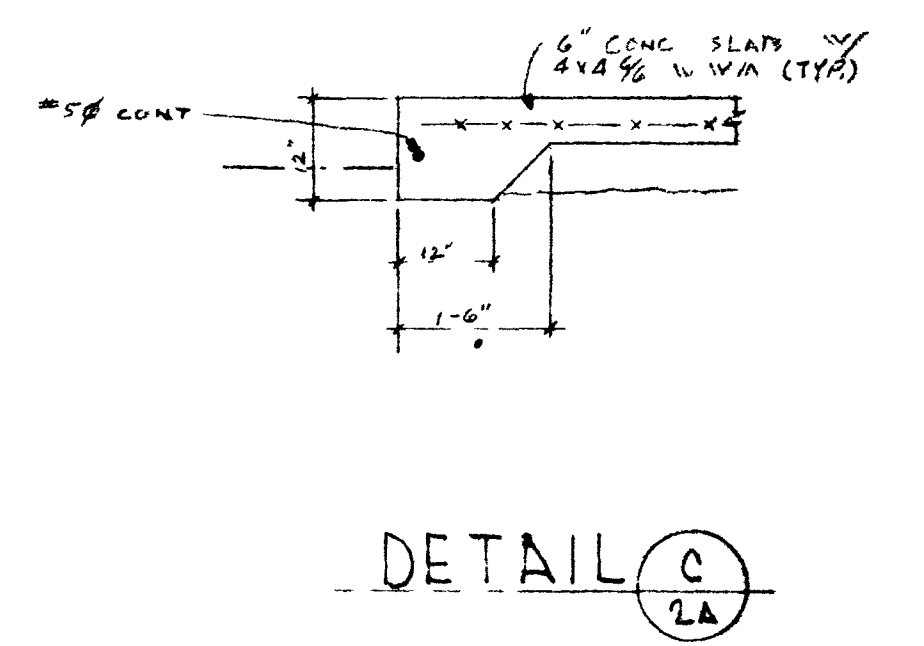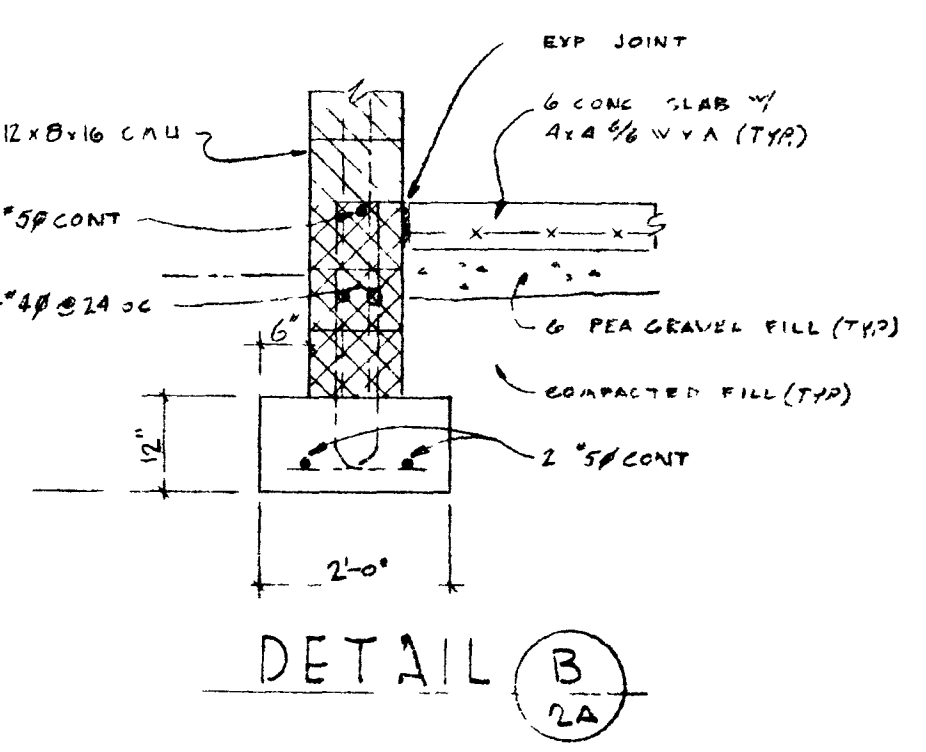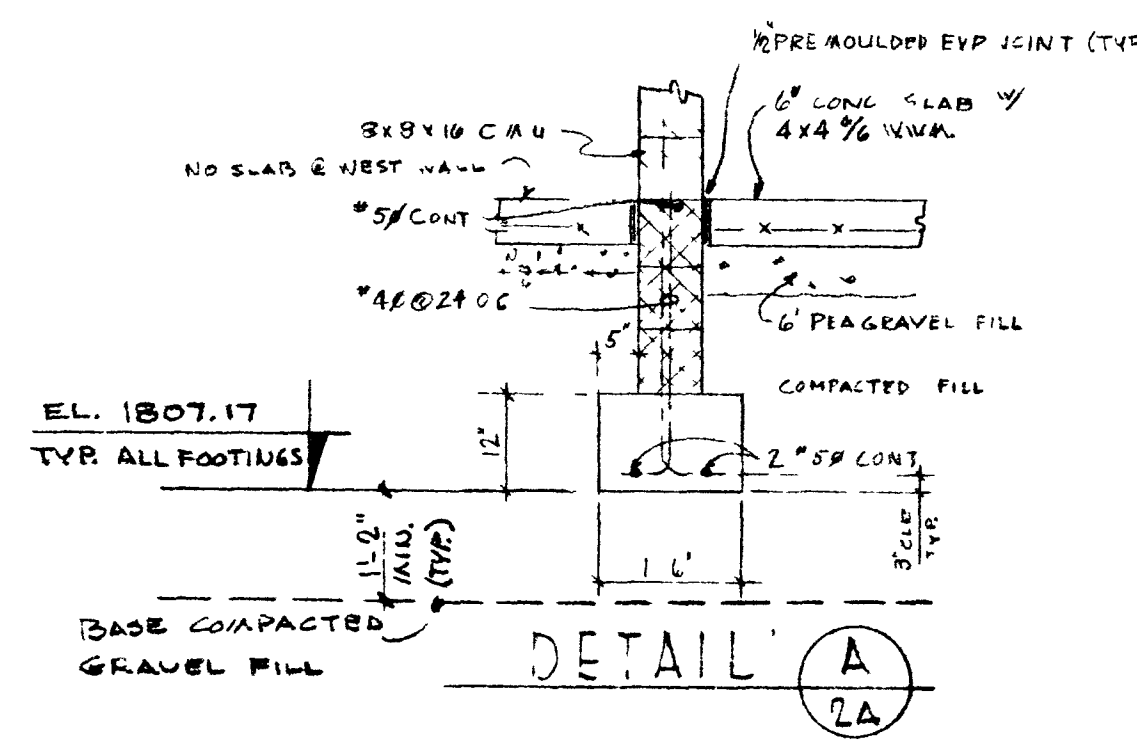


SCALE - 1/8" = 1'-0"

4428

AS BUILT BY CONTRACTOR (NO CHANGE) 522-29

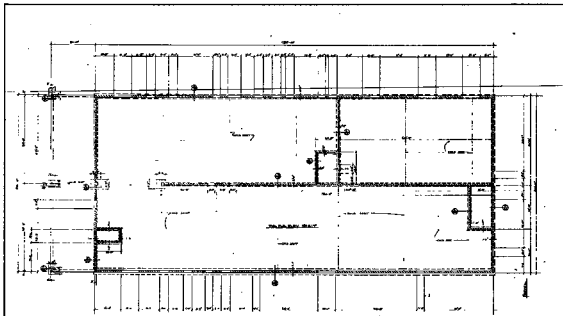

FOUNDATION PLAN

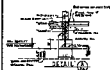

AS BUILT

NOTES: 1. FOUNDATION SHALL BE CONCRETE. 2. REINFORCEMENT SHALL BE STEEL. 3. ALL DIMENSIONS SHALL BE IN FEET AND INCHES. 4. ALL DIMENSIONS SHALL BE TO FACE UNLESS OTHERWISE NOTED.

PROJECT NO.	532-27
DATE	10/1/54
BY	J. H. HARRIS
CHECKED BY	J. H. HARRIS
APPROVED BY	J. H. HARRIS
FOUNDER	PLAS
LOCATION	CITY OF LAS VEGAS, NEVADA
NO.	B510
2A	