


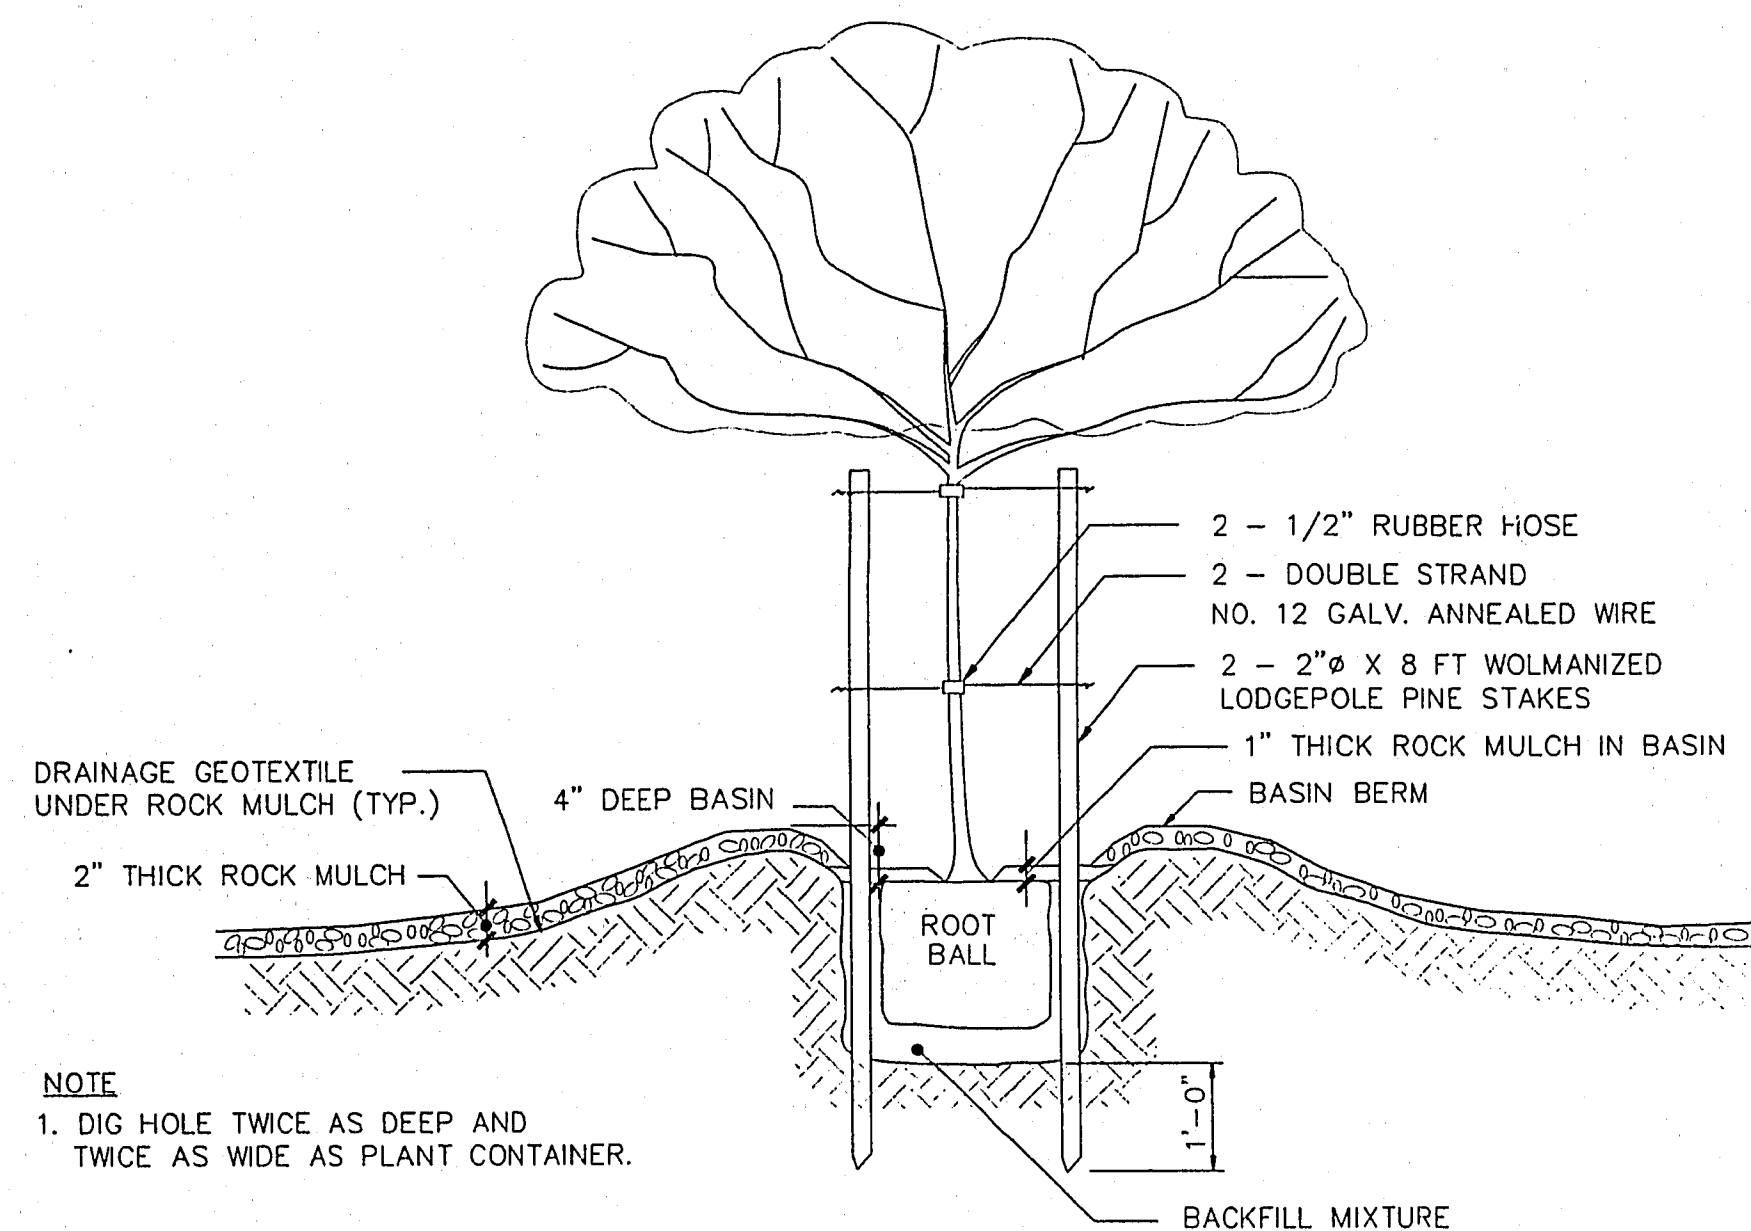

NOTE
1. DIG HOLE TWICE AS DEEP AND
TWICE AS WIDE AS PLANT CONTAINER.

TREE PLANTING DETAIL
NOT TO SCALE

LEGEND

TREES


	SIZE	QUANTITIES
PROSOPIS JULIFLORA ARIZONA HONEY MESQUITE	24" BOX	7 EA.

SHRUBS


	SIZE	QUANTITIES
LANTANA MONTEVIDENSIS TRAILING LANTANA	1 GAL	21 EA.
BACCHARIS X 'CENTENIAL' PROSTRATE BROOM	1 GAL	54 EA.
LEUCOPHYLLUM FRUTESCENS 'COMPACTA'	5 GAL	14 EA.
LEUCOPHYLLUM FRUTESCENS 'GREEN CLOUD'	5 GAL	15 EA.

ROCK


LANDSCAPE BOULDERS	2' Ø	30 EA.
RIVER ROCK, 2" DEEP (ROCK TO COVER ENTIRE LANDSCAPE AREA)	1/2" Ø	3020 SQ. FT.
PVC PIPE, SCH. 40		
HARDIE 1" ELECTRIC CONTROL VALVE 700-1 W/ METER BOX OR APPROVED EQUAL		
BACKFLOW PREVENTION ASSEMBLY, REDUCED PRESSURE PRINCIPLE ASSEMBLY PER L.V.V.W.D. STD. PLT. #11		
BOWSMITH 2 GPH L SERIES EMITTER S20-L OR APPROVED EQUAL		
AGRICULTURAL PRODUCTS 1/2" IPS PVC FLEX HOSE		

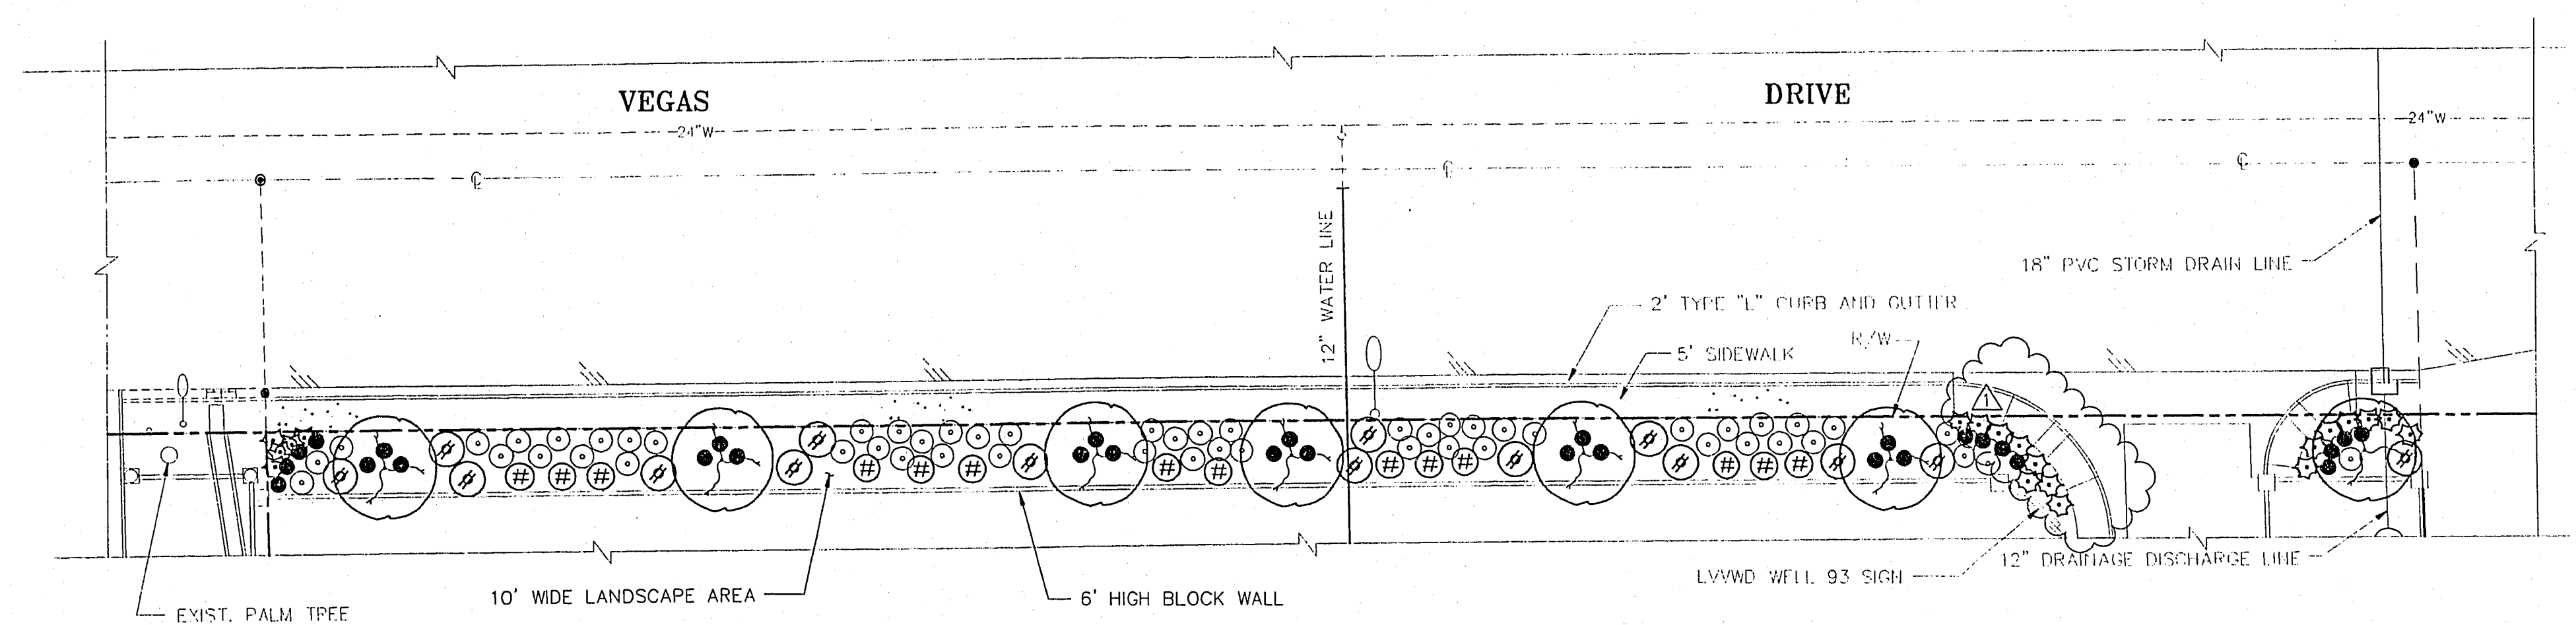


LANDSCAPE PLAN
SCALE: 1" = 20'

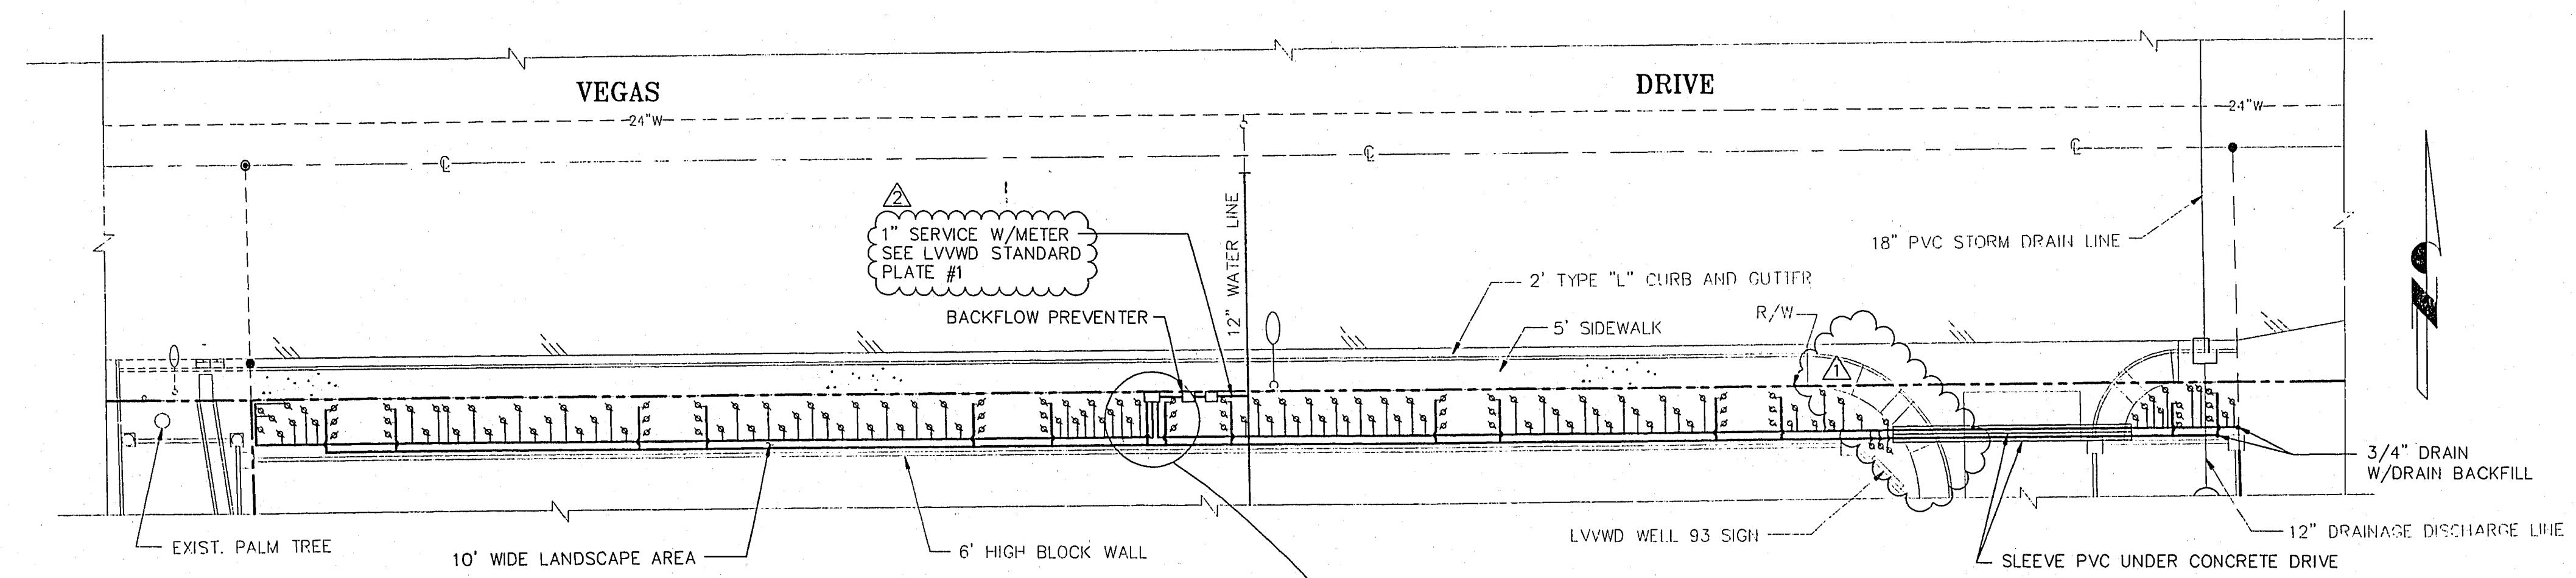

IRRIGATION PLAN
SCALE: 1" = 20'

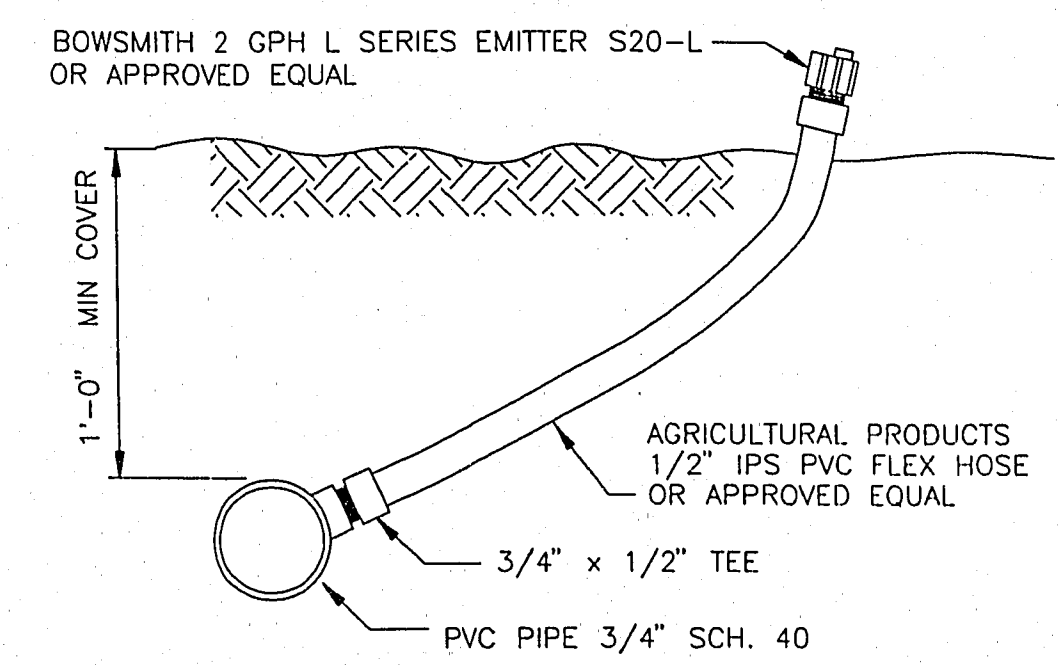

EMITTER DETAIL
NO SCALE

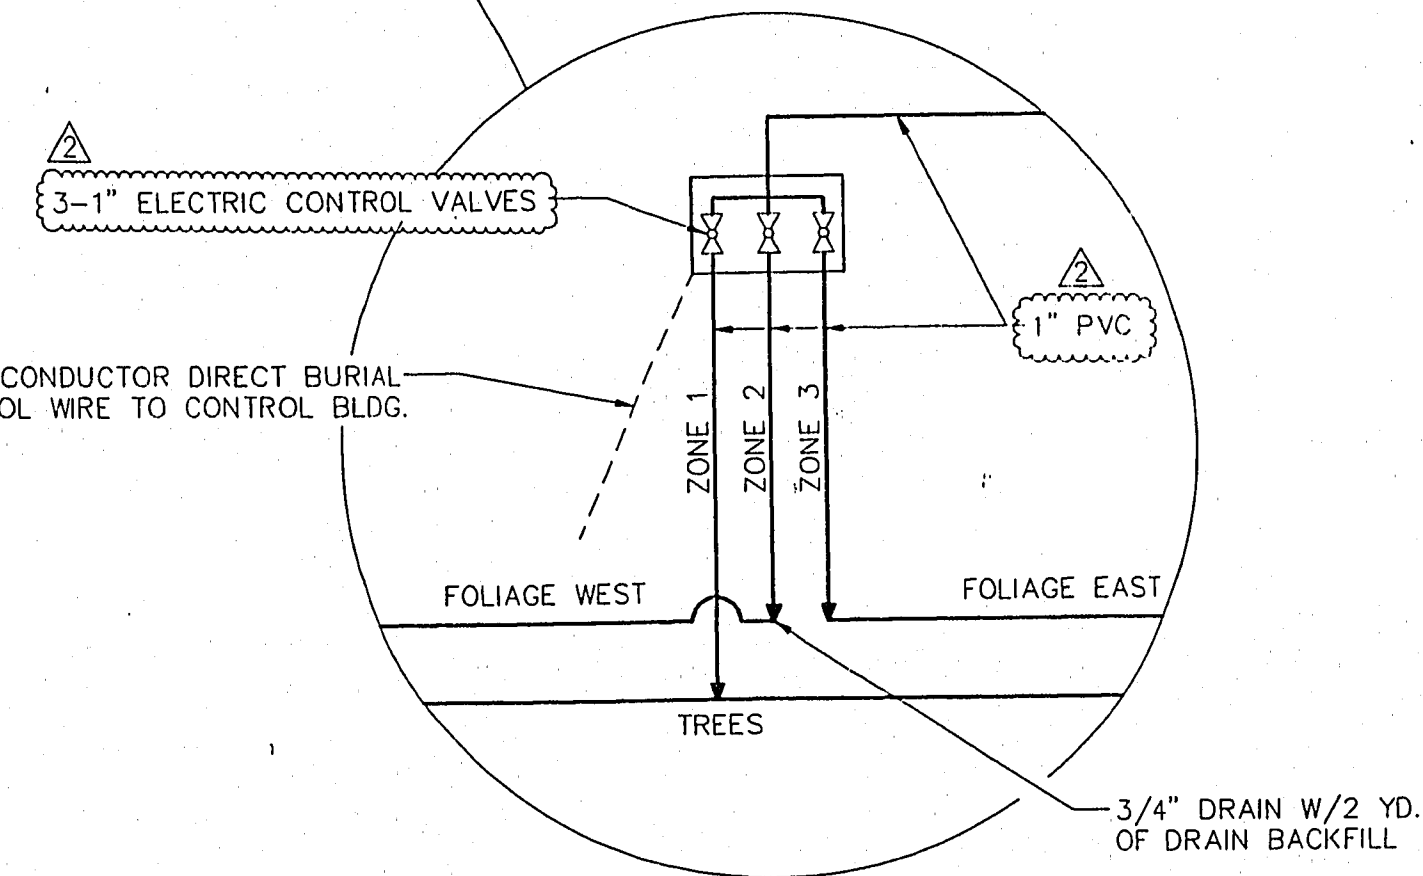

1	CHANGED PER CITY OF LAS VEGAS	GB	1/95
2	PER PLANCHHECK	GB	1/95


SCALE:
AS SHOWN

FILE NAME: 71493C09	DATE: 06/21/94
DRAWN: BJM/GB/SDM	DATE: 06/21/94
CHECKED: MHP	DATE: 06/21/94

RECOMMENDED BARTON T. SMITH 2652 C.I.T. NO. DATE	APPROVED MARK H. PETERSON 8838 P.P.E. NO. DATE
---	---

LAS VEGAS VALLEY WATER DISTRICT
1001 SOUTH VALLEY VIEW BOULEVARD
LAS VEGAS, NEVADA

EQUIP WELL NO. 93 & WELL NO. 94
LANDSCAPE AND IRRIGATION PLAN,
WELL NO. 93

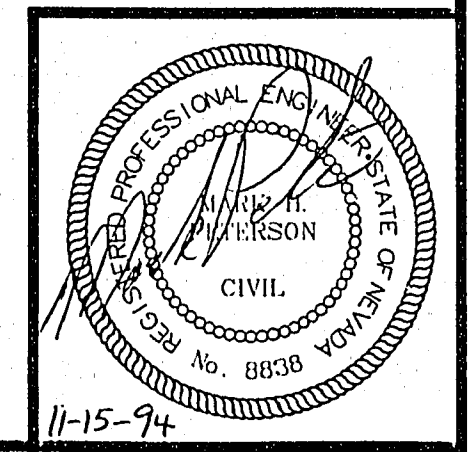

DRAWING NUMBER
714
REF. SHEET NO. 9 OF 39

ACADY(DRAWINGS) CONTRACT C071-A 71493C09.dwg Plot @ 0:1/13/95 09:24