
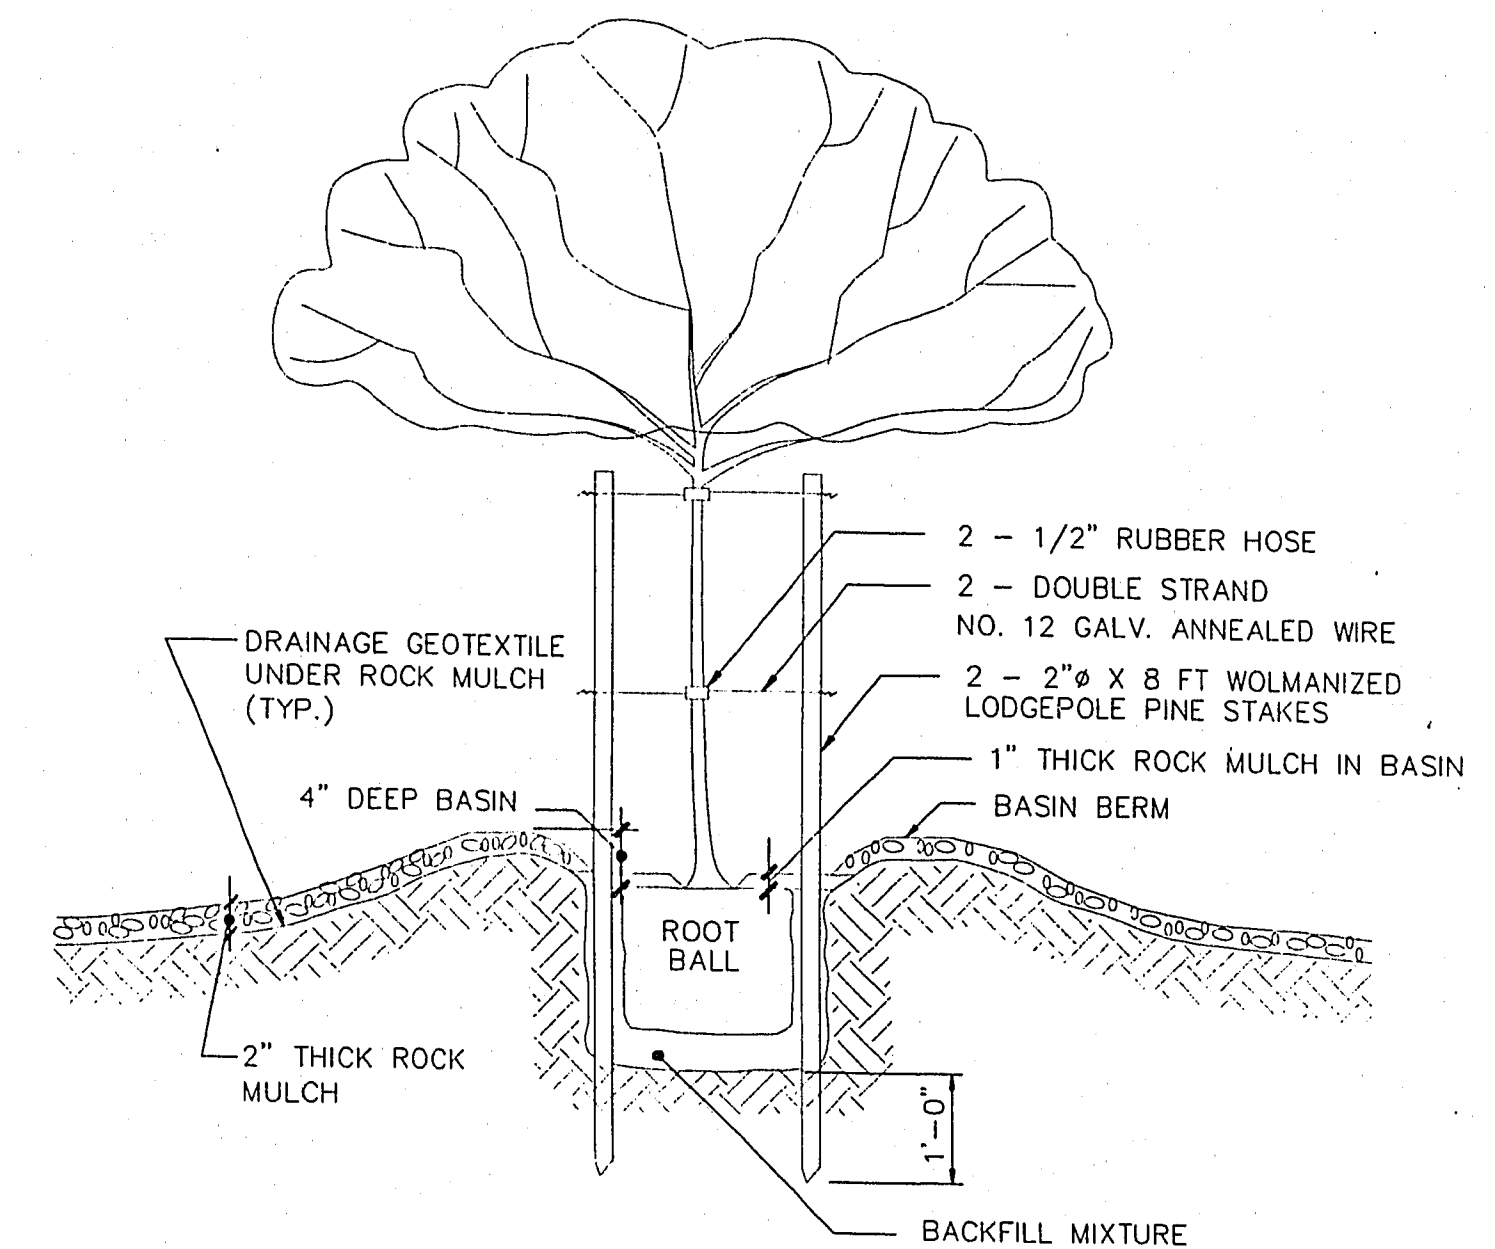
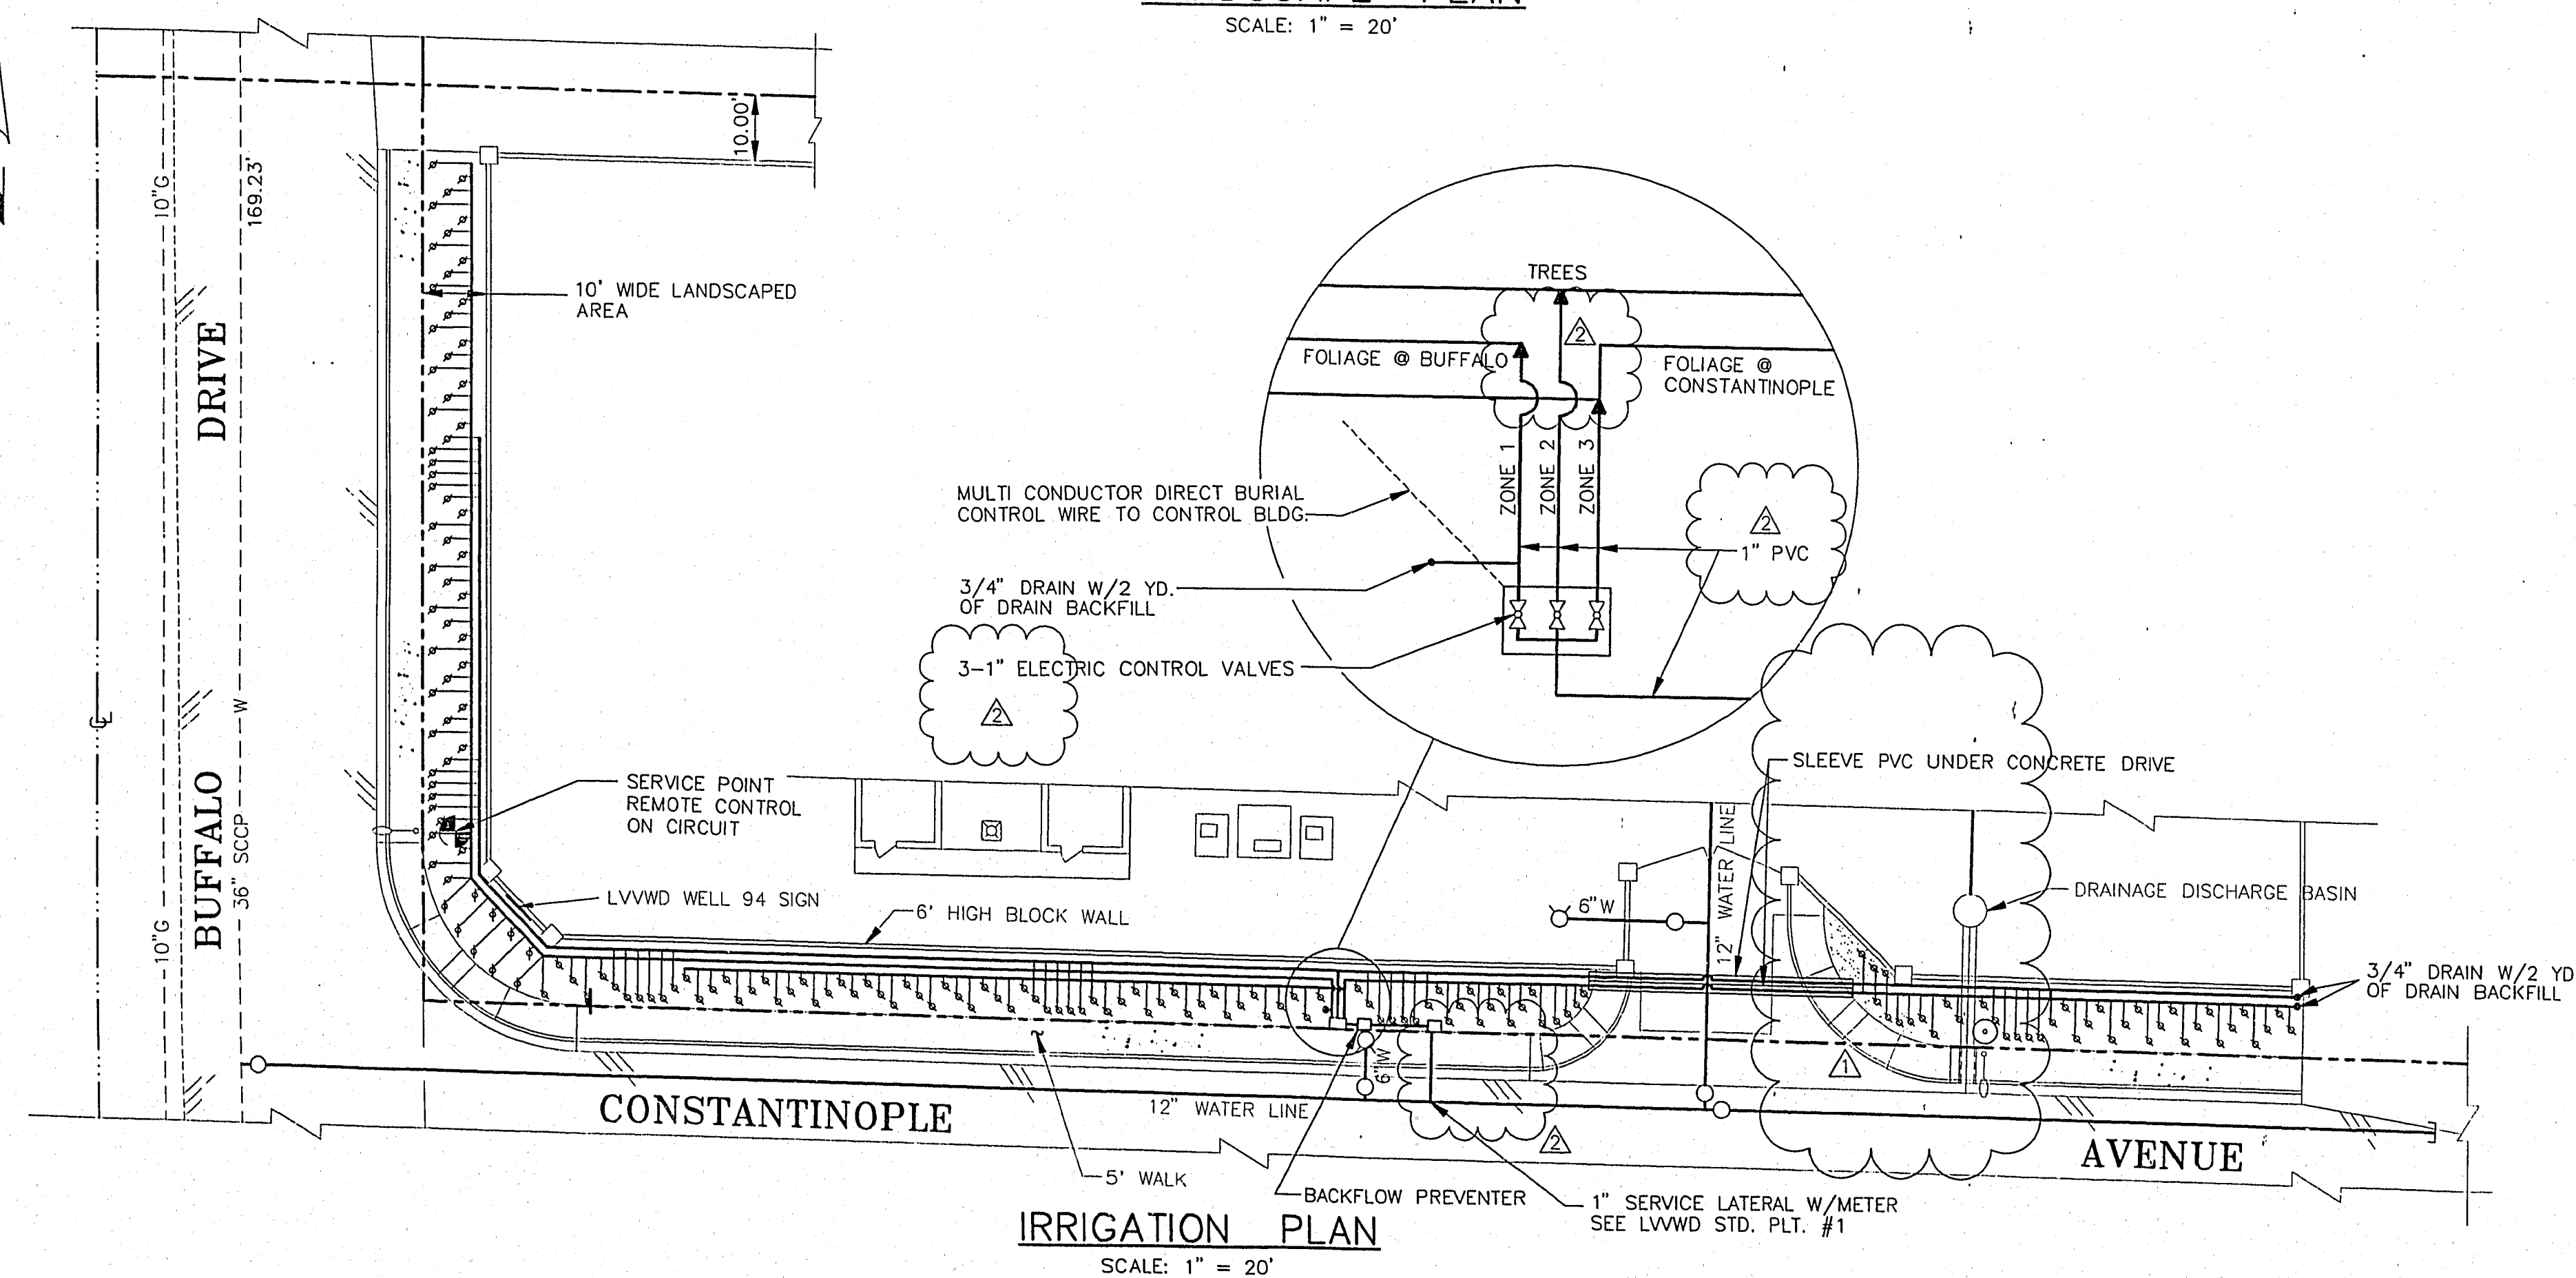


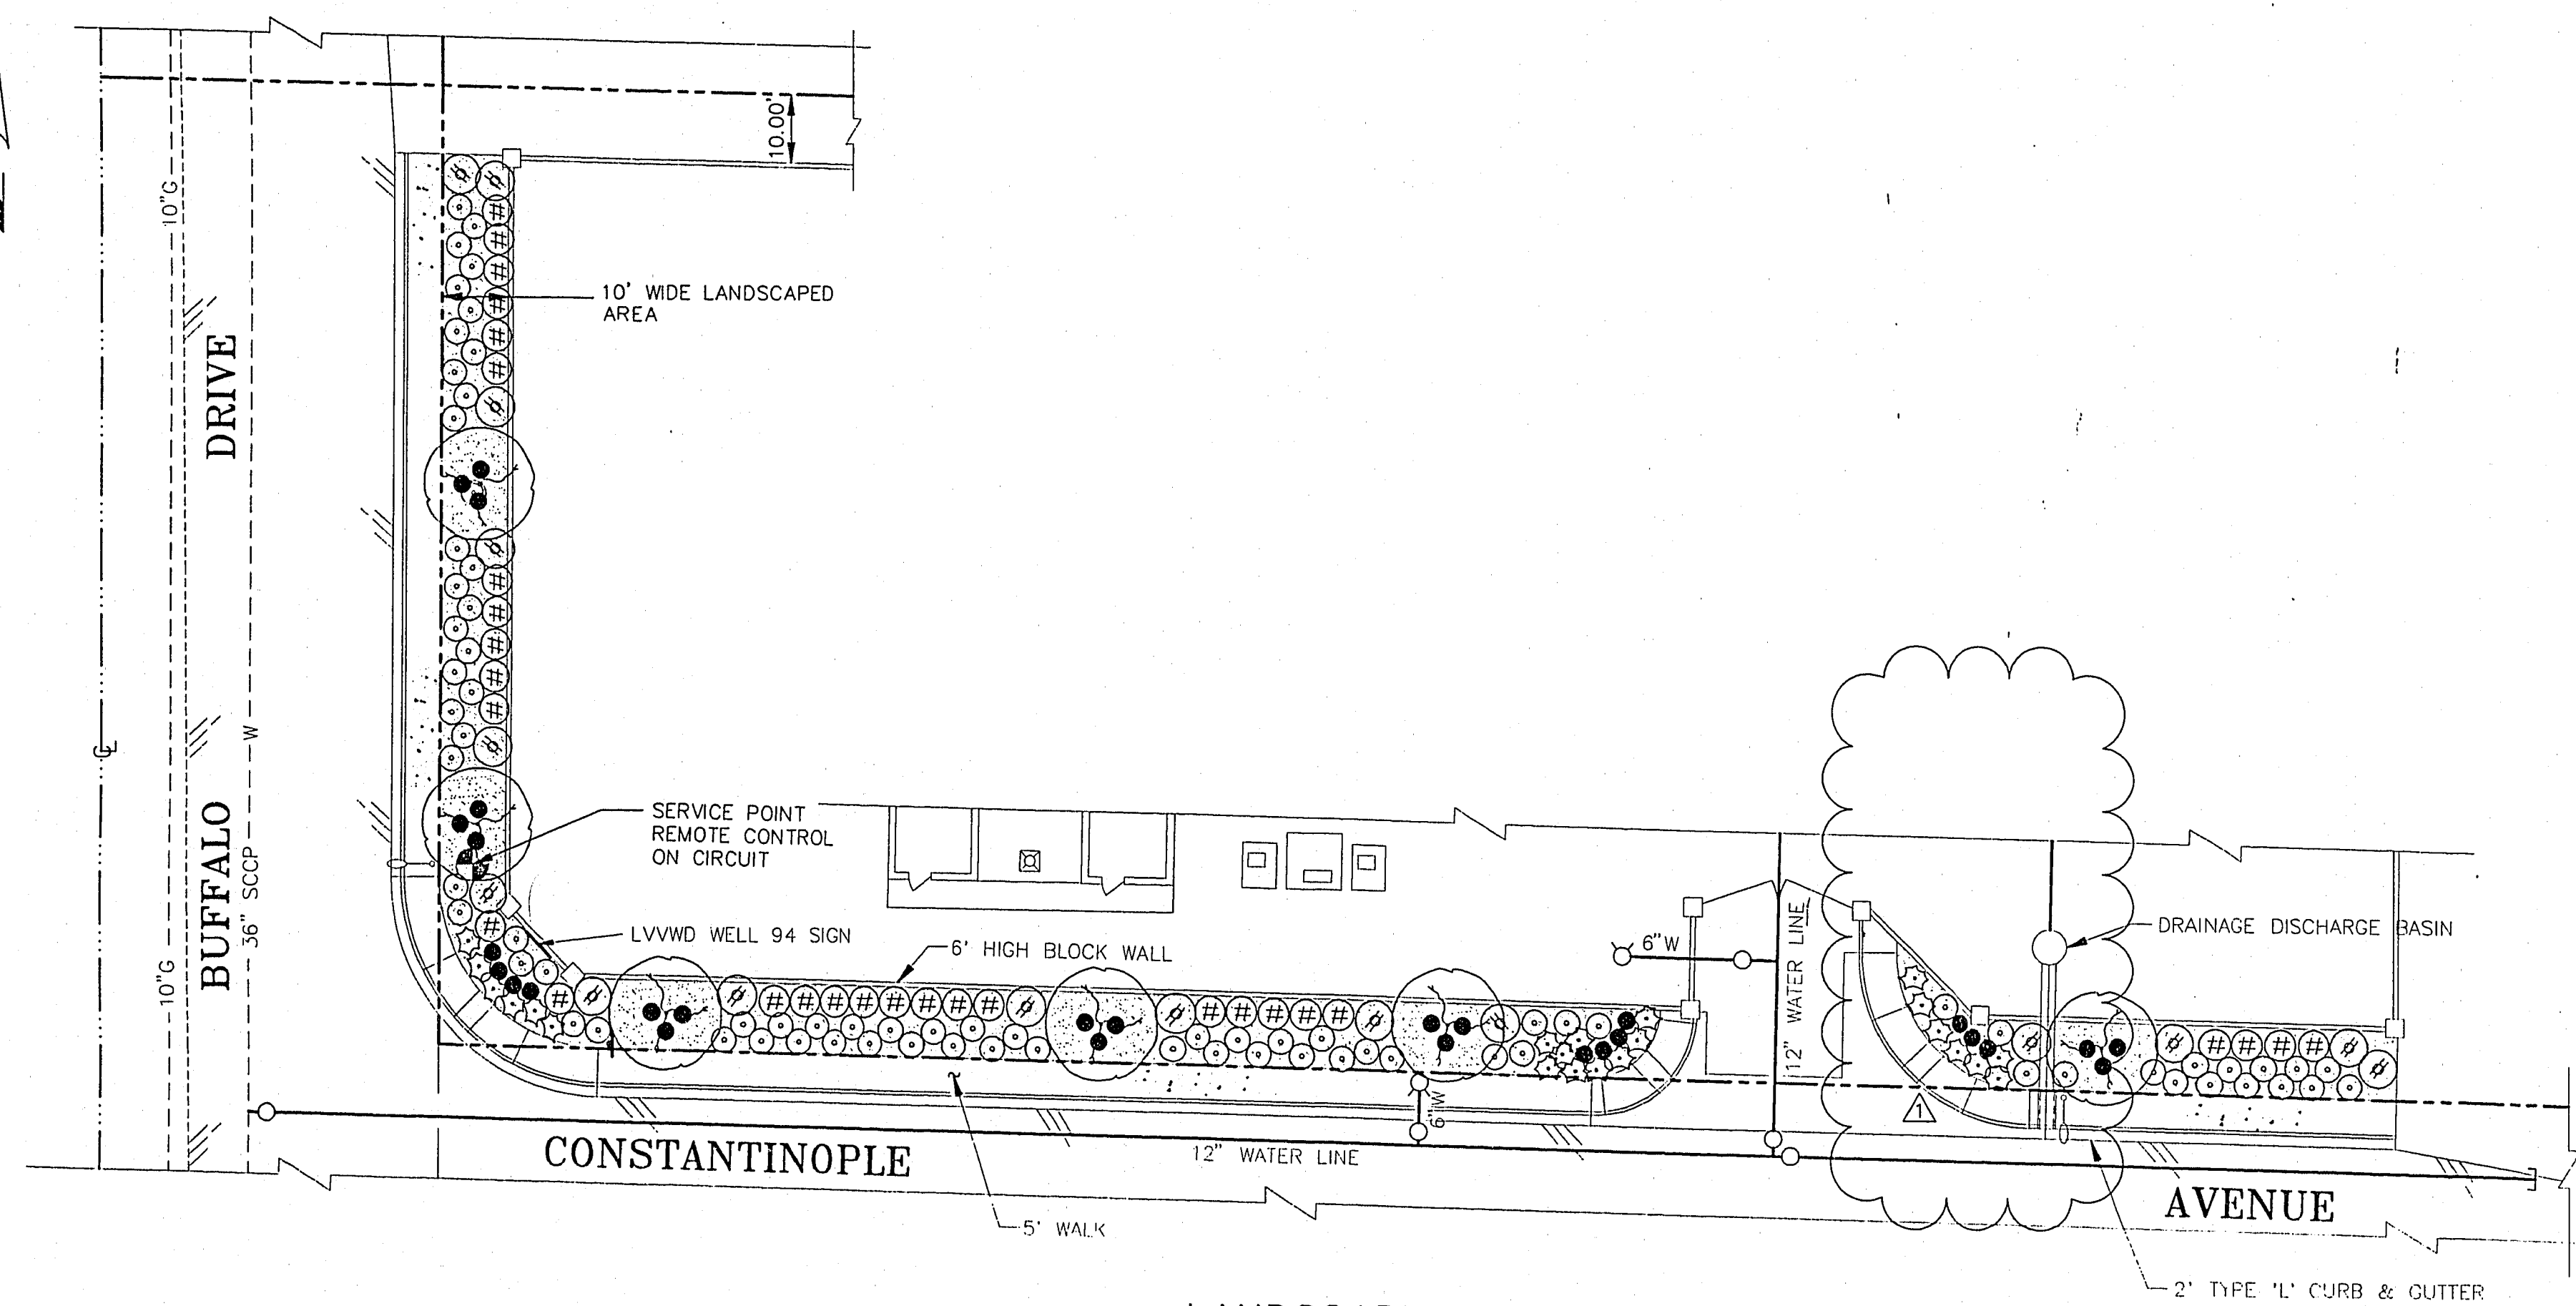

NOTE
1. DIG HOLE TWICE AS DEEP AND TWICE AS WIDE AS PLANT CONTAINER.

TREE PLANTING DETAIL

LEGEND

TREES

	SIZE	QUANTITIES
PROSOPIS JULIFLORA ARIZONA HONEY MESQUITE	24" BOX	6 EA.


SHRUBS

	SIZE	QUANTITIES
LANTANA MONTEVIDENSIS TRAILING LANTANA	1 GAL	22 EA.
BACCHARIS X 'CENTENIAL' PROSTRATE BROOM	1 GAL	78 EA.
LEUCOPHYLLUM FRUTESCENS 'COMPACTA'	5 GAL	30 EA.
LEUCOPHYLLUM FRUTESCENS 'GREEN CLOUD'	5 GAL	16 EA.

ROCK

LANDSCAPE BOULDERS	2' Ø	29 EA.
RIVER ROCK, 2" DEEP (ROCK TO COVER ENTIRE LANDSCAPE AREA)	1/2" Ø	3600 SQ. FT.

- PVC PIPE, SCH. 40
- HARDIE 1" ELECTRIC CONTROL VALVE 700-1 W/IRRIGATION BOX OR APPROVED EQUAL
- BACKFLOW PREVENTION ASSEMBLY, REDUCED PRESSURE PRINCIPLE ASSEMBLY PER L.V.V.W.D. STD. PLT. #11
- BOWSMITH 2 GPH L SERIES EMITTER S20-L OR APPROVED EQUAL
- AGRICULTURAL PRODUCTS 1/2" IPS PVC FLEX HOSE

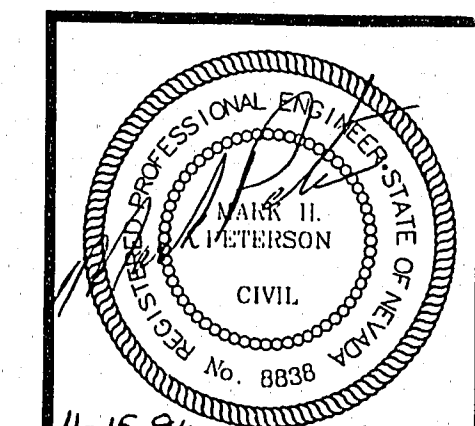

11-15-94
DRAWING NUMBER
714
REF. SHEET NO. C10
SHEET 10 OF 39

REV.	DESCRIPTION	BY	DATE	CHK'D
1	CHANGED PER CITY OF LAS VEGAS	GB	1/95	
2	PER PLAN CHECK	GB	1/95	

SCALE:
AS SHOWN

FILE NO: 71494C10
DATE: 06/21/94
DRAWN: BJM/GB/SDM
DATE: 06/21/94
CHECKED: MHP
DATE: 06/21/94

RECOMMENDED
BARTON T. SMITH 2652
DATE
APPROVED
MARK H. PETERSON 8838
DATE 11-15-94
R.P.E. NO.

LAS VEGAS VALLEY WATER DISTRICT
1001 SOUTH VALLEY VIEW BOULEVARD
LAS VEGAS, NEVADA

EQUIP WELL NO. 93 & WELL NO. 94
LANDSCAPE AND IRRIGATION PLAN,
WELL NO. 94

565-247