
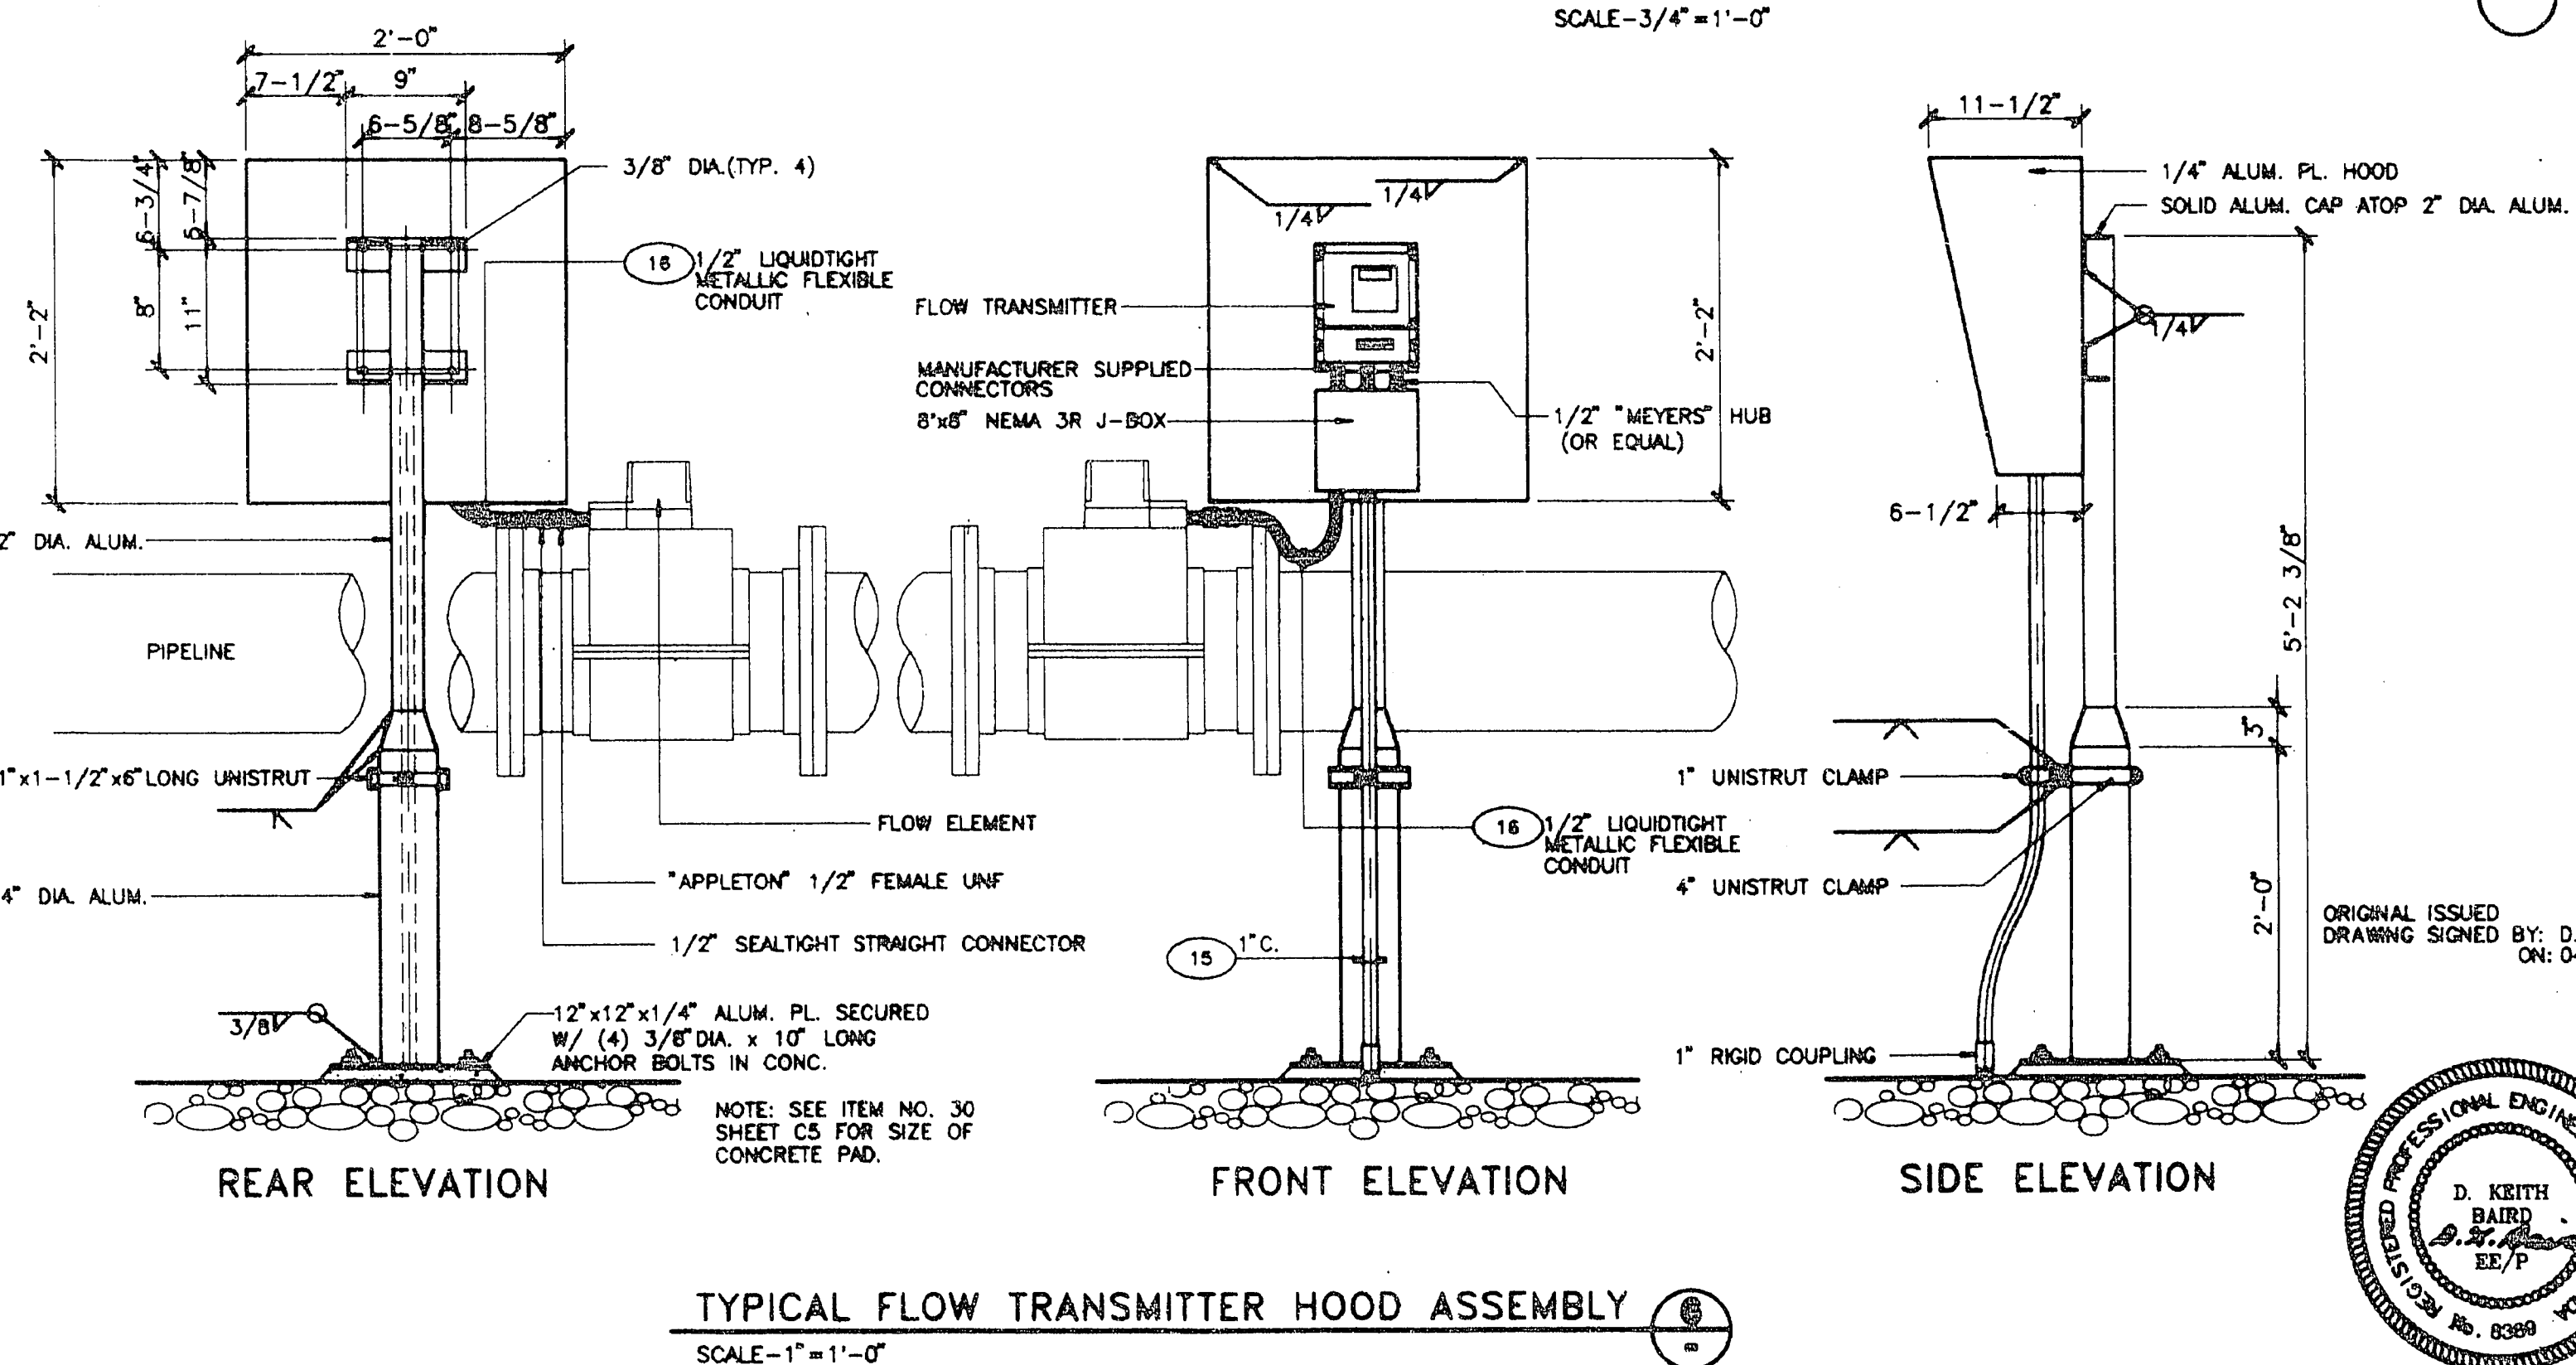
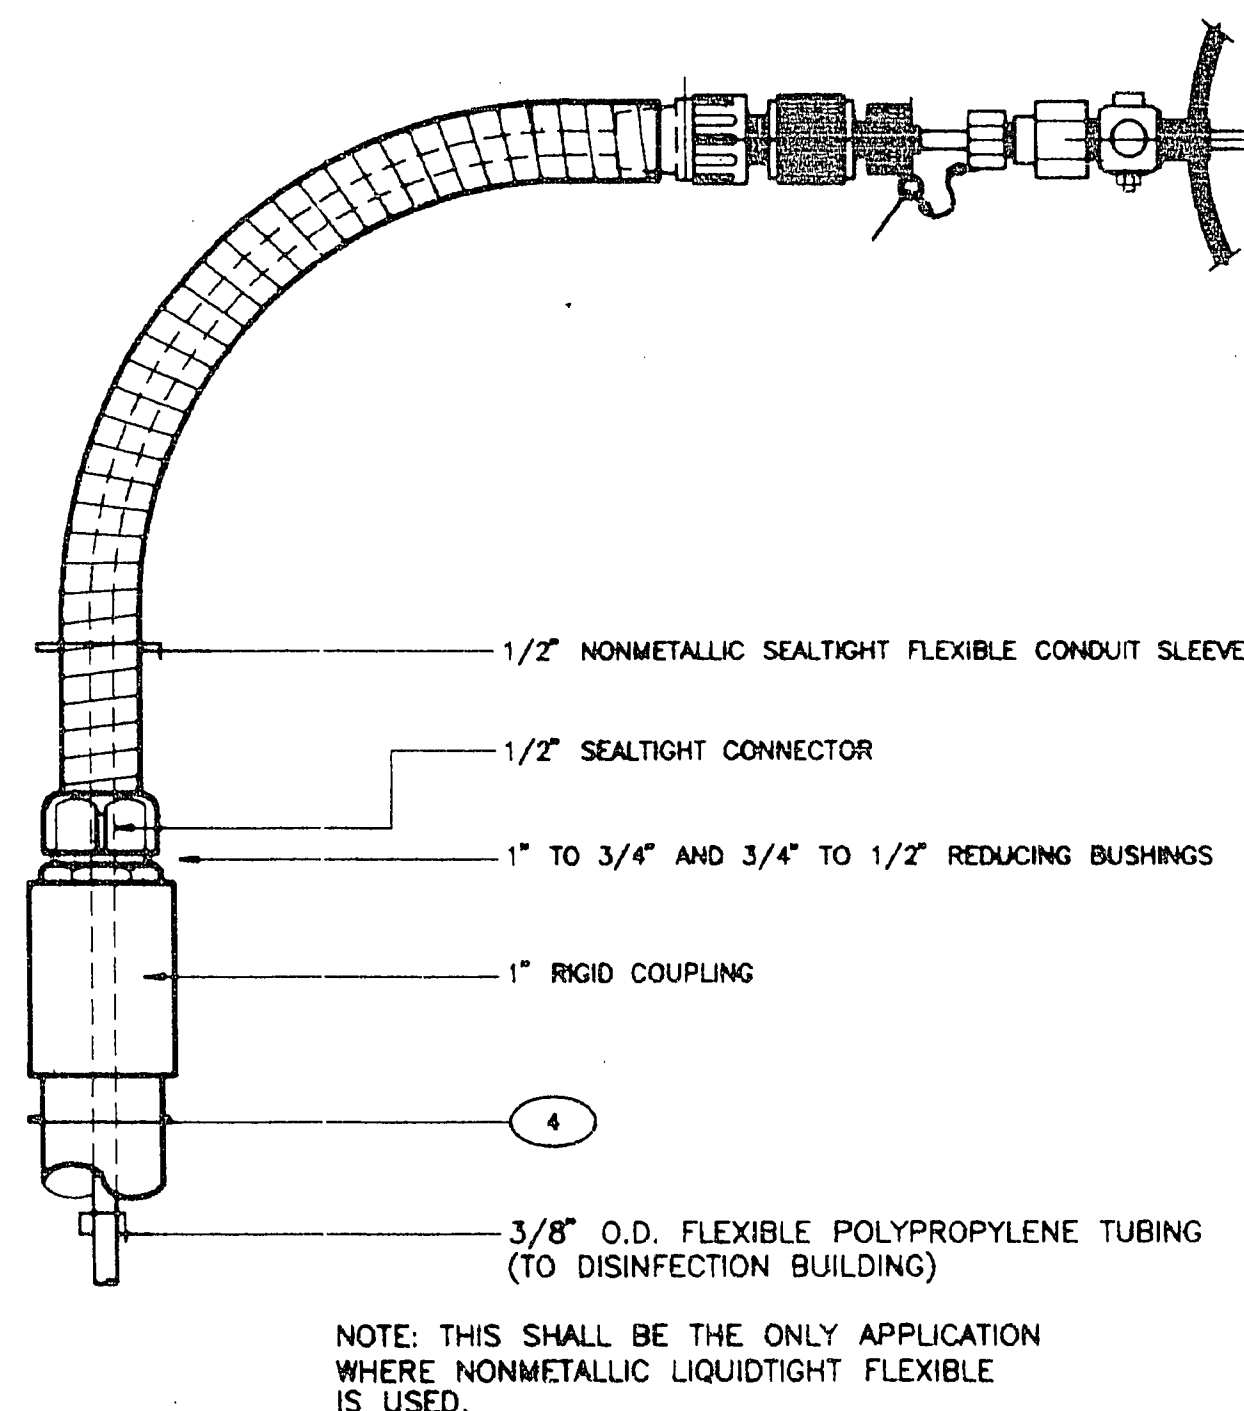
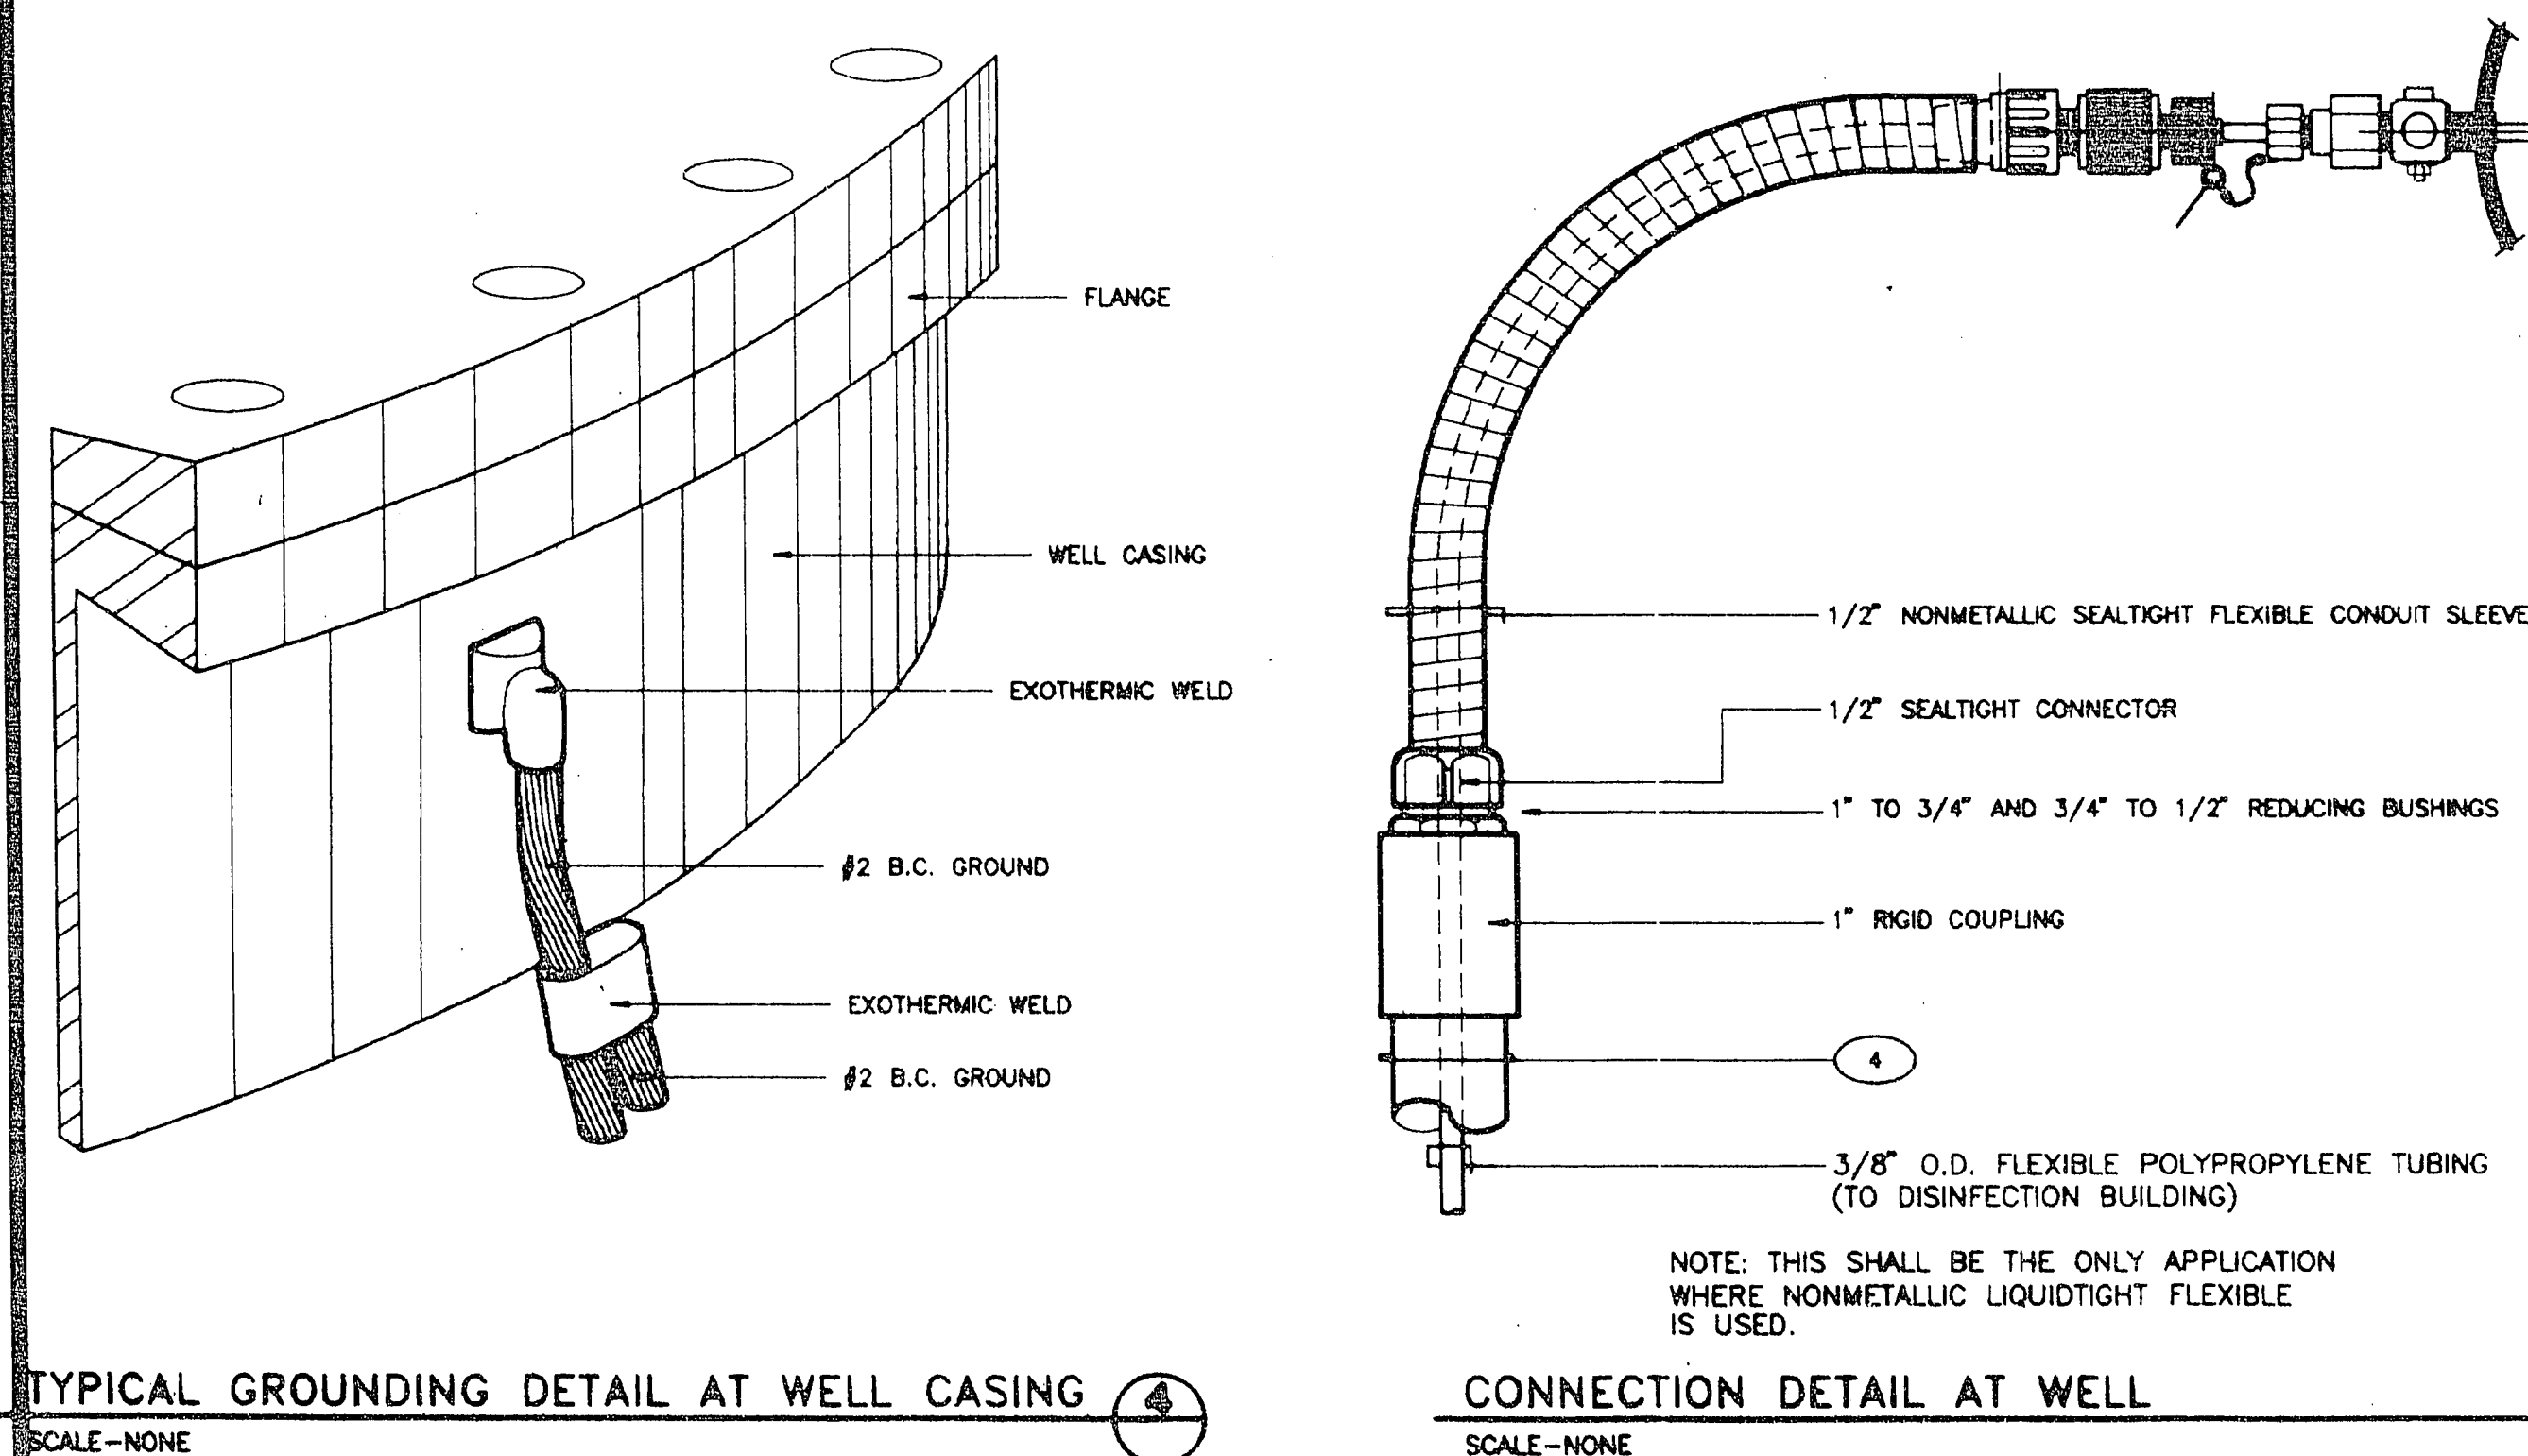
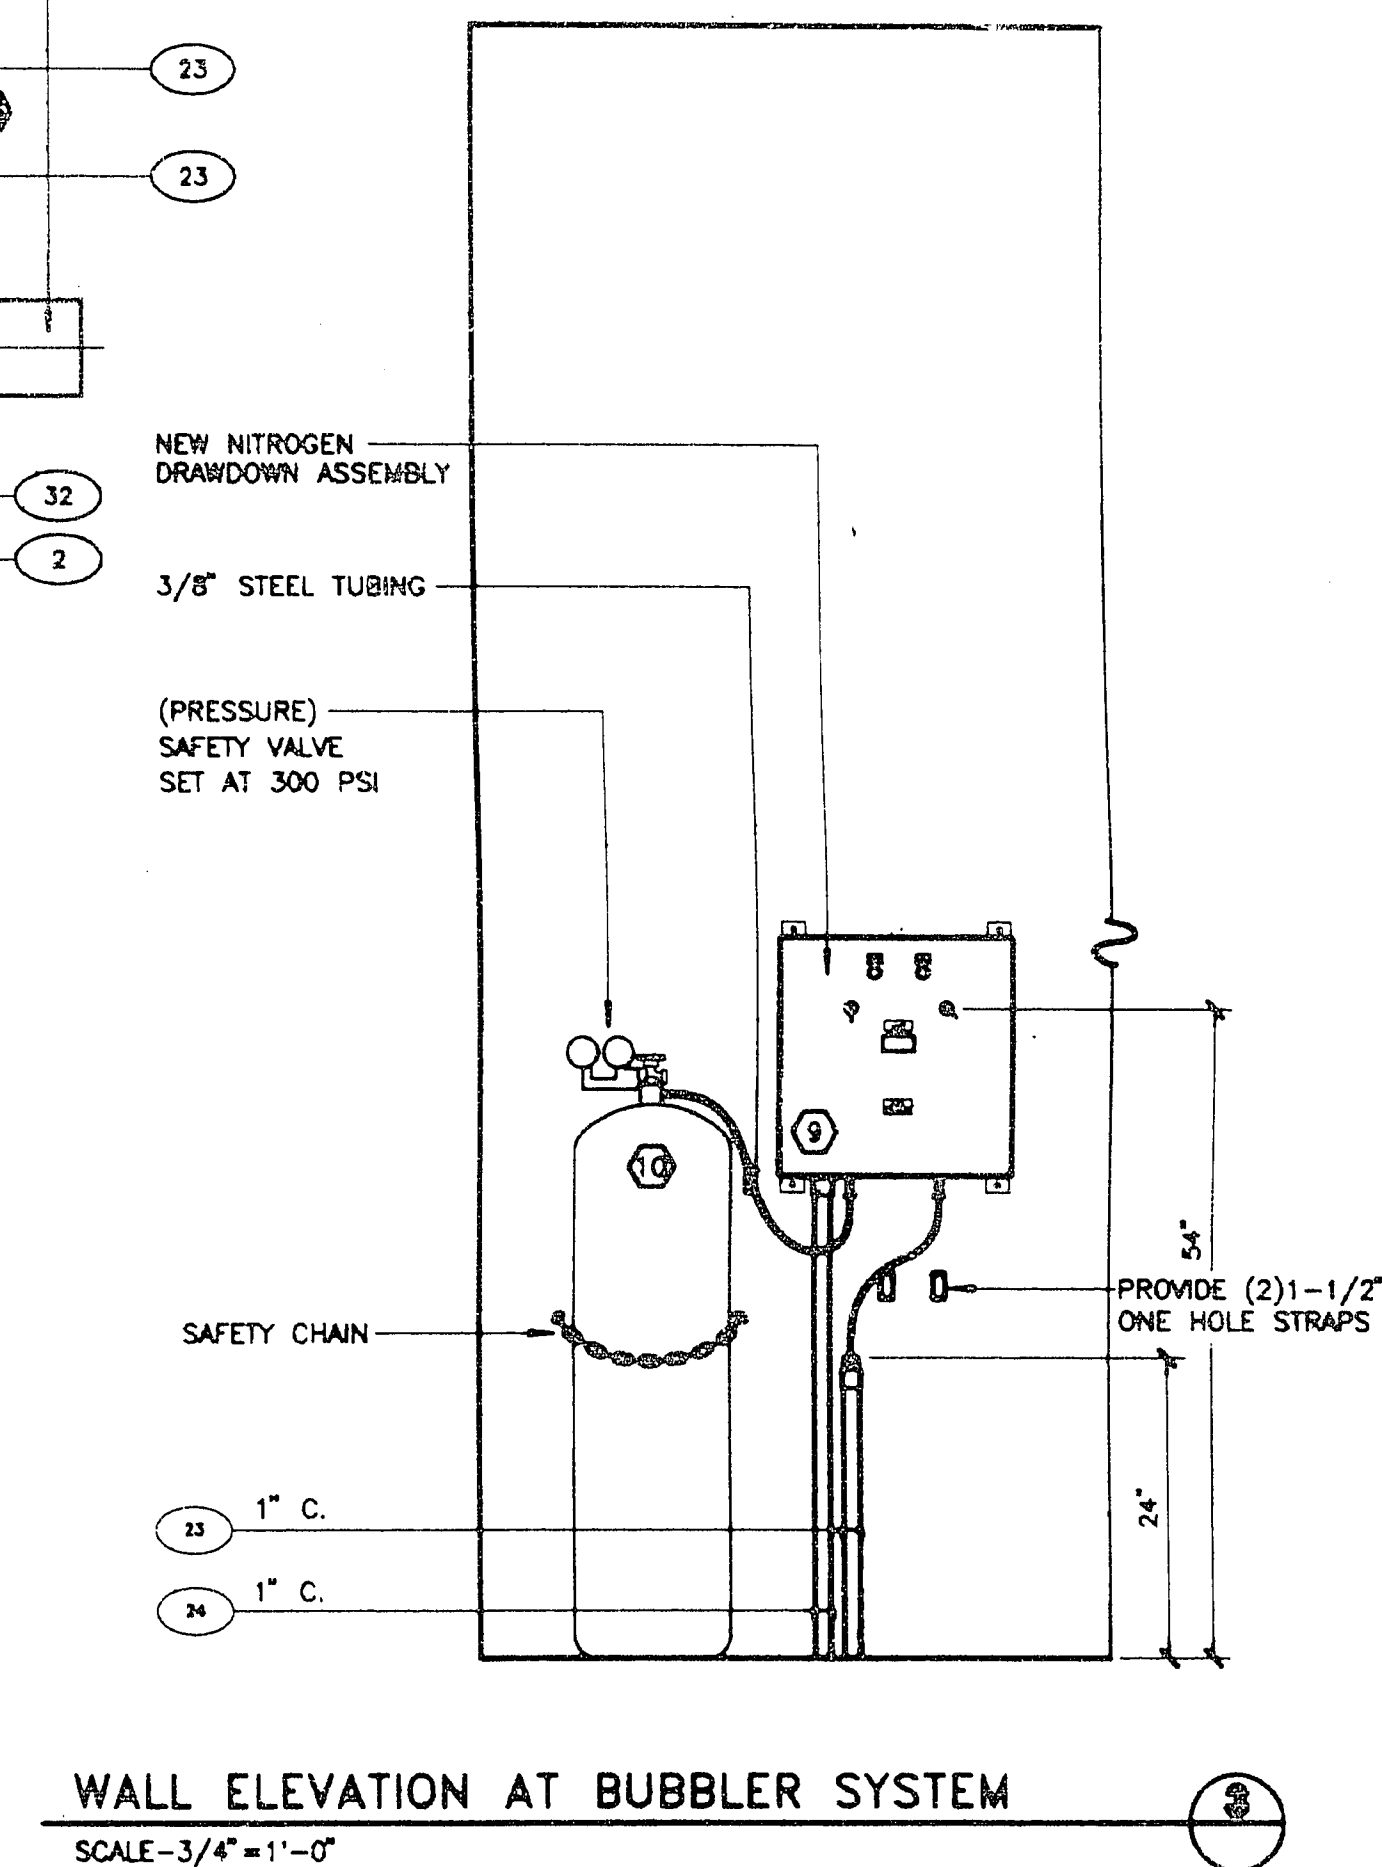
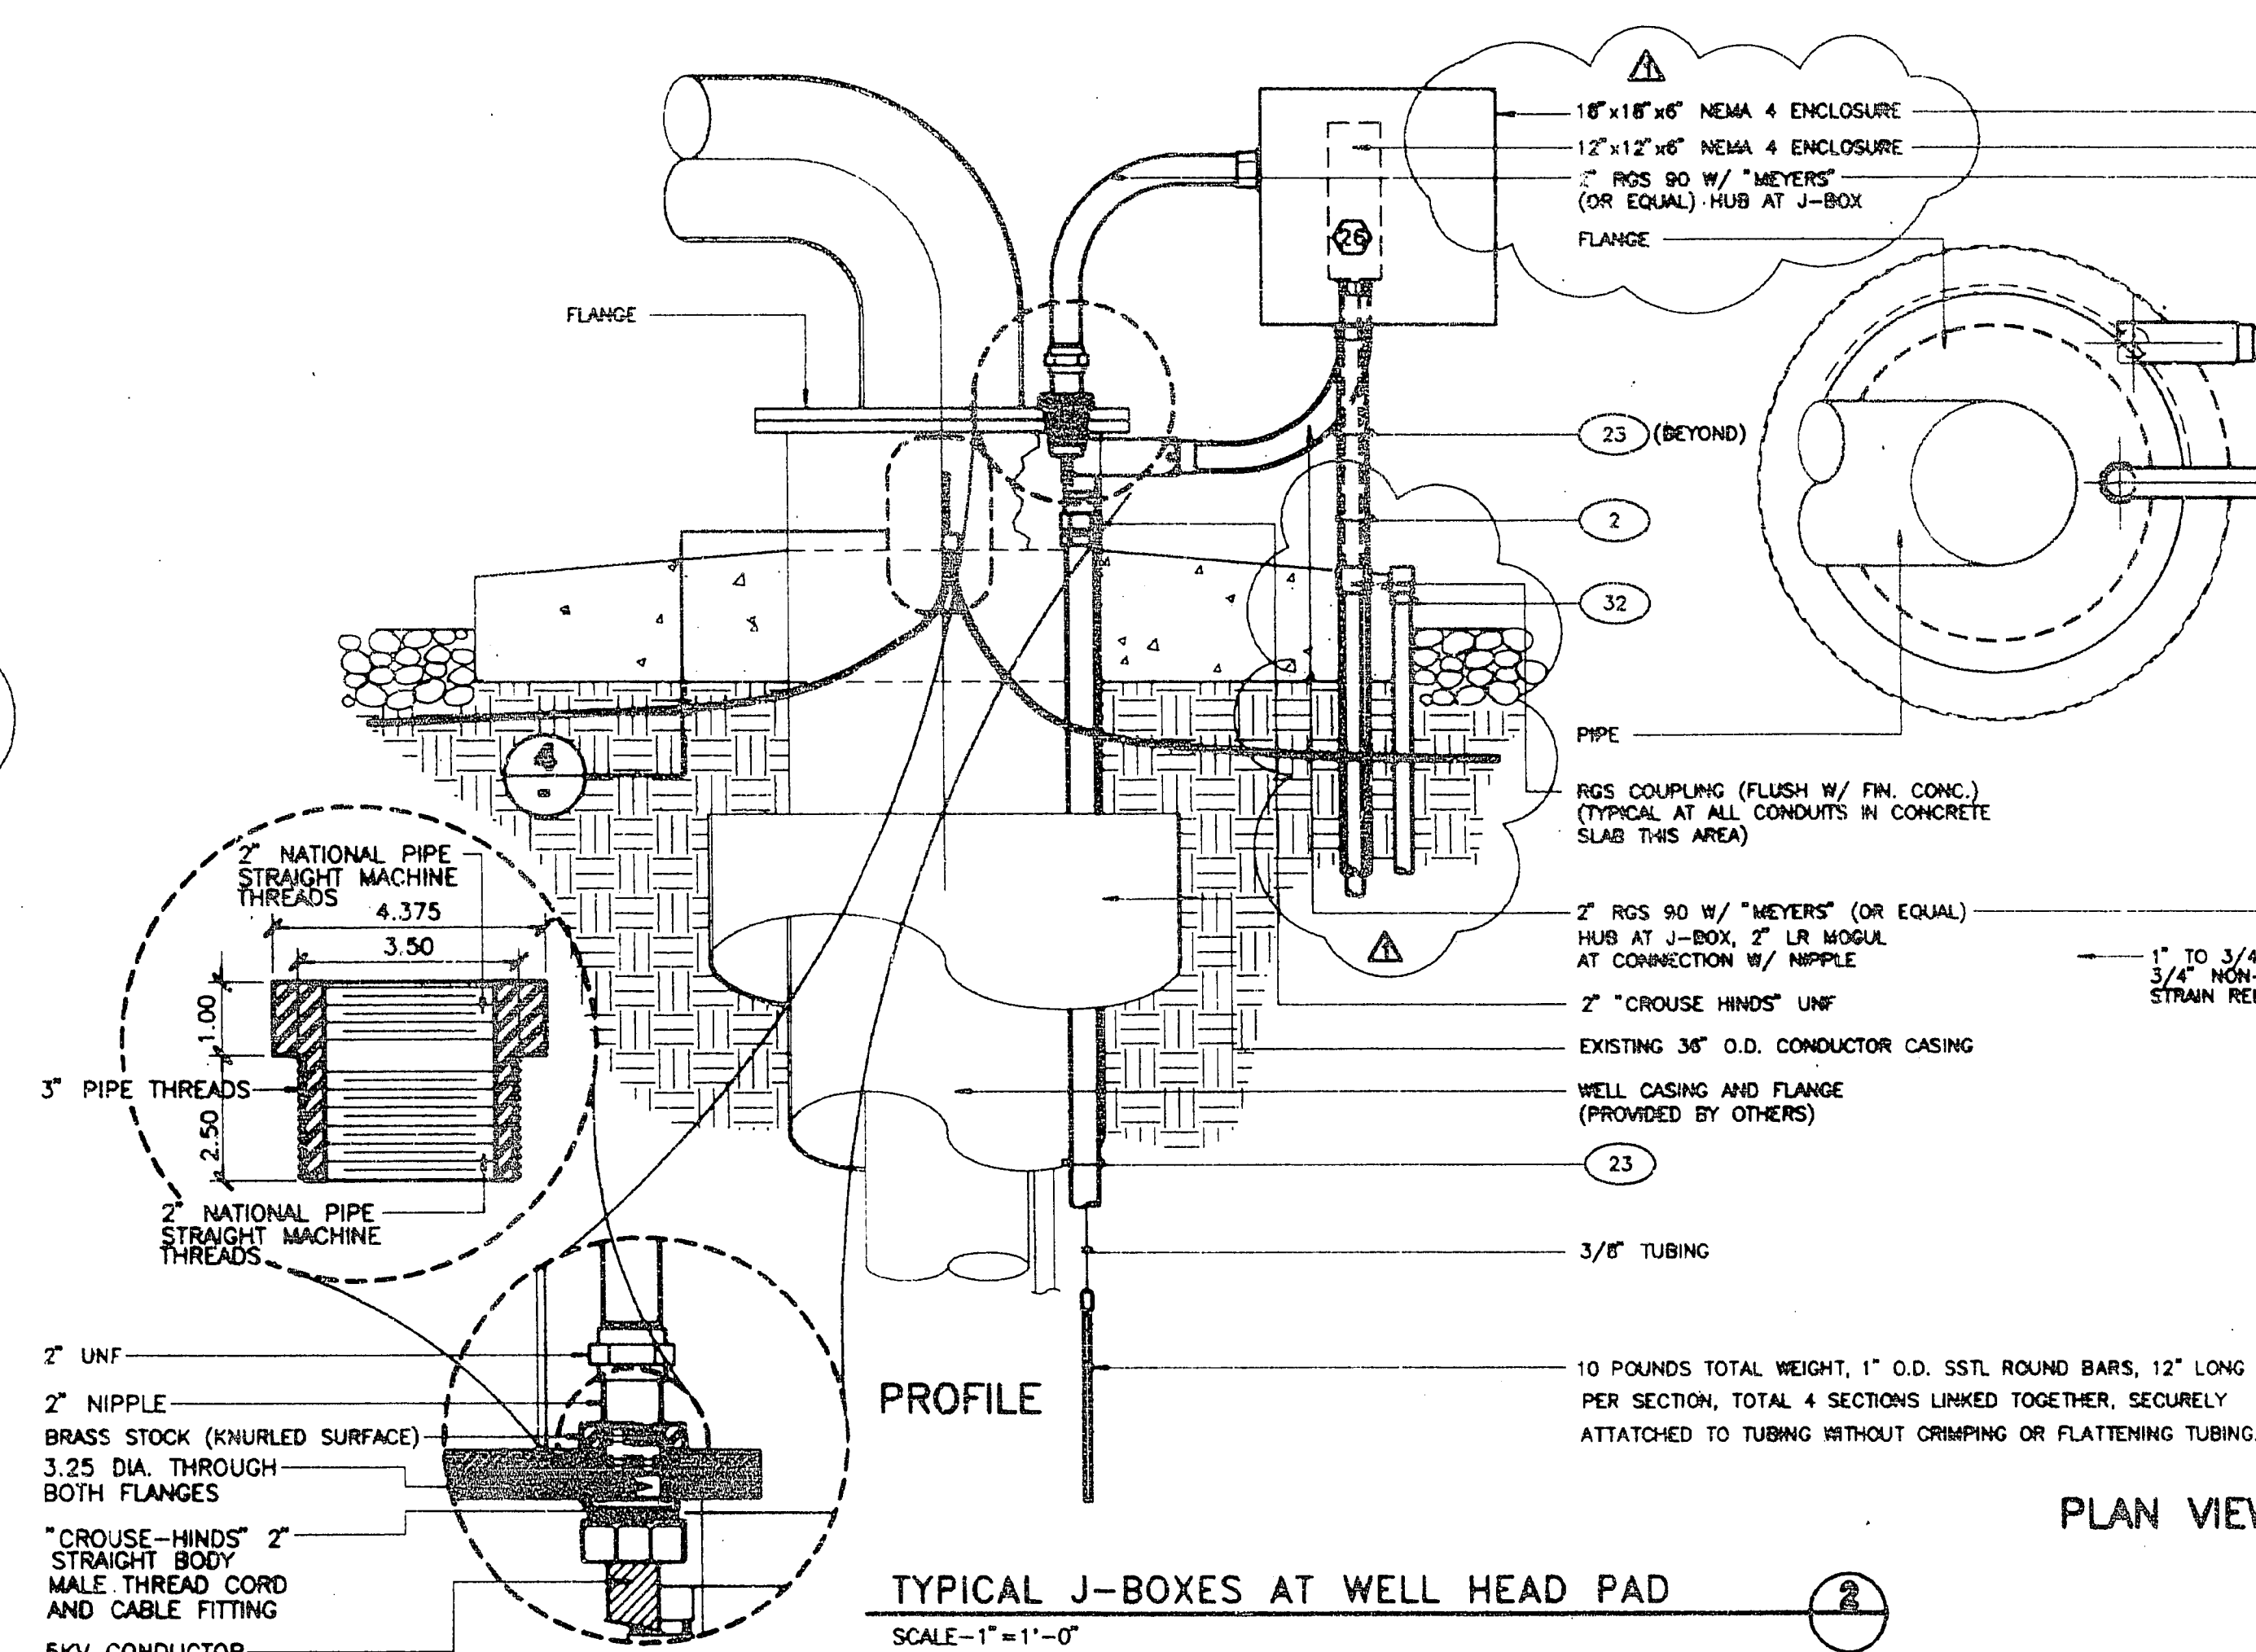


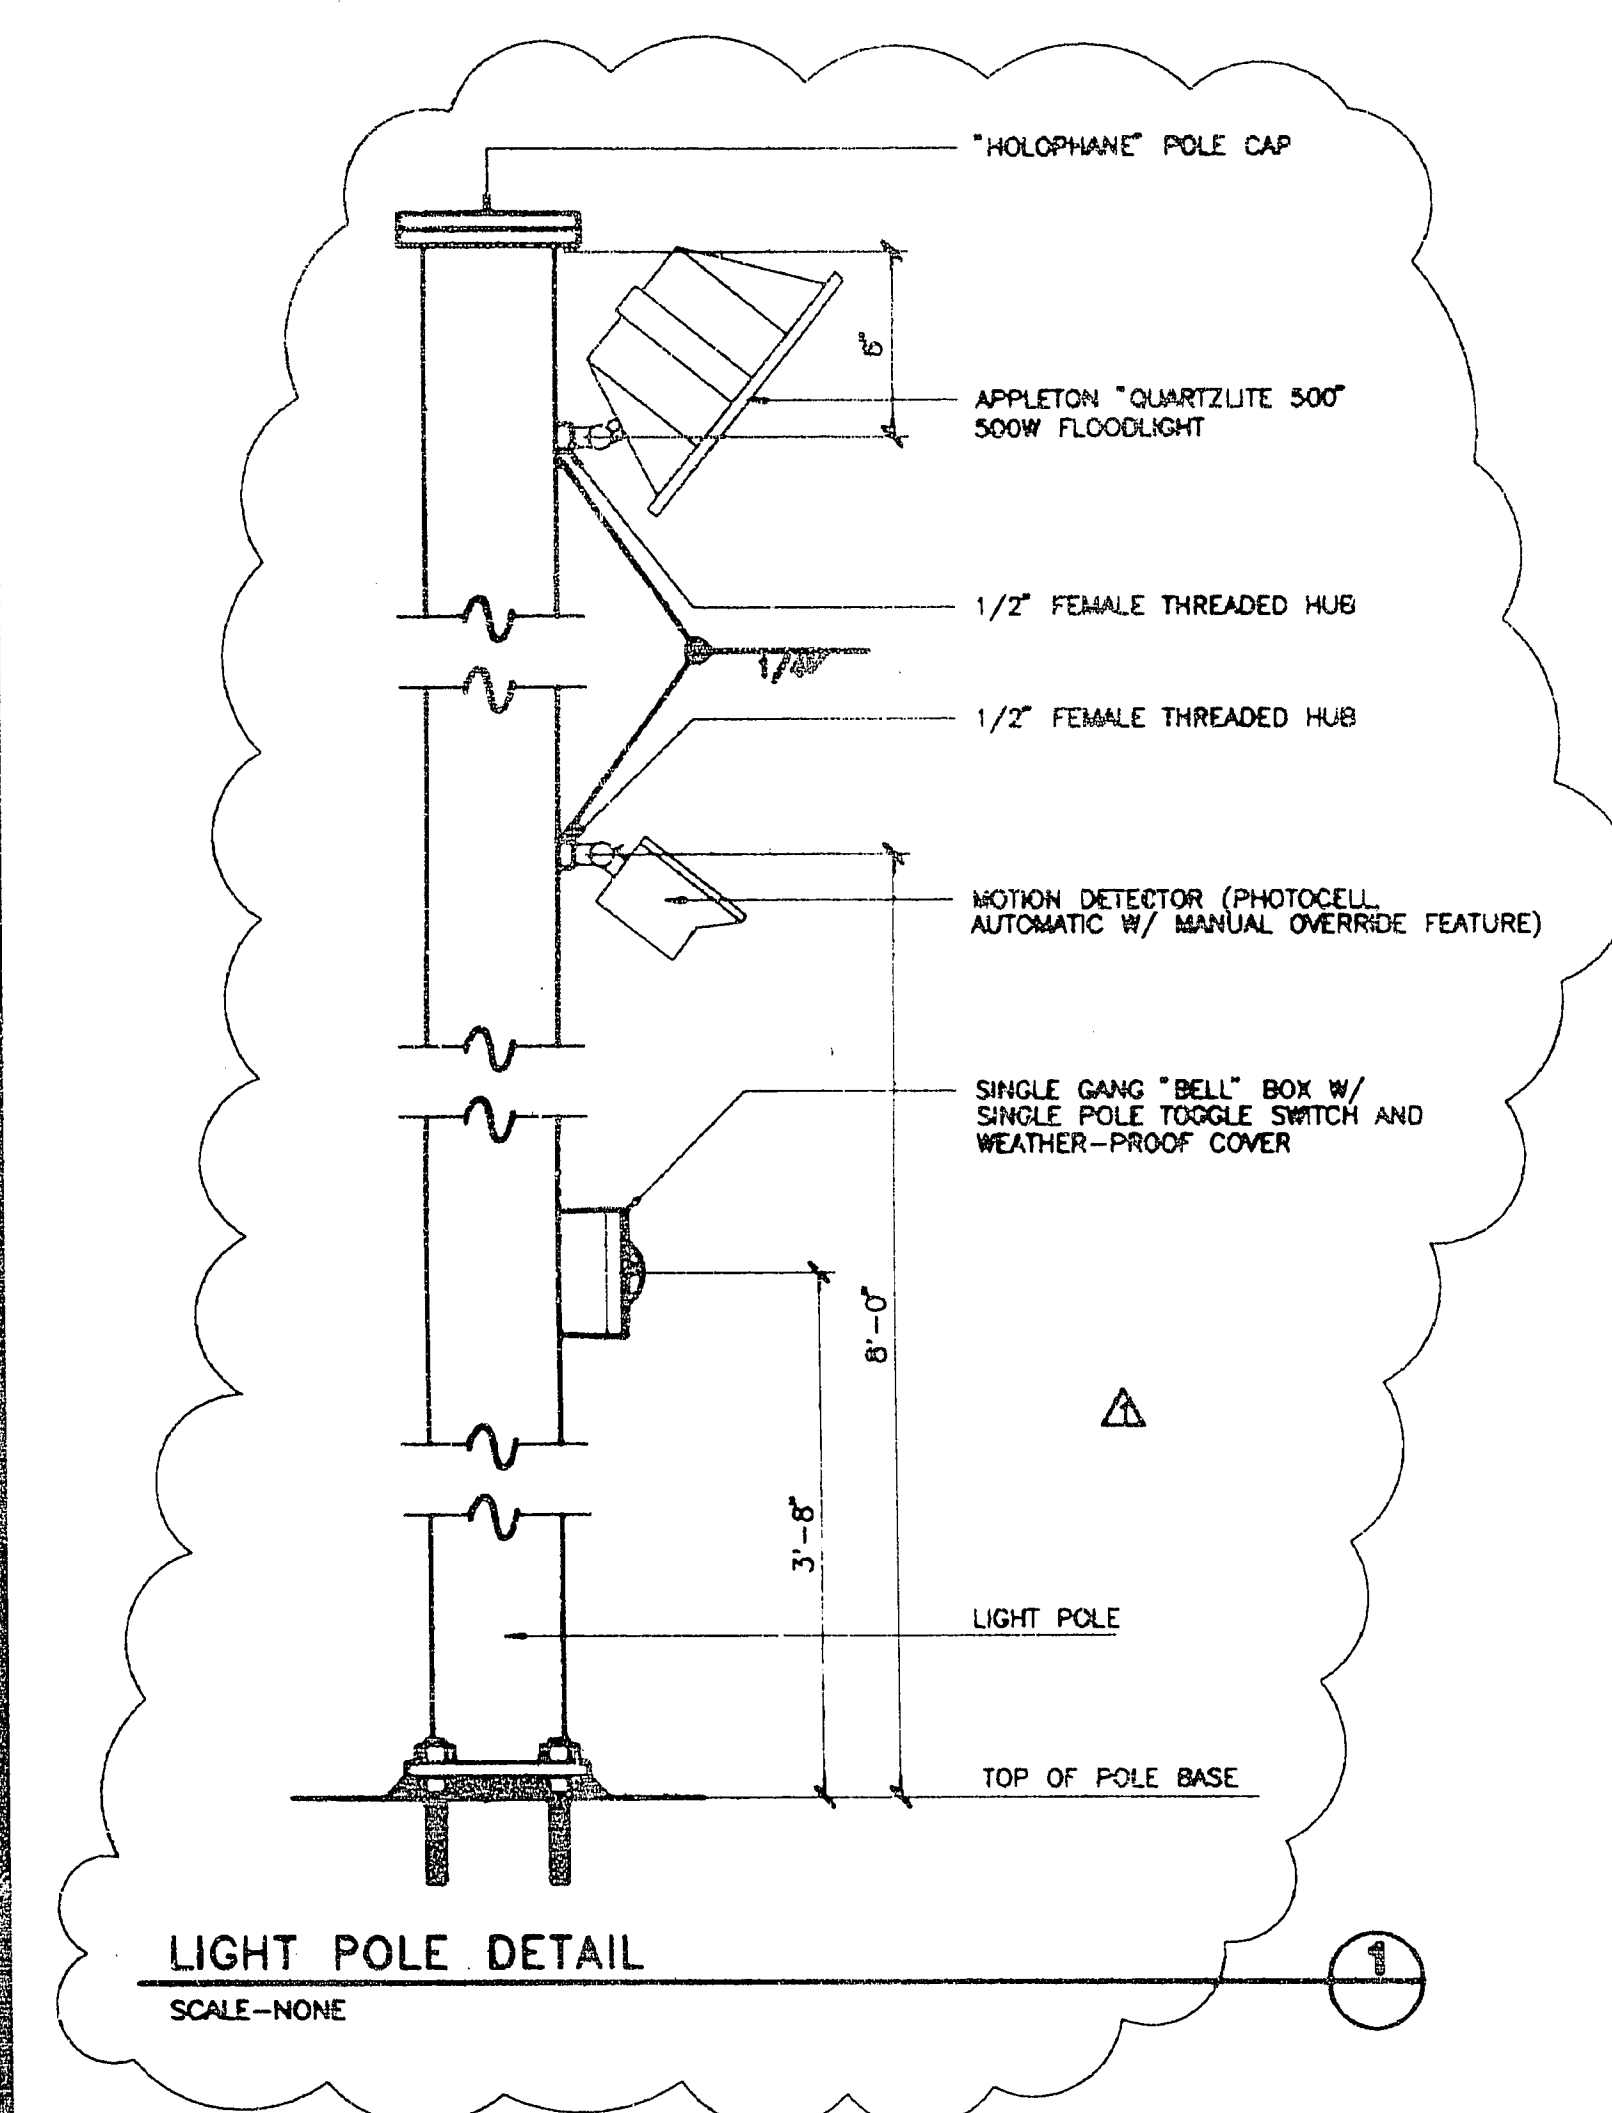

				SCALE:	RE: <u>CONSTRUCTION</u>	DATE: <u>12/14/94</u>		
				NOTED	DRAWN: <u>J. R. GALEMAN</u>	DATE: <u>12/14/94</u>		
CHANGED DETAIL 1, MODIFIED DETAIL 2				1" = 12'	DRAWN: <u>J.R.</u>	DATE: <u>04/17/95</u>		

LAS VEGAS VALLEY WATER DISTRICT
1001 SOUTH VALLEY VIEW BOULEVARD
LAS VEGAS, NEVADA 89102

EQUIP WELL NOS. 102 AND 105

DETAILS

REF. SHEET NO. 10
SHEET 21 OF 21