


A ELECTRICAL SITE PLAN
 E11 SCALE: 1/16" = 1'-0"

SHEET NOTES

- ① INTERMATIC #ET10415CR TIME SWITCH 4 POLE, 20 AMPS PER POLE 277V VOLT. STUB OUT (4) 1" C FOR FUTURE USE TO A GRASS AREA. CAP OFF CONDUITS.
- ② BEFORE ROUGH-IN OF TYPE "DD" FIXTURES, VERIFY WITH ARCHITECT.

RECORD DRAWINGS

108 OF 118
 650.59

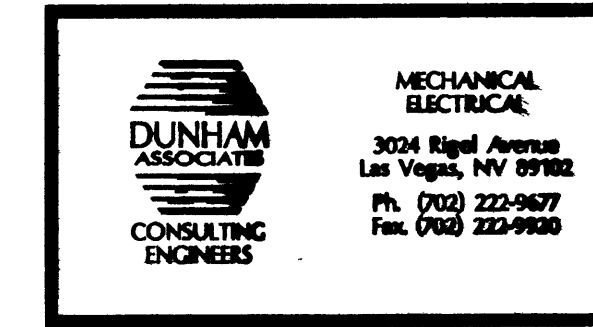

DUNHAM MECHANICAL ELECTRICAL CONSULTING ENGINEERS, INC.
 3204 West Avenue
 Las Vegas, NV 89102
 PH. (702) 222-0077
 FAX. (702) 222-0078

ELECTRICAL SITE PLAN
 SHEET TITLE
 JOB TITLE CITY OF LAS VEGAS DEPARTMENT OF PARK AND LEISURE ACTIVITIES
 JOB TITLE DURANGO RECREATION FACILITY
 Verify all Dimensions and Conditions at the Site

1325 WEST OAKLEY BLVD
 LAS VEGAS, NV 89102
 (702) 383-0077
 FAX 383-0087
WAYNE SCHEINER AIA
THOMAS M. SILVA AIA

REVISION	DESCRIPTION	DATE	REV. BY

P:\863501\1-1.dwg 04/25/98 07:56:32 1/16" = 1'-0"
 27/120