



1 WALL SECTION @ EXTERIOR WALL
SCALE: 3/4" = 1'-0"

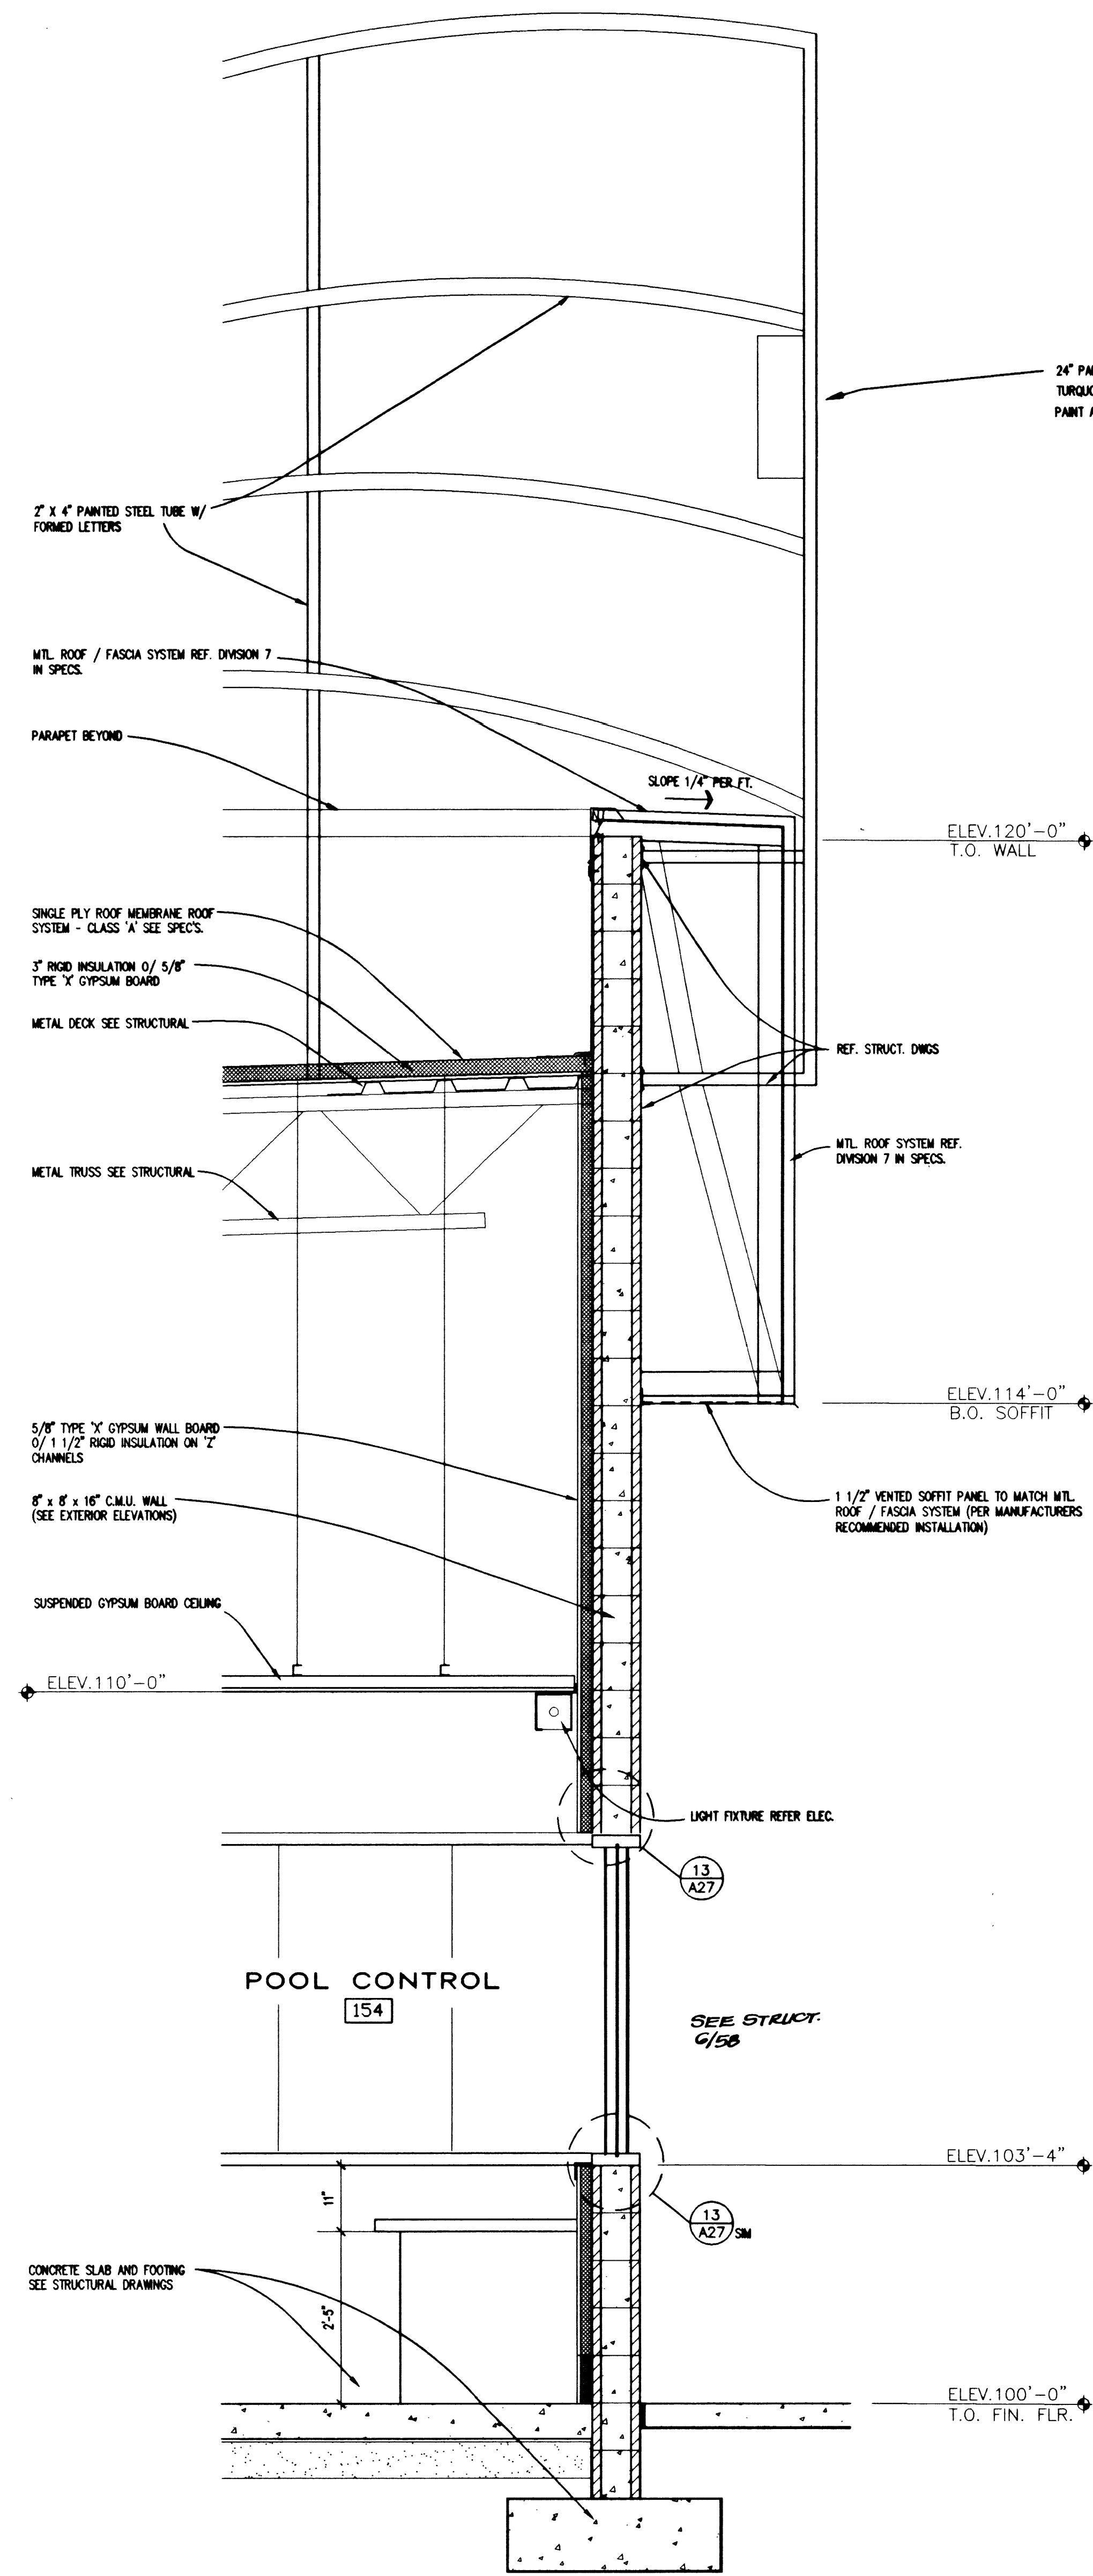

2 WALL SECTION @ EXTERIOR WALL
SCALE: 3/4" = 1'-0"

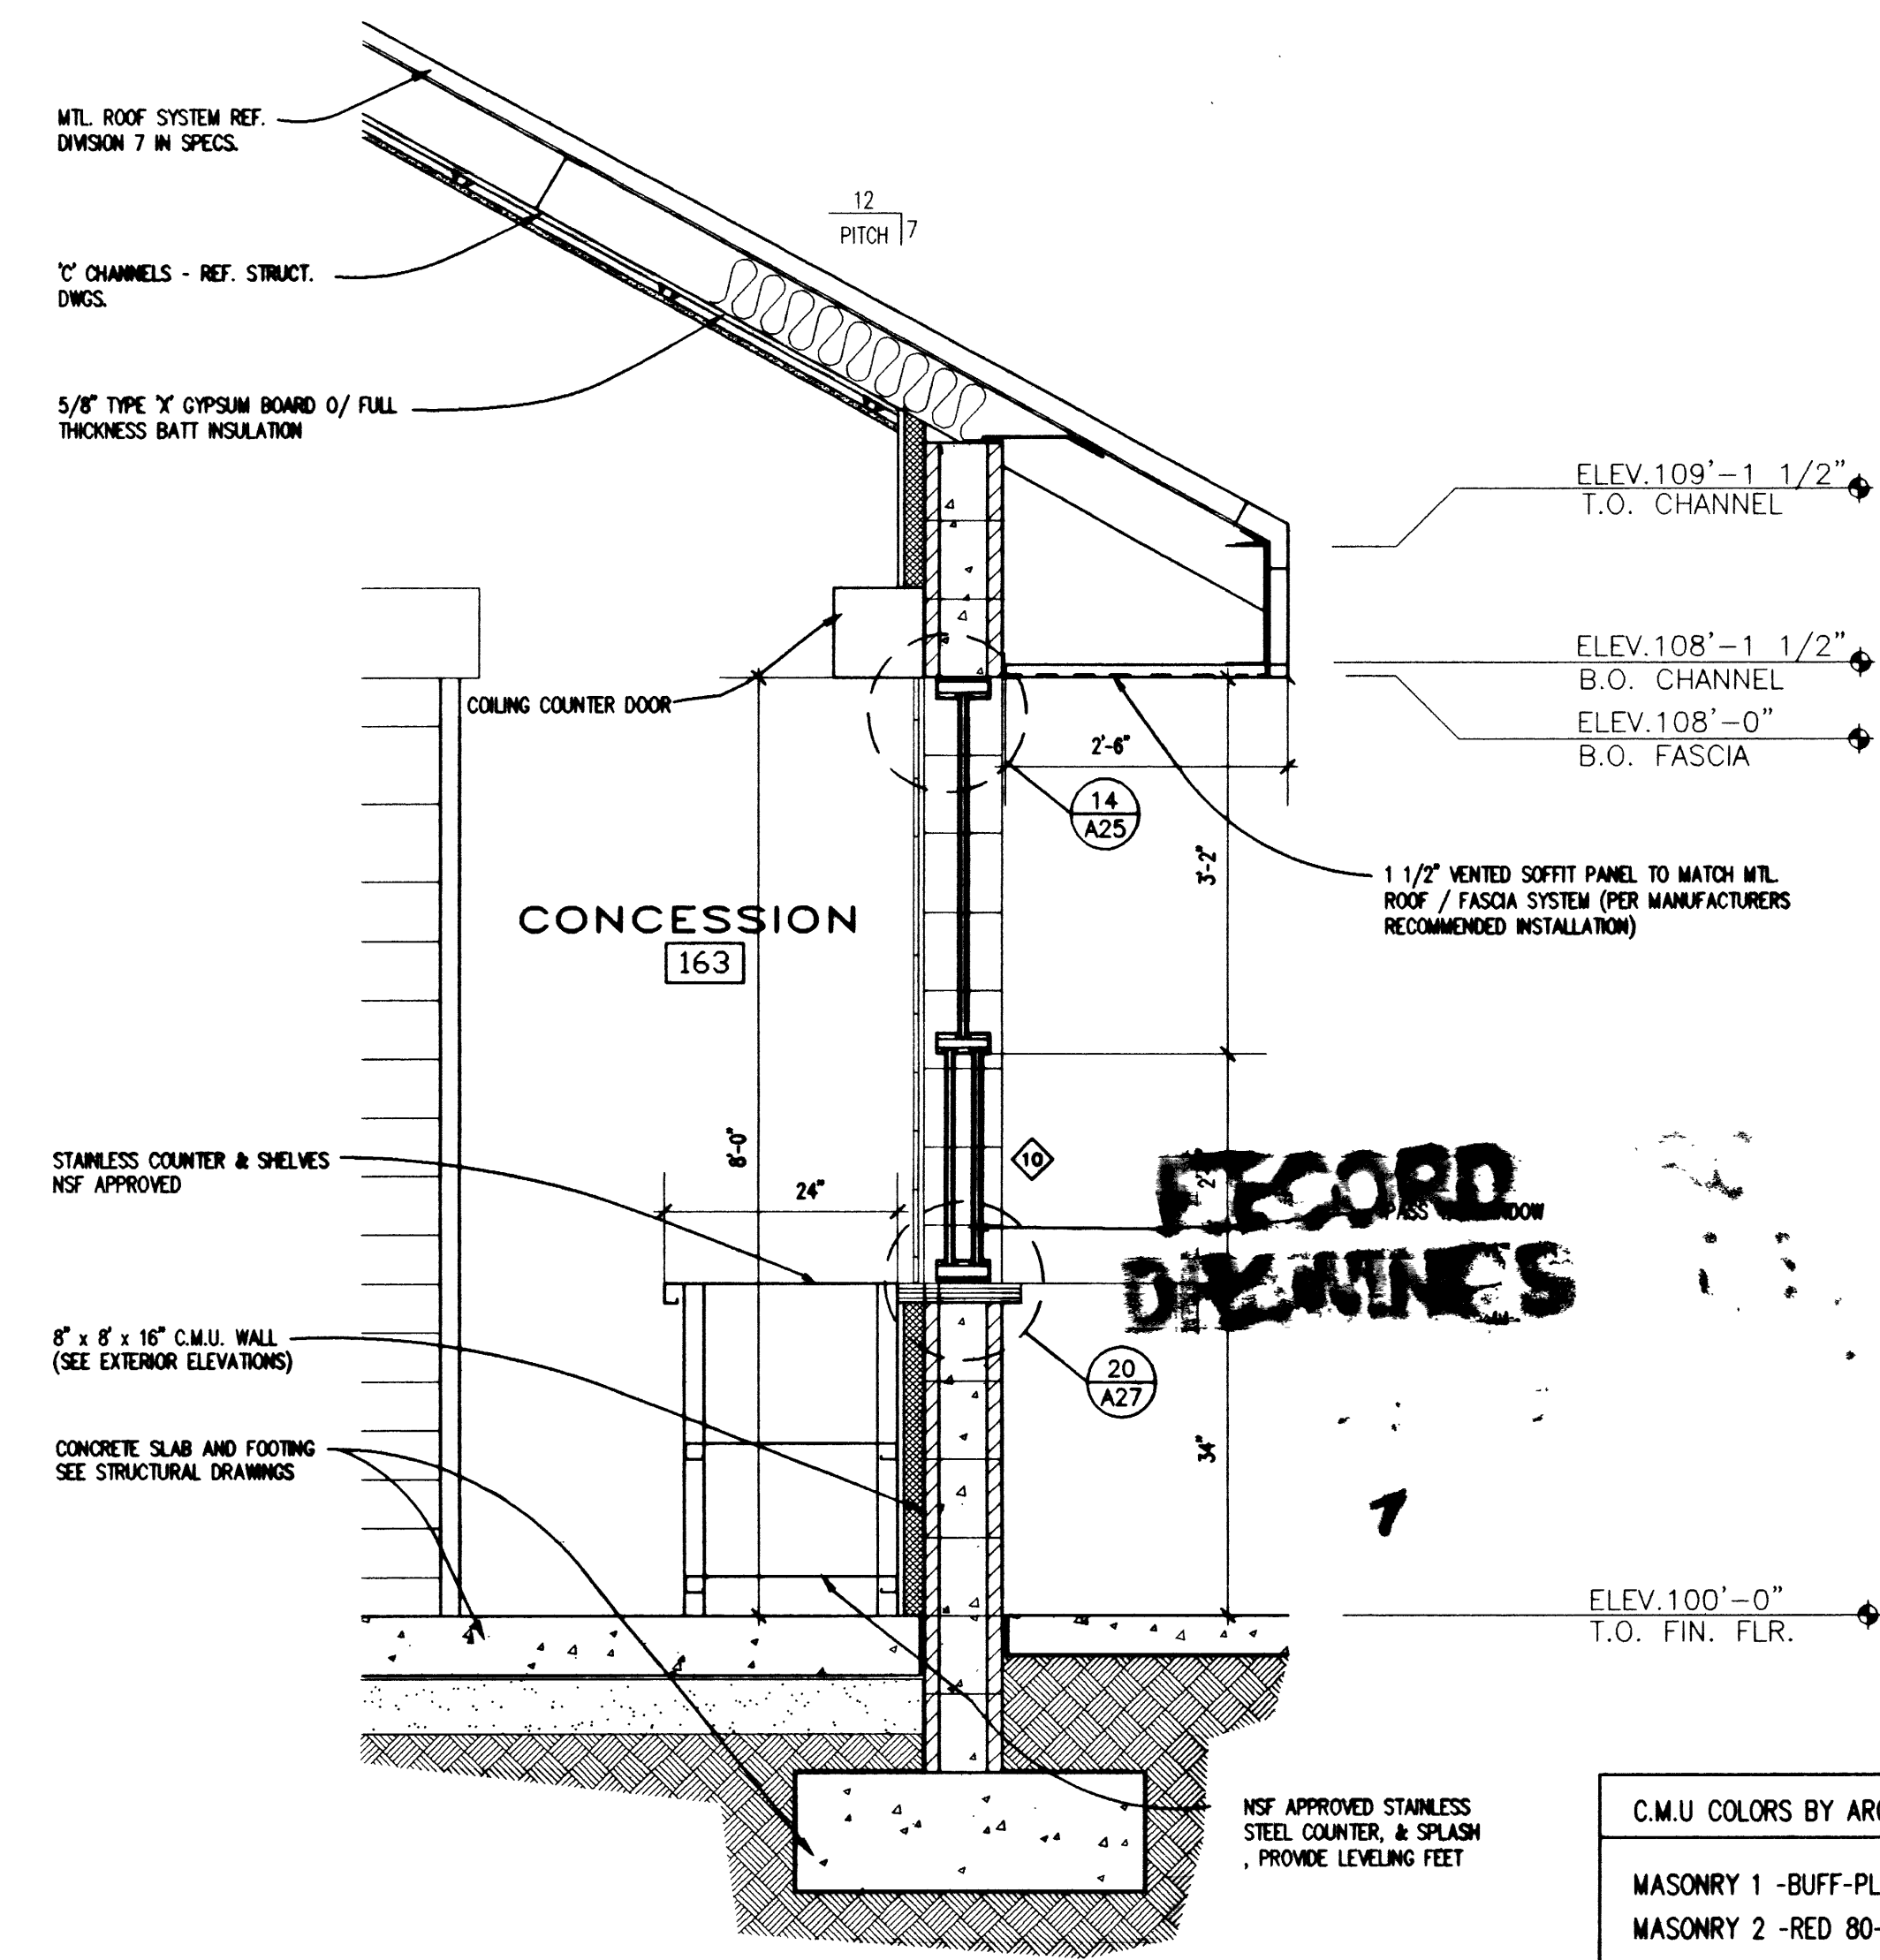

3 WALL SECTION @ EXTERIOR WALL
SCALE: 3/4" = 1'-0"

RECORD DRAWINGS

RECORD DRAWINGS

68 OF 118

650.59

CMU COLORS BY ARCH.
MASONRY 1 - BUFF-PLAIN
MASONRY 2 - RED 80-S SCORED
MASONRY 3 - RED 250-SPLIT FACE
MASONRY 4 - RED 80-SPLIT FACE

27 OF 38

DATE	
------	--

DESCRIPTION	
REVISION	

WAYNE SCHREINER AIA
THOMAS M. SILVA AIA

1525 WEST OAKLEY BLVD.
LAS VEGAS, NV, 89102
(702) 383-0077
FAX (702) 383-0057

Sheet Title: WALL SECTIONS
Job Title: CITY OF LAS VEGAS DEPARTMENT OF PARK AND LEISURE ACTIVITIES DURANGO RECREATION FACILITY
Job: 960901
Date: 20 FEB. 1998
Drawn By: CRL
Check: WPS
Sheet: A22

Verify all Dimensions and Conditions of the Site

2709D

650.59