



1 WALL SECTION @ EXT. WALL
SCALE: 3/4" = 1'-0"

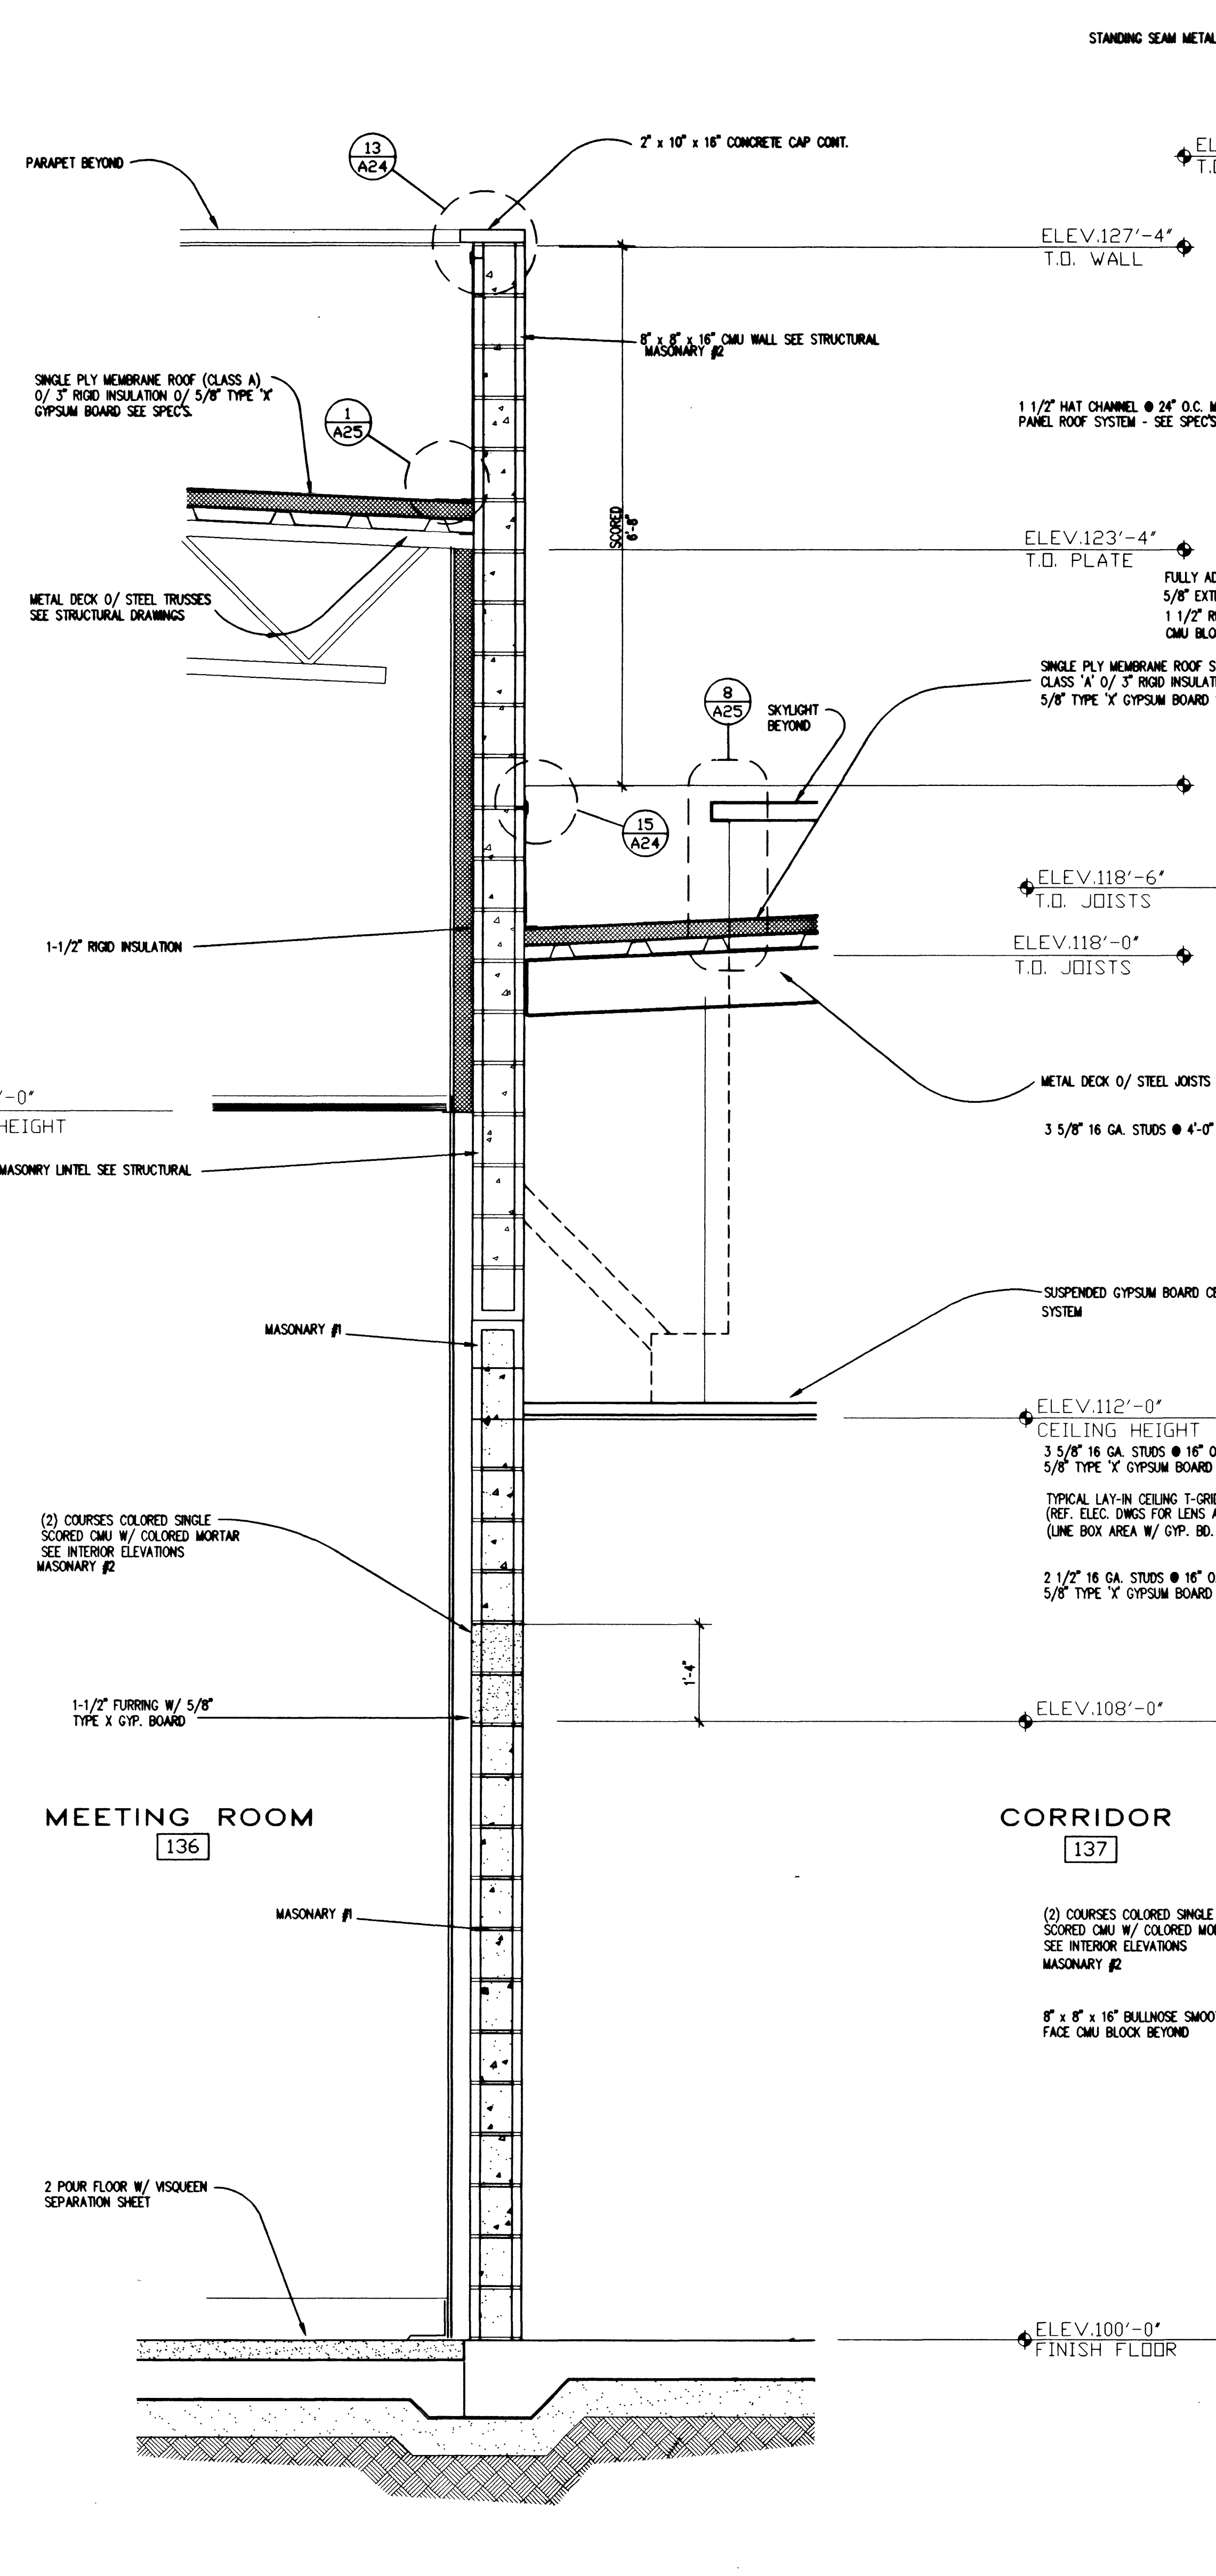

2 WALL SECTION @ MEETING ROOM 136
SCALE: 3/4" = 1'-0"

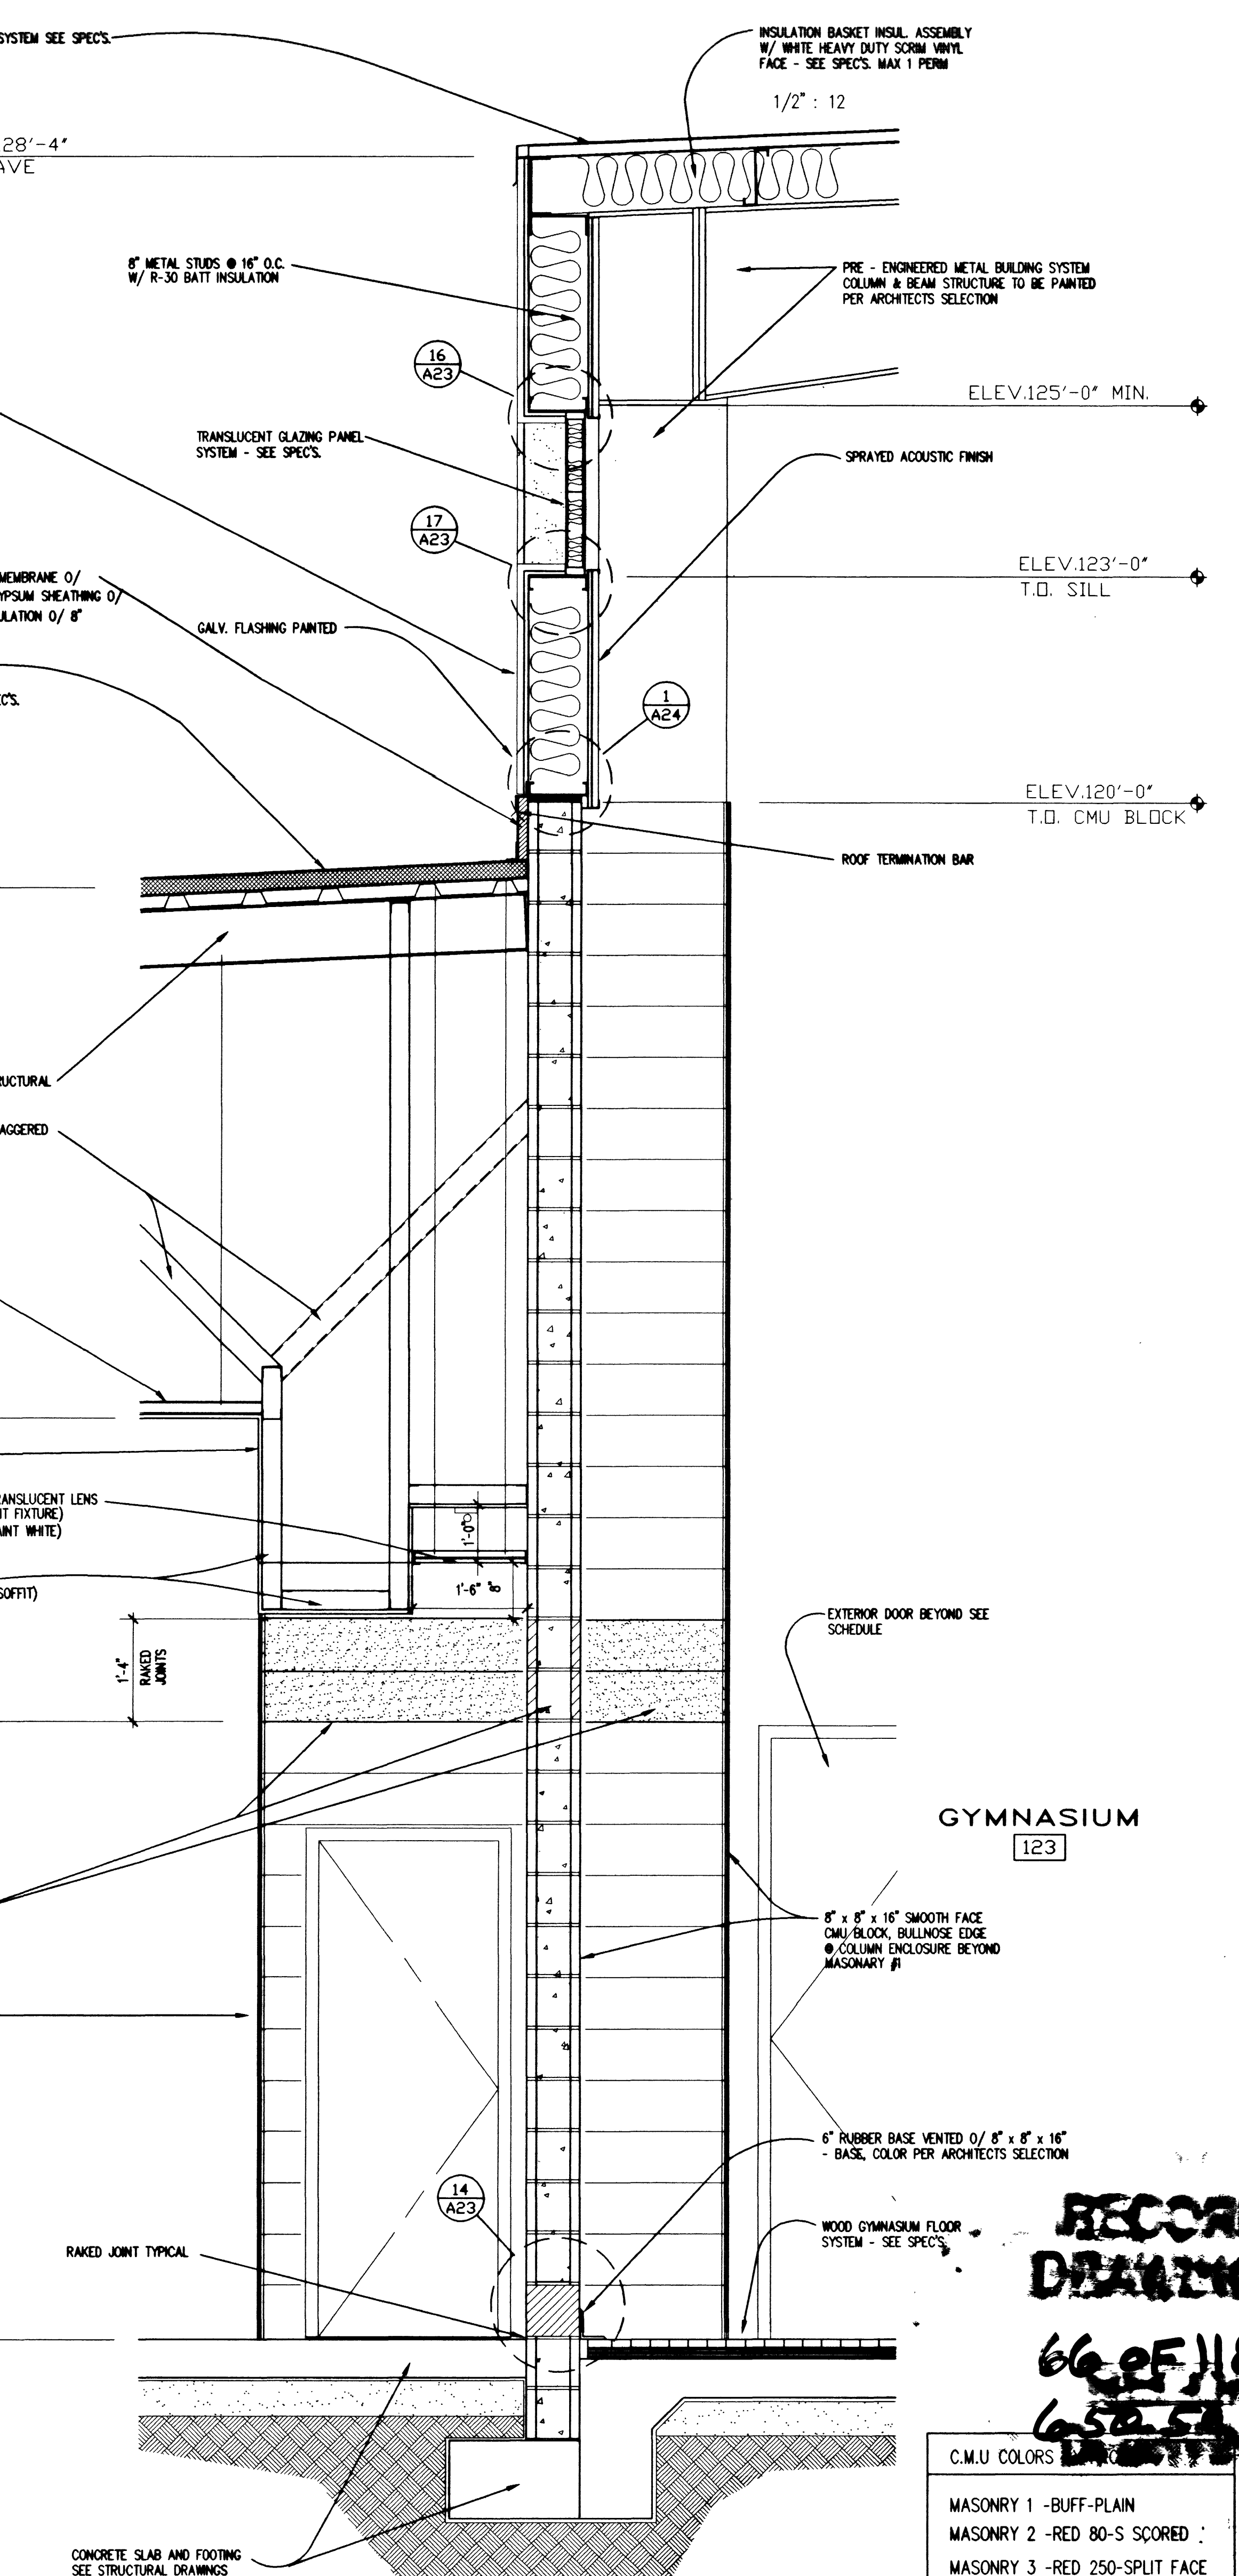

3 WALL SECTION @ CORR./GYM
SCALE: 3/4" = 1'-0"

RECORD DRAWINGS
66251180
65251180

C.M.U. COLORS

- MASONRY 1 - BUFF-PLAIN
- MASONRY 2 - RED 80-S SCORED
- MASONRY 3 - RED 250-SPLIT FACE
- MASONRY 4 - RED 80-SPLIT FACE

DATE	
DESCRIPTION	
REVISION	

WAYNE SCHREINER AIA
THOMAS M. SILVA AIA

1535 WEST OAKLEY BLVD.
LAS VEGAS, NV 89102
(702) 384-0070
FAX: (702) 384-0057

HSA ARCHITECTS

Job Title: WALL SECTIONS
Job Title: CITY OF LAS VEGAS DEPARTMENT OF PARK AND LEISURE ACTIVITIES
DURANGO RECREATION FACILITY
Verify all Dimensions and Conditions at the Site

Job: 960901
Date: 20 FEB. 1998
Drawn By: CRL
Check: WPS
Sheet: A20
25 of 36

Copyright 1997, HSA ARCHITECTS, INC.

27078