

LIMIT OF THIS PROJECT

MATCH LINE

N.I.O.

Community Center

MATCH LINE

NOTES:

- ① CIRCUIT TO EXISTING PANELS AND BREAKERS PROVIDE UNDER BUILDING CONTRACT.
- ② 1" C.O. STUB-OUT, GAP AND PROVIDE SURFACE MARKER.
- ③ SEE SHEET E2.1 FOR WORK IN THIS AREA.
- ④ ALL WALKWAY LIGHTING CIRCUITS IS 2#6, 1#6 GND, 3/4" C UNLESS NOTED OTHERWISE.
- ⑤ ALL PARKING LOT LIGHTING CIRCUITS IS 3#6, 1#6 GND, 1" C UNLESS NOTED OTHERWISE.
- ⑥ ROUTE VIA CONTACTOR.
- ⑦ PROVIDE TIMING CONTROL CENTER EQUAL TO INTERMATIC TBS113C COMPLETE WITH PHOTOCONTROL. MOUNT CONTACTOR AND TIMING CONTROL CENTER ON WALL ADJACENT TO PANEL. PROGRAM TO CONTROL LIGHTING PER OWNER'S INSTRUCTIONS.
- ⑧ MOUNT INDICATED FIXTURE INVERTED FOR UPLIGHTING STRUCTURE.

WORKSHOP



KROB CONSULTING ENGINEERS, INC.
 1819 S. JONES BLVD. SUITE B
 LAS VEGAS, NEVADA 89102
 (702) 871-3621
 ELECTRICAL ENGINEERING

NORTHWEST FAMILY RECREATIONAL COMPLEX
 CITY OF LAS VEGAS, NEVADA

ELECTRICAL SITE PLAN

CONSTRUCTION DOCUMENTS
 ISSUE DATE 10/24/97
 DRAWN: JTKM JOB NO: 765/SITE 2
 REVIEWED: TOM KROB
 REVISIONS/DESCRIPTION:
 1. 6/30/98 APPENDIX #

PROJECT KEY MAP: NTS

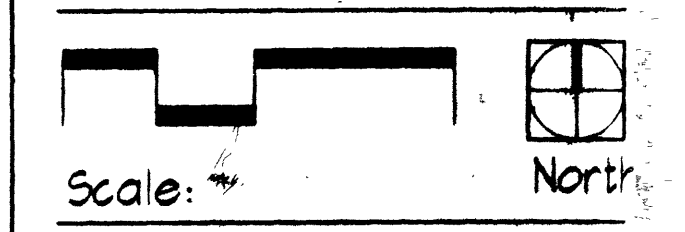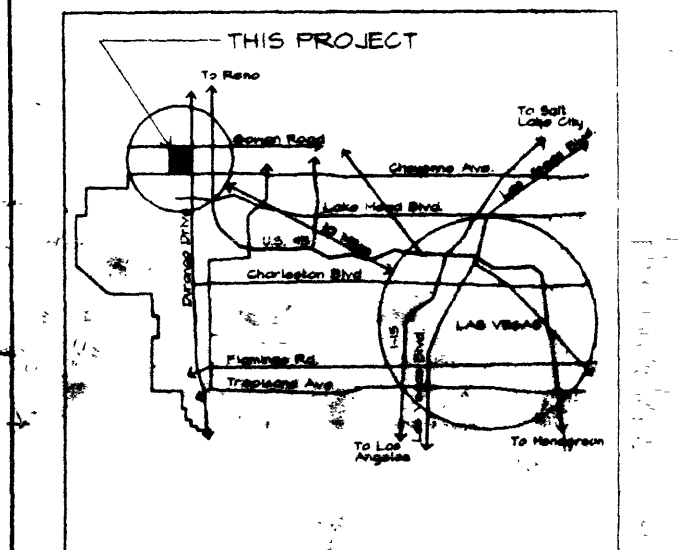

SHEET NUMBER
E-2.2

Design Workshop, Inc. *OD*
35 OF 37
 6/30/98

DURANGO DRIVE

MATCH LINE

N.I.O.

NO 3-1/2
 TO HS
 1-184 C.O.

1.85
 PERCY
RECORD DRAWINGS
38 OF 118
650.59

ELECTRICAL SITE 2 PLAN
 SCALE: 1" = 50'-0"

LIMIT OF THIS PROJECT

27050