


**ELECTRICAL LIGHTING PLAN**

SCALE: 1"=40'-0"

**NOTES (THIS SHEET ONLY):**

- ① 2#4 1#8 2" PVC (CKT B)
- ② 2#4 1#8 3#10 2" PVC (CKT B PHOTOCELL)
- ③ INTERCEPT EXISTING 2" PVC INTERCONNECT CONDUIT AND EXTEND AS INDICATED INTO NEW NO. 5 PULLBOXES. PROVIDE FULLSTRING BETWEEN PULLBOXES. VERIFY LOCATION WITH GLV.
- ④ EXISTING PULLBOX. VERIFY EXACT LOCATION IN FIELD.
- ⑤ 2" PVC INTERCONNECT CONDUIT WITH FULLSTRING.
- ⑥ INTERCEPT EXISTING ② 3" PVC AND EXTEND AS INDICATED INTO NEW NO. 7 PULLBOX. PROVIDE FULLSTRING TO EXISTING PULLBOX.
- ⑦ NO. 5 INTERCONNECT PULLBOX.
- ⑧ 2#10 1#8 2" PVC TO SERVICE PEDESTAL SP-1.
- ⑨ NO. 7 TRAFFIC SIGNAL PULLBOX.
- ⑩ ② 3" PVC WITH FULLSTRING (TRAFFIC SIGNALS).
- ⑪ 2#4 1#8 IN NEW 1/4" PVC (STREET LIGHTING). CONNECT TO EXISTING 1/4" PVC. EXTEND NEW WIRE TO EXISTING PULLBOX. DO NOT CONNECT WIRES AT EITHER END OF CONDUIT IN PULLBOX.
- ⑫ NOT USED.
- ⑬ 2#4 1#8 IN NEW 2" PVC. DO NOT CONNECT WIRES AT EITHER END OF CONDUIT IN PULLBOX.
- ⑭ 2" PVC WITH FULLSTRING STUB AND CAP 5' BEYOND PROJECT LIMITS. MARK LOCATION AS DIRECTED BY GLV.
- ⑮ 4" 2" PVC WITH FULLSTRING TO TEMPORARY PULLBOX AT LOCATION OF FUTURE TRAFFIC SIGNAL CONTROLLER. SEE SHEET SL1 FOR TEMPORARY PULLBOX LOCATION.

**RECORD DRAWINGS**  
**40 OF 118**  
**650.59**

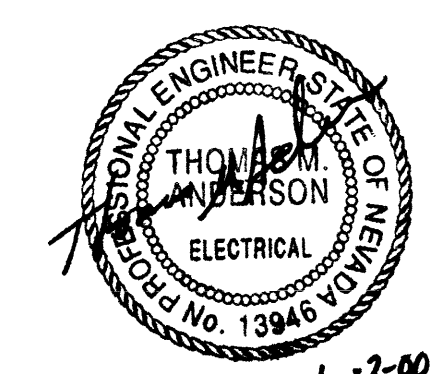

<p><b>GREELEY AND HANSEN</b>          ENGINEERS          4625 SOUTH POLARIS AVENUE, SUITE 210          LAS VEGAS, NEVADA 89103</p>	<p>6-2-00 AS BUILT</p>	<p><b>TJKROB CONSULTING ENGINEERS, INC.</b>          1919 S. JONES BLVD. SUITE B          LAS VEGAS, NEVADA 89102          (702) 871-5621          ELECTRICAL ENGINEERING</p>	<p>DSN          KM          TOM KROB</p>	<p>CITY OF LAS VEGAS, NEVADA          DEPARTMENT OF PUBLIC WORKS          NORTHWEST WATER RESOURCE CENTER</p>	<p>ROADWAY IMPROVEMENTS          DURANGO DRIVE - STA 29+17 TO 38+00          ELECTRICAL LIGHTING PLAN</p>	<p>765/LTS2          SL2 40          37          2/25/08</p>
--	------------------------	---	--	---	---	--

27052

650.59