


CONSTRUCTION NOTES

- | No. | DESCRIPTION |
|-----|---|
| 1 | CURB & GUTTER
1" TYPE
CC STD DWG 216 |
| 2 | CROSS GUTTER
CC STD DWG 228 |
| 3 | ROLL CURB-24"
CC STD DWG 217 |
| 4 | "A" TYPE ISLAND CURB SECTION
CC STD DWG 219 |
| 5 | 24' RESIDENTIAL
DRIVEWAY
CC STD DWG.
223 |
| 6 | NOT USED |
| 7 | SIDEWALK RAMP
CASE II - A=6.5', B=6.5'
CC STD DWG 235 |
| 8 | SIDEWALK DRAIN
CC STD DWG 236 |
| 9 | SIDEWALK
CASE I
CC STD DWG 235 |
| 10 | SIDEWALK
CC STD DWG 234
WIDTH PER PLAN |

RECORD DRAWINGS
9 OF 118
650.59
RECORD DRAWING

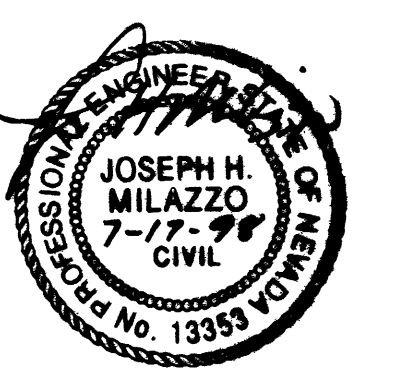

This drawing is the property of HARDING LAWSON ASSOCIATES, including all patented and patentable features, and/or confidential information and its use is conditioned upon the user's agreement not to reproduce the drawing, in whole or part, nor the materials described therein, nor the use of the drawing for any purpose other than specifically permitted in writing by HARDING LAWSON ASSOCIATES.

NO.	DATE	REVISIONS	BY	CHK
1	7/2/98	ADDENDUM 2 9/11/98	JFM	CAH

DRAWN:	JAC	PROJECT NO:	41712	FILE NAME:	CDGRADE2
ENGINEER:	DAE	SCALE:	1"=30'		
CHECKED:	SWJ	APPROVED:	JFM		
DATE:	10-30-97	DATE:	7-17-98		

Harding Lawson Associates
Engineering and Environmental Services
5145 S. Arville St. Ste. A
Las Vegas, Nevada
(702) 251-5449

NORTHWEST FAMILY RECREATION CENTER
CITY OF LAS VEGAS
400 E. STEWART AVENUE
LAS VEGAS, NEVADA

GRADING PLAN

DRAWING:	C8
SHEET:	8 OF 17
REVISION NUMBER:	
DATE:	

2102