


# DEPARTMENT OF PUBLIC WORKS

## OFFICE OF ARCHITECTURAL SERVICES

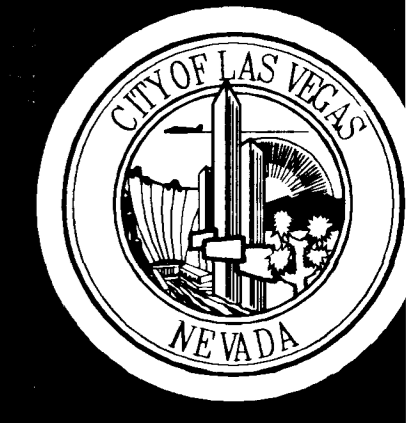

Mayor:  
OSCAR B. GOODMAN

City Council:  
GARY REESE  
(Mayor Pro-Tem)  
MICHAEL J. McDONALD  
LARRY BROWN  
LYNETTE B. McDONALD  
LAWRENCE WEEKLY  
MICHAEL MACK

City Manager:  
VIRGINIA VALENTINE

Director of Public Works:  
RICHARD D. GOECKE

Deputy Director of Public Works:  
K. JOHN MCNELLIS, P.E.

LEISURE SERVICES DEPARTMENT

# - ELKHORN SPRINGS PARK -

APPROVED BY: \_\_\_\_\_ DATE: \_\_\_\_\_

K. JOHN MCNELLIS, P.E.  
Deputy Director of Public Works

48211

DEPARTMENT OF PUBLIC WORKS

REVISIONS

RECORD DRAWING, 05/21

CONTRACT

LUCCHESI GALATI ARCHITECTS  
800 PILOT ROAD, SUITE A  
LAS VEGAS, NEVADA 89119  
(702) 263-7111

RECORD DRAWING  
This record drawing prepared by Lucchesi Galati Architects, is based on information provided by others. Lucchesi Galati Architects, Inc. does not assume any liability for or the information supplied by others, and shall not be responsible for any errors or omissions resulting from incorporation herein of a third party's information.

ELKHORN SPRINGS  
NEIGHBORHOOD PARK  
BUFFALO DRIVE  
COVER SHEET

OWNER: CITY OF LAS VEGAS  
DEPARTMENT OF PUBLIC WORKS  
ARCHITECTURAL SERVICES

400 EAST STEWART AVENUE  
LAS VEGAS, NEVADA 89101  
PHONE: (702) 229-6533  
FAX: (702) 382-3223  
TDD: (702) 386-9100

DRAWN: SAC  
FILE: 0011-00-001  
DATE: 3-9-01  
SCALE: NO SCALE  
REV NO: 01530116  
REV DWG NO: 65064  
1 OF 90  
SHEET NO: COVER