



REVISIONS 3-20-02
RECORD DRAWINGS

CONSULTANT
LUCCHESI GALATI
ARCHITECTS
805 PILOT ROAD, SUITE A
LAS VEGAS, NEVADA 89109
(702) 263-7111

R. L. BALOGH
CONSULTING ENGINEERS, INC.
2800 South Rainbow Boulevard, Suite 202
Las Vegas, Nevada 89146
(702) 246-8700 FAX (702) 246-8701

DEPARTMENT OF PUBLIC WORKS
ELKHORN SPRINGS
NEIGHBORHOOD PARK
BUFFALO DRIVE
BASKETBALL COURT
FOUNDATION PLAN

RECORD DRAWING
THIS RECORD DRAWING PREPARED BY
R. L. BALOGH CONSULTING ENGINEERS, INC.
IS BASED ON INFORMATION PROVIDED BY
OTHERS. R. L. BALOGH CONSULTING
ENGINEERS, INC., HAS NOT VERIFIED
THE ACCURACY AND/OR COMPLETENESS
OF THIS INFORMATION SUPPLIED BY
OTHERS, AND SHALL NOT BE RESPONSIBLE
FOR ANY ERRORS OR OMISSIONS
WHICH MAY BE INCORPORATED HEREIN
AS A RESULT.

DEPARTMENT OF PUBLIC WORKS
ARCHITECTURAL SERVICES
400 EAST STEWART AVENUE
LAS VEGAS, NEVADA 89101
PHONE: (702) 229-4335
FAX: (702) 382-3232
TDD: (702) 388-9108


STRUCTURAL ENGINEER
RICHARD L. BALOGH, P.E., S.E.

DRAWN **PYE**
FILE **01.15301.16**
650.64
DATE **MARCH 9, 2001**
SCALE **1/8"=1'-0"**
PROJECT **00056**
SHT NO
67 OF 90

S2.2

POST-TENSIONING NOTES:

1. REFER TO GENERAL STRUCTURAL NOTES SECTION D. FOR POST-TENSIONING NOTES.
2. SEE ARCHITECTURAL AND CIVIL DRAWINGS FOR ADDITIONAL INFORMATION NOT SHOWN.

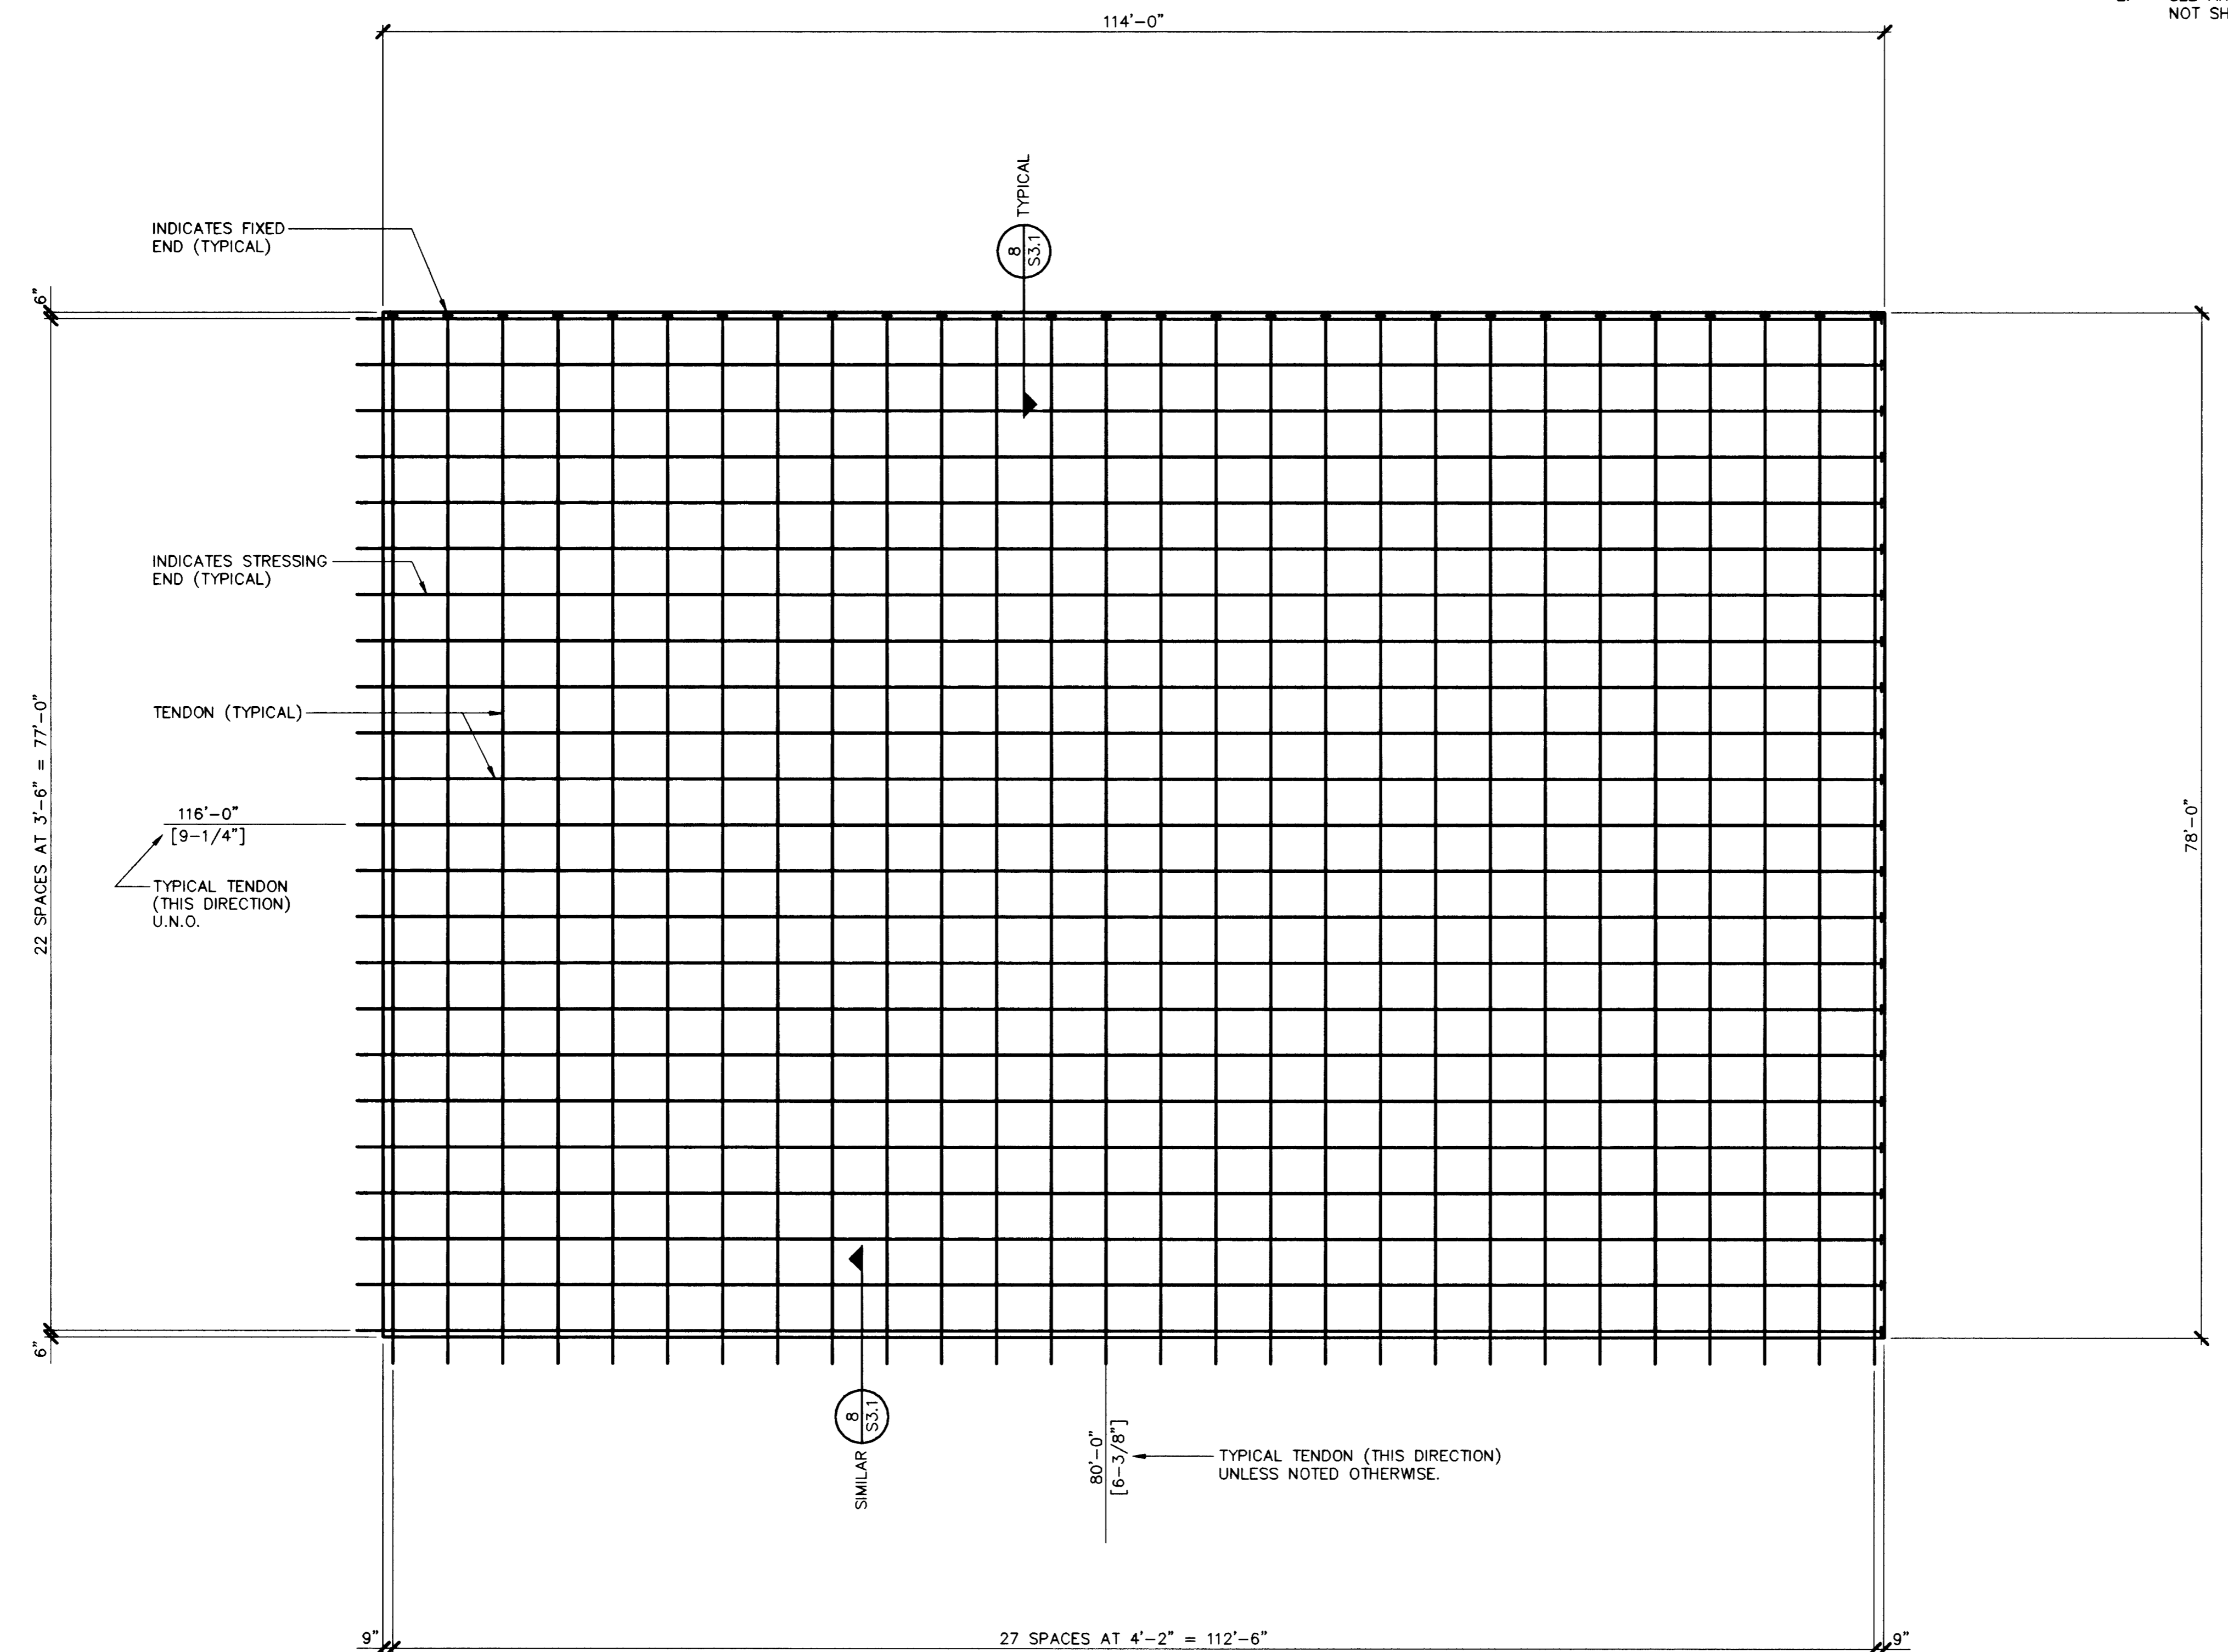

POST-TENSION LAYOUT PLAN

1/4" = 1'-0"



LEGEND:

- XX'-XX" — MINIMUM REQUIRED LENGTH OF TENDON, INCLUDING 2'-0" ADDITIONAL LENGTH FOR STRESSING; ALL SPECIFIED TENDON LENGTHS SHALL BE VERIFIED BY THE CONTRACTOR
- [XXX] TENDON ELONGATION FOR STRESSING OPERATIONS