






135 DETAIL

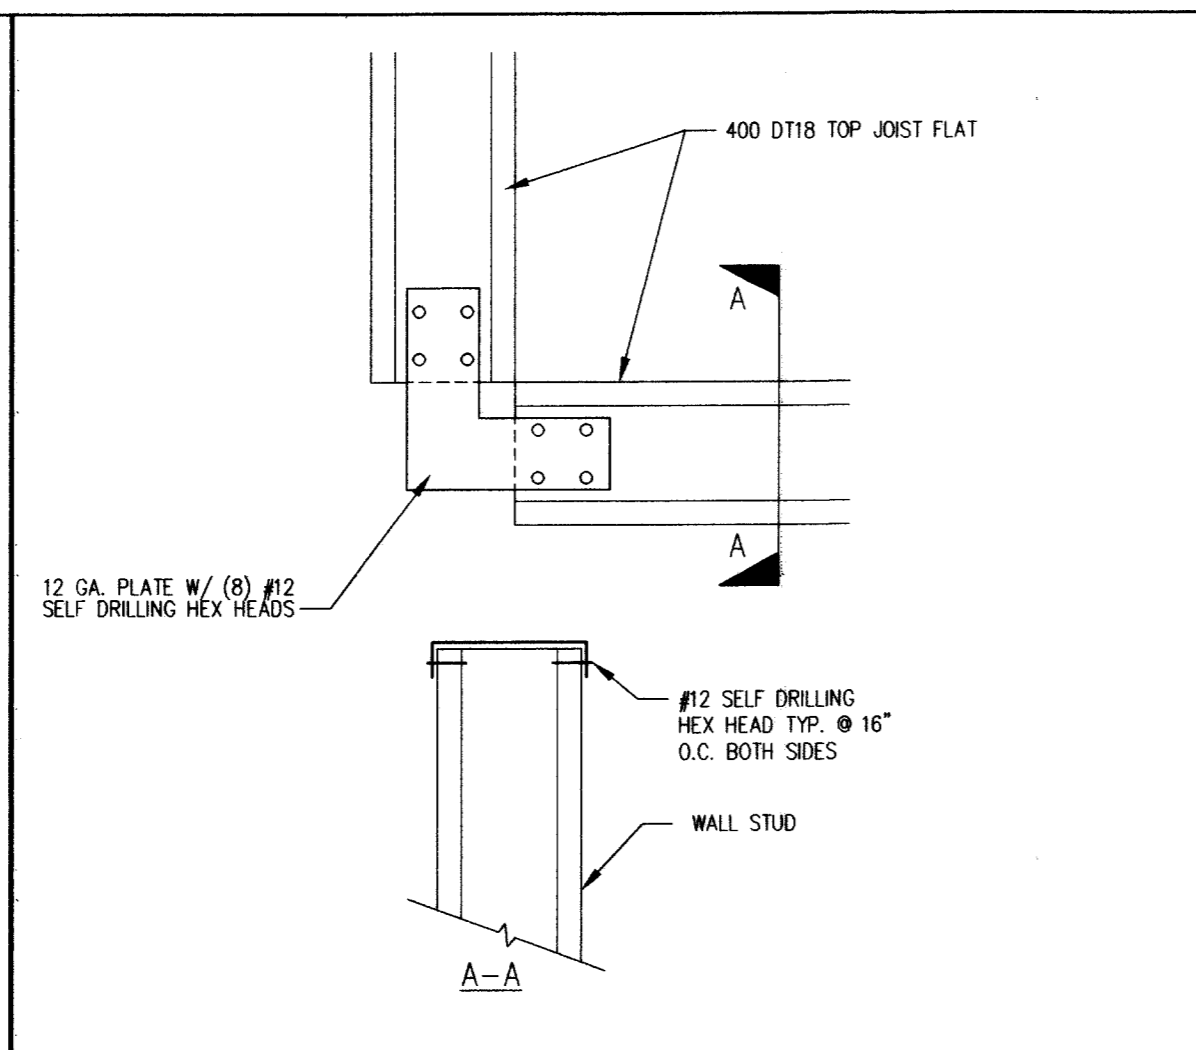


131 STUD CORNER

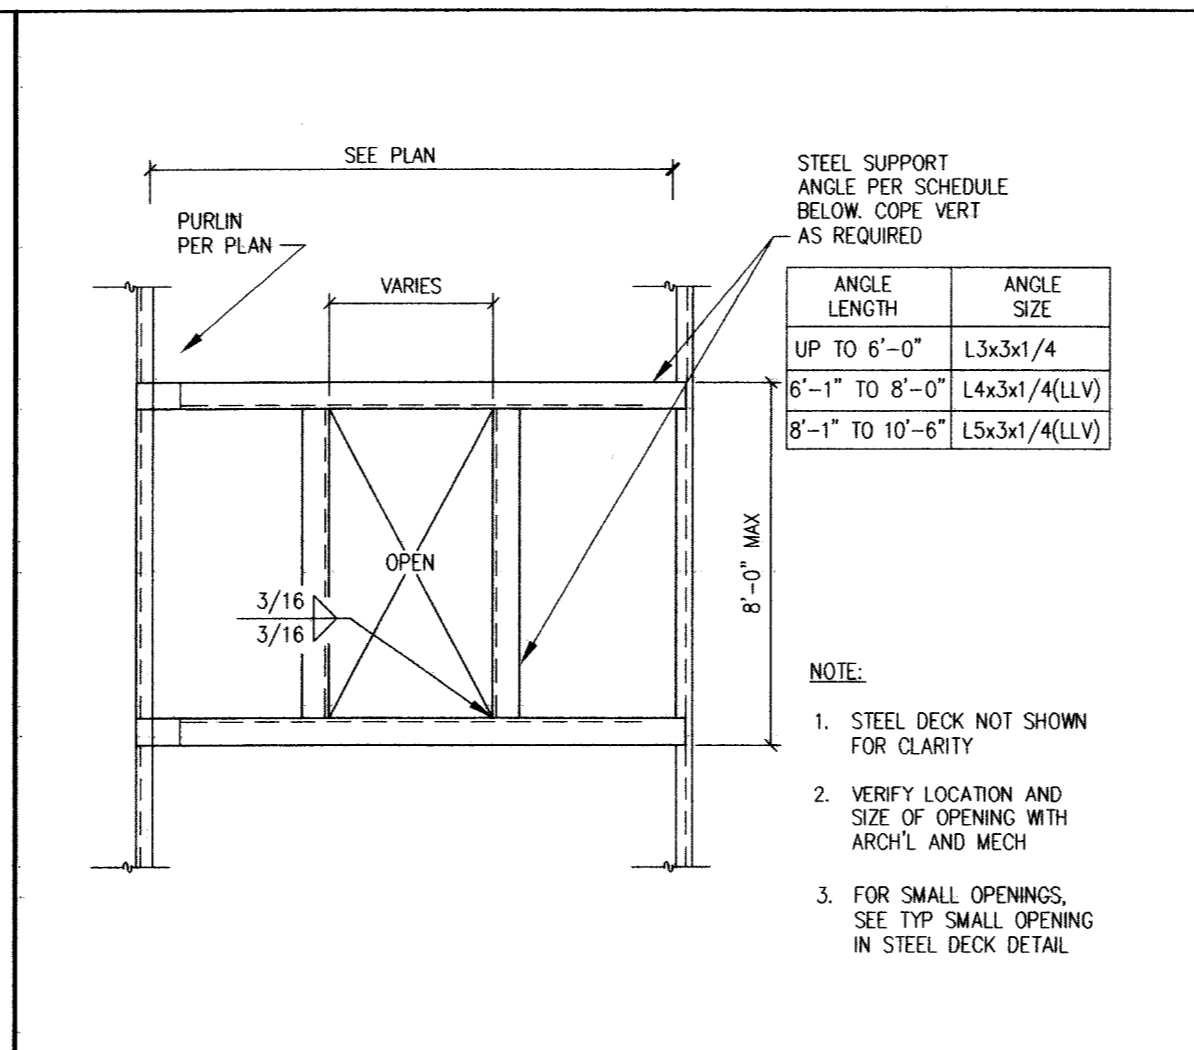

127 TYPICAL OPENING IN ROOF FRAMING (PLAN VIEW)

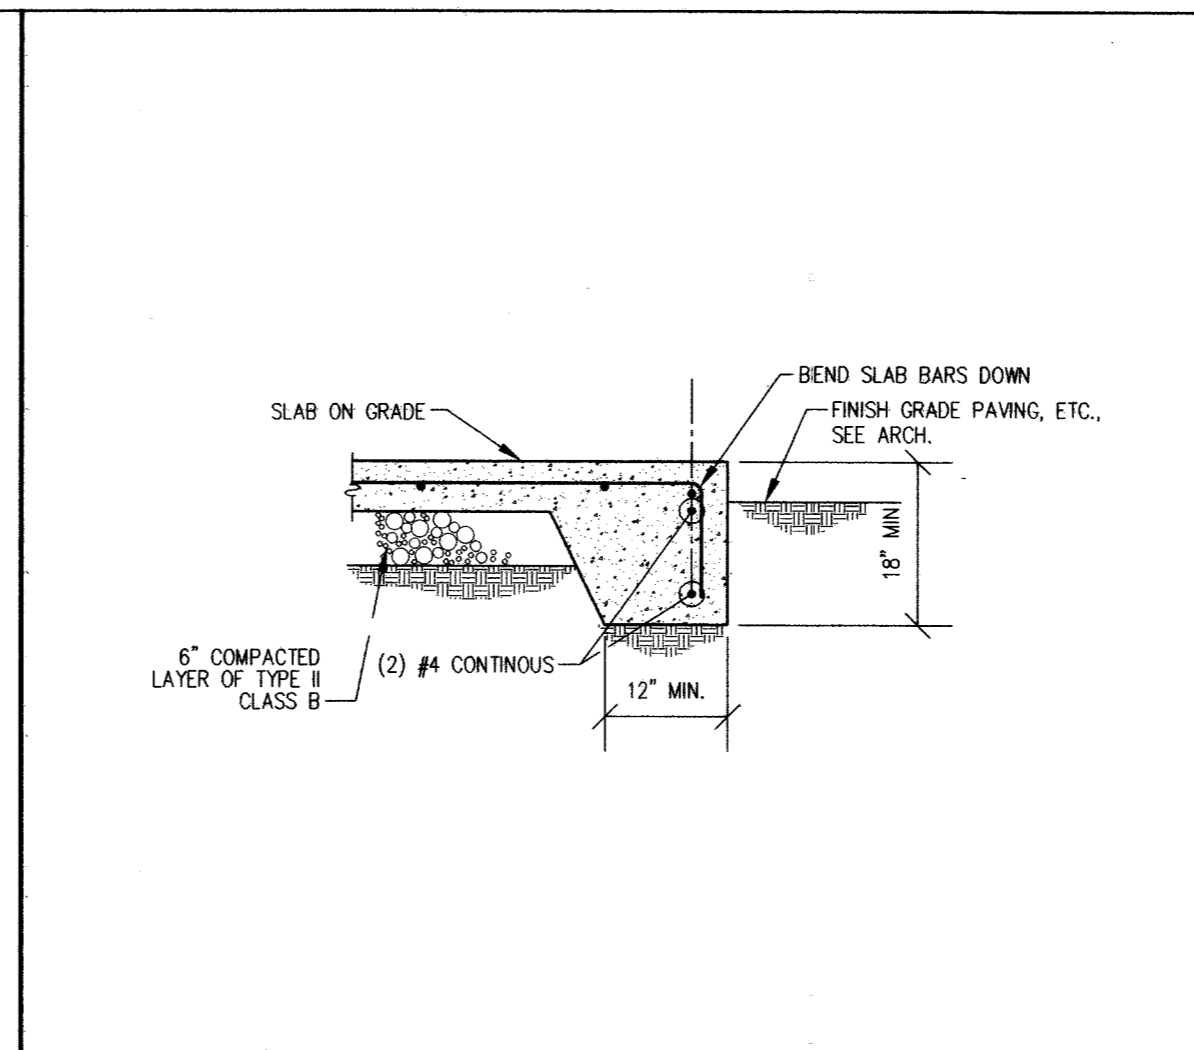


123 THICKENED SLAB

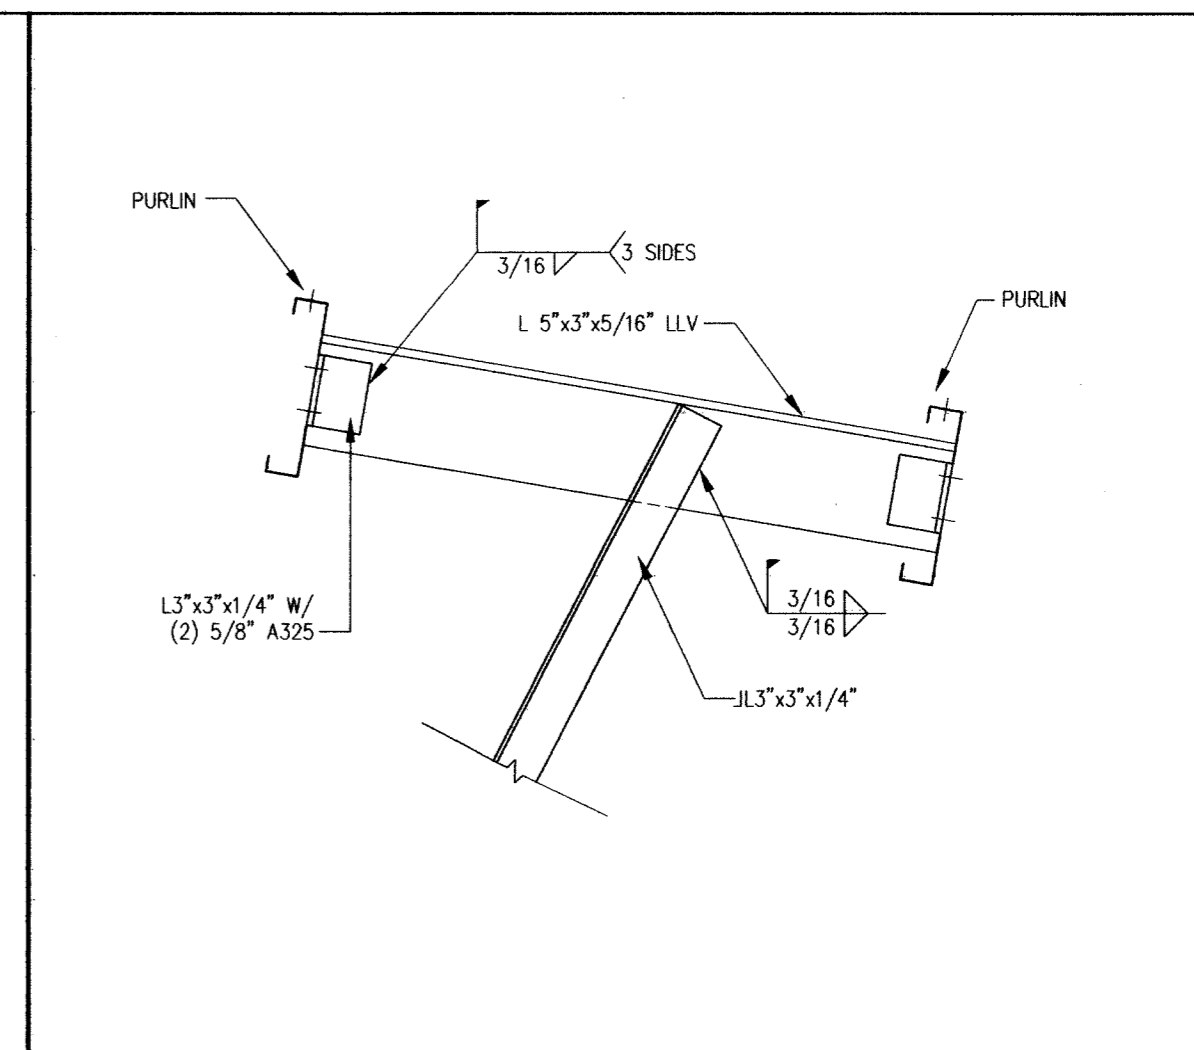


119 WALL BRACE TOP CONNECTION




136 DETAIL

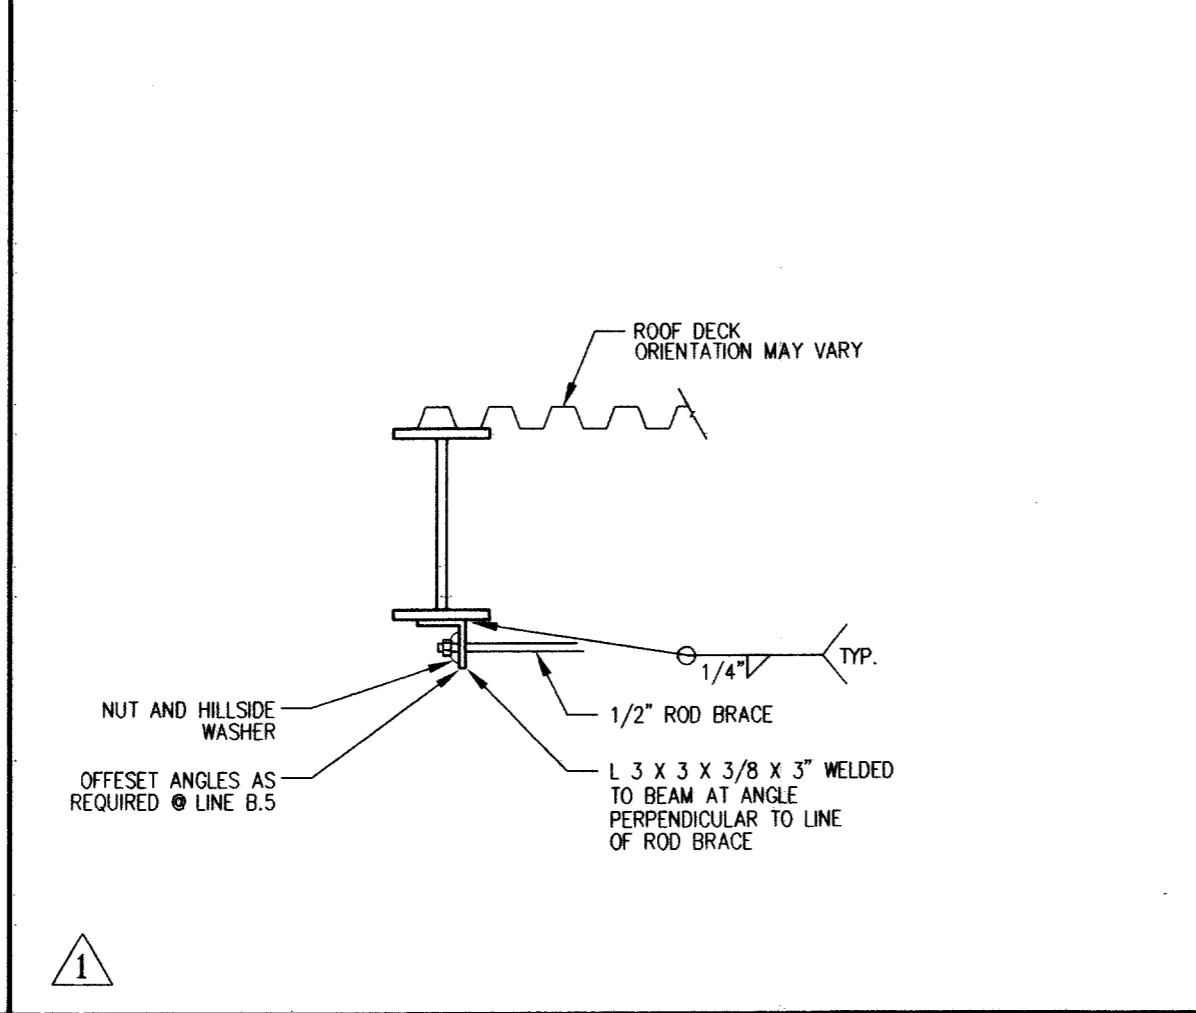


132 WALL TRACK

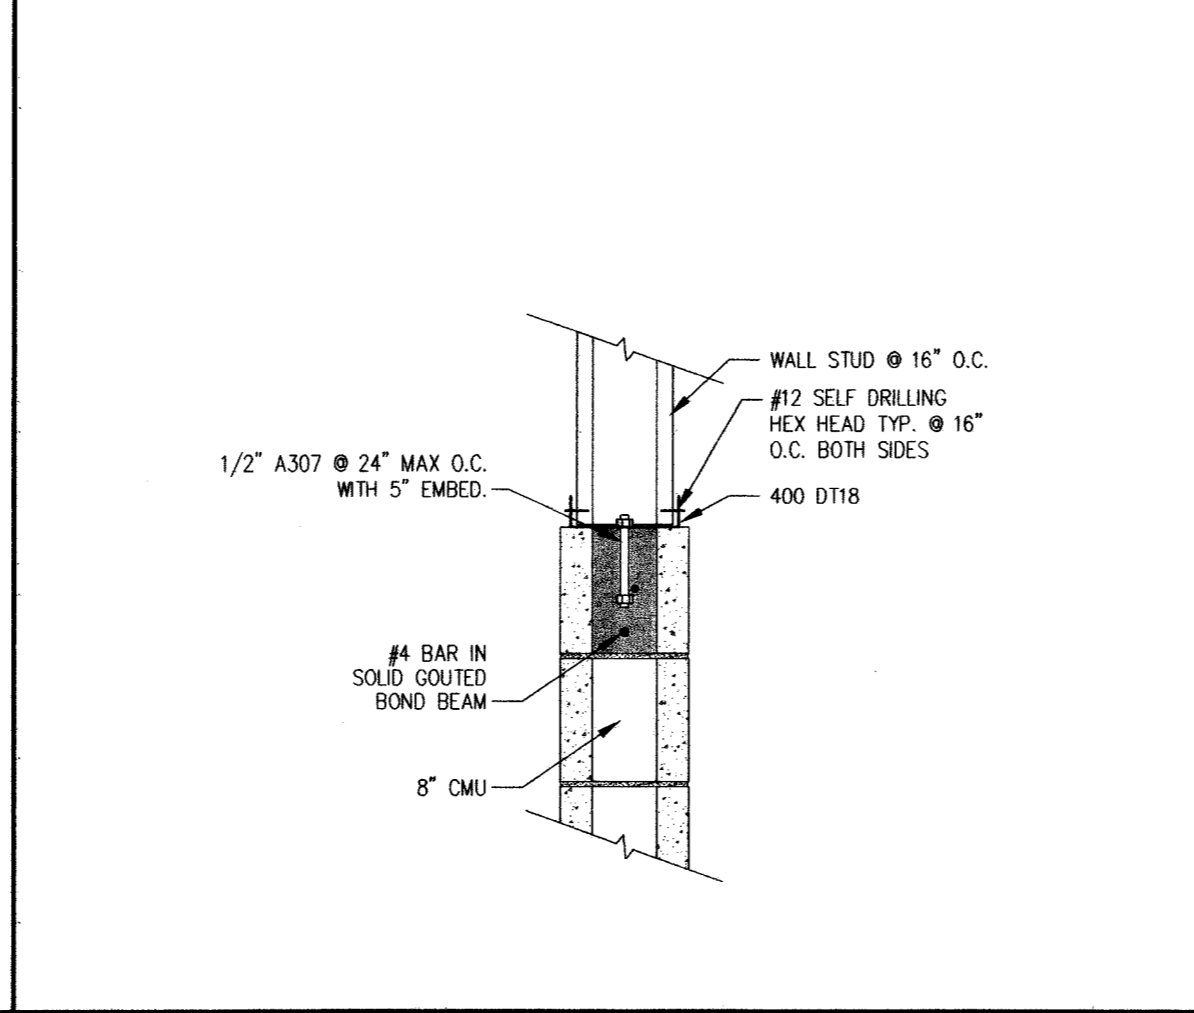


128 SIDEWALK @ SLAB-ON-GRADE

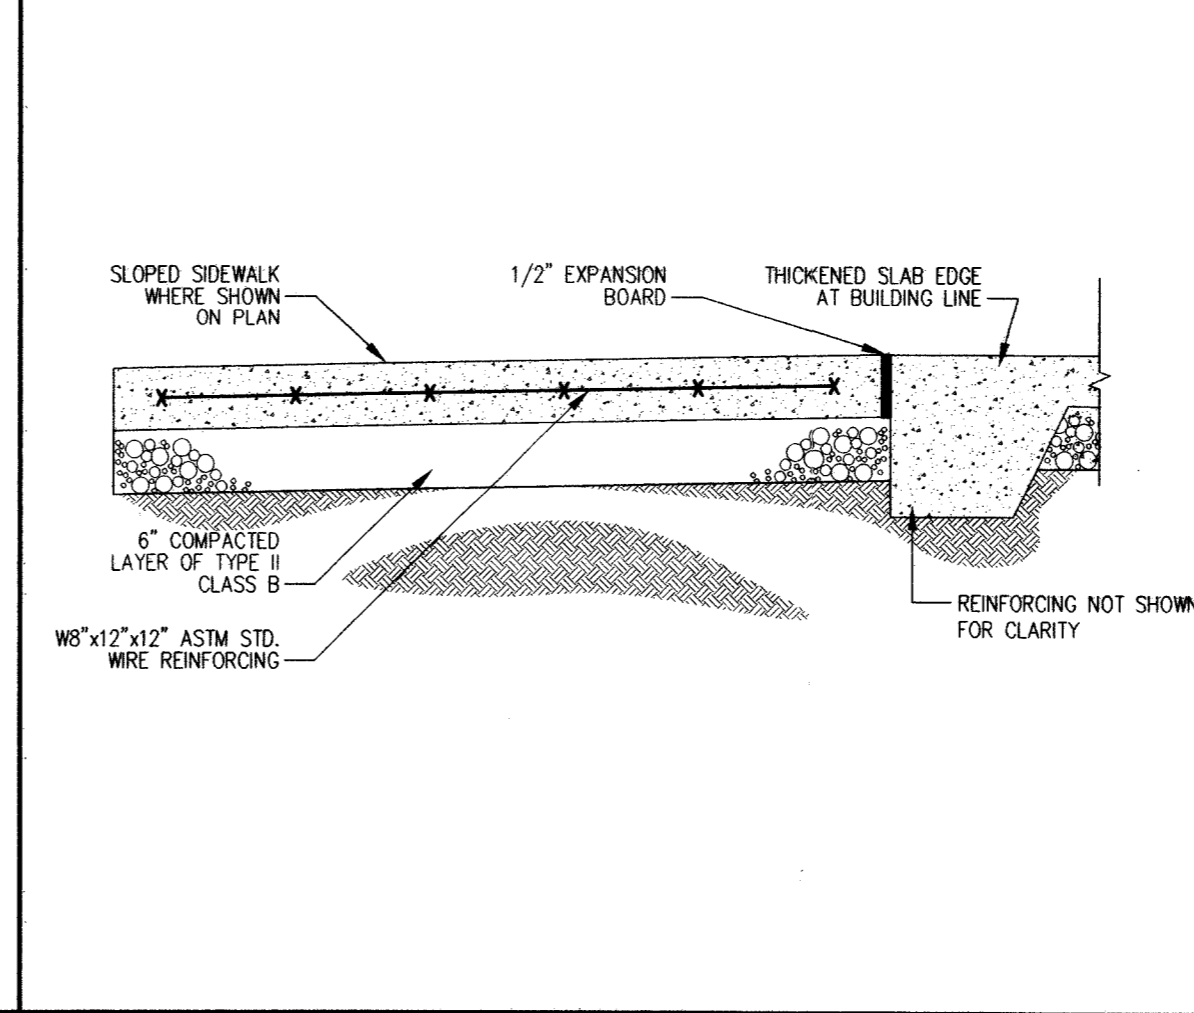


124 LOUVER DETAIL

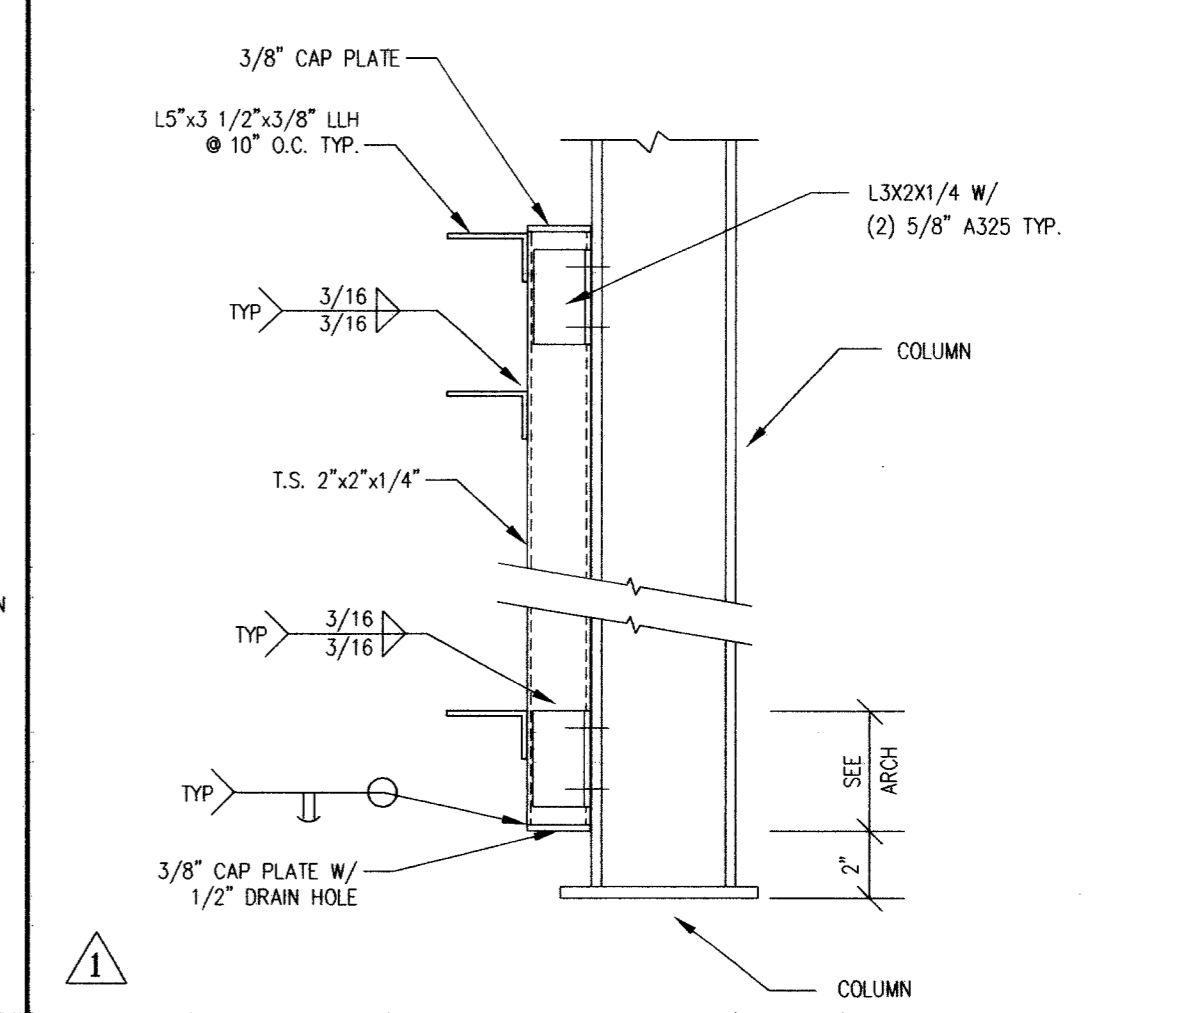


120 ROD BRACING

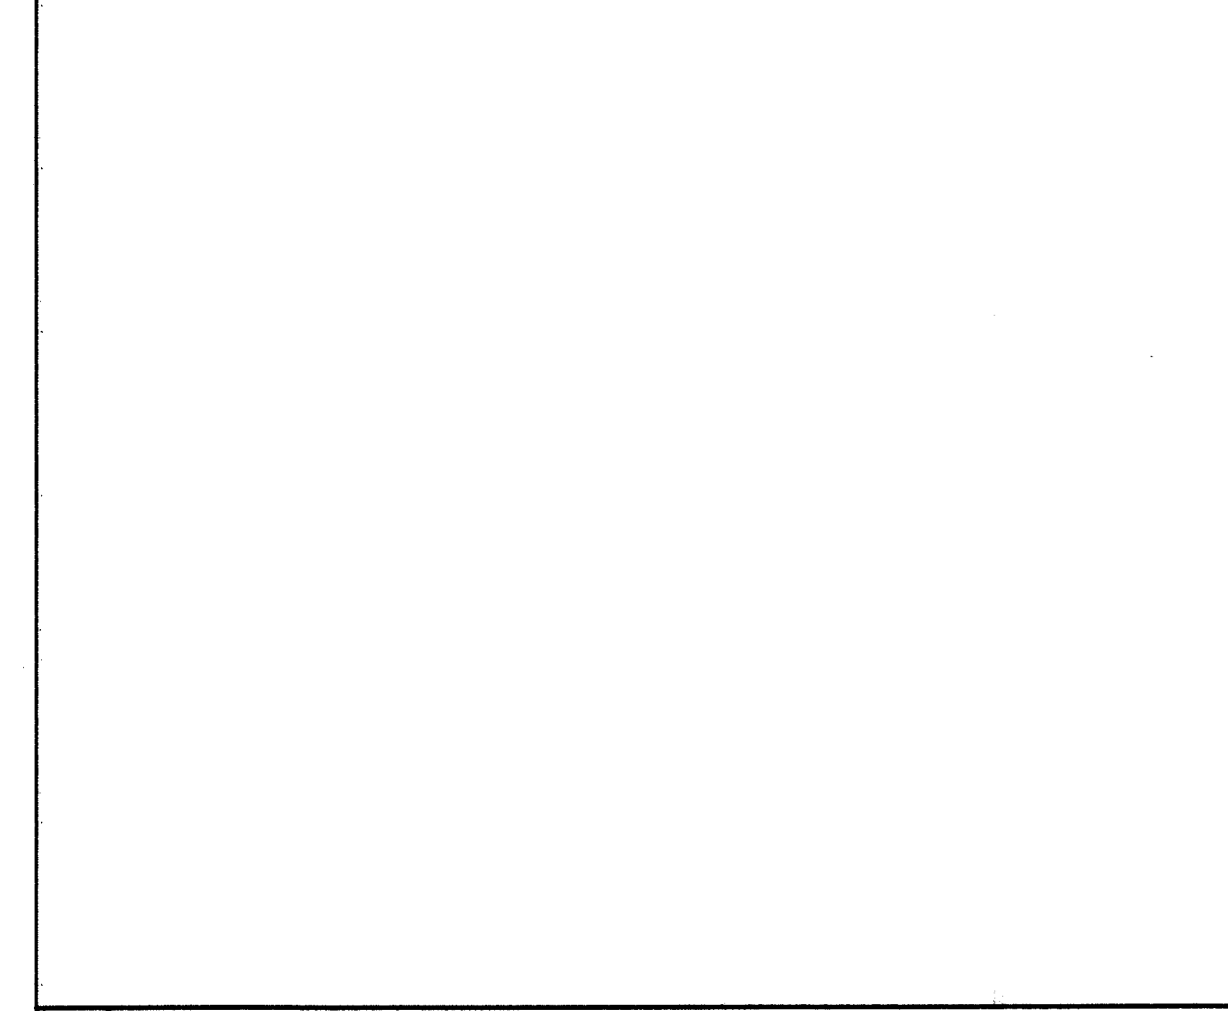


137 SLIP TRACK

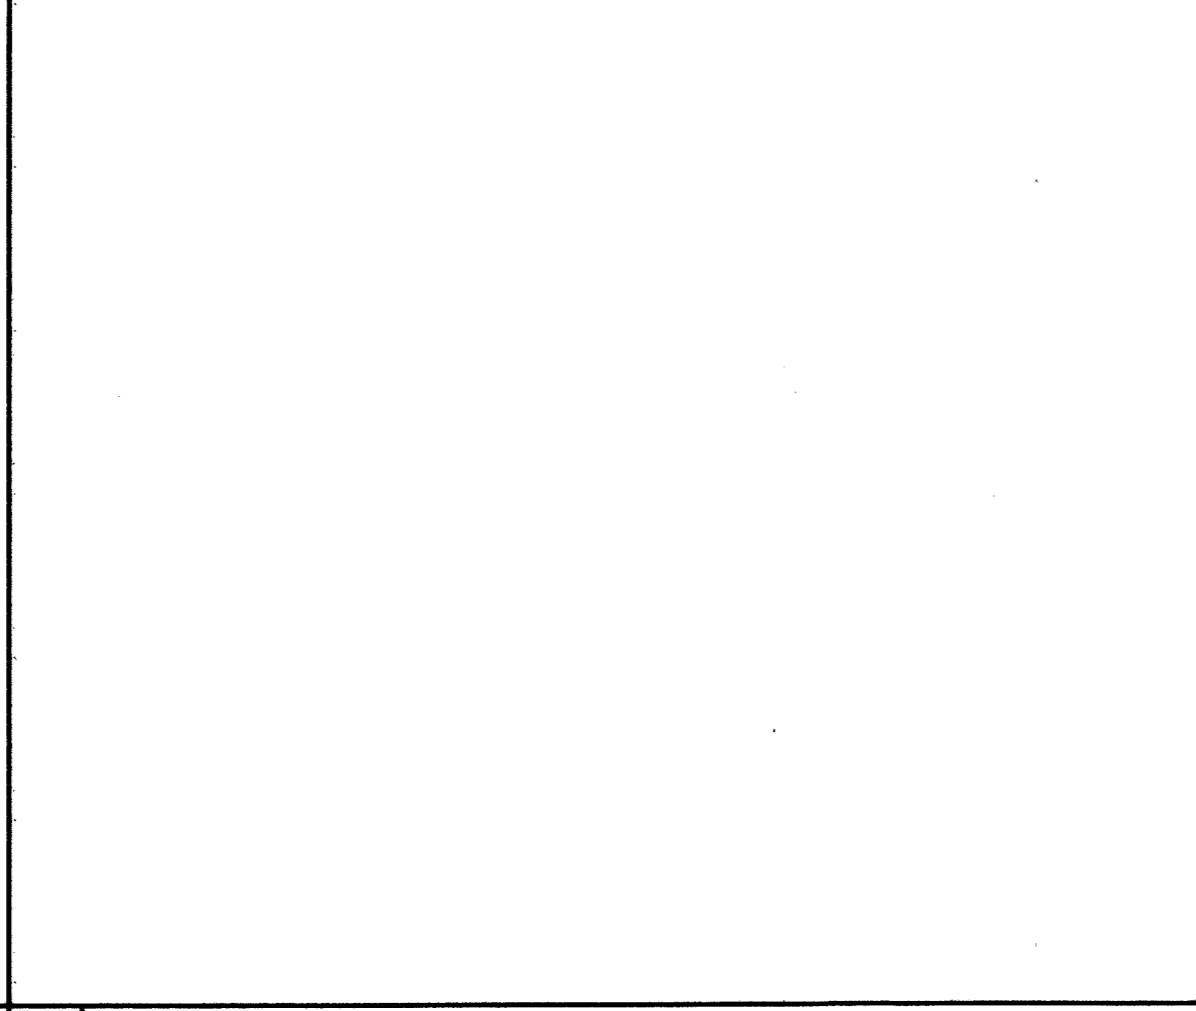


133 LOUVER

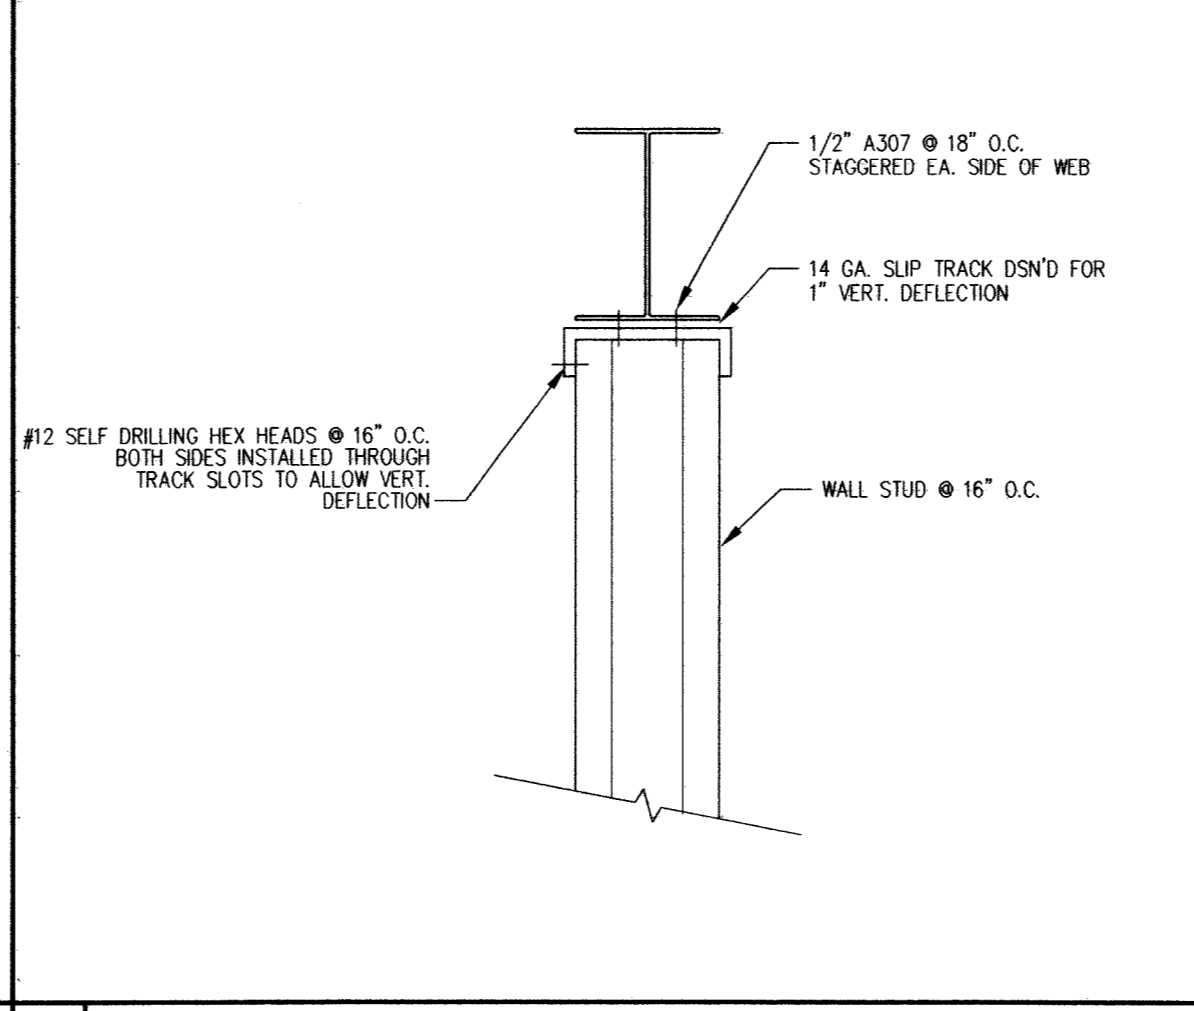

129 TOP OD STUD WALL

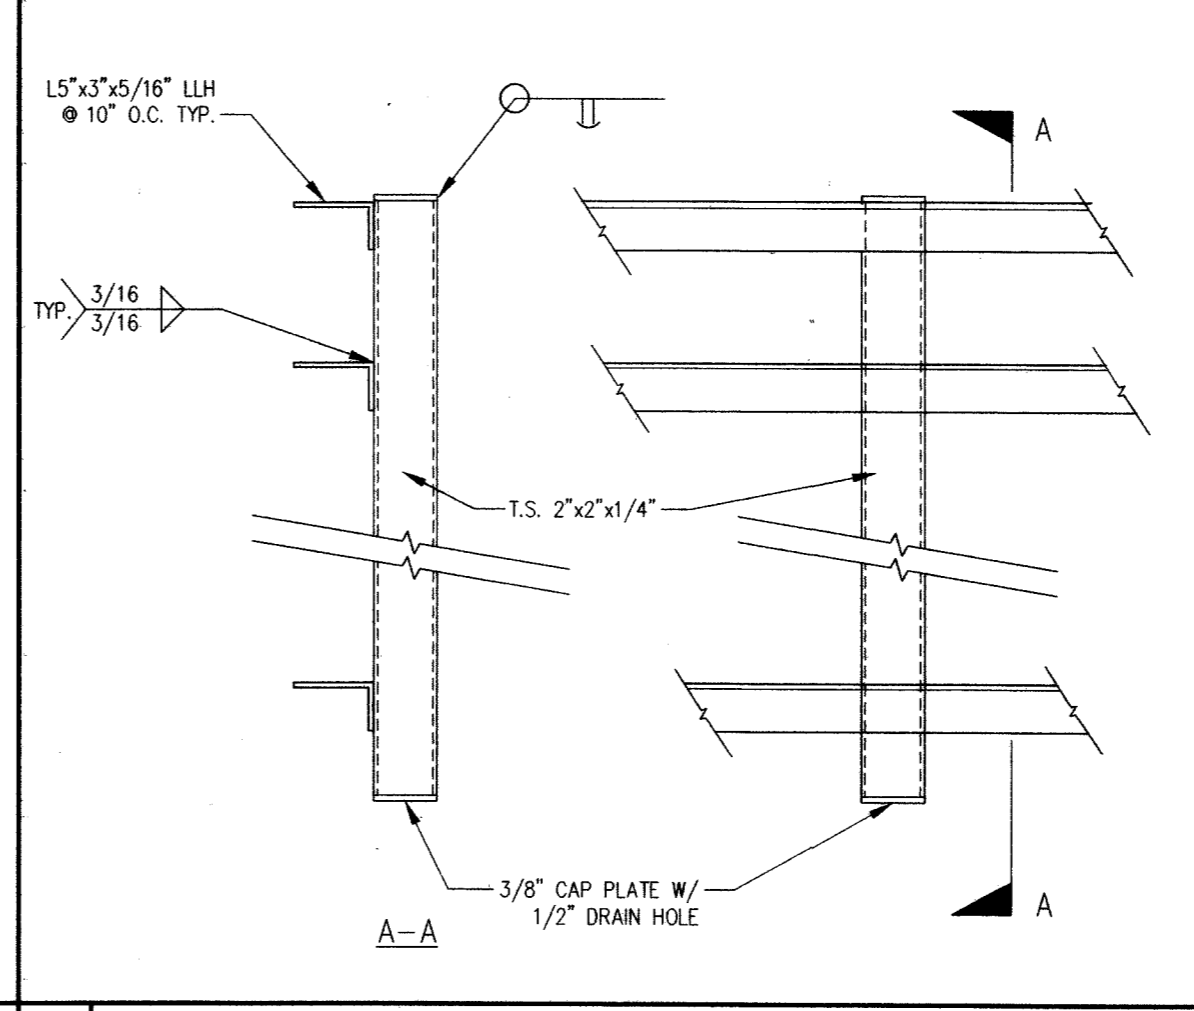


125 LOUVER

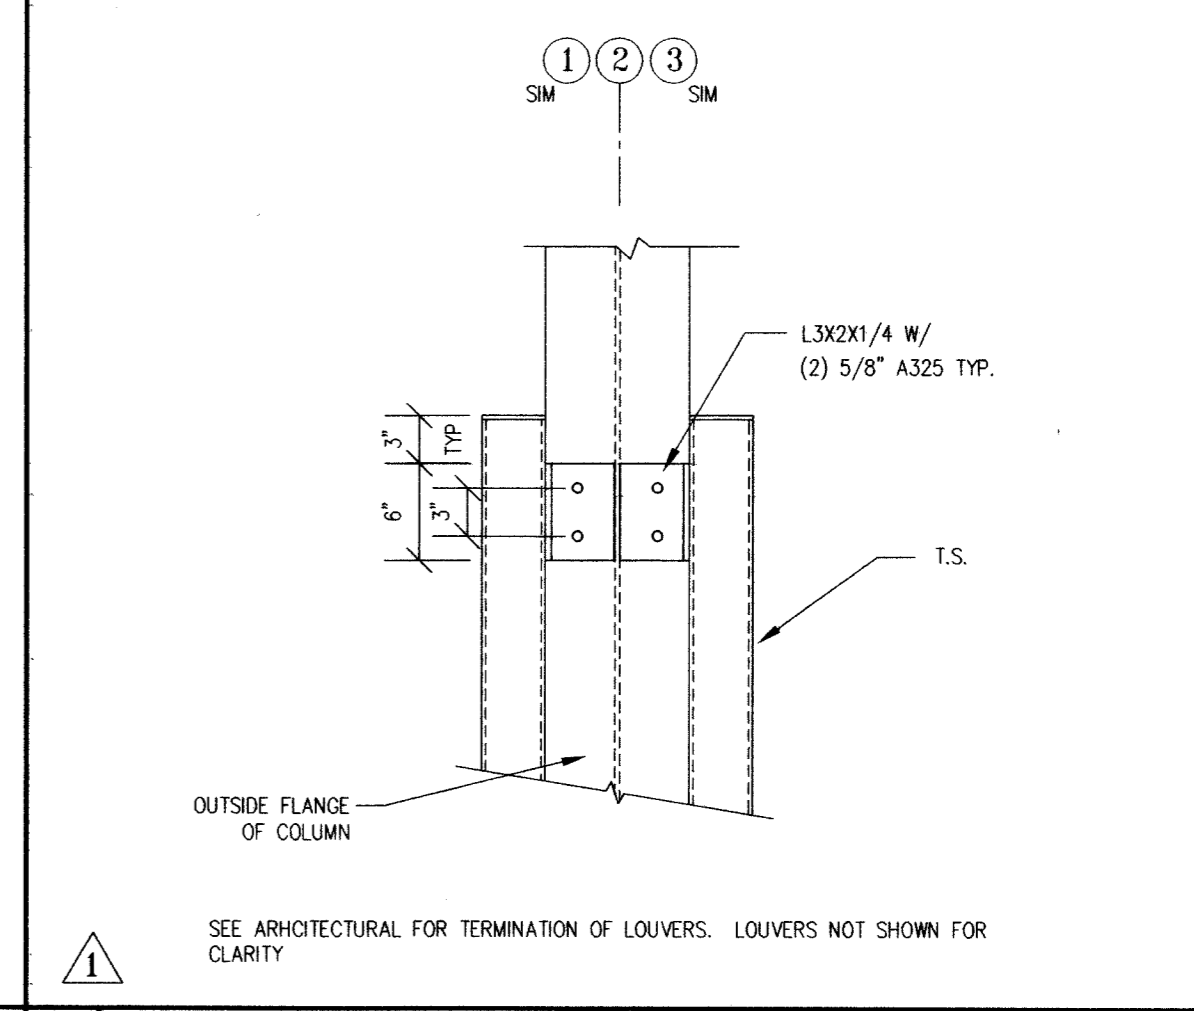


121 LOUVER DETAIL




138 RECORD AS-BUILTS

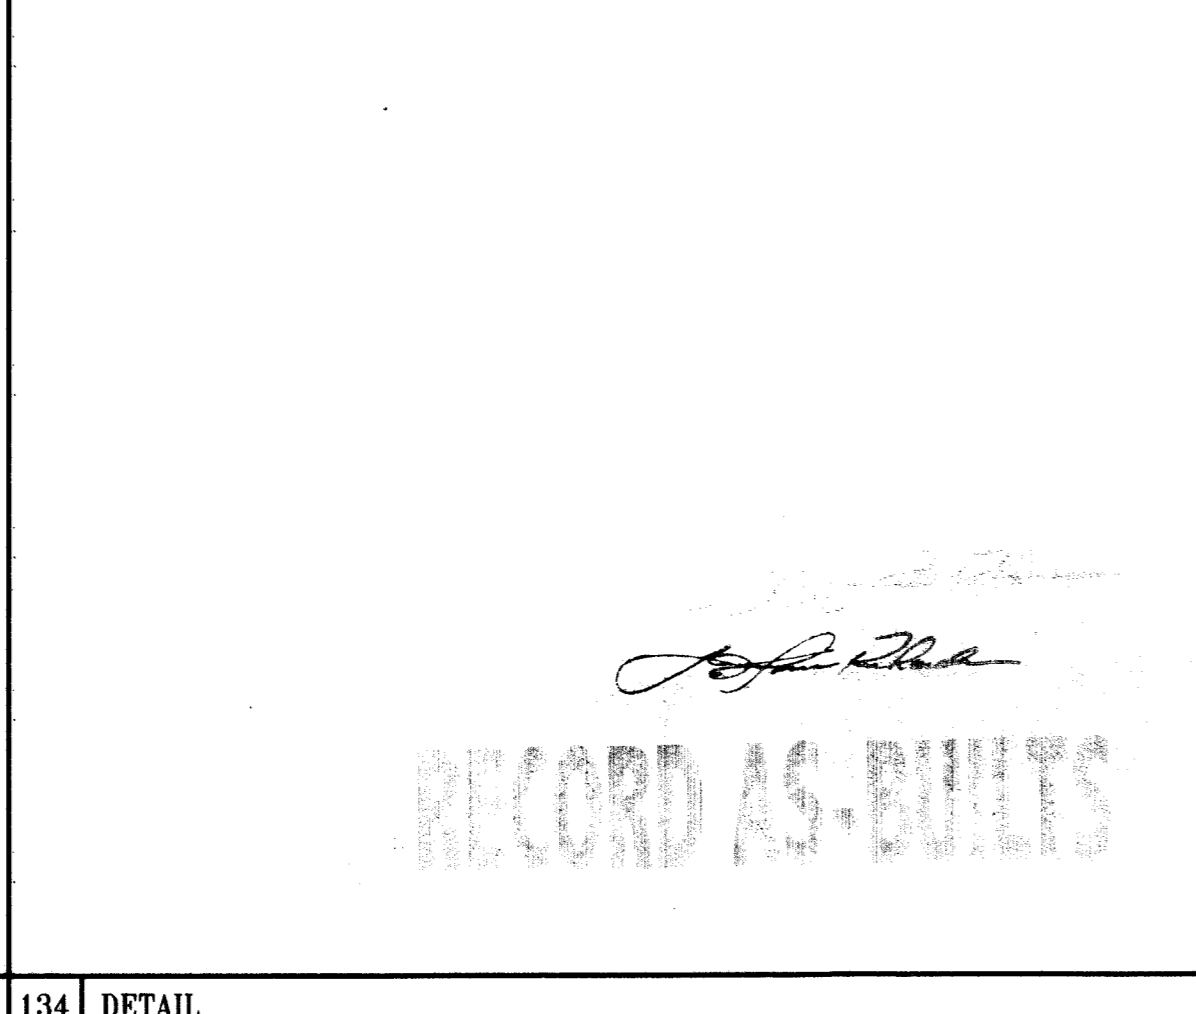


134 TYPICAL SMALL OPENING IN STEEL ROOF DECK

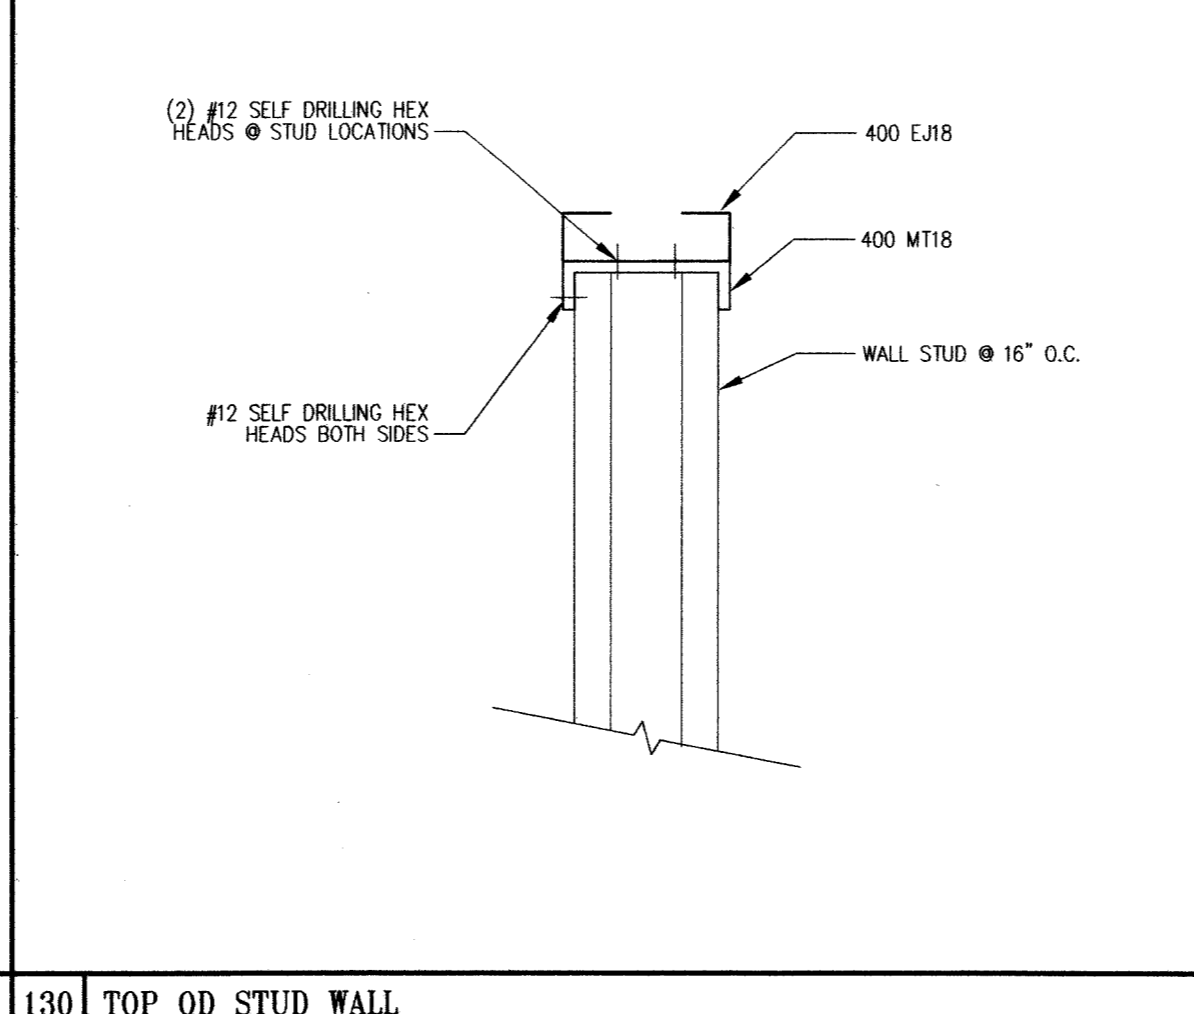


130 MASONRY WALL

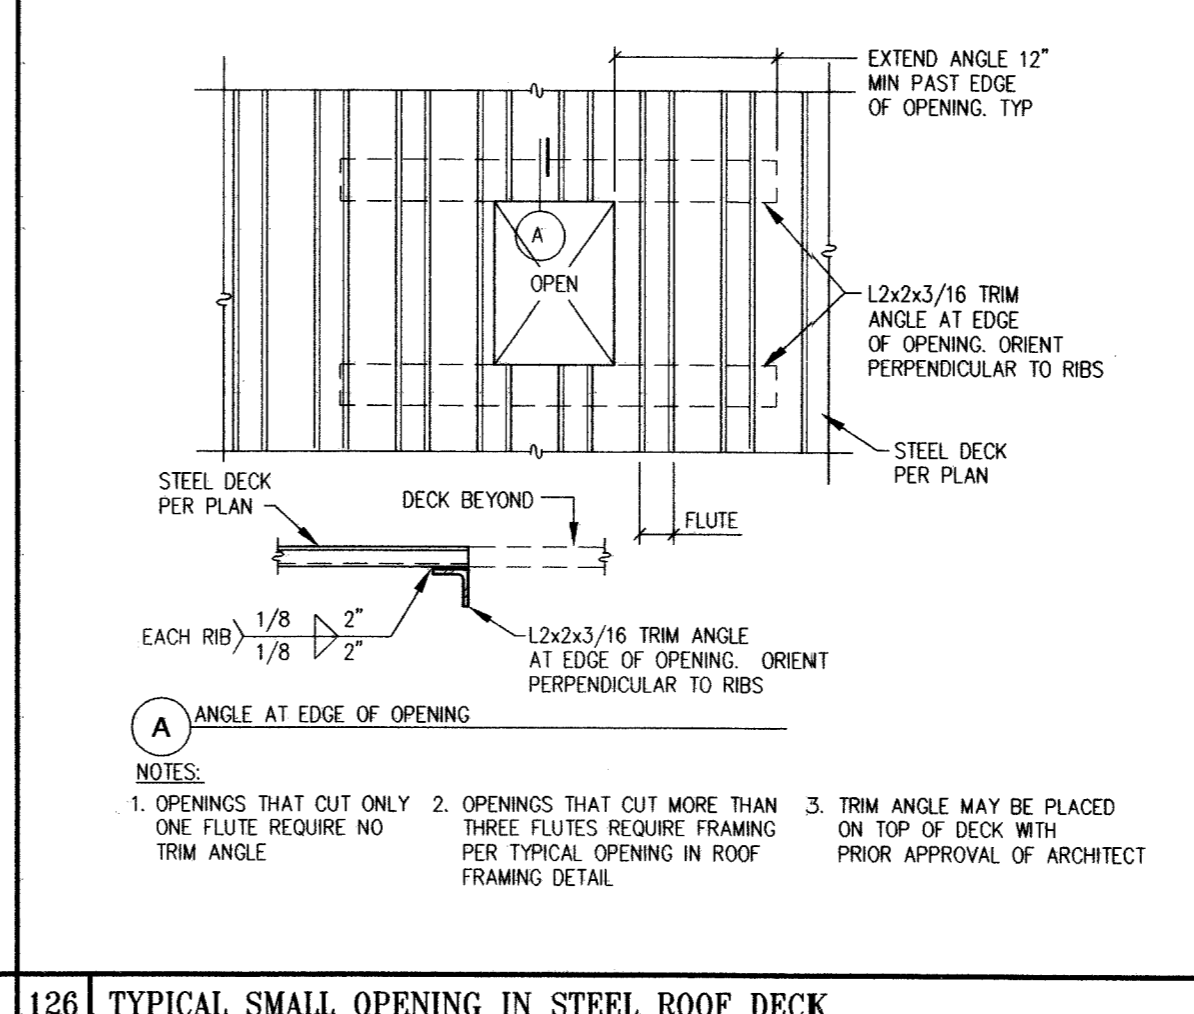

126 MASONRY WALL

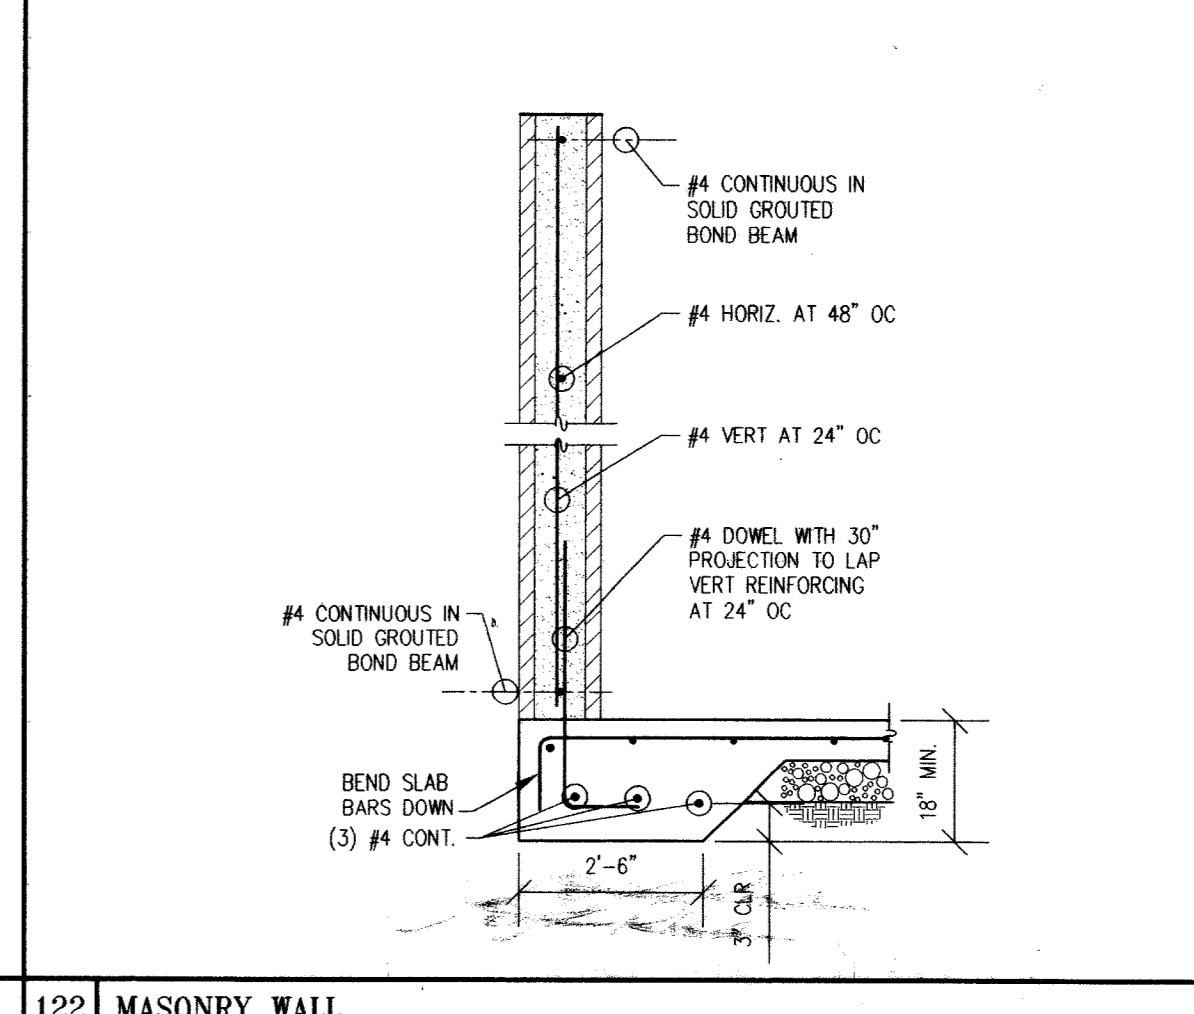

122 MASONRY WALL



REVISIONS  
 03-01-2002

CONSULTANT  
 6757 W CHARLESTON BLVD  
 LAS VEGAS, NEVADA 89146  
 PHONE (702) 258-0115  
 FAX (702) 869-8547

**Stantec**

DEER SPRINGS PARK - PHASE 1  
 ELKHORN & BUFFALO, LAS VEGAS, NV

STRUCTURAL DETAILS

OWNER: CITY OF LAS VEGAS  
 DEPARTMENT OF PUBLIC WORKS  
 ARCHITECTURAL SERVICES

400 EAST STEWART AVENUE  
 LAS VEGAS, NEVADA 89101  
 PHONE: (702) 229-5538  
 FAX: (702) 382-3232  
 TDD: (702) 386-9108

DRAWN: SRF  
 FILE: S-5DWG  
 DATE: 03-04-02  
 SCALE: N/A  
 BID NO: 021534105  
 CLV DWG NO: 65065-1  
 BID SET ISSUED 3-8-02  
 SHEET NO: MF-S5