

FROM STA.	TO STA.	LIN. FEET
6+20.80	7+10	149.80
9+36.88	11+97	230.00

LT.	RT.	RADIUS	LIN. FT.
	11+74.25	5'	77.00


FROM STA.	TO STA.	LIN. FEET
5+13.92	9+48.4	378.61
10+73.04	10+74.36	44.71

FROM STA.	TO STA.	80 YDS
5+08.4	9+45.1	2242.16
10+66.5	11+97	745.62

STA.	TO STA.	LENGTH	RT.	50'	LN. FT.
7+10	8+20	50'			

ITEM	ESTIMATE OF QUANTITIES	AMOUNT	UNIT
1	EXCAVATION	7,245.00	CU. YDS.
2	A.C. PAVEMENT	3,232	SQ. YDS.
3	1" CURB & GUTTER CONSTRUCTION	781.6	LN. FT.
4	REMOVE CURB & GUTTER	50.00	LN. FT.


SCALE - 1"=30'
 FB - #100-M-42-54-13
 BM FH ON LINDEN BETWEEN 7TH & 8TH ST
 ELEV. 1995.06

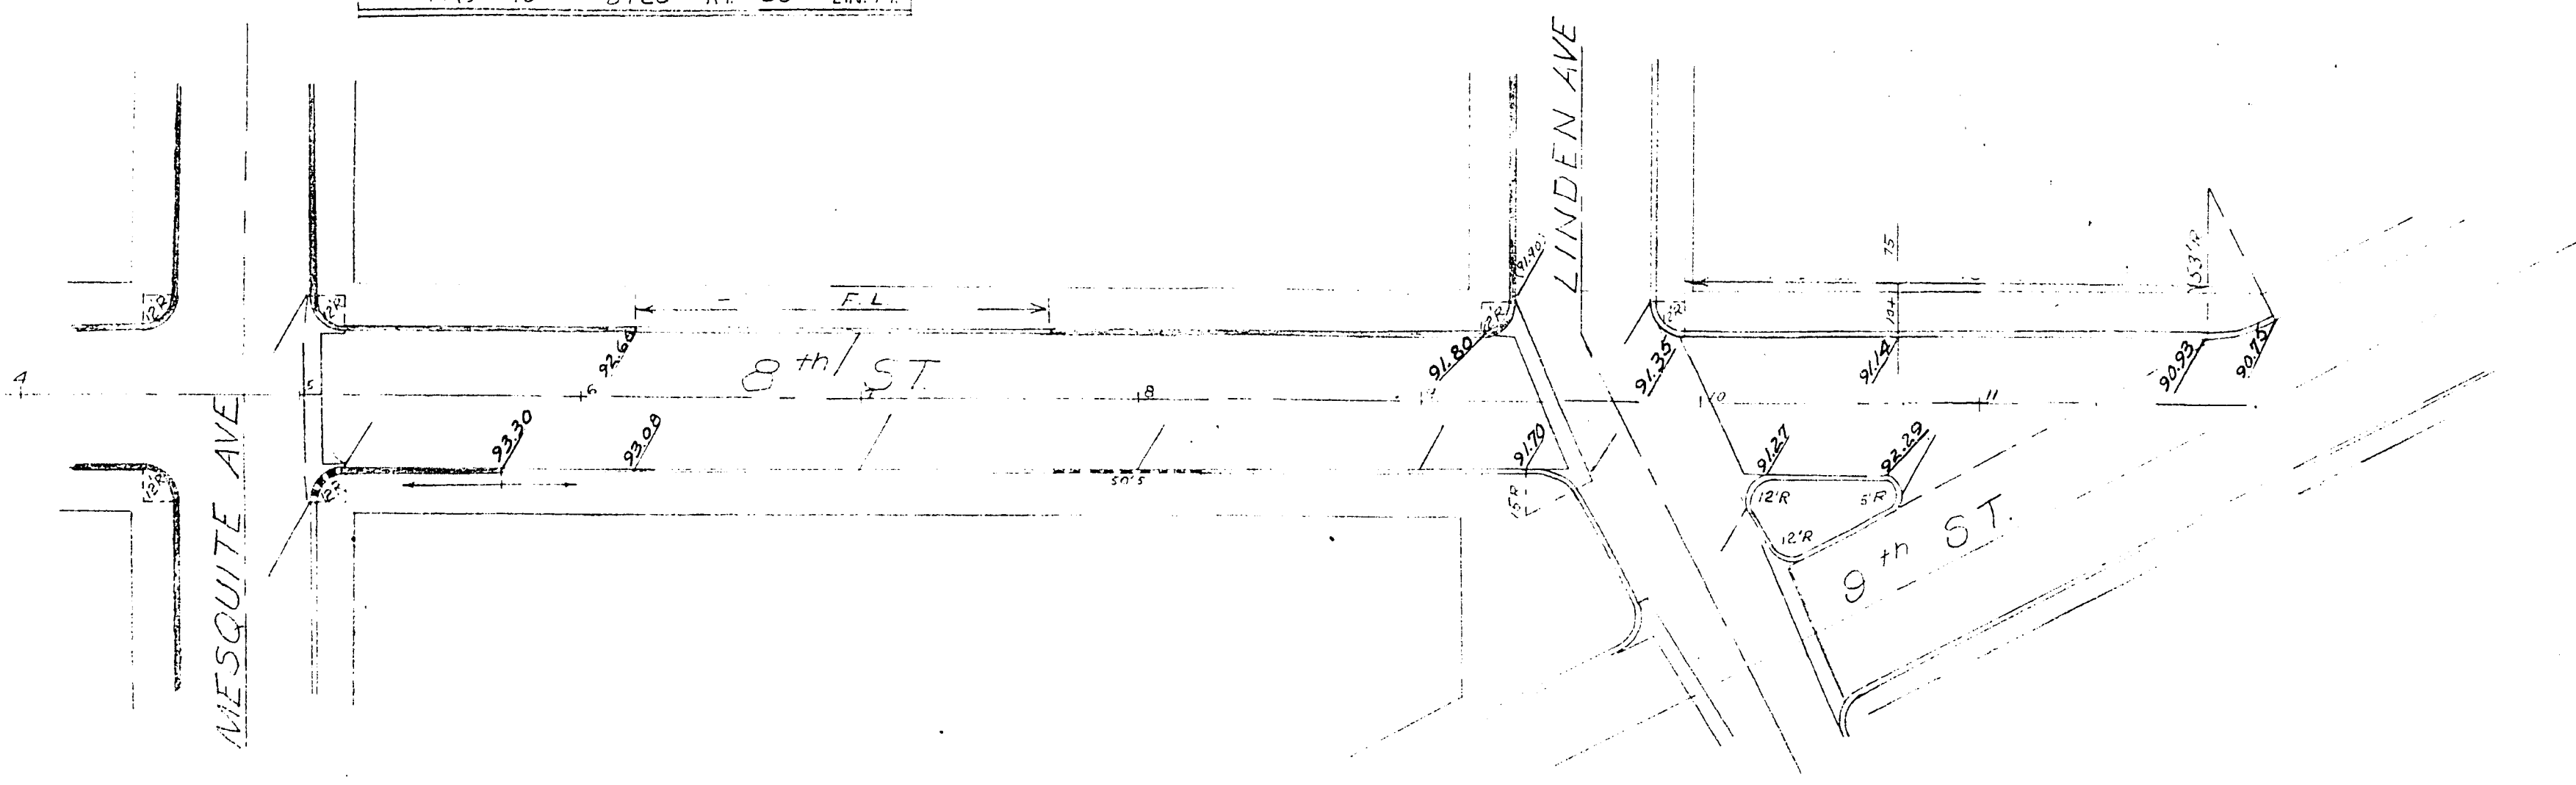

REVISION - GRADES CHANGED AT INTERSECTION OF 8TH ST, LINDEN AVE & 9TH ST.

PLAN
 SURVEYED
 PLOTTED
 NOTE BOOK NO.
 DATE

PROFILE
 SURVEYED
 PLOTTED
 NOTE BOOK NO.
 DATE

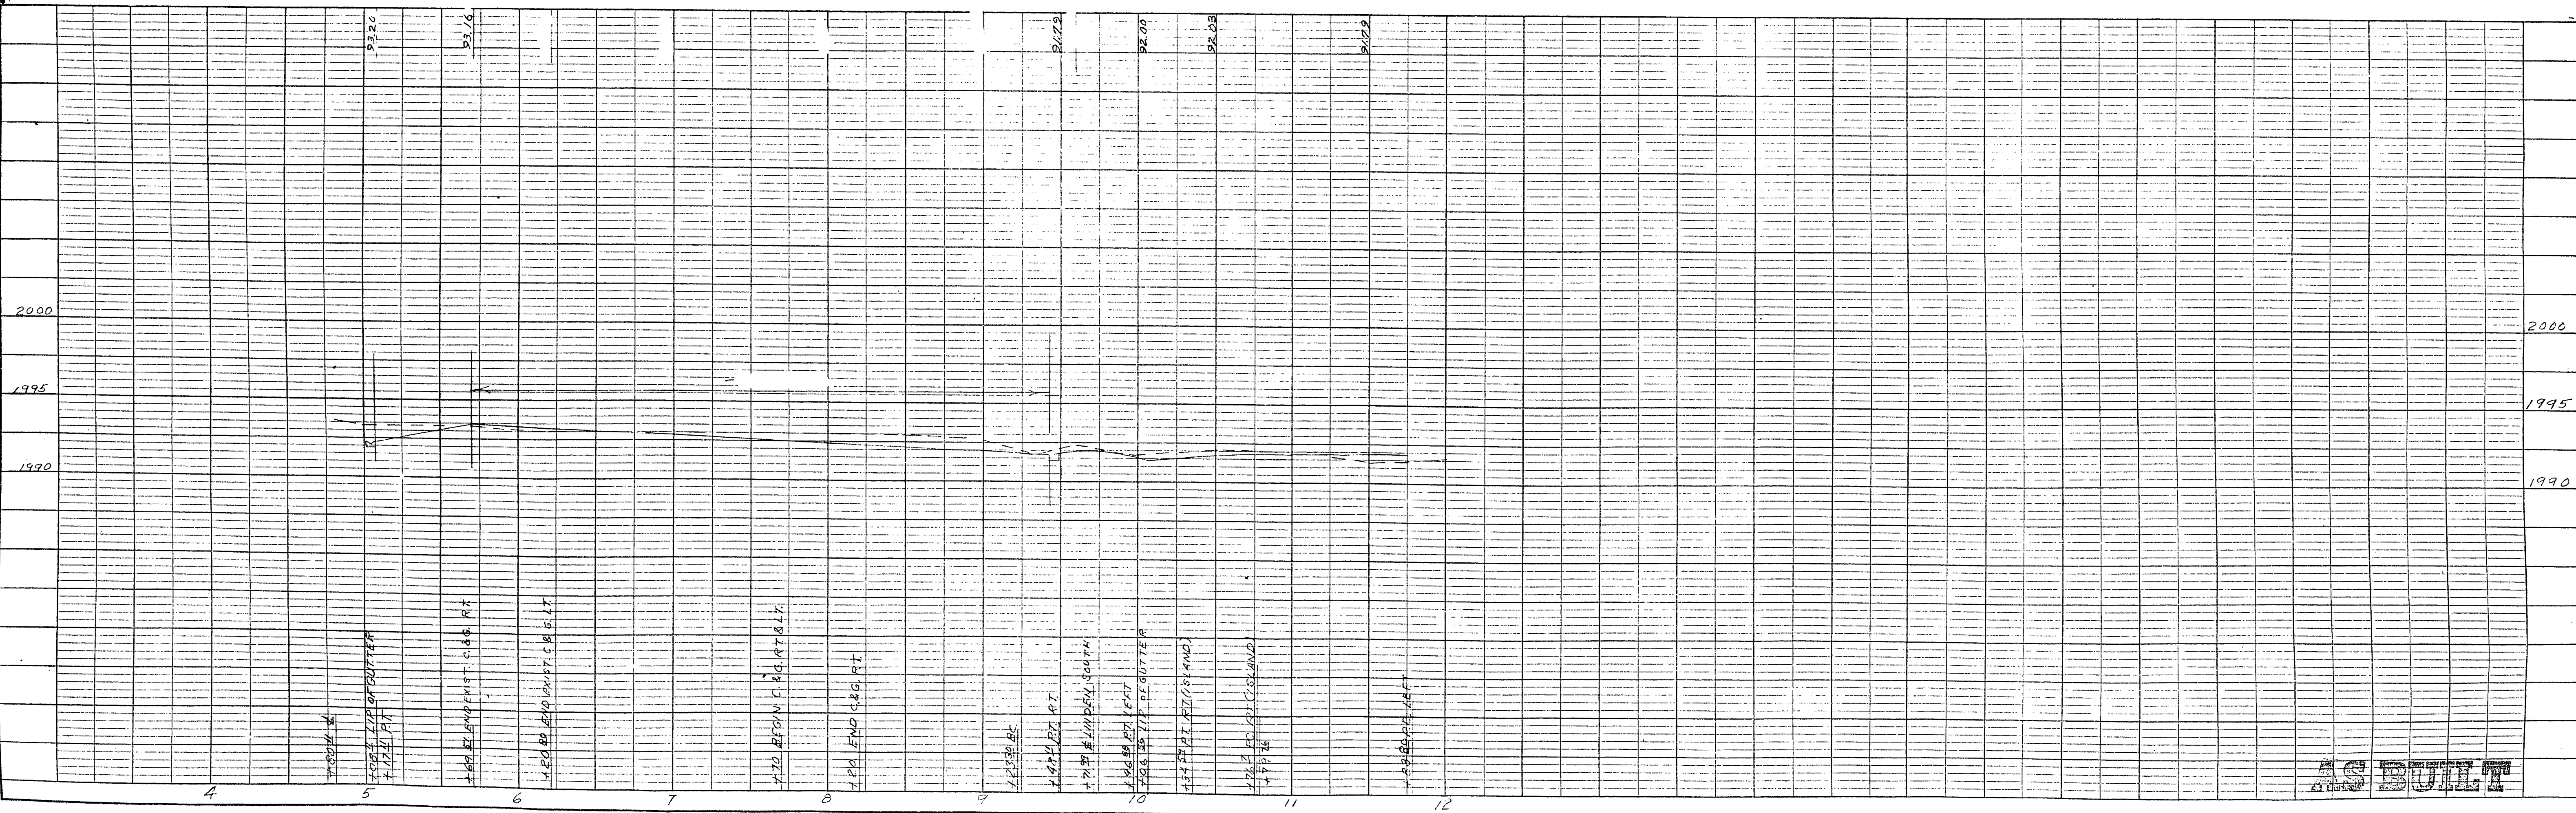

AS BUILT