

PLAN  
 SURVEYED BY DATE  
 NOTE BOOK NO.  
 ALIGNMENT CHECKED  
 RT. OF WAY CHECKED

PROFILE  
 SURVEYED BY DATE  
 NOTE BOOK NO.  
 GRADE CHECKED  
 B.M. NOTED  
 STRUCTURE NOTATIONS



FROM STA.	TO STA.	SQ. YDS.
0+39.42	2+95.25	1237.5
3+53.35	7+72.62	229.61

FROM STA.	TO STA.	LIN. FT.
0+39.42	2+95.25	1237.50
3+53.35	7+72.62	229.61

ITEM	ESTIMATE OF QUANTITIES	AMOUNT	UNIT
1	CONSTRUCT AC PAVING RT. & LT.	2545.00	SQ. YDS.
2	CONSTRUCT L-CURB & GUTTER LT.	775.00	LIN. FT.
3	CONSTRUCT L-CURB & GUTTER RT.	625.00	LIN. FT.
4	ADJUST MANHOLE TO GRADE	1.00	EACH

SCALE - 1"=50'  
 FB 100-178

REMARKS - MINOR GRADE CHANGES

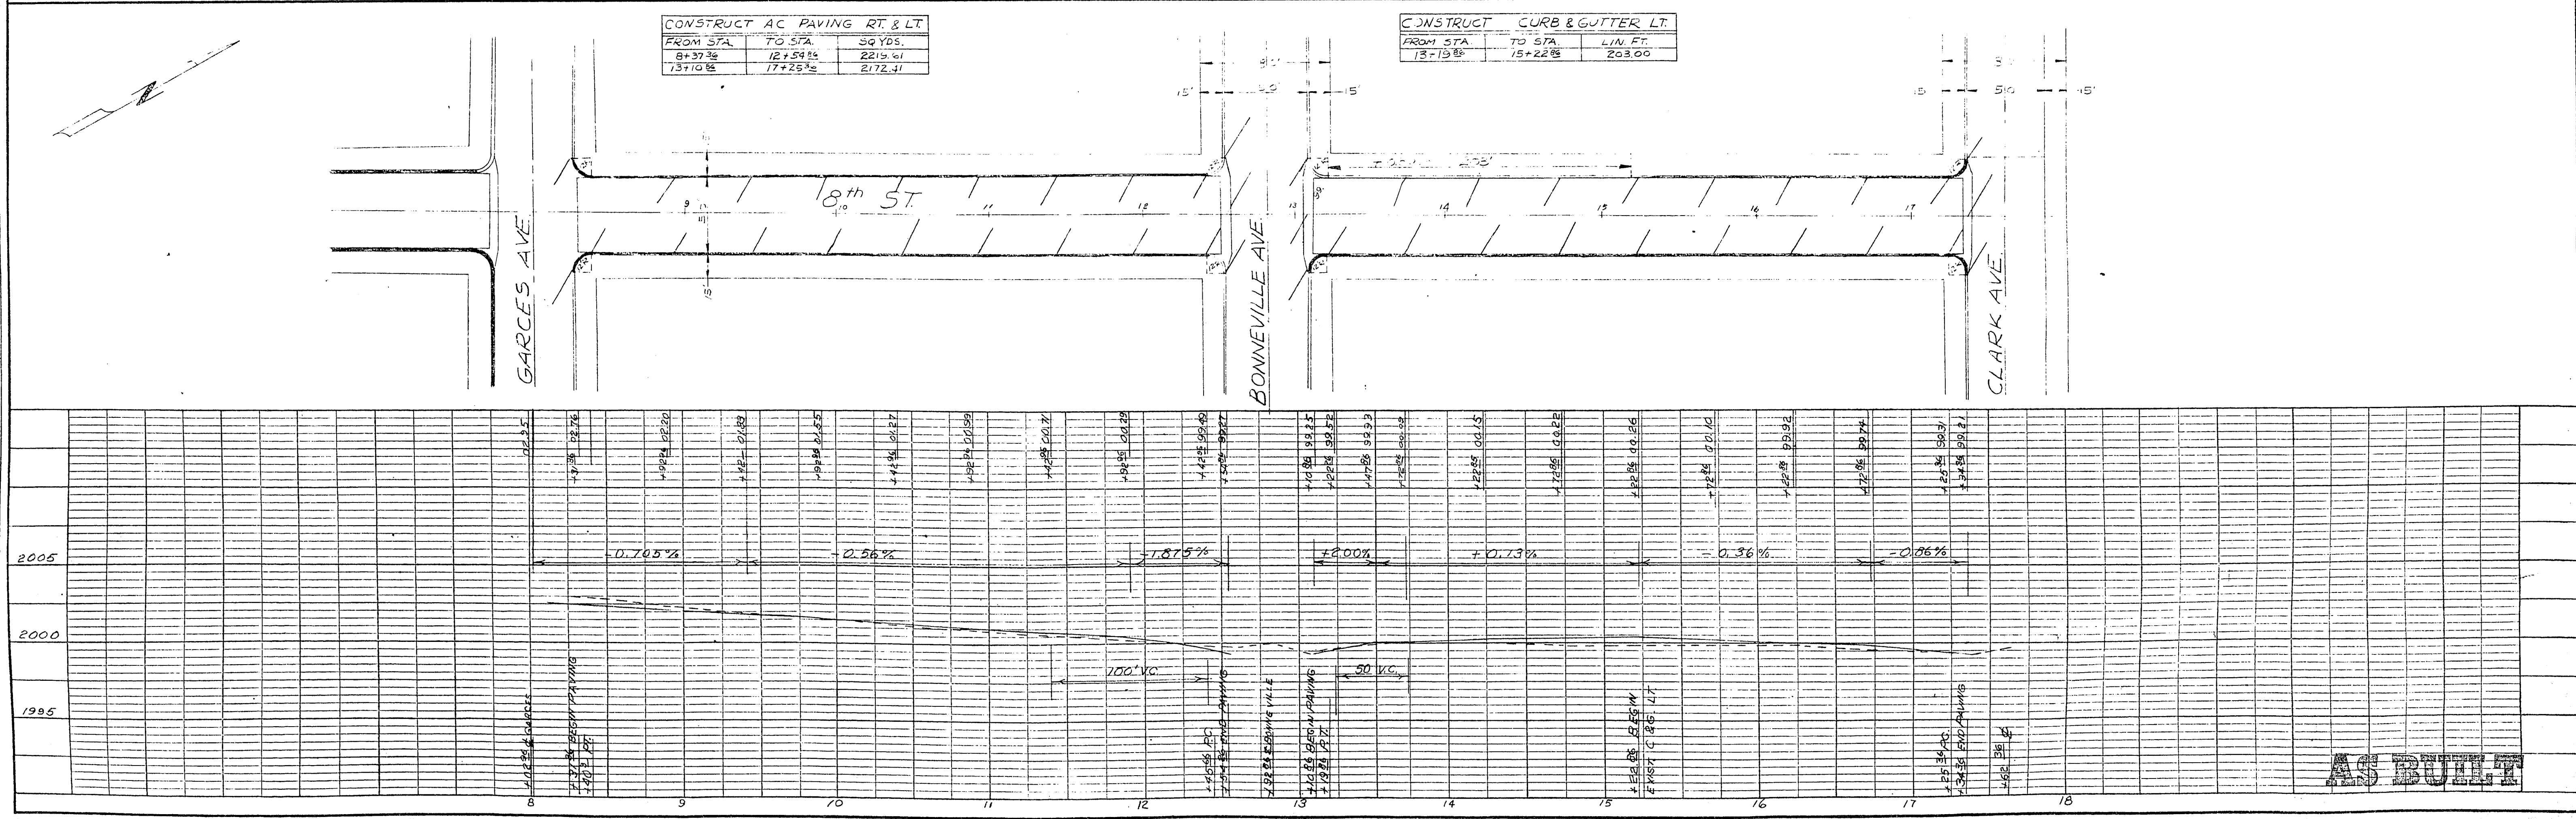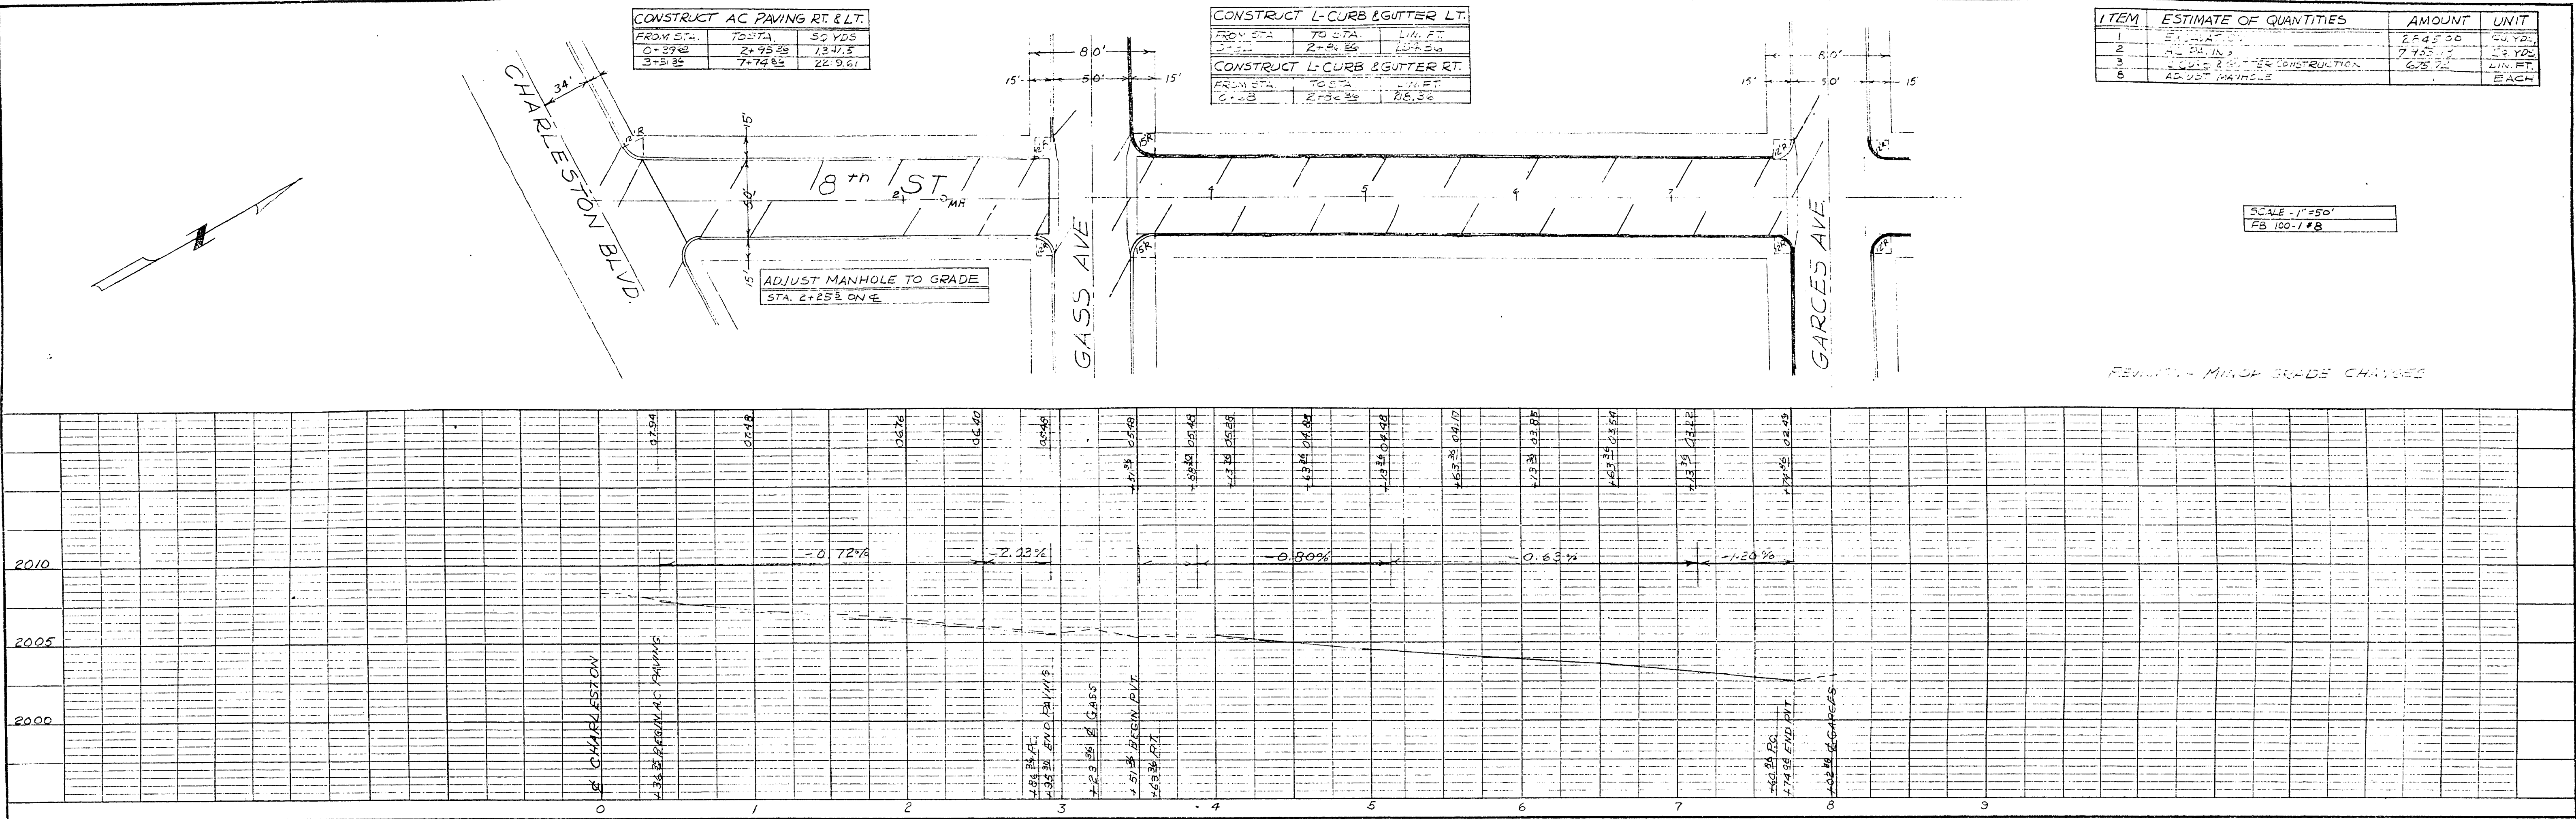

AS BUILT