
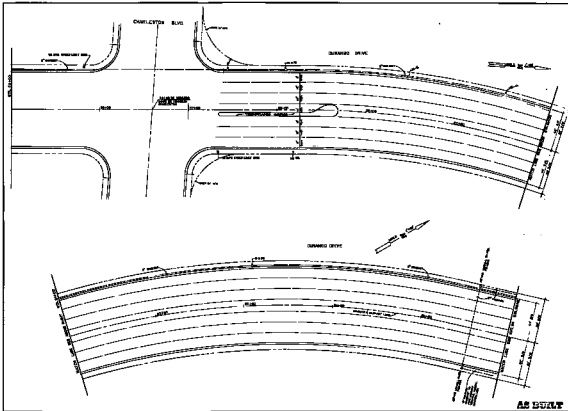


AS BUILT

		Department of Public Works Traffic Engineering Division		W.A.	
Durango Drive Charleston to Venetian Strada		Lane Delineation and Traffic Control		Scale (H) ——— Scale (V) 1" = 20' Date _____	
Drawing no. 107-V1649		Design by G. DAMMER Approved by CITY ENGINEER		Drawn by JACK J. BERTOLA Date _____	
23 30		Revisions		Date	

12-3-83



DATE	PROJECT NO.	SHEET NO.

Department of Public Works
 Bureau of Street and Traffic Control
 Lane Distribution
 and
 Traffic Control



AS BUILT