


SCALE **N** 1"=20'


SCALE **N** 1"=20'

SCALE **N** 1"=20'

AS BUILT

	Department of Public Works Traffic Engineering Division		Lane Delineation and Traffic Control	
	Durango Drive Charleston to Venetian Strada		W.A.	
Drawing no. 107-V1649		Scale (V) 1"=20'		Date
Design by G. DAMMEIR		Drawn by JACK J. BERTOLA		Date
Approved by CITY ENGINEER		Date		Revisions
Date		Date		Date

12-3-85

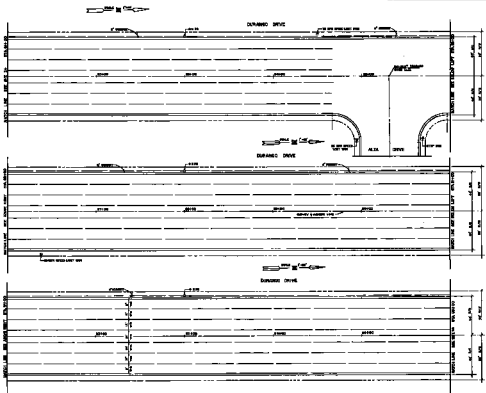

AS BUILT



Department of Public Works
 Chicago Office
 Checked by
 Verification sheets

Drawn by
 Checked by
 Approved by

Sheet No.	Project No.
Scale	Date
Author	Checked by
Drawn by	Approved by