



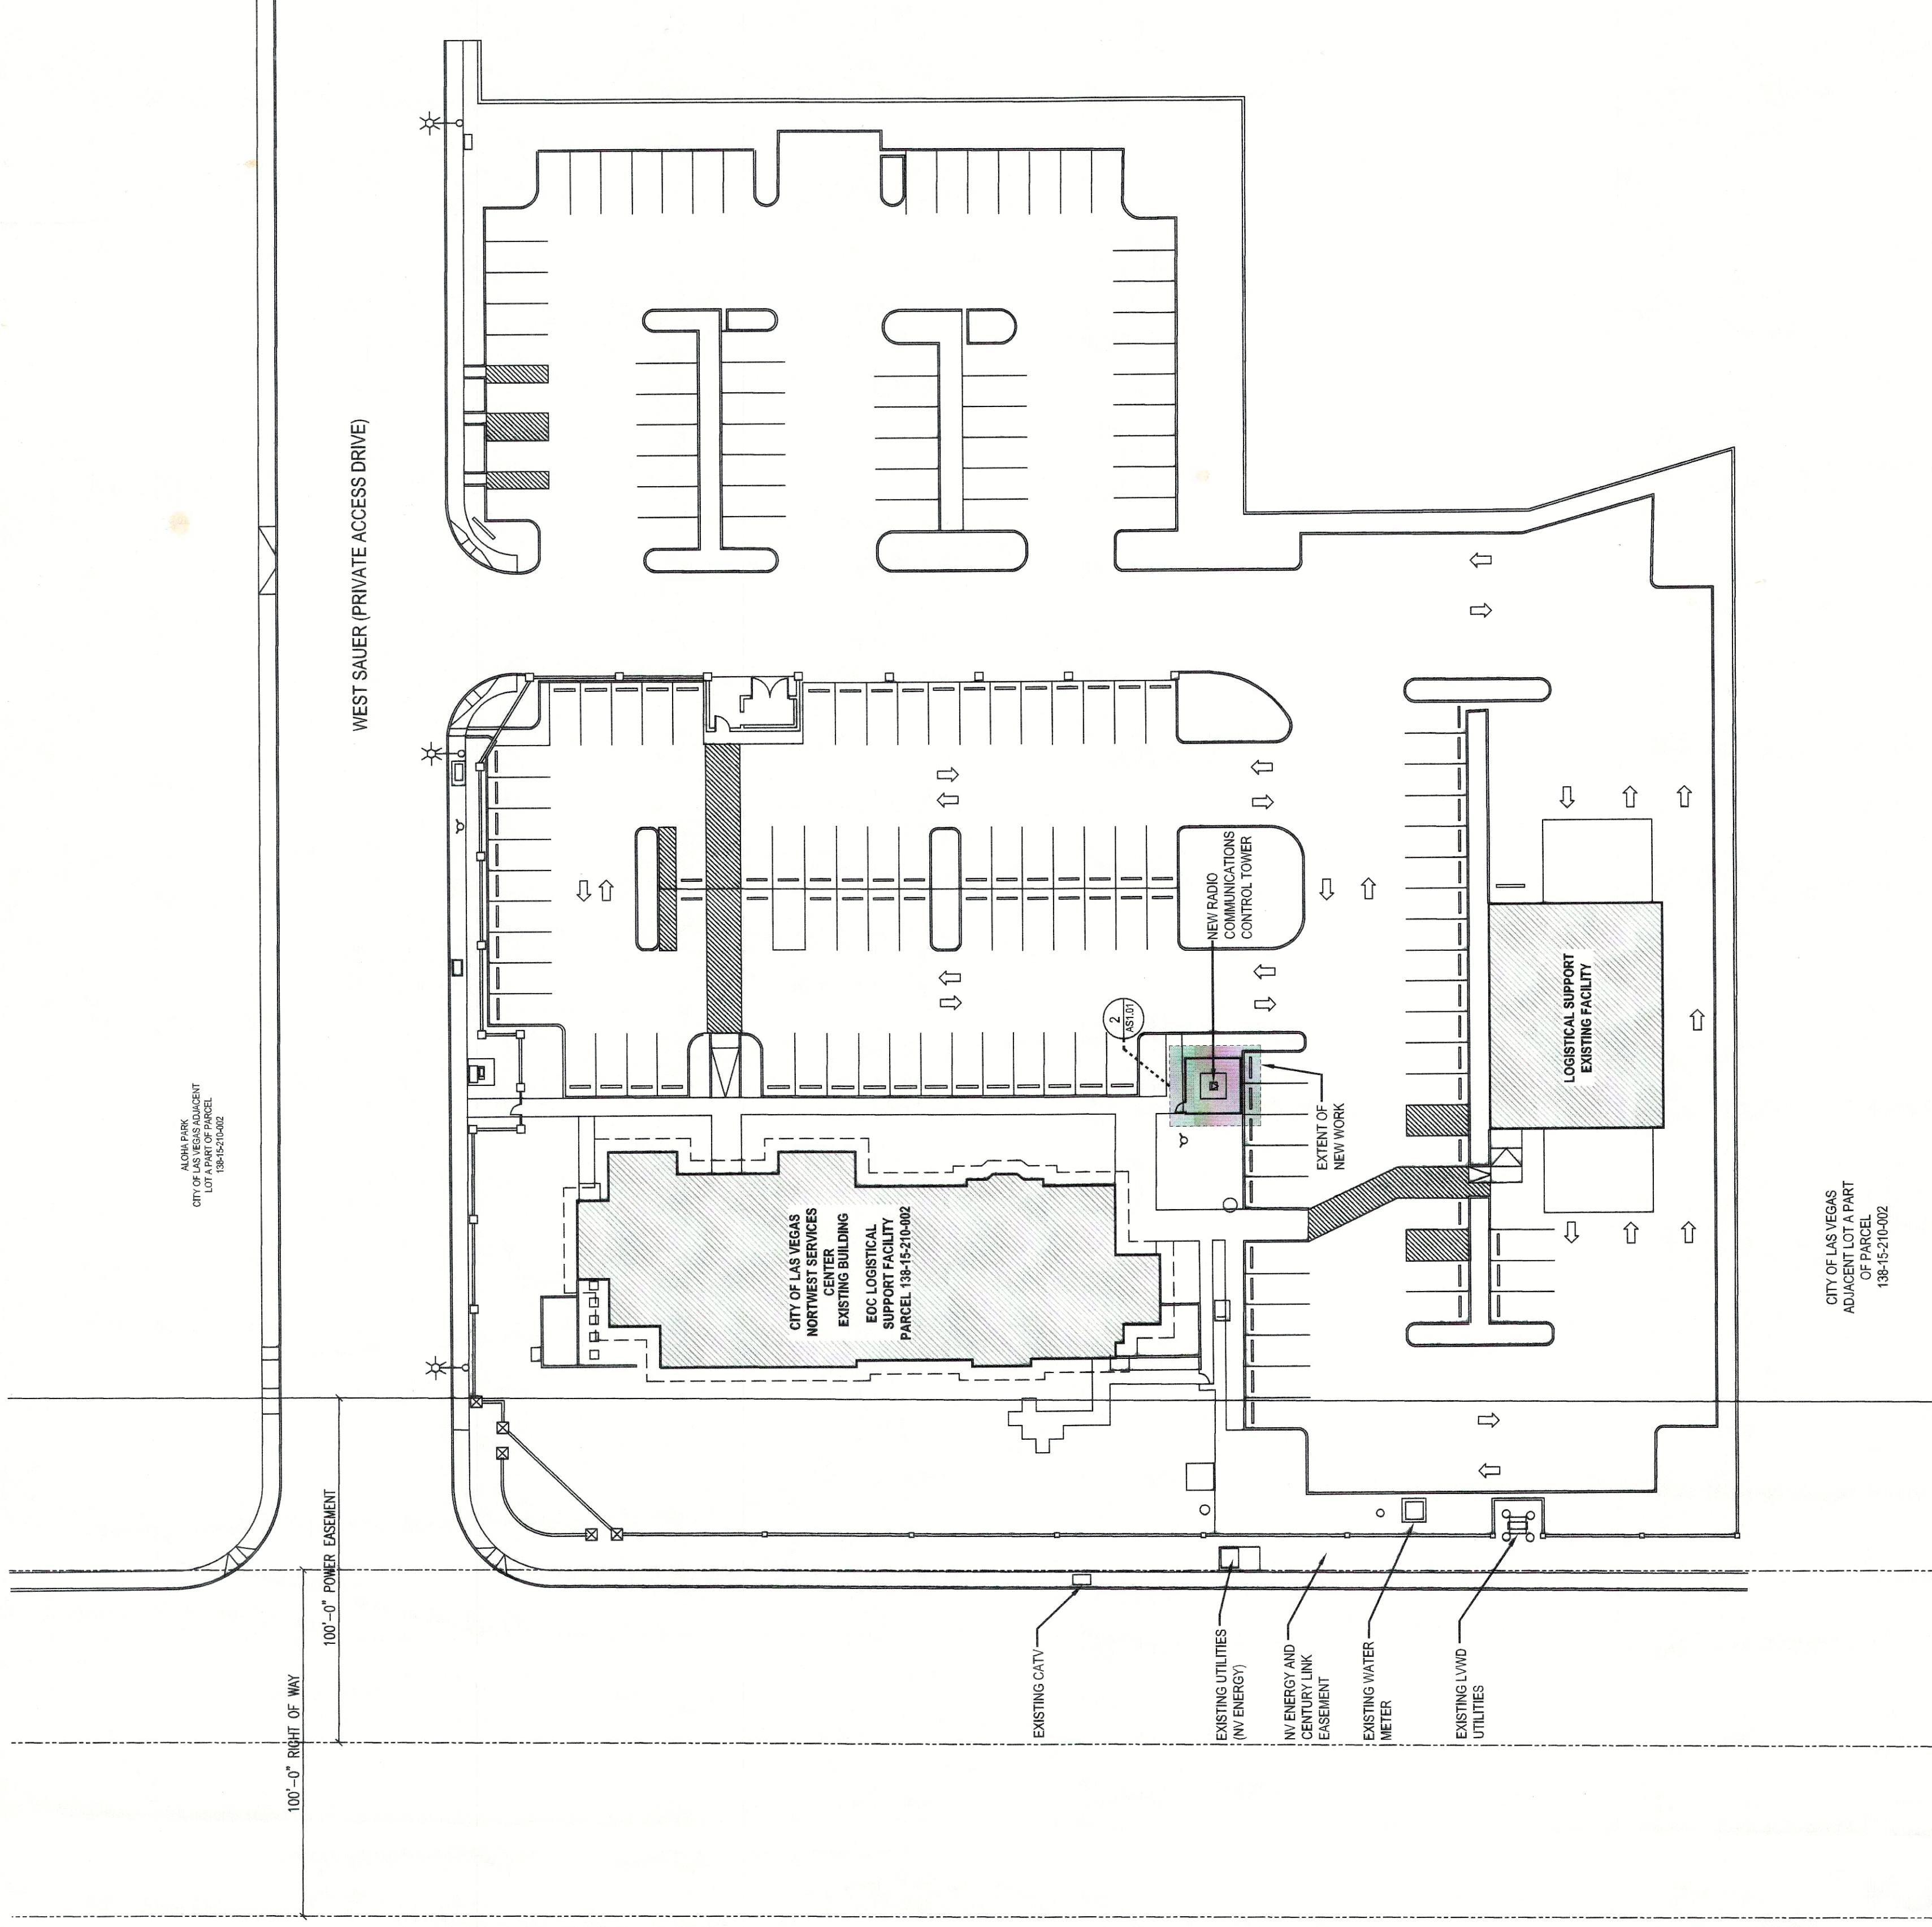


1 ARCHITECTURAL SITE PLAN

SCALE: 1/32" = 1'-0"

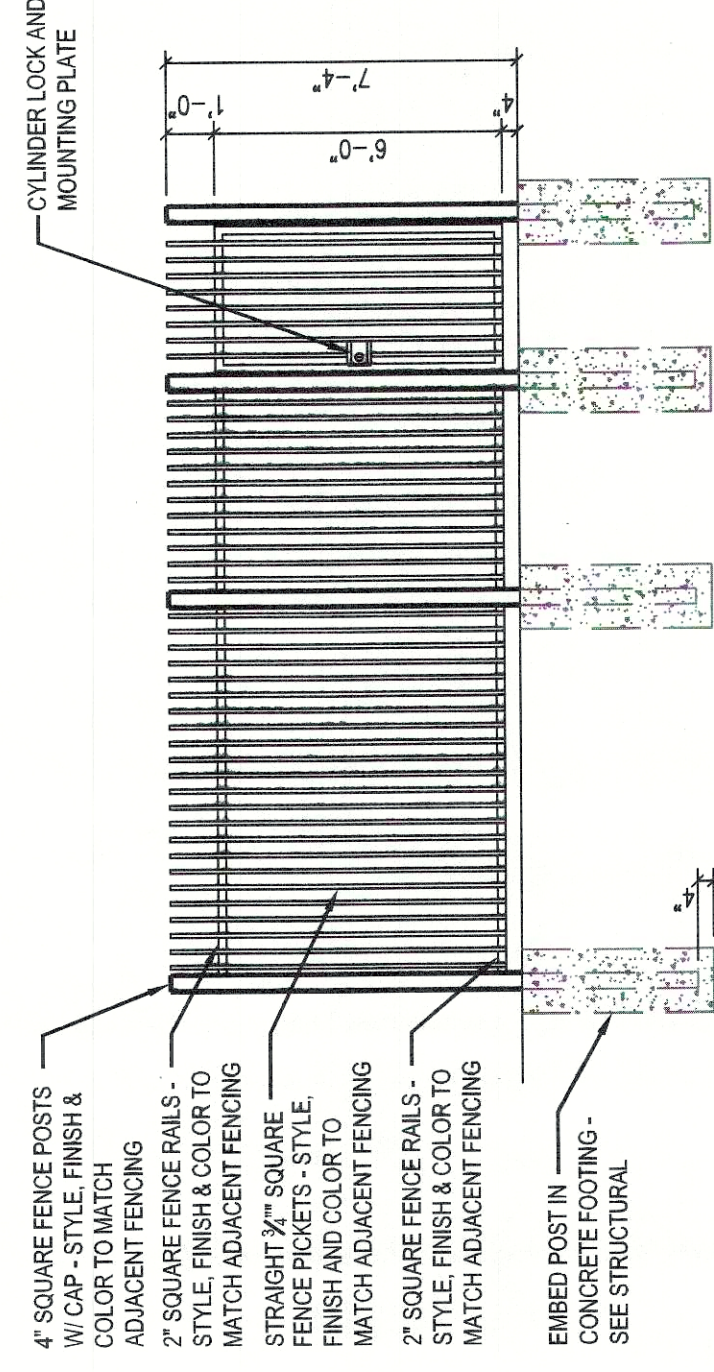

3 SECURITY FENCE ELEVATION

SCALE: 1/4" = 1'-0"

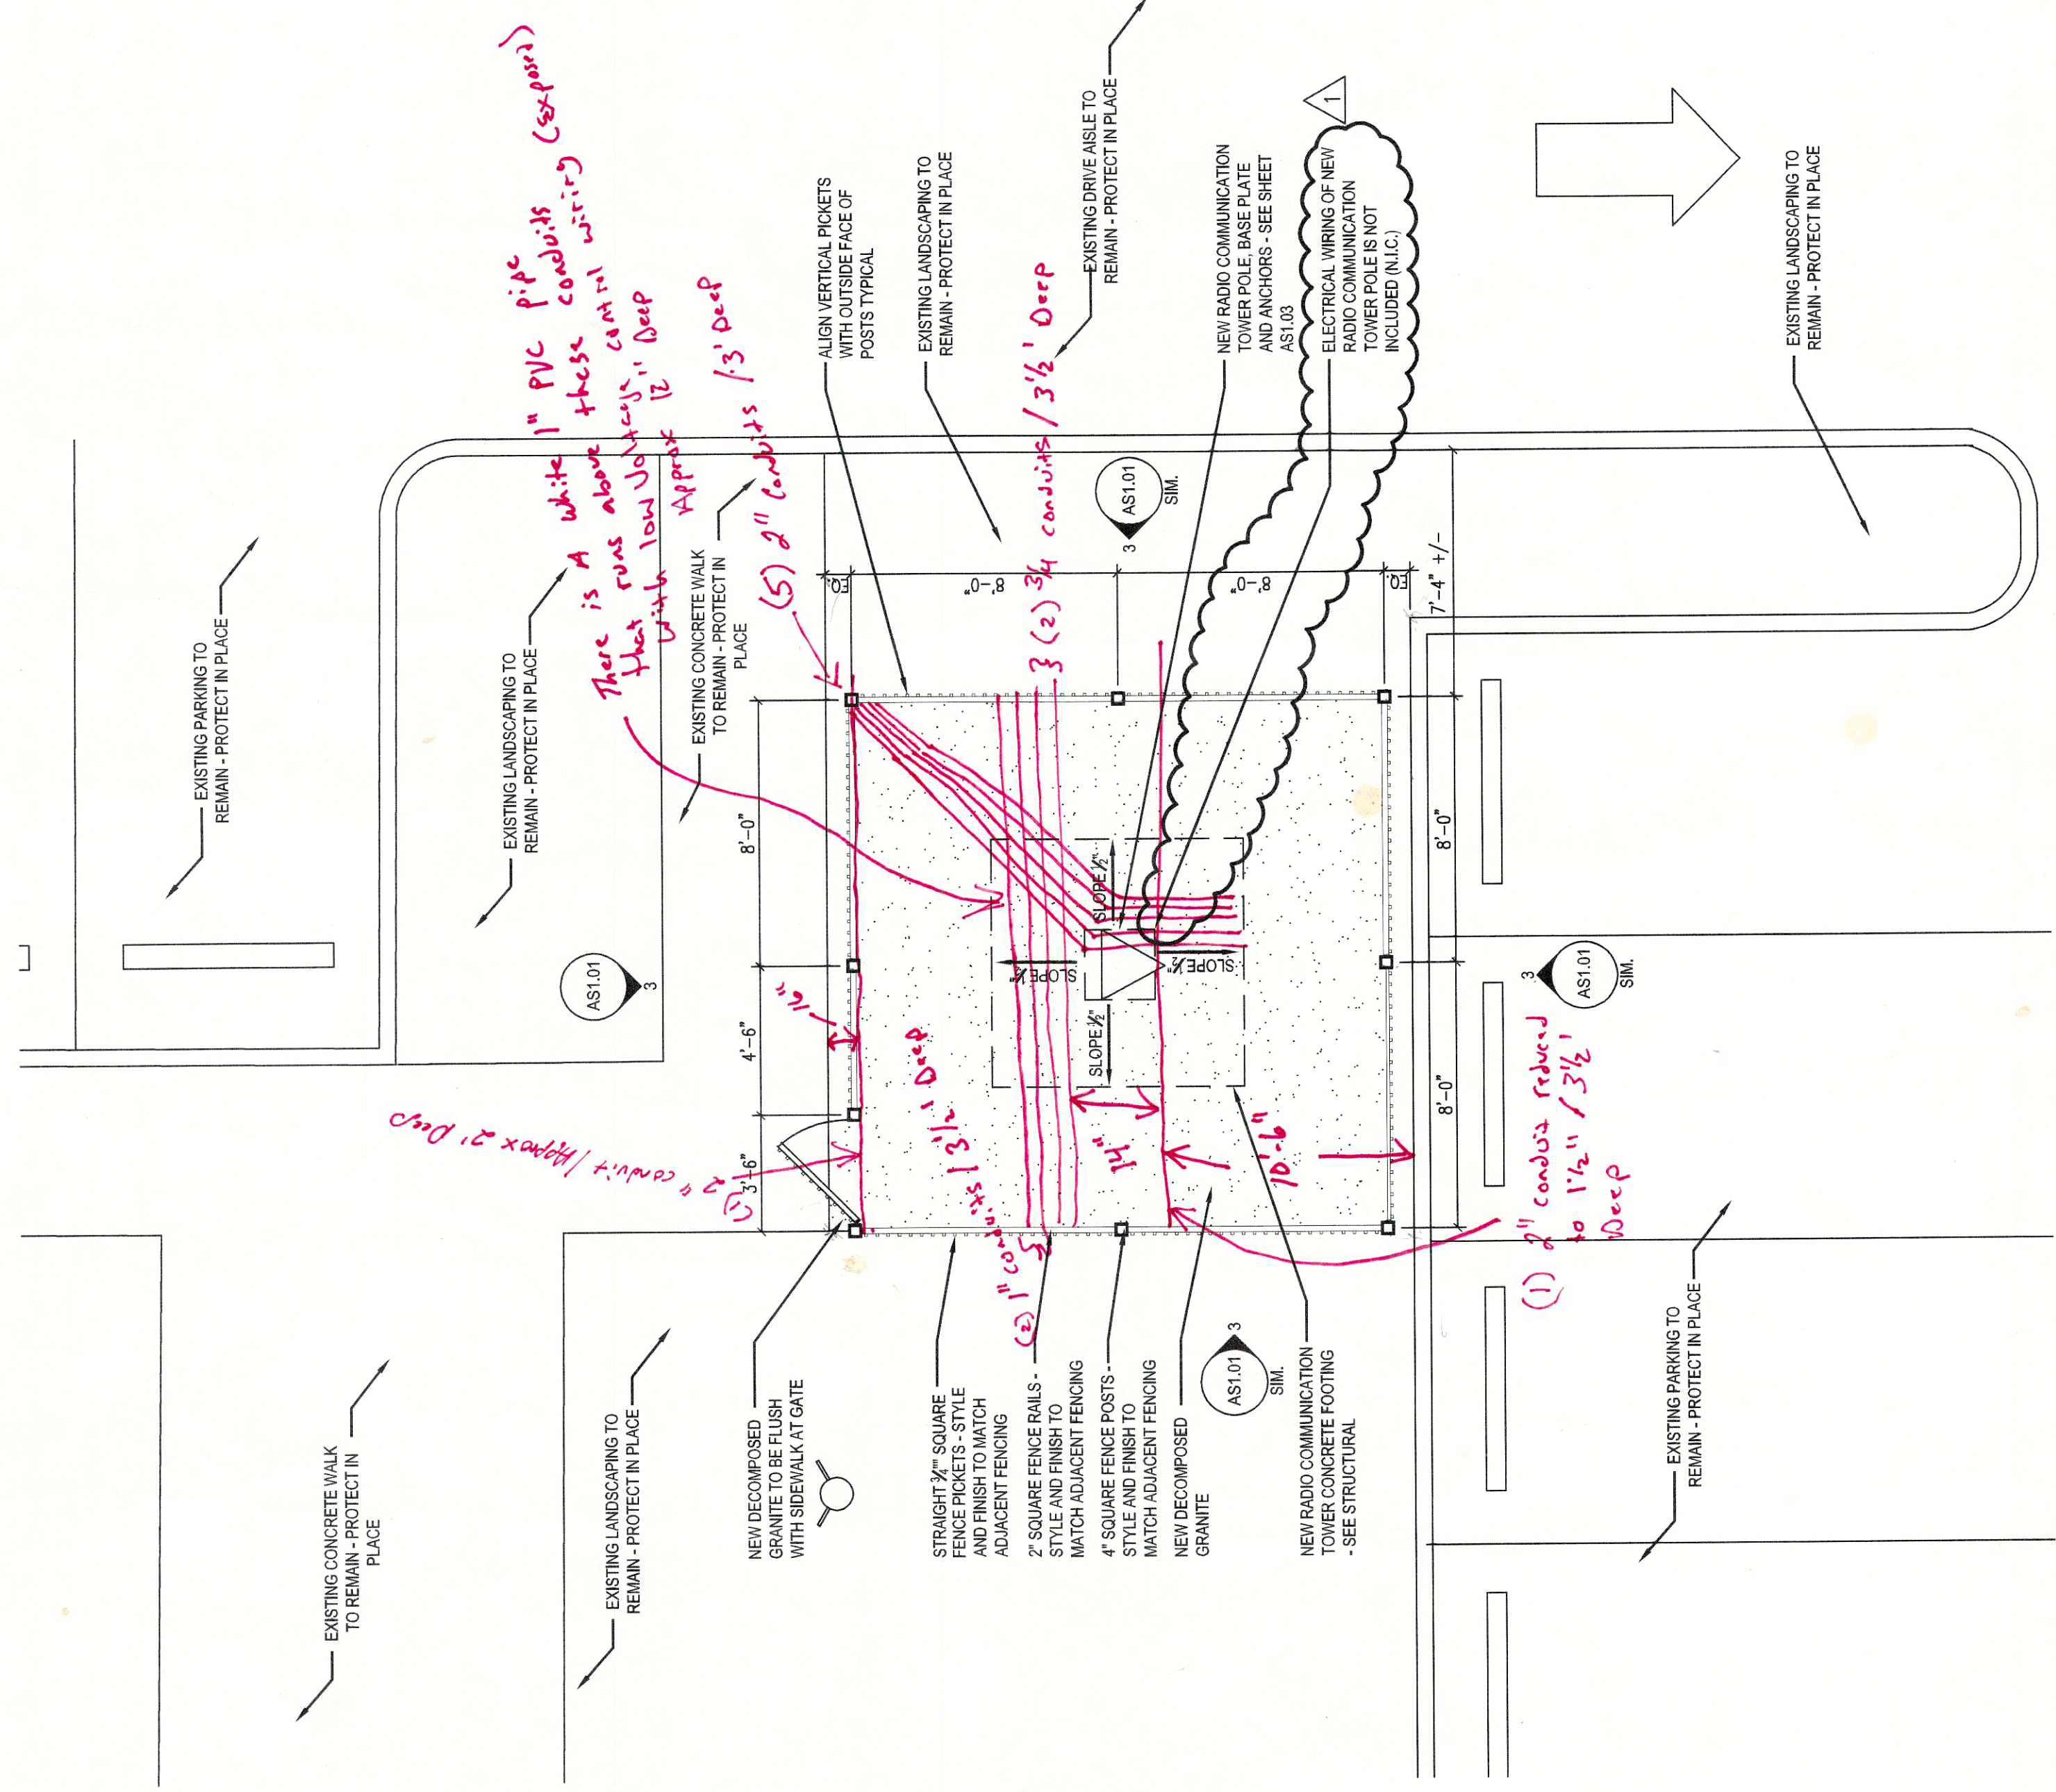

2 ENLARGED ARCHITECTURAL SITE PLAN

SCALE: 1/4" = 1'-0"

ARCHITECTURAL SITE PLANS AND ELEVATION
PROJECT NAME
NEW RADIO COMMUNICATION TOWER AND SECURITY FENCE
DEPARTMENT OF PUBLIC WORKS
EMERGENCY OPERATIONS CENTER - LOGISTICAL SUPPORT FACILITY
7551 SAUER DRIVE LAS VEGAS, NEVADA 89128

Revisions	Description	Date
1	CLVSC COMMENTS 12/7/15	12/7/15

Date	12/11/15
Issued for	PLANS CHECK REVIEW
Designed By	
Drawn By	
Checked By	
Project Manager	
DCC Project No.	
Sheet Number	

AS1.01
AS BUILT

Stetten CONSTRUCTION • DESIGN BUILD
SLETTEN CONSTRUCTION OF NEVADA, INC.

Seal
MAR 07 2016
No. 631
ARCHITECT

PLANS APPROVED
CONSTRUCTION
Building & Safety Department
City of Las Vegas, Nevada
MAR 08 2016

RECEIVED
MAR 07 2016
CITY OF LAS VEGAS
PERMITS

Drawn Not Inside Electrical, Plumbing, Mechanical, Structural, or Civil Engineering. Without Approval, Any Change to the Original Design or Construction of the Project is Not a Part of the Original Design or Construction.