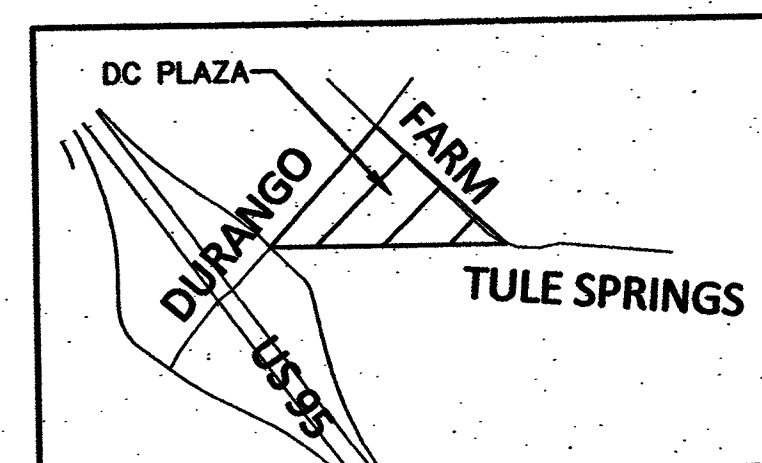
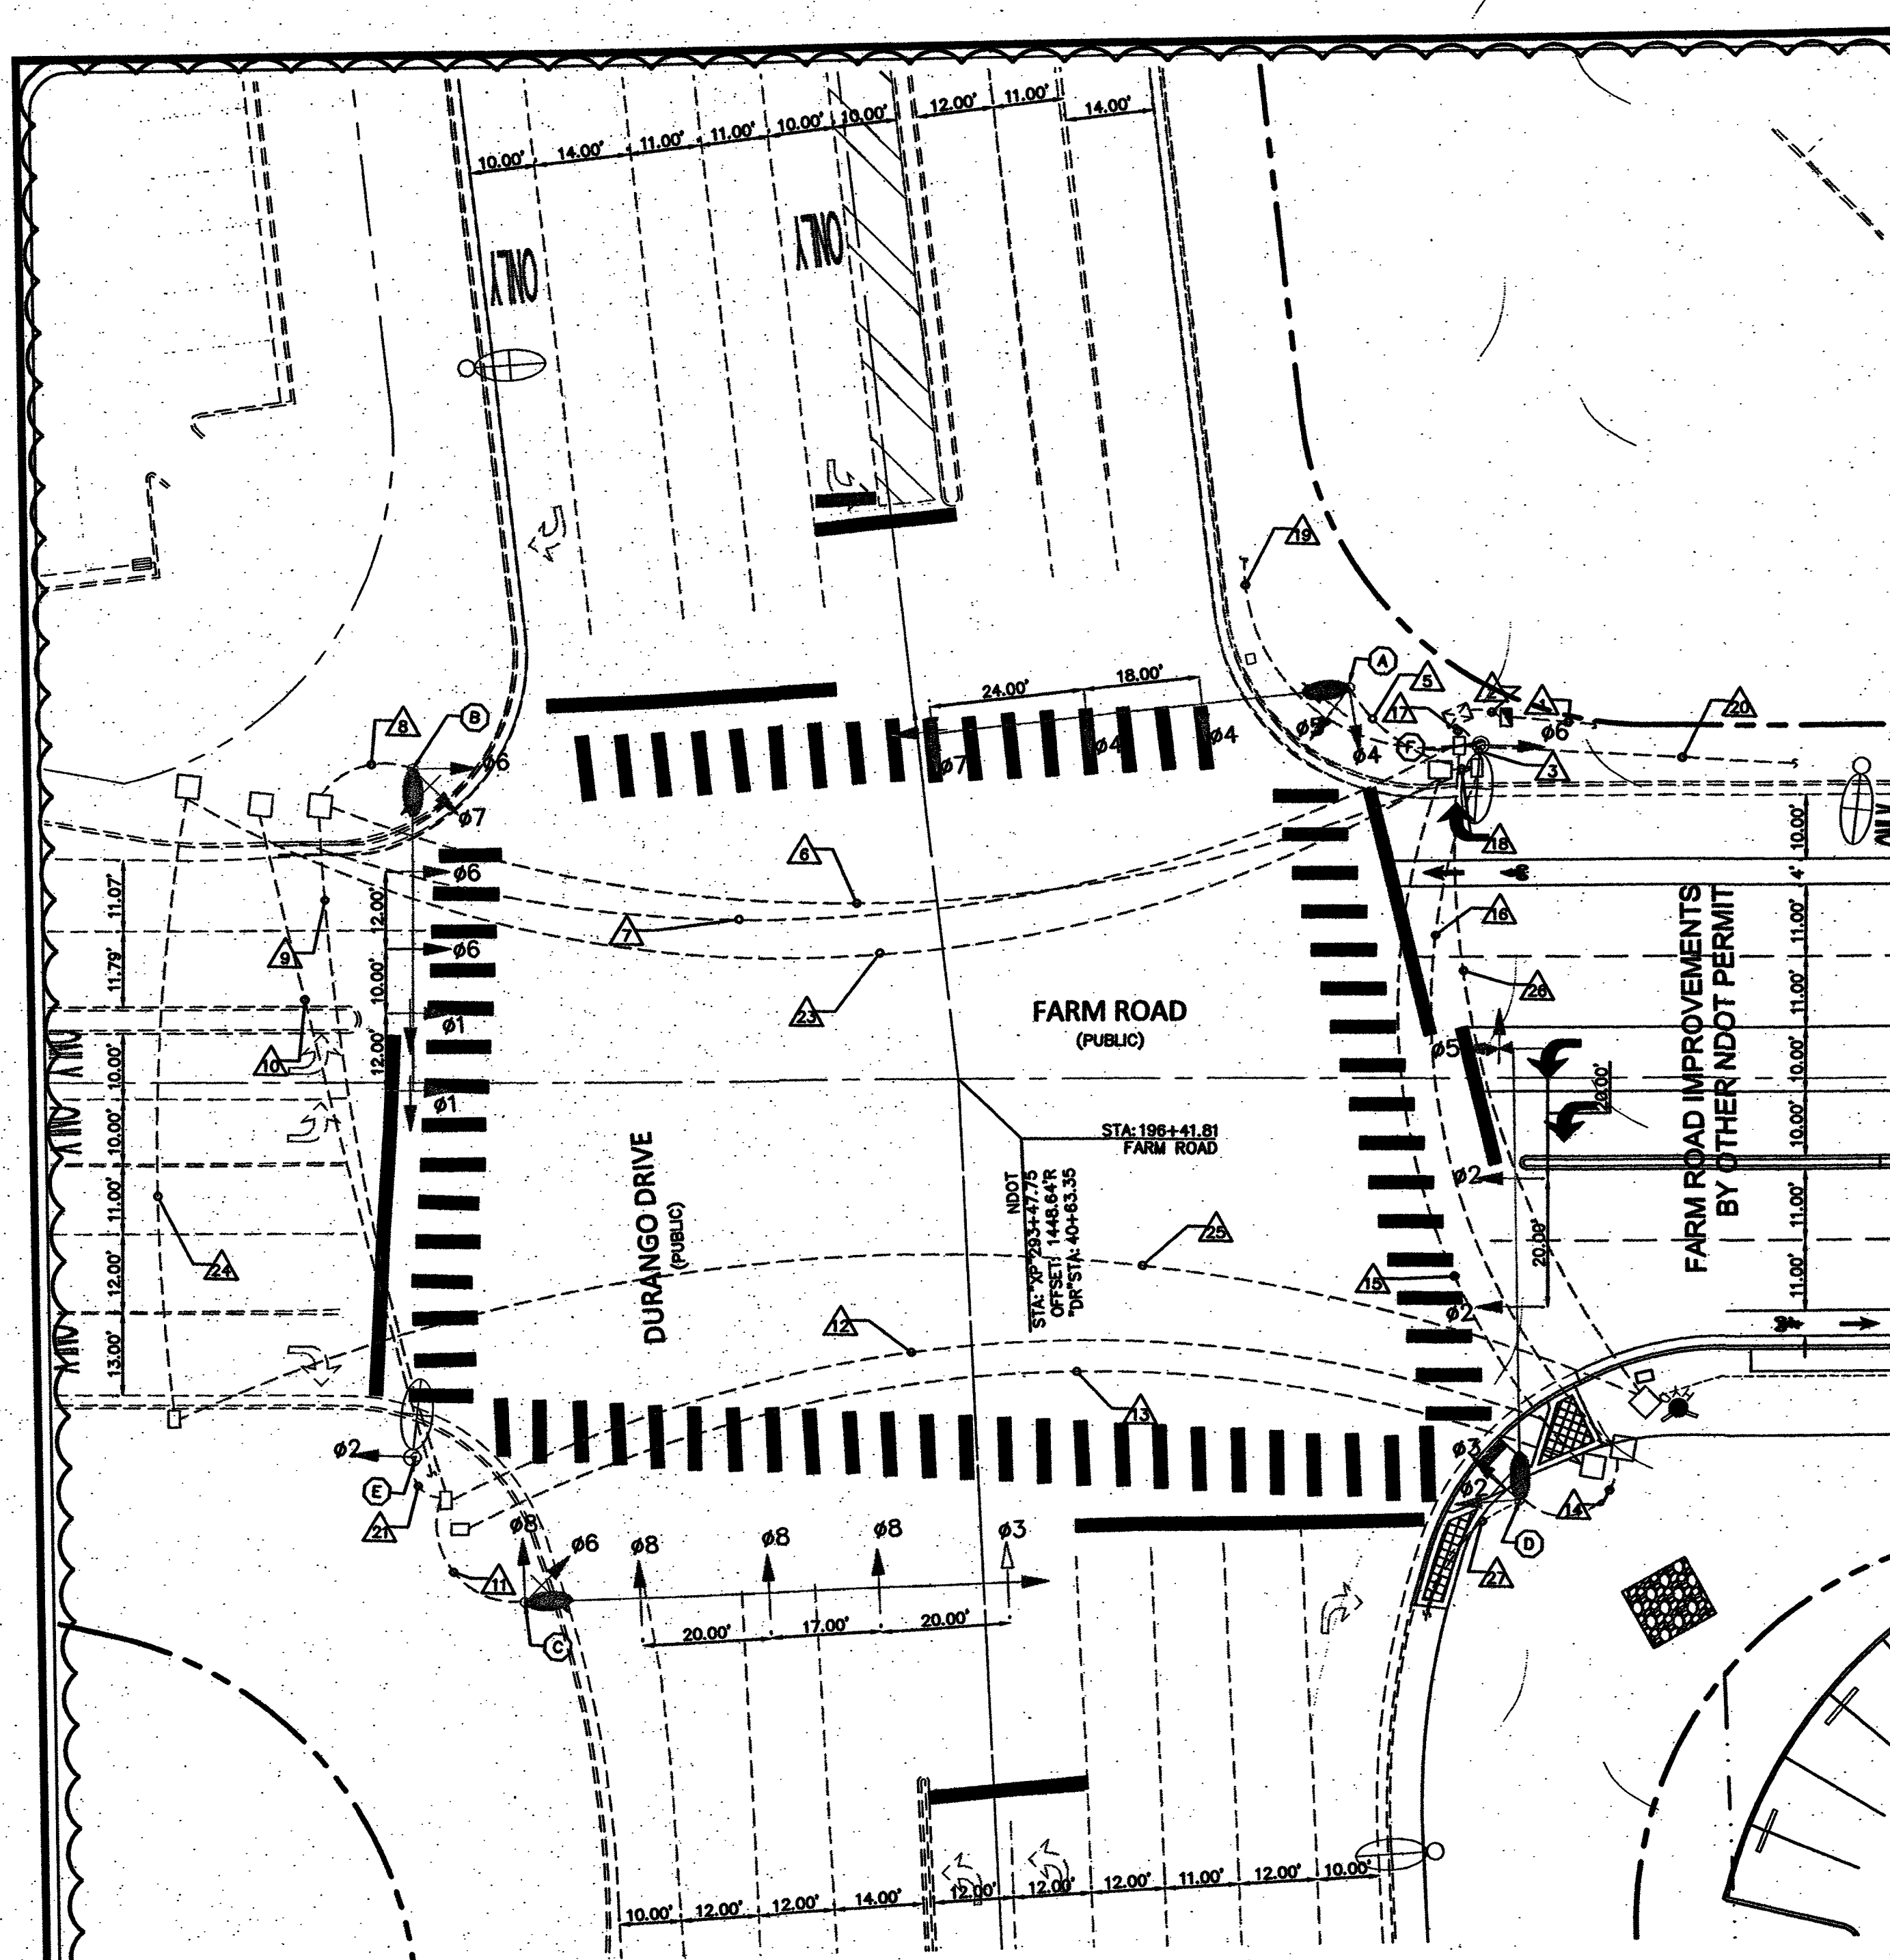


**BASIS OF BEARING**  
SOUTH 00°06'57" WEST, BEING THE WEST LINE OF THE GOVERNMENT LOT 11, LYING WITHIN THE SOUTHWEST QUARTER (SW 1/4) OF SECTION 17, TOWNSHIP 19 SOUTH, RANGE 60 EAST, M.D.M., AS SHOWN IN BOOK 140, PAGE 12 OF PLATS IN THE CLARK COUNTY, NEVADA, RECORDER'S OFFICE.




**BENCHMARK**  
CITY OF LAS VEGAS BENCHMARK # 5LV90 1756  
A RIVET AND PLATE IN THE TOP OF CURB AT THE NORTHWEST CORNER OF OSO BLANCA ROAD AND DURANGO DRIVE.

NAVD 88 ELEVATION = 798.4331 METERS / 2619.53 FEET  
NORTH AMERICAN DATUM OF 1988

|                                                               |                  |                    | CONDUIT AND WIRE SCHEDULE |     |     |---------------------------------------------------------------|------------------|--------------------|---------------------------|-----|-----|-----|-----|-----|-----|-----|-----|-----|-----|-----|-----|-----|-----|-----|-----|-----|-----|-----|-----|-----|-----|-----|-----|-----|-----|-----|
| WIRE                                                          | FROM             | TO                 | VIA CONDUIT               |     |     |                                                               |                  |                    | 1                         | 2   |
| 2#6, 2#10, 1#4 THW - EXIST.                                   | SERVICE PEDESTAL | CONTROLLER CABINET |                           | ○   |     |     | 25 COND. 2#10, 1#8 - EXIST.                                   | CONTROLLER       | POLE A             |                           |     | ○   |     | ○   |     |     | 25 COND. 2#10, 1#8 - EXIST.                                   | CONTROLLER       | POLE B             |                           |     | ⊗   |     |     | ⊗   |     | ⊗   |     |     | 25 COND. 2#10, 1#8 - EXIST.                                   | CONTROLLER       | POLE C             |                           |     | ○   |     |     |     |     |     |     |     |     | ○   | ○   |     |     |     |     |     |     |     |     |     | ○   |     |     |     |     |     |
| 25 COND. 2#10, 1#8 - EXIST.                                   | CONTROLLER       | POLE D             |                           |     | ○   |     |     |     |     |     |     |     |     |     |     |     |     |     | ○   |     |     |     |     | ○   |     |     |     |     |     |     |
| DET. CAMERA POWER, VIDEO                                      | CONTROLLER       | POLE A             |                           |     | ○   |     | ○   |     |     | DET. CAMERA VIDEO                                             | CONTROLLER       | POLE A             |                           |     | ○   |     | ○   |     |     | DET. CAMERA POWER, VIDEO                                      | CONTROLLER       | POLE B             |                           |     | ○   |     |     | ○   |     | ○   |     |     | DET. CAMERA VIDEO                                             | CONTROLLER       | POLE B             |                           |     | ○   |     |     | ○   |     | ○   |     |     | DET. CAMERA POWER, VIDEO                                      | CONTROLLER       | POLE C             |                           |     | ○   |     |     |     |     |     |     |     |     | ○   | ○   |     |     |     |     |     |     |     |     |     | ○   |     |     |     |     |     |
| DET. CAMERA VIDEO                                             | CONTROLLER       | POLE C             |                           |     | ○   |     |     |     |     |     |     |     |     | ○   | ○   |     |     |     |     |     |     |     |     |     | ○   |     |     |     |     |     |
| DET. CAMERA POWER, VIDEO                                      | CONTROLLER       | POLE D             |                           |     | ○   |     |     |     |     |     |     |     |     |     |     |     |     |     | ○   |     |     |     |     |     | ○   |     |     |     |     |     |
| DET. CAMERA VIDEO                                             | CONTROLLER       | POLE D             |                           |     | ○   |     |     |     |     |     |     |     |     |     |     |     |     |     | ○   |     |     |     |     |     | ○   |     |     |     |     |     |
| OPTICOM CABLE                                                 | CONTROLLER       | POLE A             |                           |     | ○   |     | ○   |     |     | OPTICOM CABLE                                                 | CONTROLLER       | POLE D             |                           |     | ○   |     |     |     |     |     |     |     |     |     |     |     |     |     | ○   |     |     |     |     |     | ○   |     |     |     |     |     |
| 15 COND.                                                      | CONTROLLER       | POLE E             |                           |     | ○   |     |     |     |     |     |     |     |     |     | ○   |     |     |     |     |     |     |     |     |     | ○   |     |     |     |     |     |
| 15 COND.                                                      | CONTROLLER       | POLE F             |                           |     | ○   |     |     ○   |     |     |     |     |
| XX = EXISTING    XY = PROPOSED                                |                  |                    | X INDICATES EXISTING CONDUIT TO BE REMOVED                    |                  |                    | ○ INDICATES EXISTING WIRE/CONDUIT RUNS TO REMAIN              |                  |                    | ● INDICATES EXISTING CONDUIT RUNS TO REMAIN, WIRE TO BE ADDED |                  |                    | ● INDICATES NEW WIRE/CONDUIT RUNS TO BE ADDED                 |                  |                    | CONDUIT SIZE                                                  |                  |                    | 1-2                       | 1-2 | 1-3 | 1-2 | 1-3 | 1-3 | 1-2 | 1-3 | 1-3 | 1-2 | 1-3 | 1-3 | 1-2 | 1-3 | 1-3 | 1-2 | 1-3 | 1-3 | 1-2 | 1-3 | 1-3 | 1-2 | 1-3 | 1-3 | 1-2 | 1-3 | 1-3 | 1-2 |
|                                                               |                  
XX-EXISTING XX-PROPOSED  
X INDICATES EXISTING CONDUIT TO BE REMOVED  
O INDICATES EXISTING WIRE/CONDUIT RUNS TO REMAIN  
● INDICATES EXISTING CONDUIT RUNS TO REMAIN, WIRE TO BE ADDED  
● INDICATES NEW WIRE/CONDUIT RUNS TO BE ADDED

| POLE SCHEDULE ((E)-EXISTING) |                                             |      |            |        |               |        |                              |      |                |      |                                  |
|------------------------------|---------------------------------------------|------|------------|--------|---------------|--------|------------------------------|------|----------------|------|----------------------------------|
| POLE                         | LOCATION STATION                            | TYPE | SIGNAL ARM |        | LUMINAIRE ARM |        | SIGNALS (VEH.)               |      | SIGNALS (PED.) |      | REMARKS                          |
|                              |                                             |      | QUAD       | LENGTH | QUAD          | LENGTH | TYPE                         | QUAD | TYPE           | QUAD |                                  |
| A                            | DURANGO NDOT STA(02): 292+96.28 1517.43' RT | XX-B | 4          | 65'    | 4             | 15'    | (2) M-2 (1) M-2 (ARROW) B-2T | MA   | W-3T           | 1,2  | SIGN R3-BL AND R3-4 ON MAST ARM. |
| B                            | DURANGO NDOT STA(02): 294+38.41 1484.80' RT | XX-A | 3          | 50'    | 3             | 15'    | (1) M-2 (2) M-2 (ARROW) B-2T | MA   | W-3T           | 1,4  | SIGNS R3-5 AND R3-4 ON MAST ARM. |
| C                            | DURANGO NDOT STA(02): 294+02.94 1359.14' RT | XX-B | 2          | 75'    | 2             | 15'    | (3) M-2 (1) M-2 (ARROW) B-2T | MA   |                |      | SIGN R3-BL AND R3-4 ON MAST ARM. |
| D                            | DURANGO NDOT STA(02): 292+52.40 1396.28' RT | XX-B | 1          | 70'    | 1             | 15'    | (1) M-2 (ARROW) B-14T        | MA   | W-3T           | 2,3  | SIGNS R3-5 AND R3-4 ON MAST ARM. |
| E                            | DURANGO NDOT STA(02): 294+22.90 1379.18' RT | IA   |            |        |               |        | B-11T                        | 4    | W-3T           | 3,4  |                                  |
| F                            | DURANGO NDOT STA(02): 292+74.98 1511.64' RT | IA   |            |        |               |        | A-1                          | 2    |                |      |                                  |

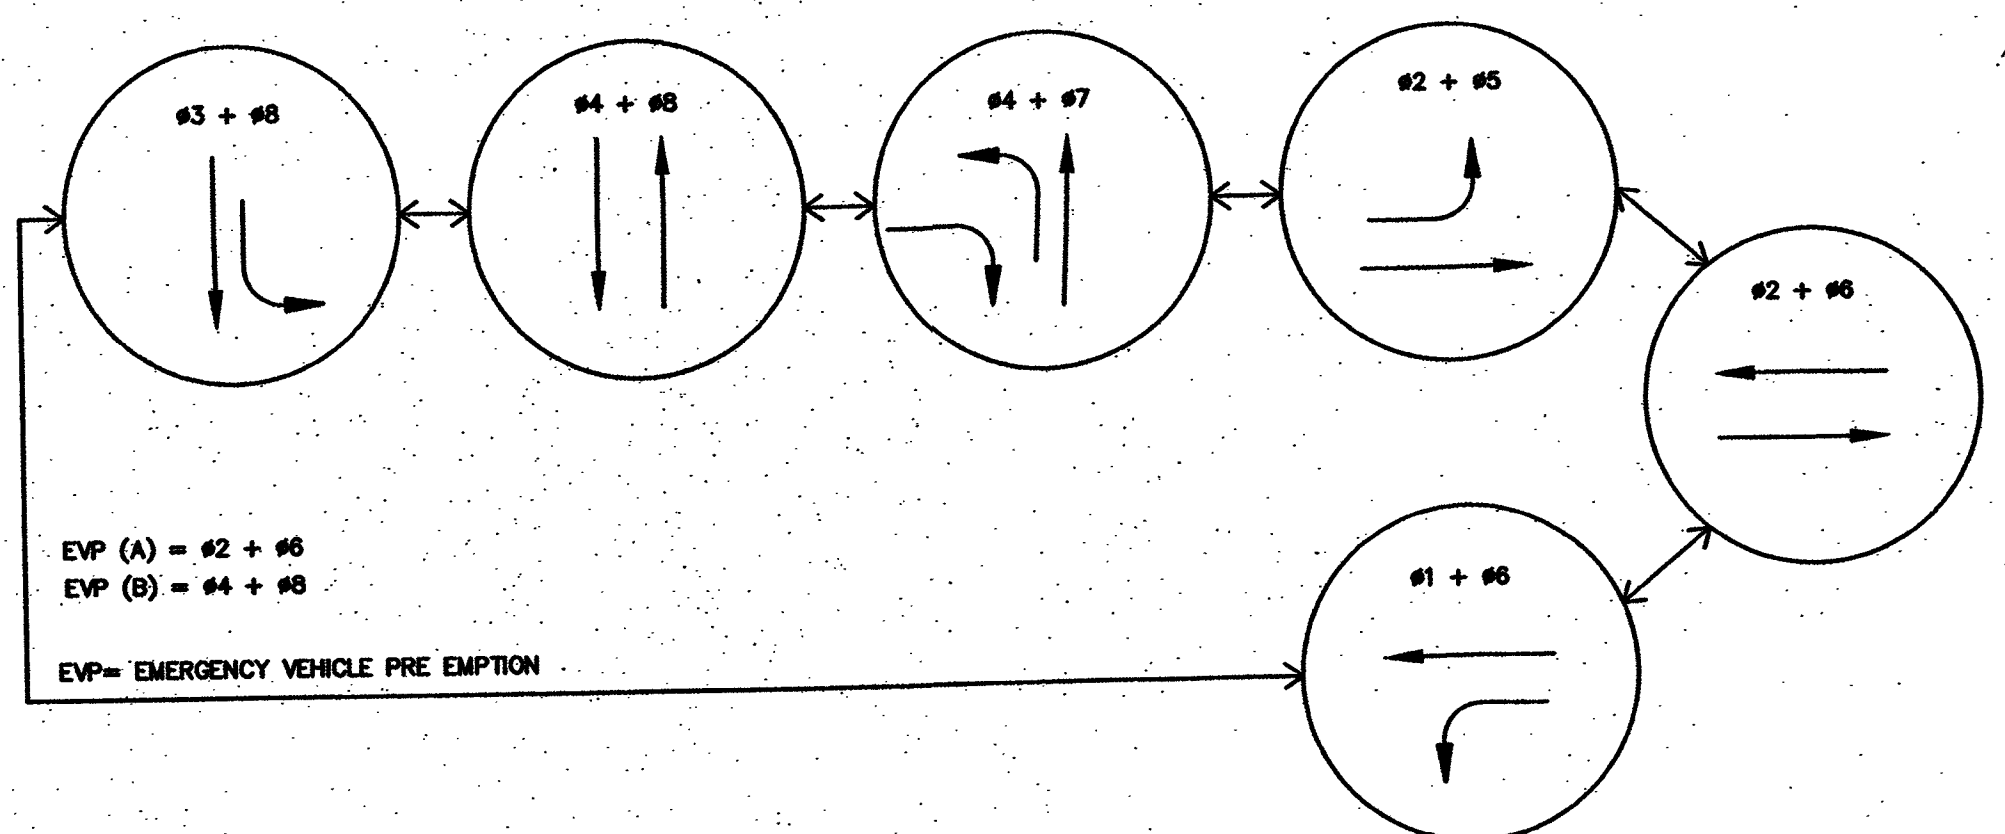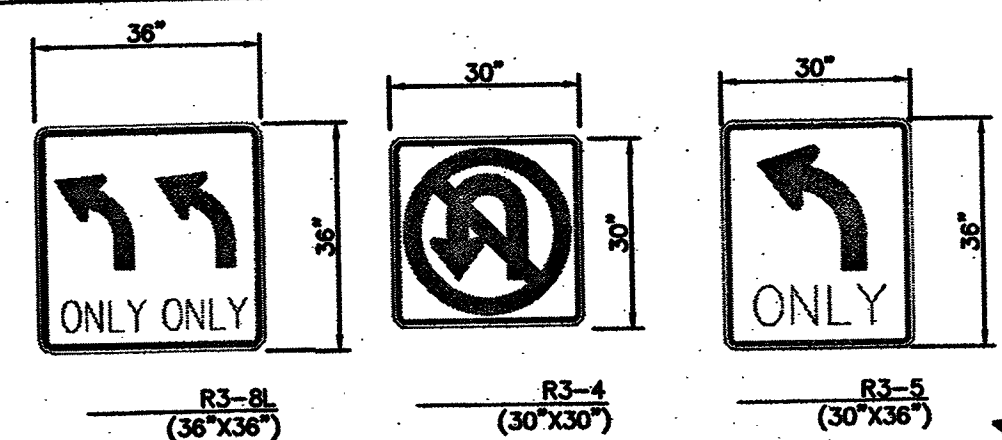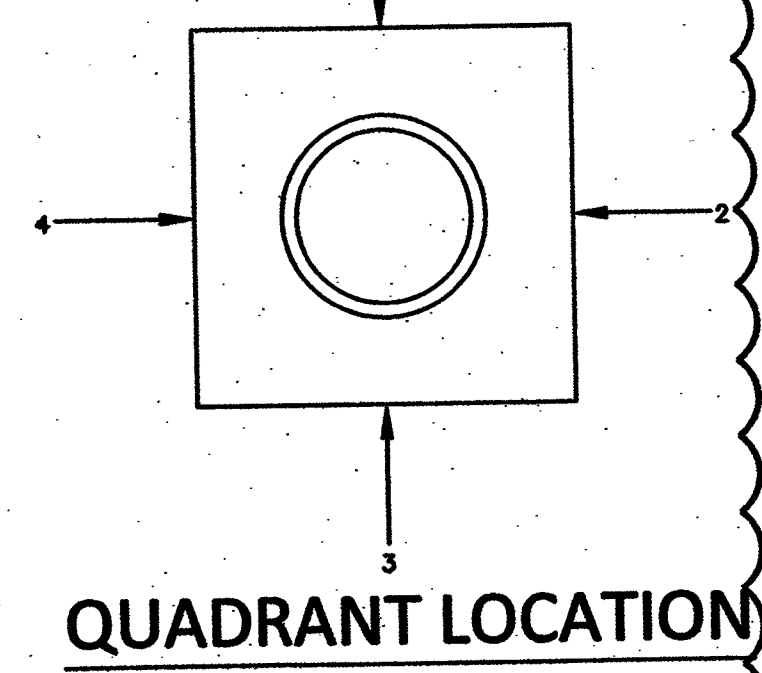

ASBUILTS  
MC4 CONSTRUCTION, LLC.  
PER PLAN EXCEPT WHERE  
NOTED 10.31.2017

- NOTES:**
- NDOT PERMIT REQUIRED FOR WORK WITHIN NDOT
  - TRAFFIC SIGNAL TO BE MAINTAINED BY CITY OF

CALL BEFORE YOU DIG  
AVOID CUTTING UNDERGROUND UTILITY LINES. IT'S COSTLY.

**Call 811**

1-800-227-2800

**FAST**

CALL BEFORE YOU DO OVERHEAD WORK

1-702-432-5300

GREENWAY AND AIRPORT SYSTEM OF TRANSPORTATION

AVOID HITTING OVERHEAD POWER LINES. IT'S COSTLY.

CALL BEFORE YOU DO OVERHEAD WORK

1-702-227-2800

COLLINS ENGINEERS ASSUMES NO RESPONSIBILITY FOR EXISTING UTILITY LOCATIONS AND ELEVATIONS. THE UTILITIES SHOWN ON THIS DRAWING HAVE BEEN PLOTTED FROM THE BEST AVAILABLE INFORMATION. IT IS, HOWEVER, THE CONTRACTOR'S RESPONSIBILITY TO FIELD VERIFY THE LOCATION AND ELEVATION OF ALL UTILITIES PRIOR TO THE COMMENCEMENT OF ANY CONSTRUCTION. CONTRACTOR TO FIELD VERIFY ALL EXISTING SITE CONDITIONS PRIOR TO CONSTRUCTION. IF A CONFLICT EXISTS BETWEEN WHAT IS SHOWN ON THESE DRAWINGS AND WHAT EXISTS IN THE FIELD, THE CONTRACTOR IS TO NOTIFY THE ARCHITECT OR ENGINEER IMMEDIATELY.

**COLLINS ENGINEERS**  
3130 S. DURANGO DR., SUITE 404  
LAS VEGAS, NV 89117  
PHONE: (702) 248-8000  
FAX: (702) 248-8070  
WWW.COLLINSENGR.COM

PROFESSIONAL ENGINEER  
THOMAS D. MILLER  
EXP. 12-31-17  
CIVIL  
NO. 15776  
6-1-17

**IMPROVEMENT PLANS FOR DC PLAZA**  
APN: 125-17-613-001  
TRAFFIC NOTES AND SIGNALS  
8451 FARM ROAD  
LAS VEGAS, NEVADA

| DESIGN |         | DESCRIPTION |    |
|--------|---------|-------------|----|
| NO.    | DATE    | BY          | TM |
| 1      | 3/13/17 | JDM         | SR |

CEI PROJECT: 4136  
DESIGN BY: JDM SR  
DRAWN BY: JDM SR  
CHECKED BY: TOM P.E.  
DATE: 03/13/17  
SCALE:  
SHEET NUMBER  
**C7.01**  
SHEET 30 OF 45  
H # 64486