


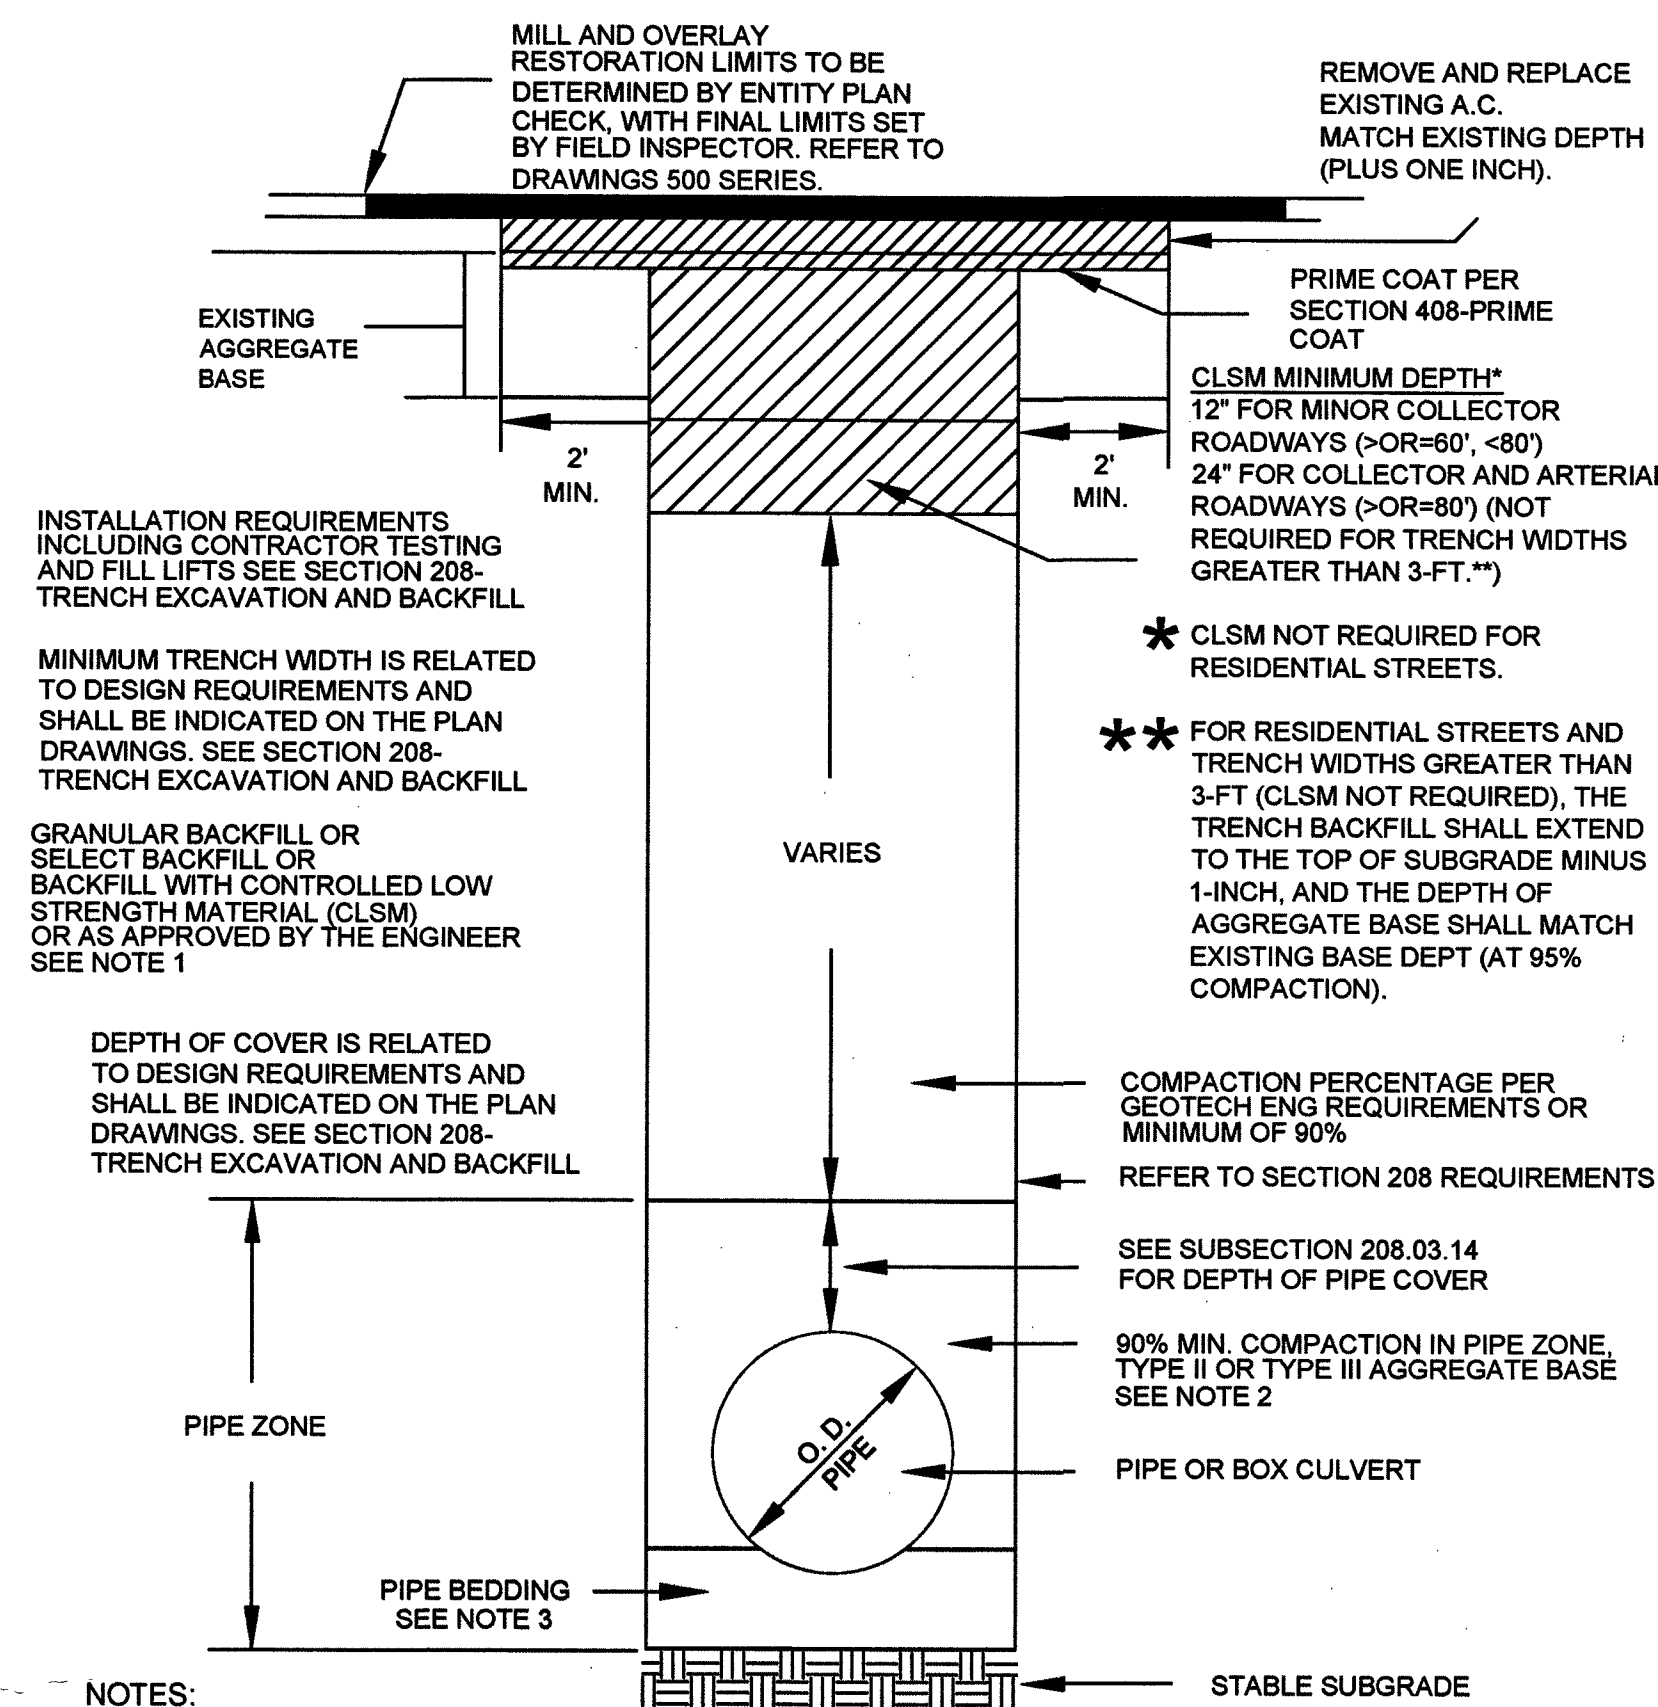

NOTES:

1. NO STONES OR LUMPS GREATER THAN 3" PERMITTED IN TRENCH 2' OR LESS IN WIDTH.
2. TRENCH WIDTH, BEDDING, SUBGRADE AND PIPE ZONE REQUIREMENTS FOR UTILITY INSTALLATIONS SHALL CONFORM TO THE RESPECTIVE ENTITY REQUIREMENTS.
3. CRUSHED ROCK MAY BE USED FOR PIPE BEDDING ONLY IF MATERIAL USE HAS BEEN SPECIFICALLY APPROVED BY THE GOVERNING AGENCY. SEE STANDARD DRAWING NO. 505 FOR PIPE BEDDING METHODS.
4. LAS VEGAS VALLEY WATER DISTRICT REQUIRES PIPE BEDDING AND BACKFILL WITHIN THE PIPE ZONE TO BE OF THE SAME MATERIAL.

RTC STD DWG 503

SYSTEM	D VALLEY WIDE
DR. NO.	21DS10026780
SEGMENT M.A.O.P.	N/A
SYSTEM M.A.O.P.	43 psig
SYSTEM M.O.P.	43 psig

AS-BUILT DRAWING-PRESSURE TEST DATA

PIPE DIA.	TEST MEDIUM	TEST METHOD
PIPE LENGTH	☐ AIR	☐ GAUGE
PIPE TYPE	☐ NITROGEN	☐ CHART
MIN. DURATION	☐ WATER	☐ GAUGE/
	☐ SOAP	PRESS REC SN#
TEST PRES. (PSIG)	START	END
TIME		
DATE		
PERFORMED BY		

PURGE PLAN WAS COMPLETED IN ACCORDANCE WITH THE OPERATIONS MANUAL GUIDELINES BY:

PRINT: _____ DATE: _____
SIGNATURE: _____

ALIGNMENT CHANGE DF 02/06/18

NO.	DESCRIPTION	BY	DATE	APPROVED
1.				
2.				
3.				
4.				

REVISIONS



PROPOSED FACILITIES (TAX CODE 02-0200):

	QTY. (DESIGN)	QTY. (AS-BUILT)
1 PROP. 2" PE SVC	55'	
2 PROP. 2" PE MAIN	626'	1
3 PROP. 2" PE COUPLING (140-3504)	4	
4 PROP. 2" PE 90° ELBOW (140-3067)	5	
5 PROP. REDUCER 4" X 2" PE PRFP (140-5118)	2	

ABANDONED FACILITIES (TAX CODE 02-0200):

	QTY. (DESIGN)	QTY. (AS-BUILT)
1 ABANDON EX. 3/4" PVC '69 SVC	79'	
2 ABANDON EX. 2" PVC '78 SVC	10'	
3 ABANDON EX. 2" PE '86 SVC	2'	
4 ABANDON EX. 2" PVC '69 SVC	164'	
5 ABANDON EX. 3/4" PVC '71 SVC	2'	
6 ABANDON EX. 2" PVC '71 MOP 43#	426'	
7 ABANDON EX. 2" PVC '71 SVC	31'	
8 ABANDON EX. 2" PE '89 SVC	3'	
9 ABANDON EX. 2" NON-ESSENTIAL BALL VALVE #NE00000	1	
10 ABANDON EX. 2" PE '06 MOP 43#	9'	
13 ABANDON EX. 3/4" PVC '70 SVC	20'	
14 ABANDON EX. 2" PE '78 SVC	9'	

PROPOSED FACILITIES (TAX CODE 02-0213):

	QTY. (DESIGN)	QTY. (AS-BUILT)
1 PROP. 2" PE SVC	130'	
2 PROP. 2" PE MAIN	16'	
3 PROP. 2" PE COUPLING (140-3504)	5	
4 PROP. 2" PE 90° ELBOW (140-3067)	2	

ABANDONED FACILITIES (TAX CODE 02-0213):

	QTY. (DESIGN)	QTY. (AS-BUILT)
1 ABANDON EX. 3/4" PVC '69 SVC	202'	
4 ABANDON EX. 2" PVC '69 SVC	2'	
5 ABANDON EX. 3/4" PVC '71 SVC	20'	
11 ABANDON EX. 1" PE '76 SVC	137'	
12 ABANDON EX. 1" PE '10 SVC	3'	
13 ABANDON EX. 3/4" PVC '70 SVC	130'	
14 ABANDON EX. 2" PE '78 SVC	10'	

CONSTRUCTION NOTES:


1. SUGGESTED GAS LOCATIONS ARE TO CLEAR SUBSTRUCTURES. LOCATE IN FIELD.
2. ALL PIPELINE CONSTRUCTION SHALL CONFORM TO APPLICABLE JURISDICTIONAL SPECIFICATIONS.
3. DO NOT SCALE THIS DRAWING.
4. SEE AC'S FOR SERVICE REPLACEMENT.
5. CHANGE IN PROPOSED MAIN LOCATION MUST BE AUTHORIZED BY SWG ENGINEER PRIOR TO INSTALLATION.
6. GAS MAINS SHALL BE PURGED PER OPERATIONS MANUAL.
7. ABANDONED SERVICE NO ACTION REQUIRED.
8. REPLACE ALL ACTIVE SERVICES EXCEPT WHERE EXISTING PE SERVICES ARE VERIFIED, INSPECTED, AND APPROVED FOR TIE-OVER BY SWG INSPECTOR.
9. EXISTING PE SERVICE, PE VERIFICATION, AND INSPECTION REQUIRED FROM MAIN TO RISER. TIE INTO NEW MAIN IF APPROVED BY SWG INSPECTOR, OTHERWISE REPLACE SERVICE.
10. EXISTING SERVICE, UNKNOWN TYPE, SIZE, AND LOCATION TO BE VERIFIED.
11. EXISTING ANODE RISER.
12. EXISTING ANODELESS RISER.
13. REPLACEMENT SVCS TO BE SINGLE OR BRANCHED. NO CROSS-LOT REPLACEMENT SVCS PERMITTED.
14. REPLACE ALL ANODE RISERS WITH ANODELESS RISERS. CITY OF LAS VEGAS PERMIT REQUIRED.
15. ALL EXISTING UTILITY LOCATION TO BE VERIFIED PRIOR TO START OF CONSTRUCTION.
16. CONTACT ENGINEERING FOR BYPASS INFORMATION.
17. ALL MAIN TIE-INS REQUIRING TEES ARE TO BE FULL-FLOW TEES UNLESS OTHERWISE STATED.
18. ALL SHORING REQUIREMENTS SHALL CONFORM TO APPLICABLE PORTIONS OF THE OPERATIONS MANUAL.
19. REQUEST FOR SURVEYING AND/OR STAKING WILL BE SUBMITTED TO ENGINEERING 72 HOURS IN ADVANCE, MINIMUM.
20. TRENCHING AND BACKFILL TO CONFORM WITH UNIFORM STANDARD SPECS. SECTION 208 AND RTC STANDARD 503.
21. PROTECT ALL EXISTING VALLEY GUTTERS IN PLACE BORE, DO NOT CUT.
22. TRENCHING AND BACKFILL TO CONFORM WITH RTC STANDARDS 500.2, 500.5 & 503 FOR ALL SERVICE REPLACEMENTS.
23. THE FOLLOWING VALVE(S) WILL BE ABANDONED ON THIS WORK REQUEST:
2" NON-ESSENTIAL BALL VALVE #NE00000 AT 444 DECATUR BLVD.
24. REPLACE EXISTING SERVICE WITH SIMILAR SIZE UNLESS OTHERWISE NOTED.
- 25.

RTC NOTES:

PAVEMENT REPAIR SHALL CONFORM TO RTC STANDARD(S):

- A1 500.3
- A2 500.4
- A3 500.5
- A4 503

EXISTING RISERS	QTY.
# OF ANODELESS RISERS	1
# OF ANODE RISERS	4

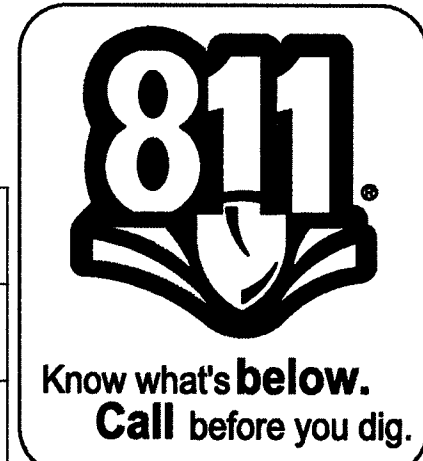

Replot

PIPE DIA.	TEST MEDIUM	TEST METHOD
PIPE LENGTH	☐ AIR	☐ GAUGE
PIPE TYPE	☐ NITROGEN	☐ CHART
MIN. DURATION	☐ WATER	☐ GAUGE/
	☐ SOAP	PRESS REC SN#
TEST PRES. (PSIG): (MAX)	(MIN)	
TIME: (START)	(STOP)	
DATE: (START)	(STOP)	
PERFORMED BY:		
SWG VERIFIED BY:		

INDIVIDUAL PERFORMING VISUAL INSPECTION	
VISUAL INSPECTION CERTIFICATION	
I HAVE VISUALLY INSPECTED ALL HEATED FUSIONS, SOLVENT CEMENT, MECHANICAL JOINTS, AND WELDS THAT I HAVE PERFORMED	
NAME	DATE
AS-BUILTS ACCEPTED BY	
POSTED BY	DATE
POSTING QC'D BY	DATE

CONSTRUCTION	
INSPECTOR	
FOREMAN	
REVIEWED BY	
PERMIT INFORMATION	
CITY OF LAS VEGAS	
TAX CODE 02-0200, 02-0213	

ISOLATION AREA	W.R. NO.
ISO_21_DIST_051	3284937
ISO_21_DIST_058	
LOCATION	ATLAS #/TILE #
T20S	x609y514
R60E R61E	x609y516
SEC 36 SEC 31	
M.D.M.	

ENGINEER/TECH: DOMINIC FOSSILE	PHONE: 702-365-2391
ACCOUNT REP:	PHONE:
PROJECT CONTACT: DOMINIC FOSSILE	PHONE: 702-365-2391
SHEET NO: 2 OF 6	SCALE: N.T.S.
DWN. BY: (SEI)	CHKD. BY:
APPRD. BY:	
TITLE 1 F - CLV DECATUR AND MEADOWS SHORT SEGMENTS REPLACEMENTS MATERIALS AND SIGNATURE SHEET	

[illegible]

CATHODIC PROTECTION NOTES:

CP READ: _____

AS-BUILT DRAWING-PRESSURE TEST DATA

WELDS CUT OUT:



1. ALIGNMENT CHANGE		DF	02/06/18											
2.														
3.														
4.														
NO.	DESCRIPTION	BY	DATE	APPVD.										
REVISIONS														
 SOUTHWEST GAS CORPORATION					SEE SHEET 2									
TAX CODES	UNIT NO.	UNIT TYPE	INSTL. PROPOSED	RETIRED COMPLETED										
PROPERTY UNITS														

AS-BUILT DRAWING-PRESSURE TEST DATA	
PIPE DIA.	TEST METHOD
PIPE LENGTH	☐ AIR ☐ GAUGE
PIPE TYPE	☐ NITROGEN ☐ CHART
MIN. DURATION	☐ WATER ☐ GAUGE/ PRESS REC SW
TEST PRES. (PSIG): (MAX)	(MIN)
TIME: (START)	(STOP)
DATE: (START)	(STOP)
PERFORMED BY:	
SWGS VERIFIED BY:	

INDIVIDUAL PERFORMING VISUAL INSPECTION VISUAL INSPECTION CERTIFICATION	
I HAVE VISUALLY INSPECTED ALL HEATED FUSIONS, SOLVENT CEMENT, MECHANICAL JOINTS, AND WELDS THAT HAVE PERFORMED	
NAME	DATE
SEE SHEET 2	
AS-BUILTS ACCEPTED BY	DATE
POSTED BY	DATE
POSTING QCD BY	DATE

CONSTRUCTION	
INSPECTOR	FOREMAN
REVIEWED BY	SEE SHEET 2
PERMIT INFORMATION	
CITY OF LAS VEGAS	
TAX CODE 02-0200, 02-0213	

ISOLATION AREA	
ISO_21_DIST_051 ISO_21_DIST_058	
LOCATION	ATLAS #/TILE #
T20S R60E R61E SEC 36 SEC 31 M.D.M.	x609y514 x609y516

W.R. NO. 3284937	
ENGINEER/TECH: DOMINIC FOSSILE	
ACCOUNT REP:	
PROJECT CONTACT: DOMINIC FOSSILE	
SHEET NO: 3 OF 6	SCALE: N.T.S.
DWN. BY: SEI	CHKD. BY:
	APPVD. BY:
TITLE	
F - CLV DECATUR AND MEADOWS SHORT SEGMENTS REPLACEMENTS	
STEEL MATERIALS AND SIGNATURE SHEET	



ABANDONED FACILITIES:

- 1 ABANDON EX. 3/4" PVC '69 SVC
- 2 ABANDON EX. 2" PVC '78 SVC
- 4 ABANDON EX. 2" PVC '69 SVC
- 5 ABANDON EX. 3/4" PVC '71 SVC
- 7 ABANDON EX. 2" PVC '71 SVC
- 9 ABANDON EX. 2" NON-ESSENTIAL BALL VALVE #NE00000
- 11 ABANDON EX. 1" PE '76 SVC
- 12 ABANDON EX. 1" PE '10 SVC

QTY. (AS-BUILT) 02-0200	QTY. (AS-BUILT) 02-0213

EX. 2" PE '78

EX. 2" PE '78

EX. 1" PE '76

EX. 1" PE '79

VERIFY TIE-IN DEPTH

CLV NOTICE: HORIZONTAL DISTANCE BETWEEN PROPOSED GAS MAIN TO EX. SERVICE SHOULD BE MIN. SIX FEET

DECATUR BLVD. (PUBLIC)

DECATUR BLVD. (PUBLIC)

NOTE: ABANDON ALL PVC FACILITIES

APN: 139-31-201-004

EX. 4" STL '67
WR# PE1939
MOP43#

EX. 4" STL '60
WR# PE172
MOP43#

MAYFLOWER LN. (PUBLIC)

VICINITY MAP

N.T.S.

LEGEND:

- EXISTING GAS LINE
- GAS LINE TO BE ABANDONED
- EXISTING GAS SERVICE
- PROPOSED MAIN GAS LINE (NEW)
- PROPOSED SERVICE LATERAL (NEW)
- PROPOSED SERVICE LINE (NEW)
- RIGHT OF WAY LINE
- STREET CENTERLINE
- PROPERTY LINE
- BACK OF CURB
- MATCHLINE
- EASEMENT
- EXISTING ANODELESS RISER
- EXISTING ANODE RISER
- EXISTING GAS LIGHT
- EXISTING GAS VALVE

RTC NOTES:

PAVEMENT REPAIR SHALL CONFORM TO RTC STANDARD(S):

- A2 500.4
- A3 500.5
- A4 503

PROPOSED FACILITIES:

- 2 PROP. 2" PE MAIN
- 4 PROP. 2" PE 90° ELBOW
- 5 PROP. PE REDUCER 4" X 2"
- 1 PROP. 2" STL CAP
- 2 PROP. 4" TRANS. FITTING
- 3 PROP. 4" 3-WAY TEE

QTY. (AS-BUILT) 02-0200	QTY. (AS-BUILT) 02-0213

MATCHLINE - SEE SHEET 5 FOR CONTINUATION



1.	ALIGNMENT CHANGE	DF	02/06/18	
2.				
3.				
4.				
NO.	DESCRIPTION	BY	DATE	APPVD.
REVISIONS				



TAX CODES	UNIT NO.	UNIT TYPE	INSTL. PROPOSED	RETIRED	INSTL. COMPLETED	RETIRED
PROPERTY UNITS						

AS-BUILT DRAWING-PRESSURE TEST DATA

PIPE DIA.	TEST MEDIUM	TEST METHOD
PIPE LENGTH	☐ AIR	☐ GAUGE
PIPE TYPE	☐ NITROGEN	☐ CHART
MIN. DURATION	☐ WATER	☐ GAUGE
TEST PRES. (PSIG) (MAX)	☐ SOAP	☐ PRESS REC SNV
TIME (START)	(MIN)	(STOP)
DATE (START)	(STOP)	(STOP)
PERFORMED BY:		
SWG VERIFIED BY:		

INDIVIDUAL PERFORMING VISUAL INSPECTION

VISUAL INSPECTION CERTIFICATION

I HAVE VISUALLY INSPECTED ALL HEATED FUSIONS, SOLVENT CEMENT, MECHANICAL JOINTS, AND WELDS THAT HAVE PERFORMED

NAME _____ DATE _____

SEE SHEET 2

AS-BUILTS ACCEPTED BY _____ DATE _____

POSTED BY _____ DATE _____

POSTING QCD BY _____ DATE _____

CONSTRUCTION

INSPECTOR _____

FOREMAN _____

REVIEWED BY _____

PERMIT INFORMATION

CITY OF LAS VEGAS

TAX CODE 02-0200, 02-0213

ISOLATION AREA

ISO_21_DIST_051

ISO_21_DIST_058

LOCATION

T20S

R60E | R61E

SEC 36 | SEC 31

M.D.M.

W.R. NO. 3284937

ATLAS #/TITLE # x609y514 x609y516

ENGINEER/TECH: DOMINIC FOSSILE

ACCOUNT REP: _____

PROJECT CONTACT: DOMINIC FOSSILE

SHEET NO. 4 OF 6

SCALE: 1" = 40'




DATE: 11/01/16

DWN. BY: (SEI) CHKD. BY: _____

APPVD. BY: _____

TITLE

F - CLV DECATUR AND MEADOWS SHORT SEGMENTS REPLACEMENTS DESIGN PLAN

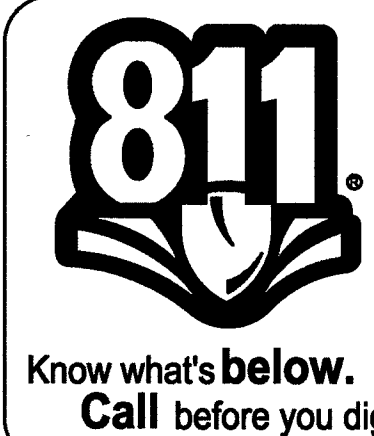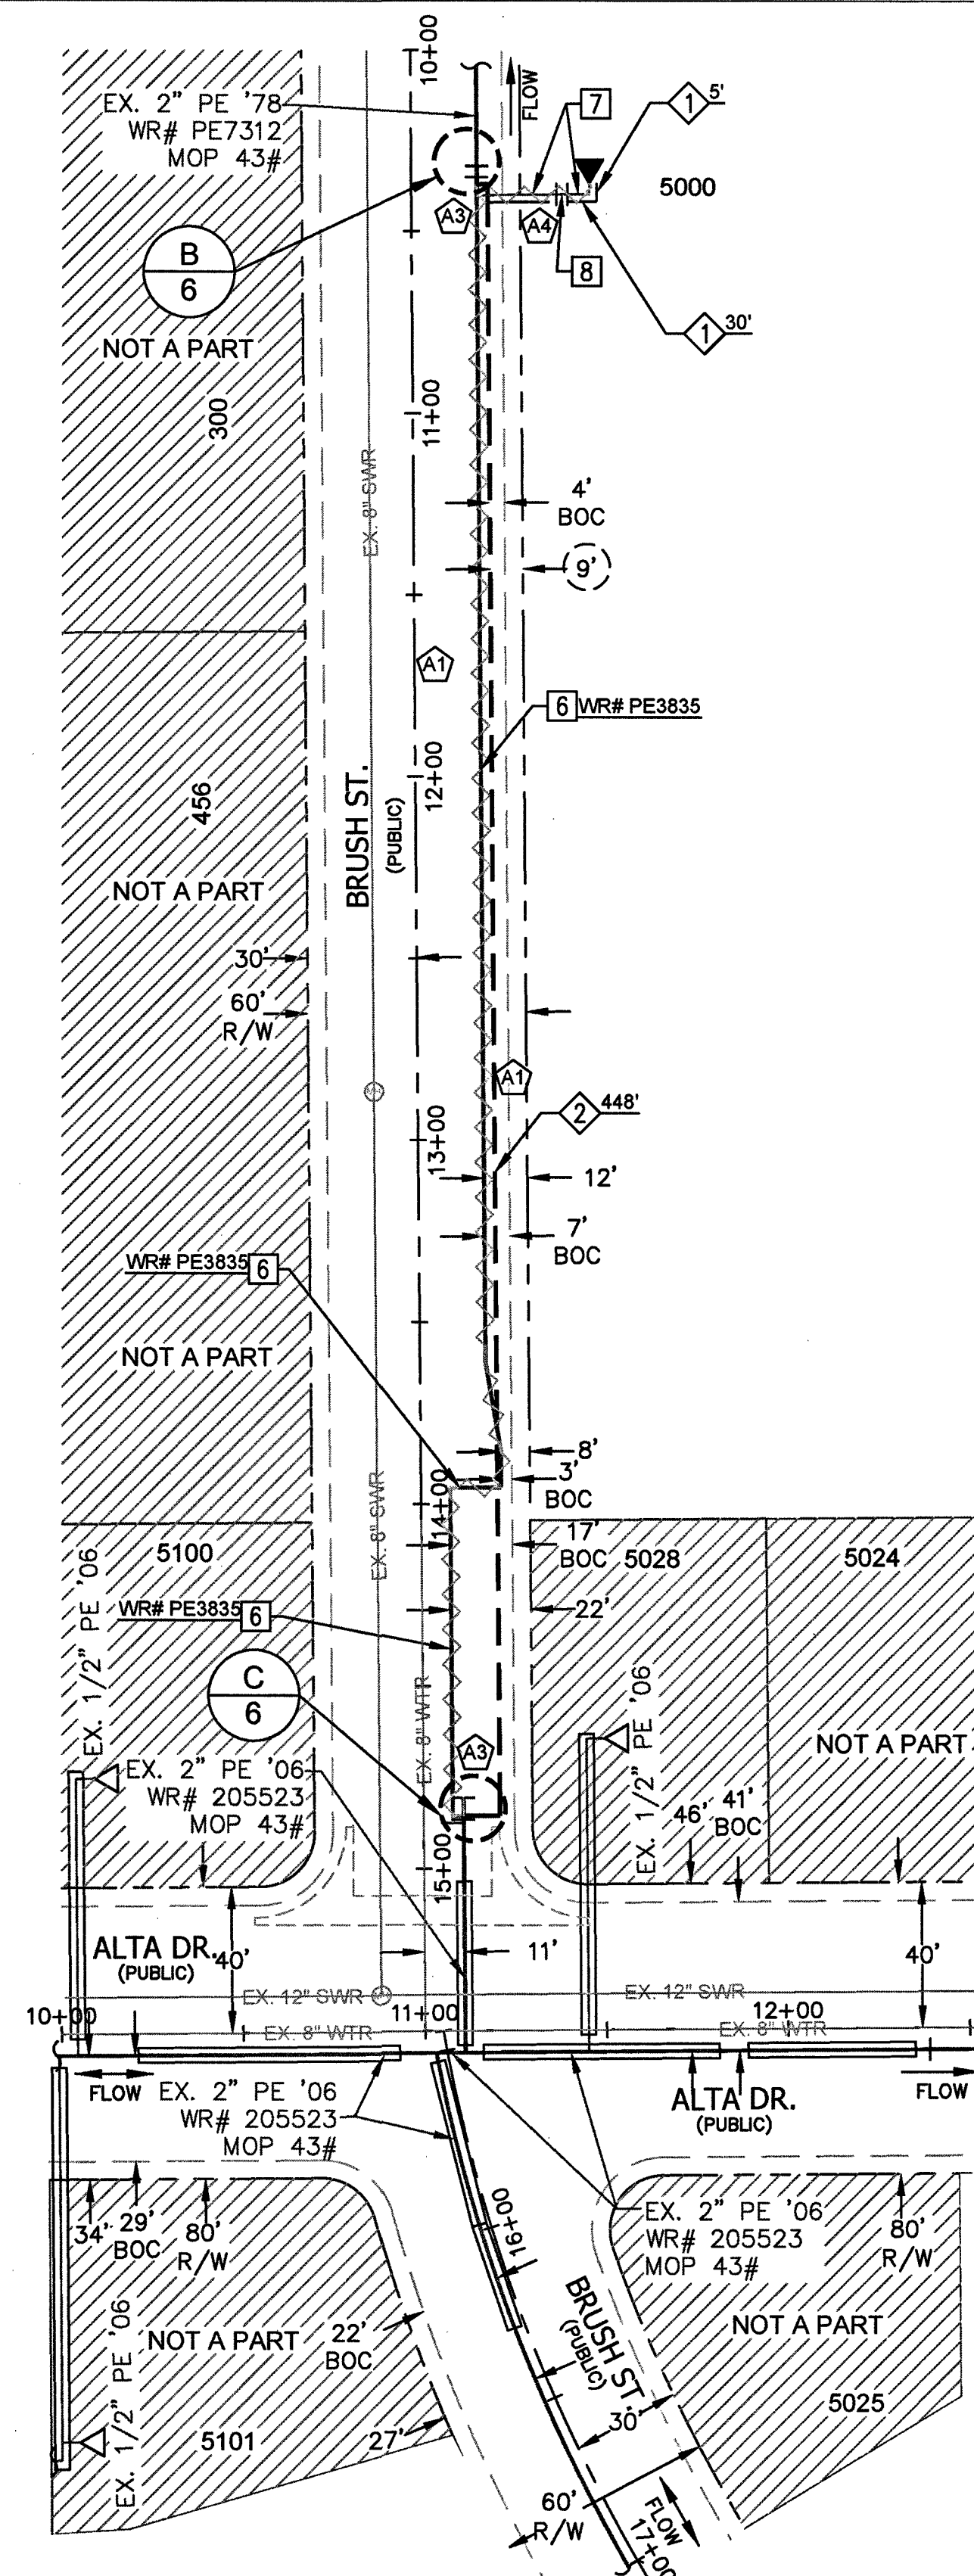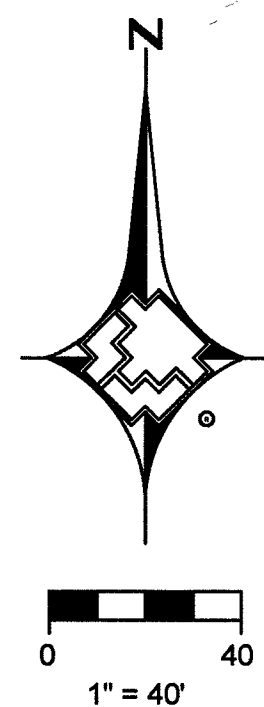

NO.	DESCRIPTION	BY	DATE	APPVD.
1	ALIGNMENT CHANGE	DF	02/06/18	
2				
3				
4				



TAX CODES	UNIT NO.	UNIT TYPE	INSTL. PROPOSED	RETIRED	INSTL. COMPLETED	RETIRED

AS-BUILT DRAWING-PRESSURE TEST DATA

PIPE DIA.	TEST MEDIUM	TEST METHOD
PIPE LENGTH	☐ AIR ☐ GAUGE	☐ CHART
PIPE TYPE	☐ NITROGEN ☐ WATER	☐ SOAP
MIN. DURATION		PRESS REC SN#
TEST PRES. (PSIG) (MAX)	(MIN)	
TIME (START)	(STOP)	
DATE (START)	(STOP)	
PERFORMED BY:		
SWG VERIFIED BY:		

INDIVIDUAL PERFORMING VISUAL INSPECTION
VISUAL INSPECTION CERTIFICATION

I HAVE VISUALLY INSPECTED ALL HEATED FUSIONS, SOLVENT CEMENT, MECHANICAL JOINTS, AND WELDS THAT HAVE PERFORMED

NAME _____ DATE _____

SEE SHEET 2

AS-BUILTS ACCEPTED BY _____ DATE _____

POSTED BY _____ DATE _____

POSTING QC'D BY _____ DATE _____

CONSTRUCTION

INSPECTOR _____

FOREMAN _____

REVIEWED BY _____

SEE SHEET 2

PERMIT INFORMATION

CITY OF LAS VEGAS

TAX CODE 02-0200, 02-0213

ISOLATION AREA	W.R. NO.
ISO_21_DIST_051 ISO_21_DIST_058	3284937
LOCATION	ATLAS #/TITLE #
T20S R60E R61E SEC 36 SEC 31 M.D.M.	x609y514 x609y516

ENGINEER/TECH: DOMINIC FOSSILE	PHONE: 702-365-2391
ACCOUNT REP:	PHONE:
PROJECT CONTACT: DOMINIC FOSSILE	PHONE: 702-365-2391
SHEET NO: 5 OF 6	SCALE: 1" = 40'
DWN. BY: (SEI)	CHKD. BY:
DATE: 11/01/16	APPVD. BY:

TITLE 1 F - CLV DECATUR AND MEADOWS SHORT SEGMENTS REPLACEMENTS DESIGN PLAN

PROPOSED FACILITIES:

- 1 PROP. 2" PE SVC
- 2 PROP. 2" PE MAIN
- 3 PROP. 2" PE COUPLING (140-3504)

QTY.
(AS-BUILT)
02-0200

ABANDONED FACILITIES:


- 6 ABANDON EX. 2" PVC '71 MOP 43#
- 7 ABANDON EX. 2" PVC '71 SVC
- 8 ABANDON EX. 2" PE '89 SVC

QTY.
(AS-BUILT)
02-0200

RTC NOTES:


PAVEMENT REPAIR SHALL CONFORM TO RTC STANDARD(S):

- A1 500.3
- A3 500.5
- A4 503

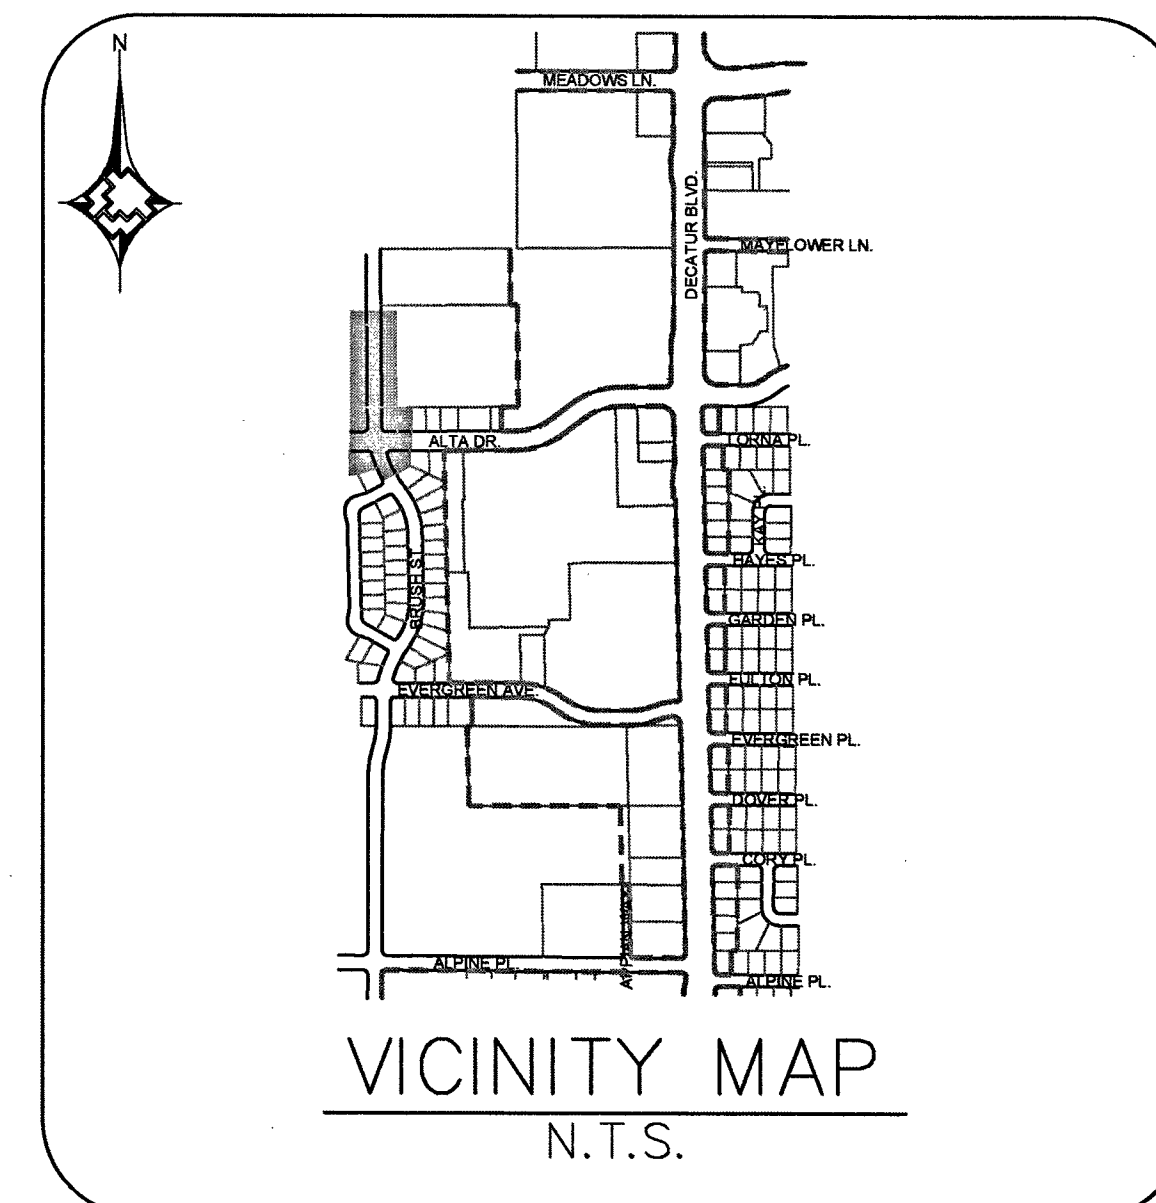

LEGEND:

- EXISTING GAS LINE
- GAS LINE TO BE ABANDONED
- EXISTING GAS SERVICE
- PROPOSED MAIN GAS LINE (NEW)
- PROPOSED SERVICE LATERAL (NEW)
- PROPOSED SERVICE LINE (NEW)
- RIGHT OF WAY LINE
- STREET CENTERLINE
- PROPERTY LINE
- BACK OF CURB
- MATCHLINE
- EASEMENT
- EXISTING ANODELESS RISER
- EXISTING ANODE RISER
- EXISTING GAS LIGHT
- EXISTING GAS VALVE

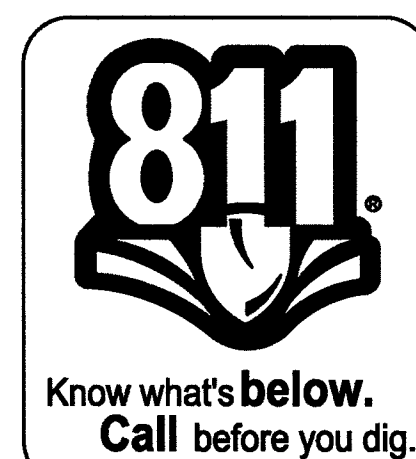

2	PROP. 2" PE MAIN
3	PROP. 2" PE COUPLING (140-3504)
4	PROP. 2" PE 90° ELBOW (140-3067)

QTY. (AS-BUILT) 02-0200	QTY. (AS-BUILT) 02-0213

1	ABANDON EX. 3/4" PVC '69 SVC
3	ABANDON EX. 2" PE '86 SVC
4	ABANDON EX. 2" PVC '69 SVC
6	ABANDON EX. 2" PVC '71 MOP 43#
10	ABANDON EX. 2" PE '06 MOP 43#
14	ABANDON EX. 2" PE '78 SVC

QTY. (AS-BUILT) 02-0200	QTY. (AS-BUILT) 02-0213

1. ALIGNMENT CHANGE		DF	02/08/18																																																																																																																																																																																																																																																																																																																																																																																																																																																																																																																																																																																																																																																																																																																																																																																																																																																																																																																																																																																																																																																																																																																																																																																																																																																																																																																																																																																																																																																																																																																									
---------------------	--	----	----------	--	--	