


LEGEND	
1	INSTALL B-36 PULL BOX (24"x36"x24")
2	EXISTING B-36 PULL BOX (24"x36"x24")
3	INSTALL B-50 PULL BOX (13"x24"x24")
4	EXISTING B-50 PULL BOX (13"x24"x24")
5	INSTALL B-100 PULL BOX (24"x36"x24")
6	EXISTING B-100 PULL BOX (24"x36"x24")
7	INSTALL T-200 CATV VAULT (30"x48"x36")
8	EXISTING T-200 CATV VAULT (30"x48"x36")
9	INSTALL T-400 CATV VAULT (36"x60"x36")
10	EXISTING T-400 CATV VAULT (36"x60"x36")
11	INSTALL T-600 CATV VAULT (48"x72"x36")
12	EXISTING T-600 CATV VAULT (48"x72"x36")
13	INSTALL NEW CATV PEDESTAL
14	EXISTING NEW CATV PEDESTAL
15	R&R S/W SLAB(S)
16	POTHOLE
17	---c--- SIDEWALK/DIRT TRENCH INSTALL
18	---c--- ASPHALT/STREET TRENCH INSTALL
19	---b--- PROPOSED BORE
20	---x--- EXISTING CATV CONDUIT(S)
21	---OHC--- PROPOSED OVERHEAD FIBER OPTIC CABLE OR COAX INSTALL
22	---XOHC--- EXISTING OVERHEAD FIBER OPTIC CABLE OR COAX
23	--- --- U.G. FIBER/COAX PULL
24	--- --- RIGHT OF WAY LINE
25	--- --- LOT/PROPERTY LINE
26	--- --- EDGE OF PAVEMENT
27	[P] EXISTING NVE PULL BOX
28	[T] EXISTING TELCO PULL BOX
29	[M] EXISTING TELCO MANHOLE
30	[T] EXISTING TELCO POLE
31	[NVE] EXISTING NVE TRANSMISSION POLE
32	[NVE] EXISTING NVE TRANSMISSION POLE
33	[X] EXISTING JOINT POLE
34	[X] EXISTING JOINT POLE WITH TRANSFORMER
35	[A] POLE ANCHOR
36	[TS] EXISTING NVE TRANSFORMER TRANSFORMER PAD
37	[TS] SNWA TEST STATION
38	[TS] COX POWER SUPPLY (49"x24"x52")
39	[RC] INSTALL RHINO CABINET
40	[RC] RISER POLE/QUADRANT DETAIL RISER OWNERSHIP NOTED
41	[R] RAILROAD
42	[M] EXISTING MANHOLE (SS),(SD)...ECT
43	--- --- 1in CONDUIT LATERAL
44	[S] STORMWATER ASSETS
45	

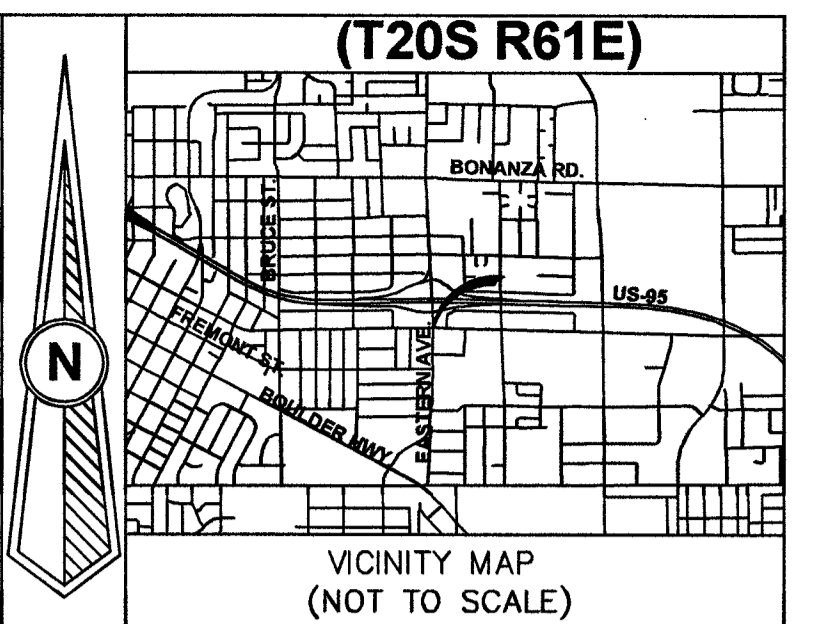

REVISIONS			
REV	DESCRIPTION	DATE	BY
Δ	ADDED B50/CHANGED CONDUIT COUNT	12/7	MM

ALL CONSTRUCTION AND MATERIALS SHALL BE IN ACCORDANCE WITH THE "UNIFORM STANDARD SPECIFICATIONS FOR PUBLIC WORKS CONSTRUCTION OFF-SITE IMPROVEMENTS, CLARK COUNTY AREA NEVADA" LATEST ISSUE; THE "UNIFORM STANDARD DRAWINGS FOR PUBLIC WORKS CONSTRUCTION, CLARK COUNTY AREA NEVADA" LATEST ISSUE; AND OTHER APPLICABLE APPROVED STANDARDS ISSUED BY THE CONTROLLING AGENCY; ALL LOCAL CITY CODES AND ORDINANCES APPLICABLE.

**APPROVED FOR CONSTRUCTION**  
 THIS APPROVAL IS FOR WORK IN CLV R/W OR CLV EASEMENT ONLY. OBTAINING PERMISSION OR EASEMENT FOR WORK SHOWN IN PRIVATE PROPERTY IS THE RESPONSIBILITY OF THE UTILITY.

APPROVAL: [Signature] DATE: 1 10 19

PERMIT # 142452A  
 DRAWN BY: MM  
 DATE: 10-2-18  
 SCALE: 1:30  
 NODE: 142452A  
 PROJECT #: 405201800000142452  
 TECH #: 702-545-1711  
 APPROVED BY: DAN RISSO

**COX**  
 1700 VEGAS DRIVE  
 LAS VEGAS, NEVADA 89106  
 PHONE: (702) 545-1606  
 FAX: (702) 545-2806

CITY/ENTITY: CITY OF LAS VEGAS  
 333 N. RANCHO DRIVE  
 LAS VEGAS, NEVADA 89106  
 (702) 229-6885

PROJECT LOCATION: EASTERN AVE & STEWART AVE

SUB-CONTRACTOR: DBA: COX COMMUNICATIONS

ENTITY NOTES: EASTERN AVE & STEWART AVE

SHEET No: **1**

SHEET 1 OF 1

**DISCLAIMER NOTE**

UTILITY LOCATIONS SHOWN HEREON ARE APPROXIMATE ONLY. IT SHALL BE THE CONTRACTOR'S RESPONSIBILITY TO DETERMINE THE EXACT HORIZONTAL AND VERTICAL LOCATION OF ALL EXISTING UNDERGROUND AND OVERHEAD UTILITIES PRIOR TO COMMENCING CONSTRUCTION. NO REPRESENTATION IS MADE THAT ALL EXISTING UTILITIES ARE SHOWN HEREON. THE ENGINEER ASSUMES NO RESPONSIBILITY FOR UTILITIES NOT SHOWN OR UTILITIES NOT SHOWN IN THEIR PROPER LOCATIONS.

**BEFORE YOU DIG**  
 OR 1-800-227-2600  
 UNDERGROUND SERVICE (USA)

**BEFORE YOU OVERHEAD**  
 1-702-227-2929  
 NEVADA POWER ENVIRONMENT AND SAFETY SERVICE DEPARTMENT

AVOID CUTTING UNDERGROUND UTILITY LINES. IT'S COSTLY.

AVOID OVERHEAD POWER LINE CONTACT

CALL BEFORE YOU DO UNDERGROUND.

CALL BEFORE YOU OVERHEAD.

TOTAL BORE	402'
TOTAL DIRT TRENCH	10'
TOTAL ASPHALT TRENCH	0'
TOTAL TRENCH	10'
TOTAL S/W PANELS	8
TOTAL LINEAR FOOTAGE	40'

REPORT

12/11/18  
 LK-02191-R001