

OFFSITE INSPECTION & TESTING
333 NORTH RANCHO DRIVE
LAS VEGAS, NV 89106
PHONE: (702) 229-6337
FAX: (702) 631-3000

 Sewer

- NOTE: THE TOP PART OF THIS FORM MUST BE FILLED OUT IN ITS ENTIRETY**

Revised: 06-03-15



City of Las Vegas
Department of Public Works
Survey Section

REVIEW CHECKLIST
STORM DRAIN
FINAL LOCATION MAP

JOB NUMBER L17-00900 SD2
PROJECT NAME ELKHORN AND GRAND CANYON
WORK AUTH. NO. P28000
SUBMITTED BY TRI-CORE (GREGORY D SPINKELINK)
PROJECT TYPE CIP ☐ Land Dev ☒ Street Rehab ☐
DATE 12/13/18
REVIEWED BY D. SANTANA

REVIEW DETERMINATION

- ☒ Approved
☐ Not Acceptable

TO BE RE-SUBMITTED

- ☐ Two bond copies (no mylar)
☐ Electronic media with comma-separated coordinate file


REVIEW ITEM	OK	SEE R/L	N/A	COMMENTS
Submittal Contents				
Two bond copies (no mylar)	☒	☐	☐	
Electronic media containing comma-separated coordinate file	☒	☐	☐	
General Map Contents				
Sheet size 24" x 36"	☐	☐	☐	
Sheet number and number of sheets	☐	☐	☐	
North arrow (pointing up, left or right)	☐	☐	☐	
Scale (written & graphic, correctly shown, appropriate scale used)	☐	☐	☐	
Lettering legibility (minimum text size 0.08")	☐	☐	☐	
Map title shown ("Storm Drain Final Location Map")	☐	☐	☐	
CLV project name shown	☐	☐	☐	
CLV Hansen No. shown	☐	☐	☐	
CLV Drawing No. shown	☐	☐	☐	
Preparer's company name and contact information shown	☐	☐	☐	
Legend (all linetypes and symbols defined)	☐	☐	☐	
Non-standard abbreviations defined	☐	☐	☐	
Distances, coordinates and elevations labeled using decimal feet	☐	☐	☐	
Approximate limits of streets shown (improvements or right-of-way)	☐	☐	☐	
Street names labeled (identified as public or private)	☐	☐	☐	

REVIEW CHECKLIST – STORM DRAIN FINAL LOCATION MAP

REVIEW ITEM	OK	SEE R/L	N/A	COMMENTS
Storm Drain Improvements Data				
*NOTE As of December 1, 2015 manhole cover locations are no longer required.				
Manhole Barrel/Base: (measured horizontally at centerline of barrel/base structure, vertical location does not apply)	☐	☐	☒	
Drop Inlets (measured horizontally at back of curb at each outer extent of box, vertically at top of curb)	☒	☐	☐	
Vaults and Junction Structures (measured horizontally at all outer extents of structure, vertically at top of structure)	☐	☐	☒	
Pipes and RCB's: locate at all connections to other pipes and structures, all horizontal and vertical deflections, points of termination (stubs), point at which pipe/RCB exits the public right-of-way or easement (measured horizontally at centerline of pipe/RCB, vertically at top of pipe/RCB)	☒	☐	☐	
*NOTE All pipe connections to manholes and other structures should be located at outside face of structure before backfilling due to accuracy limitations of pipe measurements from the structure's surface access point.				
Coordinate Information				
Data acquisition completion date indicated	☒	☐	☐	
Coordinate system indicated (only CLV approved coordinate systems are to be used)	☒	☐	☐	
Horizontal datum, datum adjustment, and epoch date indicated (only CLV approved datums are to be used)	☒	☐	☐	
Benchmark ID, description, elevation indicated	☒	☐	☐	
Statement of positional accuracy per the tolerances indicated below	☒	☐	☐	
*NOTE For all projects with improvement plans approved prior to March 1, 2015 coordinates provided must be accurate to within ± 0.5 feet horizontally and vertically. For all projects with improvement plans approved after March 1, 2015 coordinates provided must be accurate to within ± 0.3 feet horizontally and vertically.				
Coordinate accuracy QA/QC (when available)	☐	☐	☒	

ADDITIONAL COMMENTS

POINT TABLE				
POINT #	NORTHING	EASTING	ELEVATION	DESCRIPTION
9200	26808064.17	737840.80	2760.35	TBC @ DI
9201	26808063.97	737860.09	2759.62	TBC @ DI
9202	26808097.07	737895.21	2759.73	TBC @ DI
9203	26808117.69	737895.22	2759.81	TBC @ DI
9206	26808503.28	737897.00	2754.99	TOP 18" CMP OUT
9500	26808095.09	737946.98	2747.82	INV @ SSMH CL BARREL
9501	26808493.27	737945.93	2749.89	INV @ SSMH CL BARREL
20002	26808513.96	737894.34	2761.56	TBC @ DI
20003	26808493.21	737894.36	2761.54	TBC @ DI
50000	26808038.58	737850.07	2753.04	TOP 24" RCP @ CONNECTION
50001	26808058.54	737849.78	2754.94	TOP 24" RCP OUT
50002	26808109.40	737897.04	2753.08	INV 29"x45" HERCP OUT
50003	26808107.34	737903.02	2752.21	INV 29"x45" HERCP @ CONNECTION
50004	26808501.14	737906.41	2752.98	INV 18" CMP @ CONNECTION

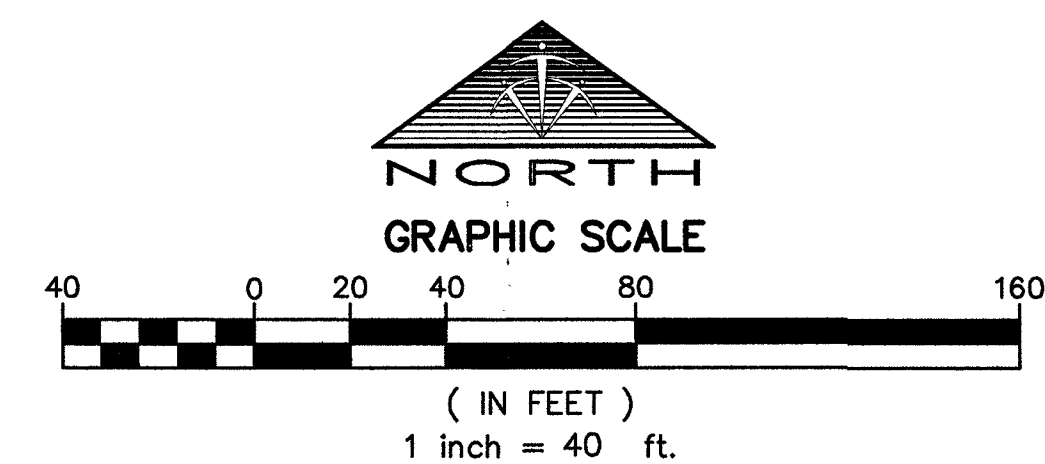

	EXISTING RIGHT OF WAY
	ASSESSORS PARCEL LINE / LOT LINE
	STORM DRAIN PIPE
	EXISTING STORM DRAIN PIPE
	LOT NUMBER
	AS-BUILT POINT NUMBER
	EXISTING STORM DRAIN MANHOLE
	EXISTING STORM DRAIN DROP INLET
	STORM DRAIN DROP INLET
	REINFORCED CONCRETE PIPE
	CORRUGATED METAL PIPE
	HORIZONTAL ELLIPTICAL REINFORCED CONCRETE PIPE

HORIZONTAL DATUM SHOWN HEREON IS BASED UPON NORTH AMERICAN DATUM OF 1983 (NAD 83 (2011) EPOCH 2010.00 REALIZATION), NEVADA STATE PLANE COORDINATE SYSTEM EAST ZONE (2701).

CITY OF LAS VEGAS BENCHMARK: 6LV90 18S4

RIVET AND PLATE IN TOP OF CURB, NORTHEAST CORNER OF GRAND CANYON DRIVE AND ELKHORN AVENUE.

ELEVATION: 2756.91 (U.S. SURVEY FEET)
815.556 (METERS)

BASED UPON NORTH AMERICAN VERTICAL DATUM OF 1988 (NAVD '88), CITY OF LAS VEGAS
2008 ADJUSTMENT

1. THE PURPOSE OF THIS SURVEY IS TO PROVIDE AS-BUILT INFORMATION FOR THE STORM DRAIN FACILITIES SHOWN ON THE IMPROVEMENT PLANS FOR "ELKHORN AND GRAND CANYON", AS SHOWN IN BOOK 155, PAGE 37 OF PLATS, SITUATE IN THE SOUTHWEST QUARTER (SW 1/4) OF SECTION 18, TOWNSHIP 19 SOUTH, RANGE 60 EAST, M.D.M., CITY OF LAS VEGAS, CLARK COUNTY, NEVADA, AND THE SURVEY WAS COMPLETED ON SEPTEMBER 7, 2018.

THE POSITIONAL CERTAINTY OF THE AS-BUILT INFORMATION SHOWN HEREON IS WITHIN
+/- 0.3' HORIZONTALLY AND VERTICALLY.

TRI-CORE SURVEYING ASSUMES NO RESPONSIBILITY FOR EXISTING UTILITIES SHOWN OR NOT SHOWN. THE UTILITIES SHOWN ON THIS DRAWING HAVE BEEN PLOTTED FOR THE CONVENIENCE ONLY. IT IS THE CONTRACTOR'S RESPONSIBILITY TO FIELD VERIFY BOTH THE HORIZONTAL AND VERTICAL LOCATION OF ALL RELEVANT UTILITIES PRIOR TO COMMENCEMENT OF CONSTRUCTION. IF A CONFLICT OR DISCREPANCY IS DISCOVERED, THE CONTRACTOR SHALL NOTIFY TRI-CORE SURVEYING IN WRITING IMMEDIATELY.