
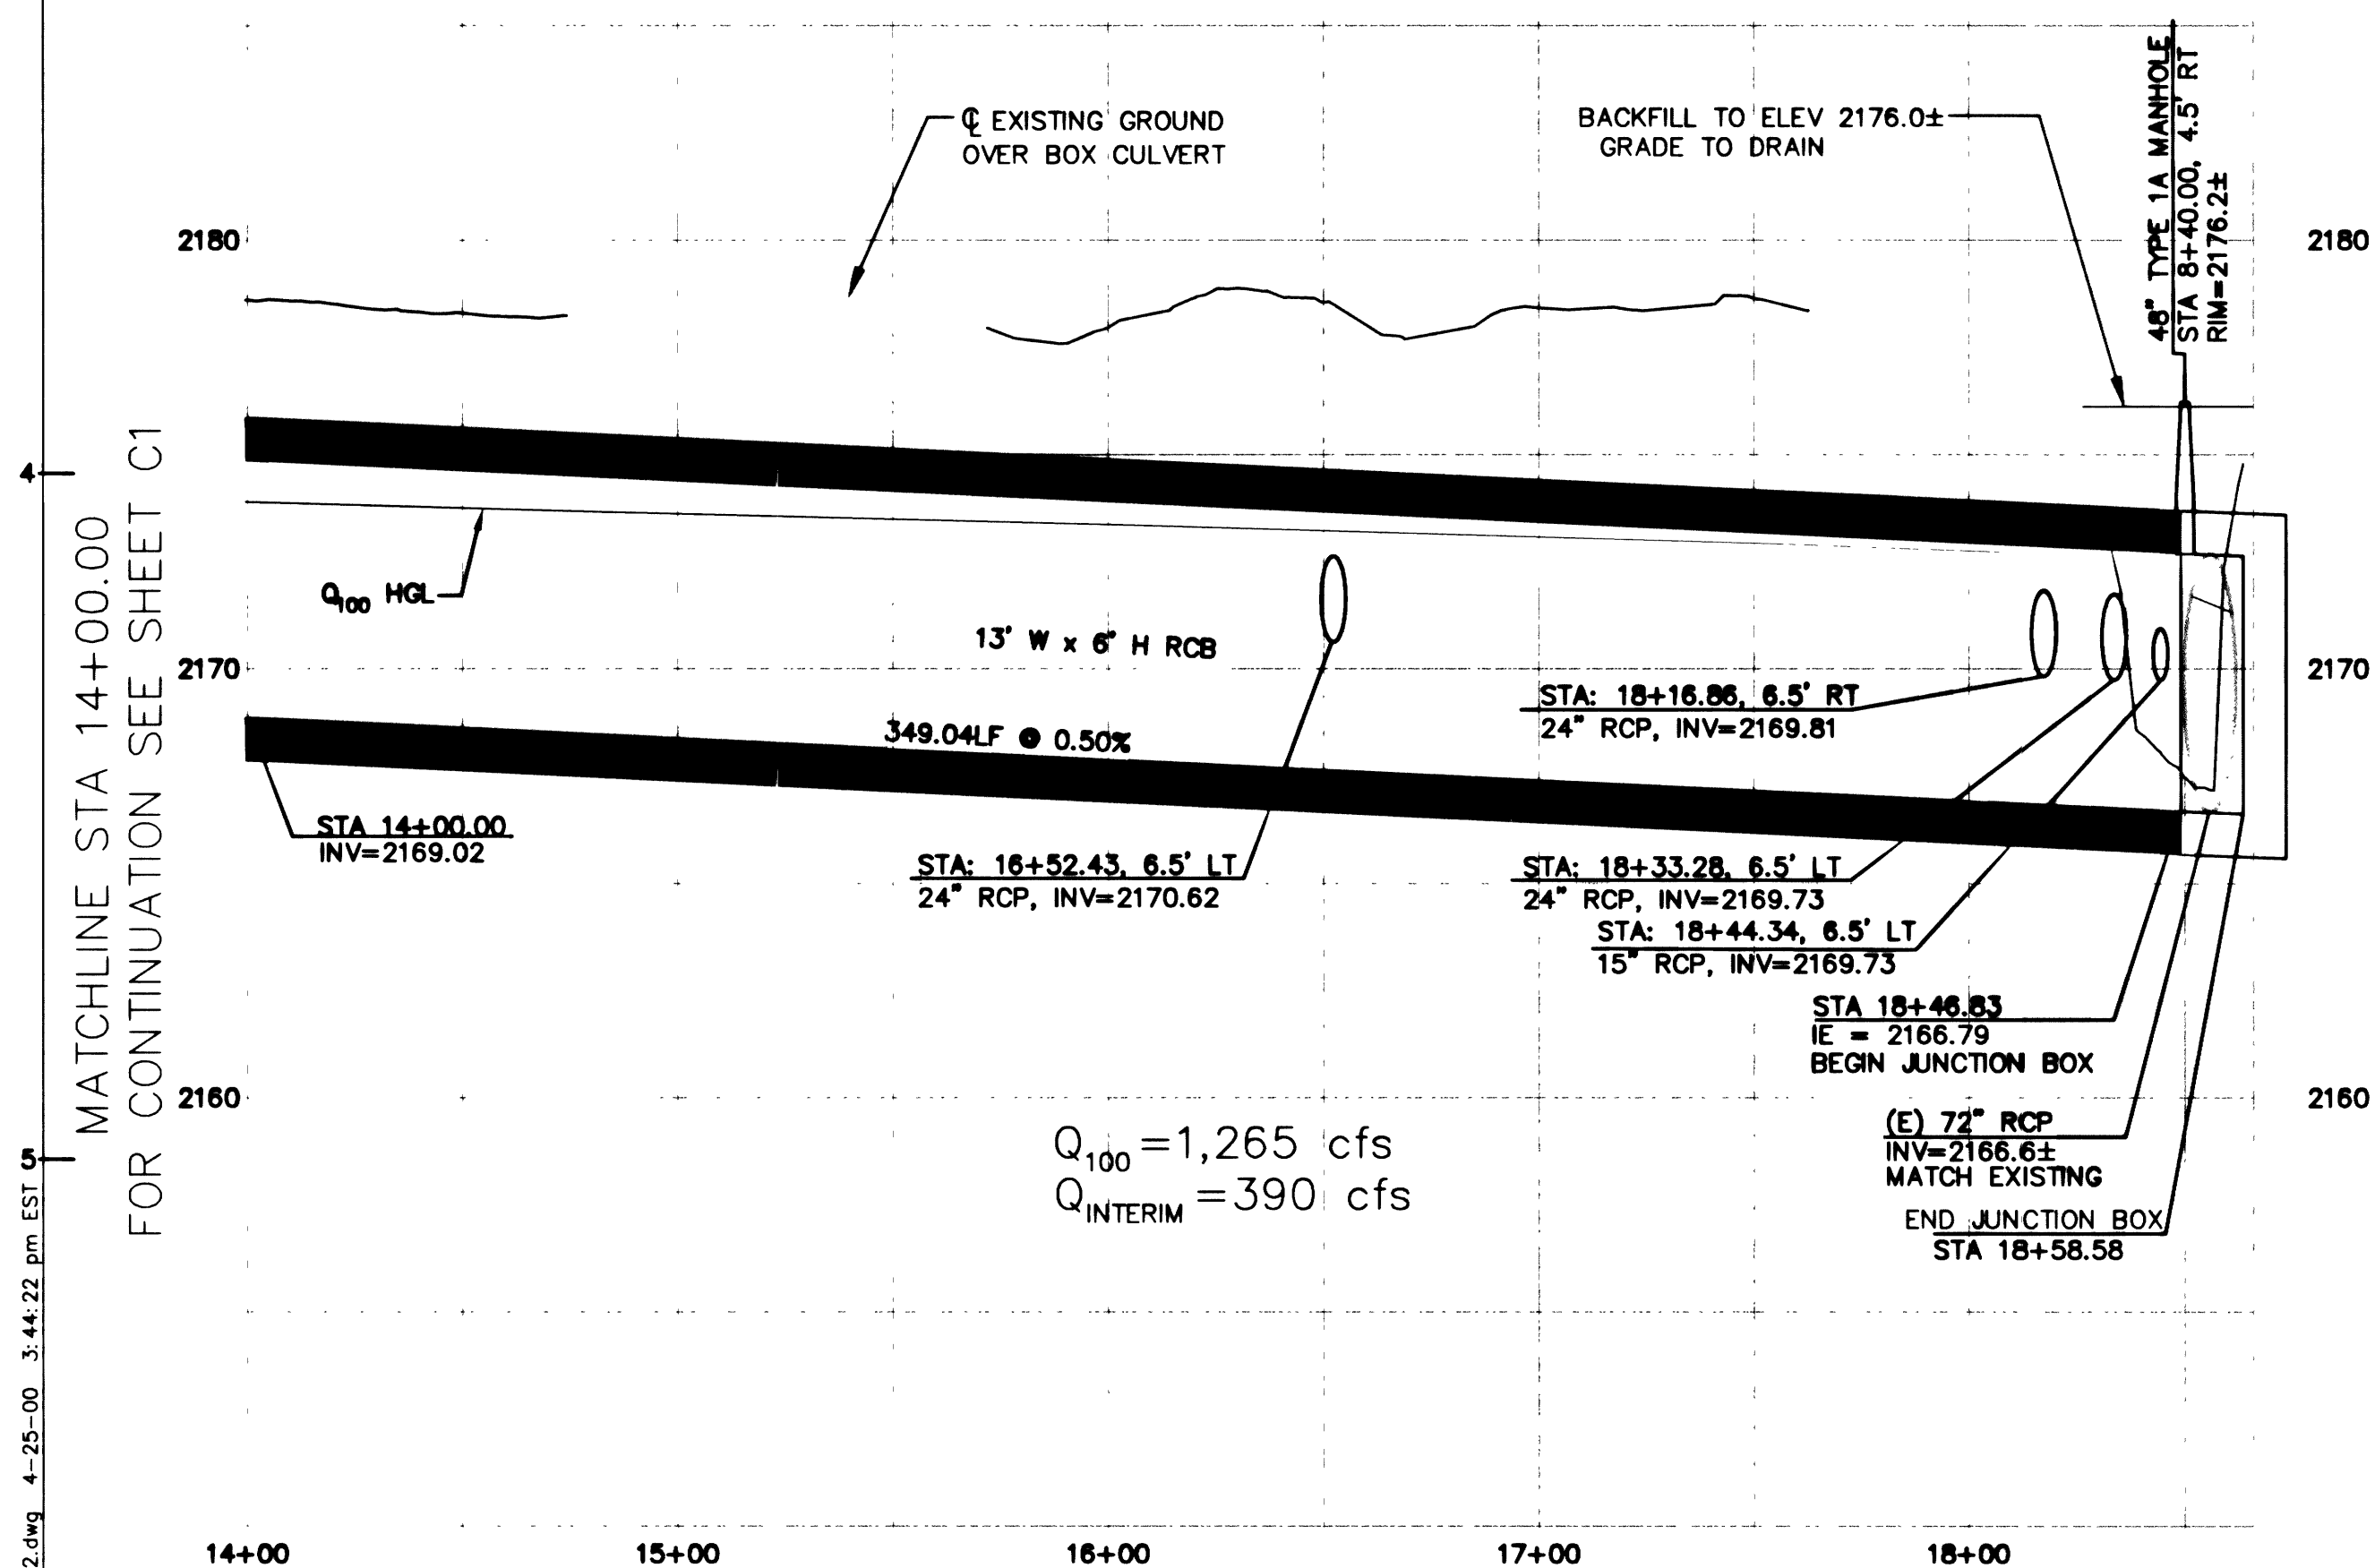


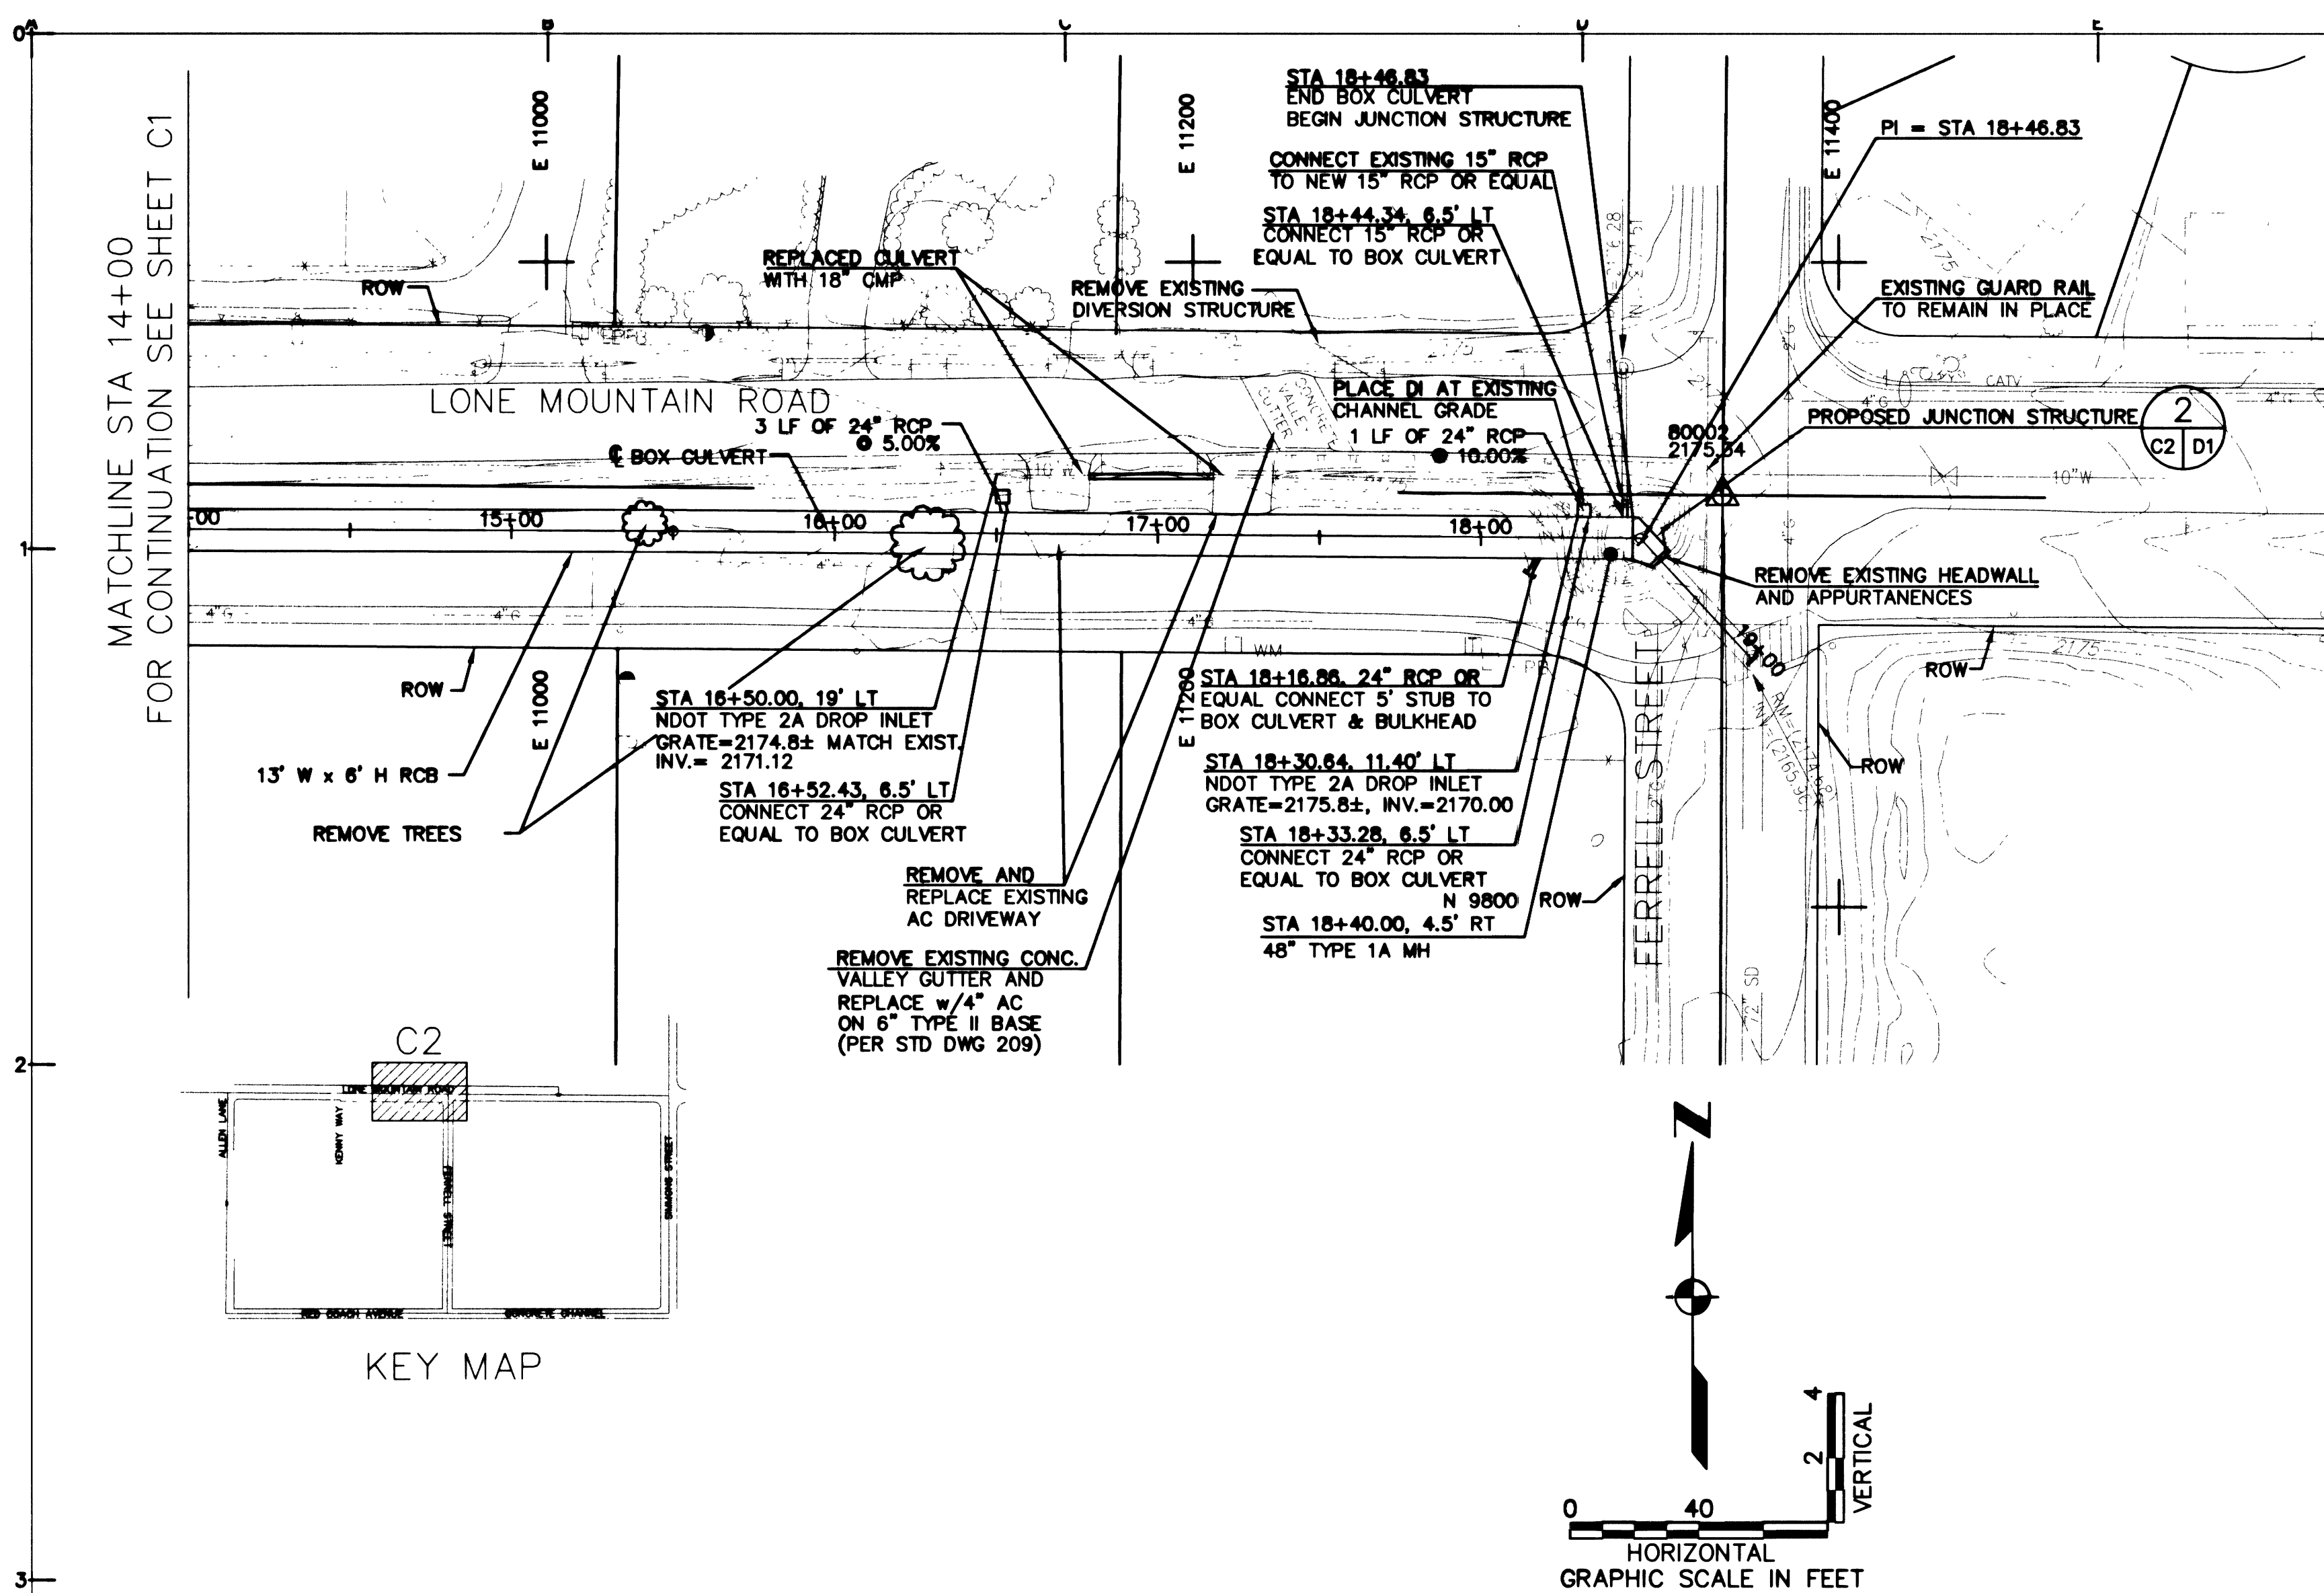

STRIPING AND SIGNAGE NOTE:

ALL EXISTING STRIPING AND TRAFFIC SIGNS REMOVED OR DAMAGED DURING CONSTRUCTION SHALL BE REPLACED PER THE STANDARD DRAWINGS.

BASIS OF BEARING:
SOUTH 89°33'41" EAST, BEING THE SOUTH LINE OF THE SOUTHEAST QUARTER OF SECTION 32, T. 19 S., R.62 E., M.D.M., CITY OF NORTH LAS VEGAS, ALSO BEING THE BOUNDARY LINE OF LONE MOUNTAIN ROAD AS SHOWN ON THE PLAT OF TIERRA DE LAS PALMAS VILLAGE 1-UNIT 1, IN BOOK 78 OF PLATS, PAGE 47 IN THE CLARK COUNTY RECORDERS OFFICE.

BENCHMARKS:
CITY OF NORTH LAS VEGAS BENCHMARK NO. NLV015C4 BEING A RIVET AND 2" ROUND ALUMINUM DISK STAMPED NORTH LAS VEGAS BM NO. NLV015C4, IN THE TOP OF CURB AT THE NORTHWEST CORNER OF THE INTERSECTION OF CRAIG ROAD AND SIMMONS STREET. ELEVATION 656.983 METERS (2155.45 FT.).

AS-BUILT DRAWING
 PROGRAMMER DESIGN GROUP
 NAME DAVID S. AUSTIN
 SIGNATURE [Signature] DATE 7/04/01

AVOID CUTTING UNDERGROUND UTILITY LINES. IT'S COSTLY.

**Call
before you
Dig.**

1-800-227-26

UNDERGROUND SERVICE ALERT (USA)

AVOID OVERHEAD POWER LINE
CONTACT. IT'S COSTLY.


 **Call** 

before you
OVERHEAD

1-702-593-61

NEVADA POWER ENVIRONMENT &
SAFETY. WORKER'S PERMITS

Kennedy/Jenks Consultants
840 Grier Drive, Suite 300
Las Vegas, NV 89119
Phone 702-270-3610, Fax 702-270-3611

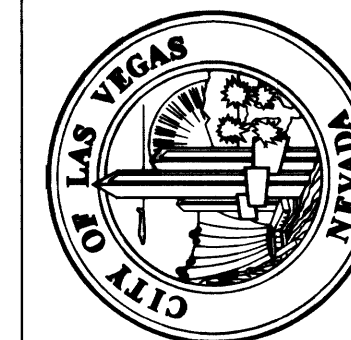

GOWAN OUTFALL
LONE MOUNTAIN BRANCH

DWG. NO.	9901-C2
JOB NO.	997401.00
DATE	30 APRIL 2000
SHEET	0 OF 8 C-2

USE OF DOCUMENTS

[illegible]

--	--	--	--	--	--	--

—BUILT DRAWING

[illegible]

DESIGN	CONSULTANTS	DRAWN	CHECKED
	270-3611		

Lenks Consulting
 3000 Las Vegas Drive, Suite 300
 Las Vegas, NV 89119
 702-361-0360, Fax 702-361-0361

Kennedy/J
840 Grick
Las V
Phone 702-270

NCH	O STA 18+63.5
-----	---------------

DOWN OUTFALL
MOUNTAIN BRA
- STA 14+00 T

**GO
LONE M**

	PLAN
DWG. NO.	9901-C2

JOB NO.	98740100
DATE	30 APRIL 2000
SHEET	8 OF 8 C-2

1 AS-BUILT DWG. 07.09.01
DRAWING NO.: 107-V3153