


MONUMENTATION TIE MAP FOR FOXFIRE RANCH PHASE 3 UNIT 4

SURVEYOR'S CERTIFICATE

I, J EDWARD LEAVITT, A PROFESSIONAL LAND SURVEYOR IN THE STATE OF NEVADA,
DO HEREBY CERTIFY THAT THE MONUMENTS HAVE BEEN SET AND THE TIE DISTANCES
WERE ESTABLISHED AS SHOWN HEREON.

THIS SURVEY WAS COMPLETED ON OCTOBER 9, 1998

J EDWARD LEAVITT, PLS 5878

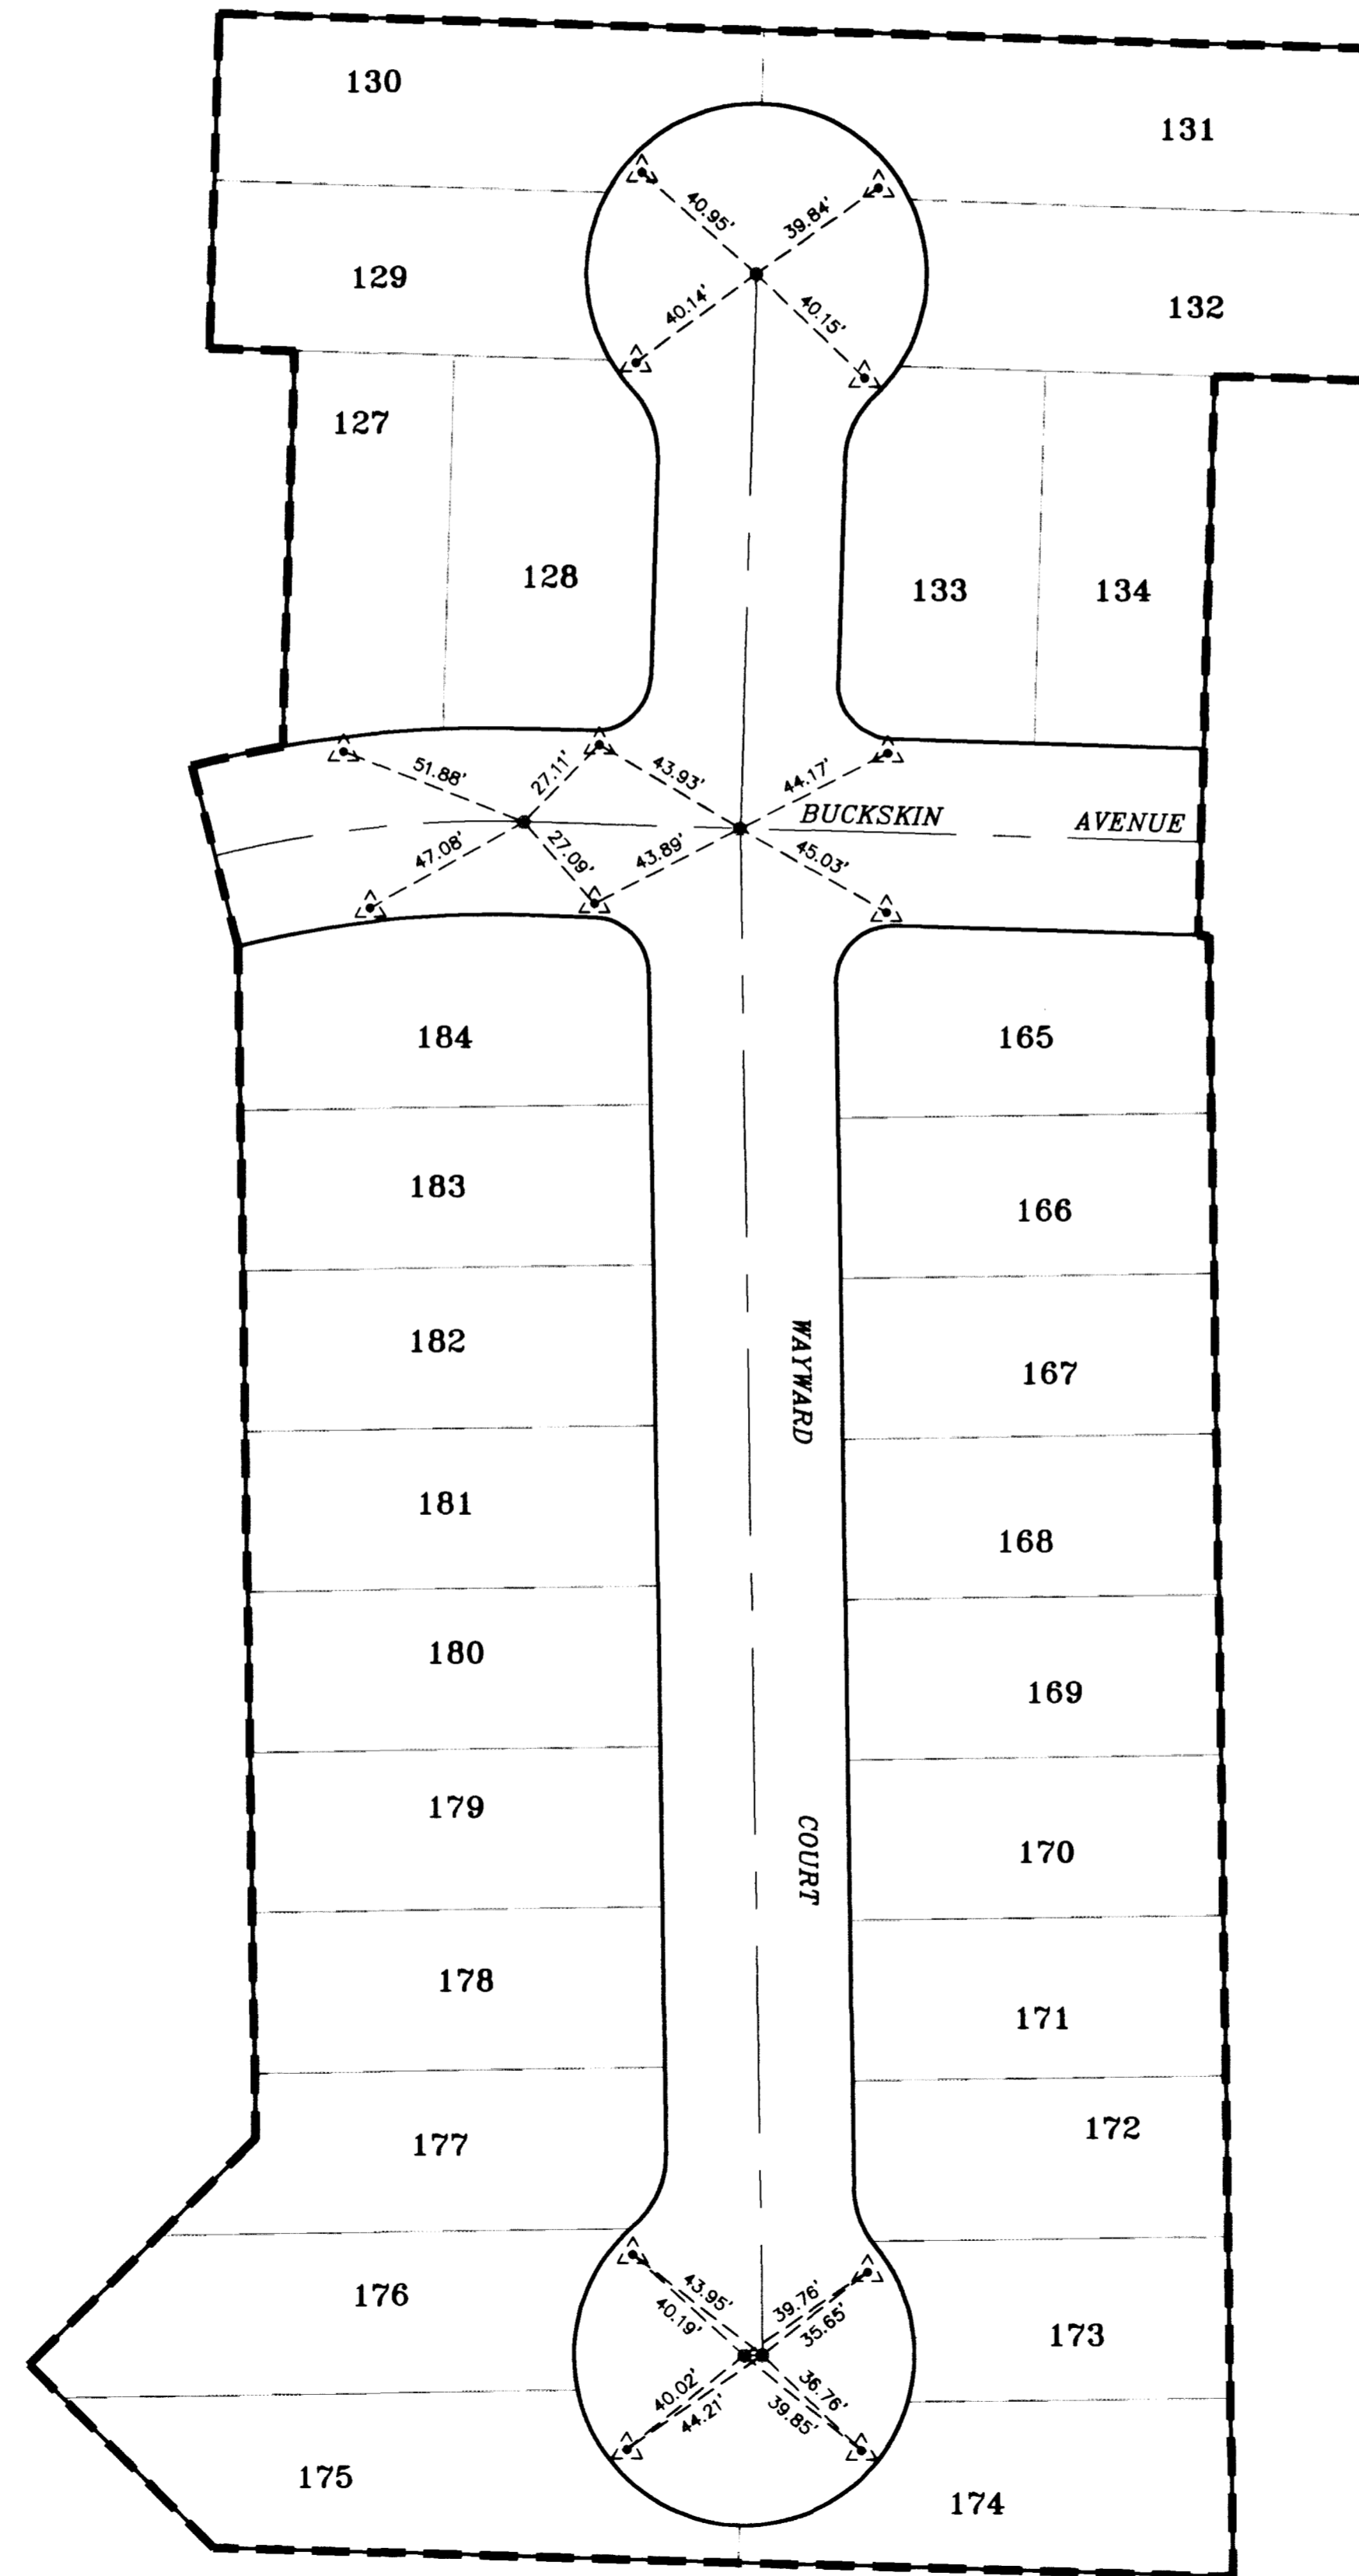

LEGEND

•	SET 5/8" REBAR W/ ALUM. CAP & TIES PLS 5878
●	FOUND MONUMENT AS INDICATED
———	OVERALL PARCEL BOUNDARY LINE
———	INTERIOR PROPERTY OR RIGHT-OF-WAY LINE
———	STREET CENTERLINE
▲	REFERENCE MONUMENT STAMPED "PLS 5878" WITH DISTANCE

SHEET	10/09/98	DRAWN BY:		
DESIGNED BY:		CHECKED BY:		
PROJECT NO:	507621	SCALE:	1"=40'	
SHEET	1	DRAWING NO.	058-4288-4	
OF 1 SHEETS				
REV	DATE	BY		
PULTE HOMES CORP.		ALPHA &		REVISION
1635 VILLAGE CENTER CIR LAS VEGAS, NV (702) 238-7900		ENGINEERING COMPANY 50 So. Jones #207, Las Vegas, NV 89107 Telephone: (702) 877-1300		
MONUMENTATION TIE MAP		FOXFIRE RANCH PHASE 3 UNIT 4		

