



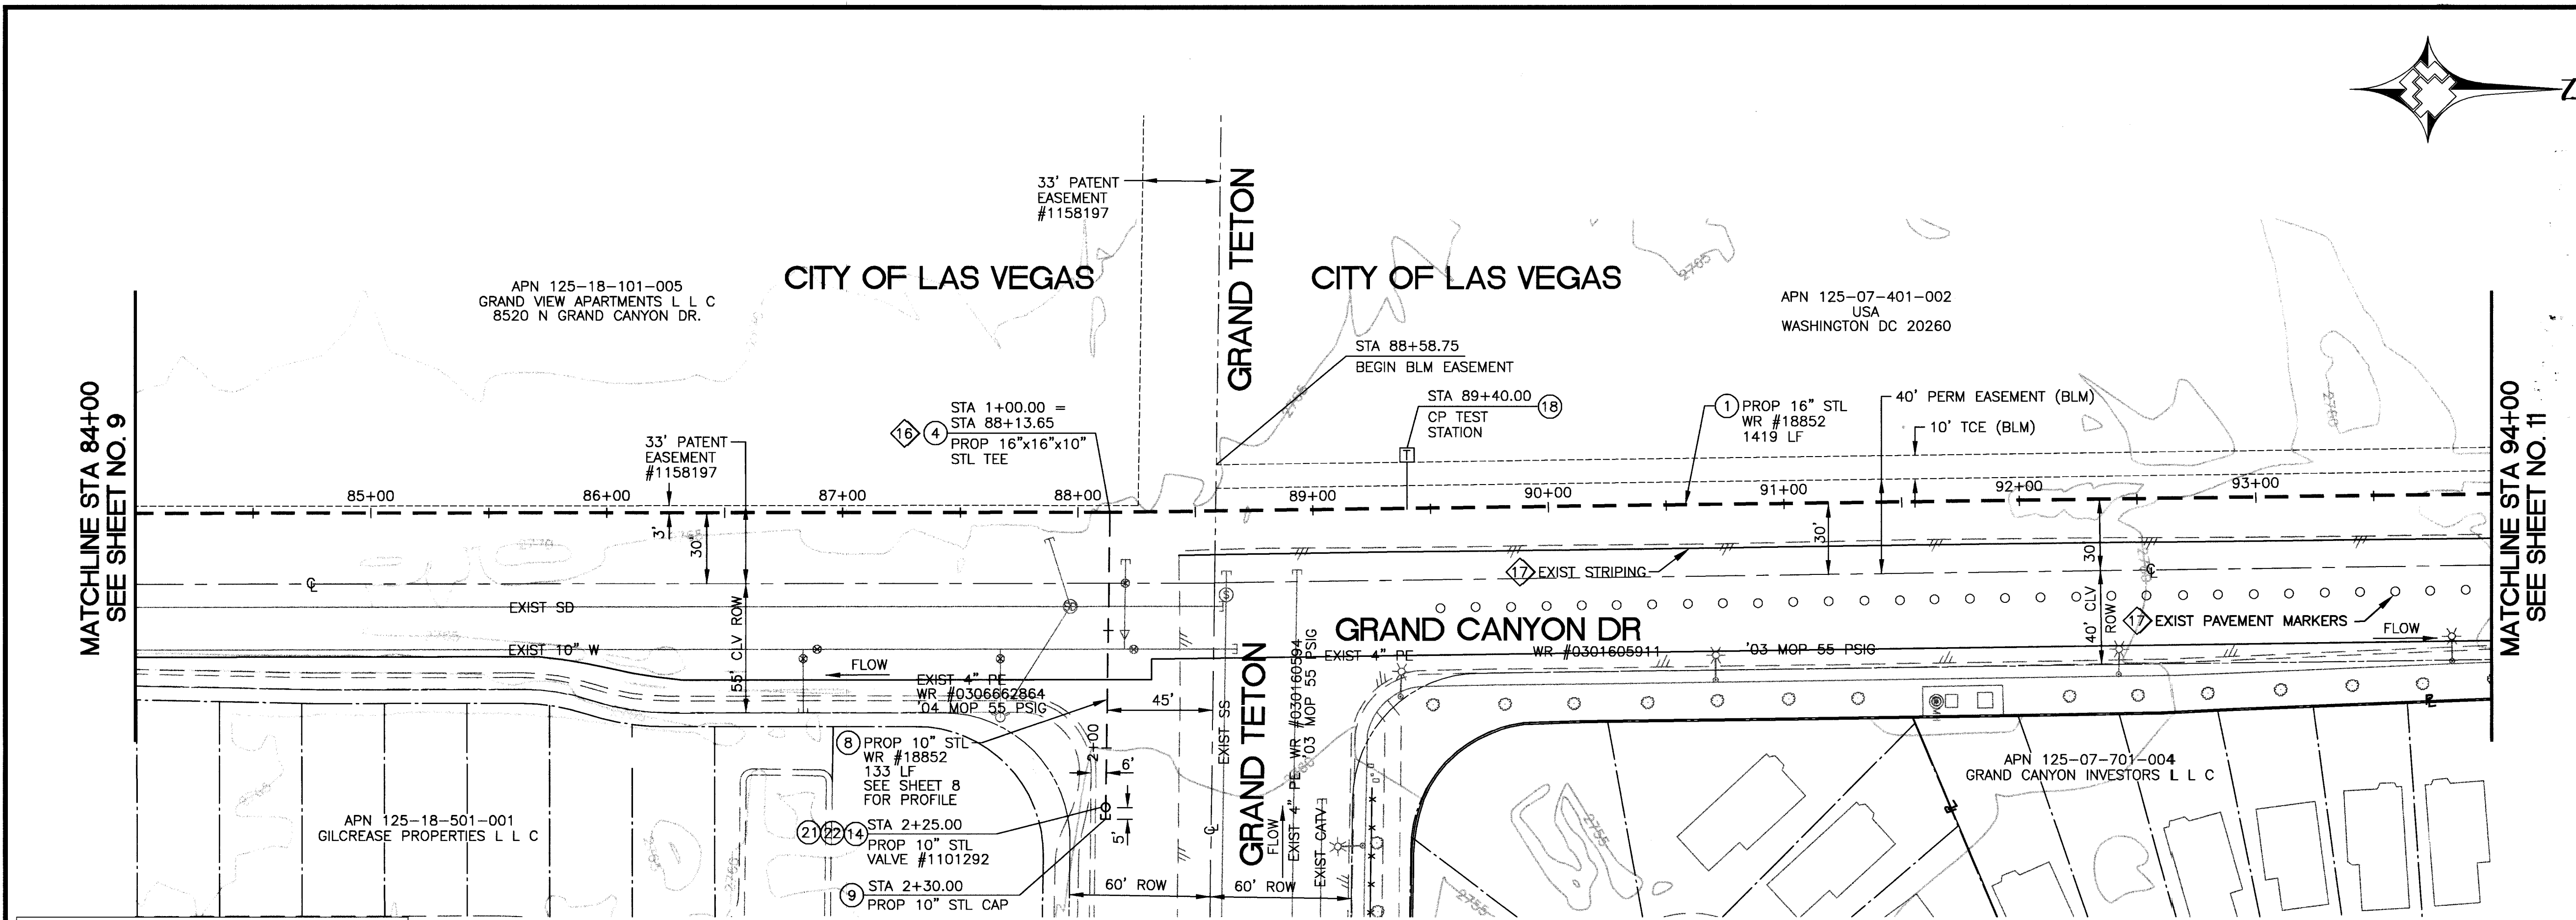

PIPELINE SHALL BE INSTALLED USING FIELD BENDS. NO FITTINGS SHALL BE INSTALLED EXCEPT WHERE NOTED ON PLANS.

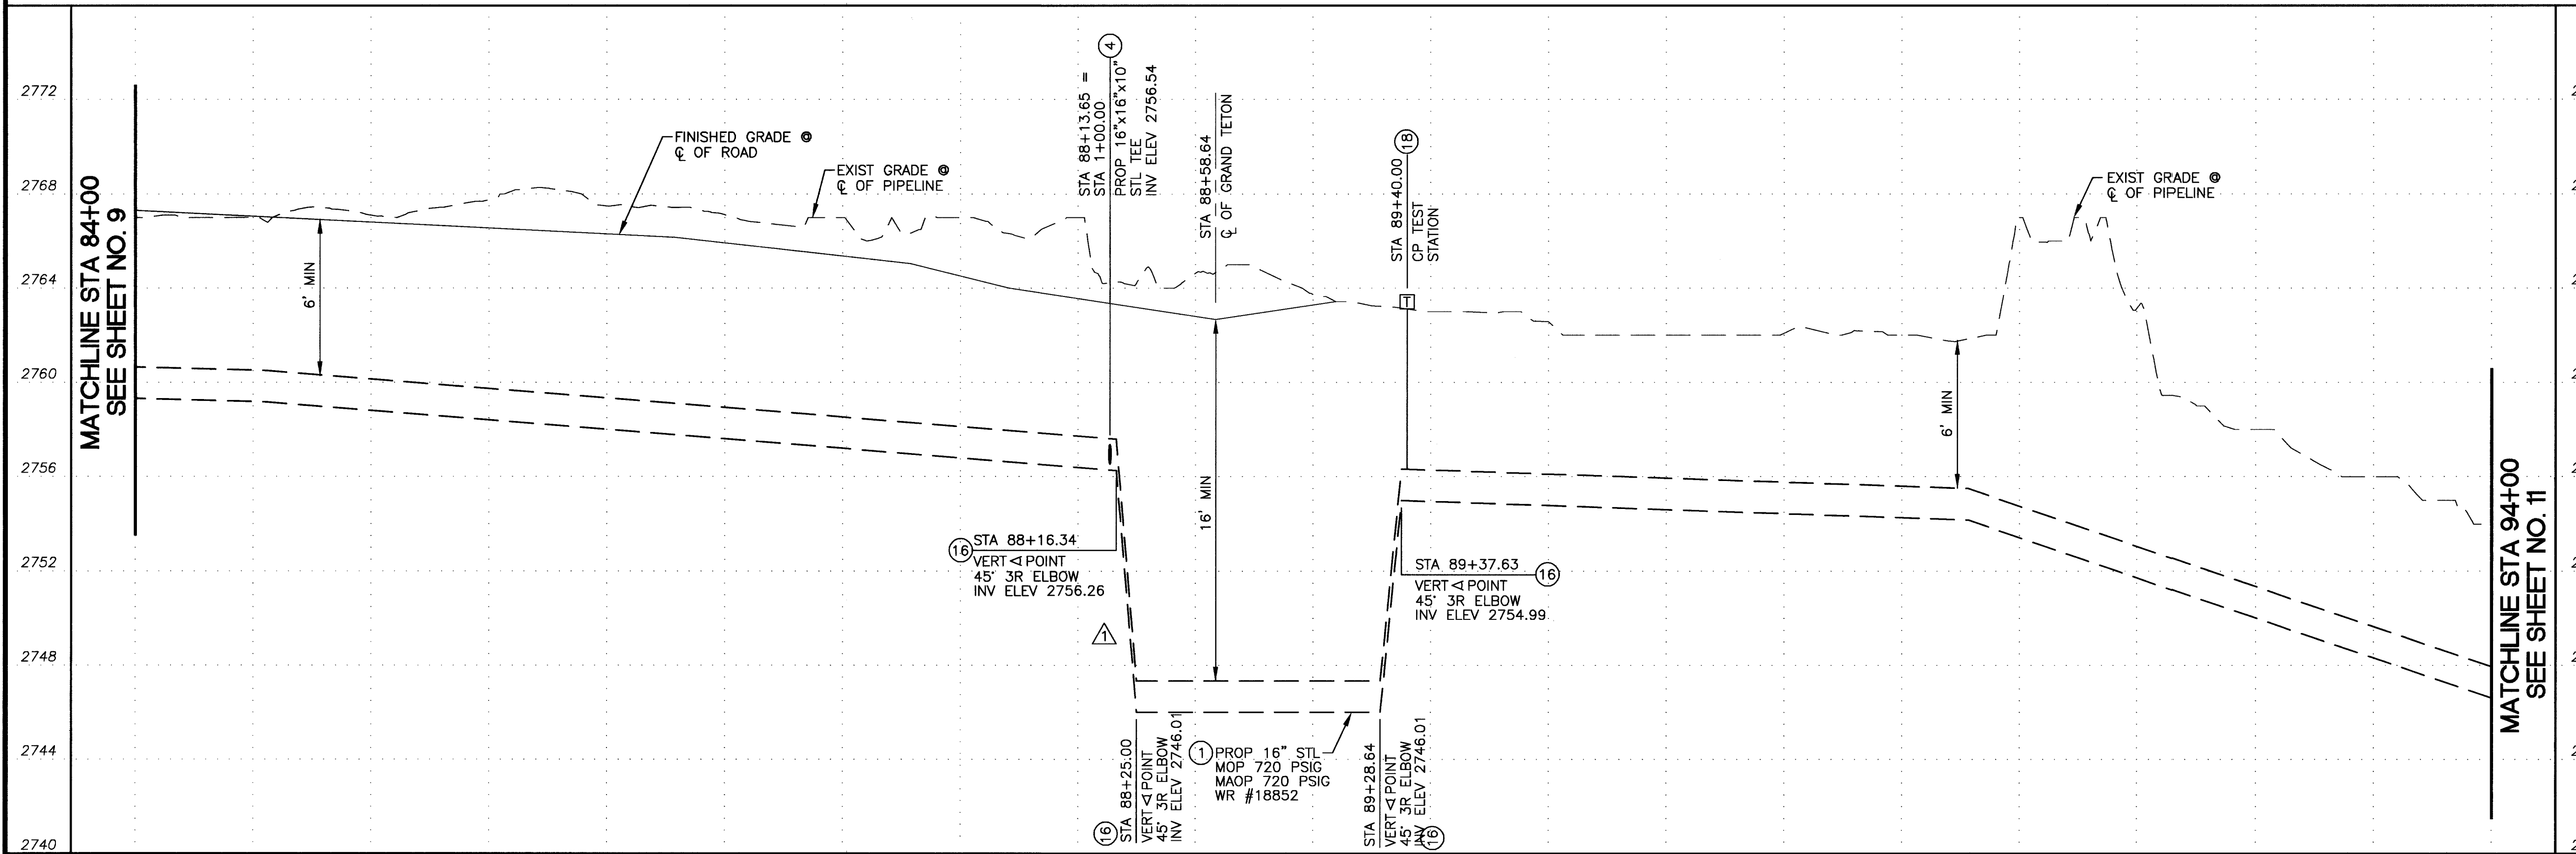

 SOUTHWEST GAS CORPORATION 71133	85+00		86+00		87+00		88+00		89+00		90+00		91+00		92+00		93+00									
	WR #18852		WR #18854		AS-BUILT DRAWING-PRESSURE TEST DATA														REVISED 10" DEPTH TO 6' & REVISED DROP SECTION LOCATION NORTH OF GRAND TETON NO. DESCRIPTION BY DATE APPROV. 7/07/04		INSPECTOR _____		SUPPLY ISOLATION AREA SUP-51		W.R. No. 18854	
					PIPE DIA. _____ TEST MEDIUM _____ TEST METHOD _____ PIPE LENGTH _____ ☐ AIR ☐ GAUGE _____ PIPE TYPE _____ ☐ NITROGEN ☐ CHART _____ ☐ WATER ☐ SOAP _____ MIN. DURATION _____ START _____ END _____														FOREMAN _____		31		X579 Y558, X579 Y560			
																							X579 Y562, X579 Y564			
																							X579 Y566			