


T,R,S: 2061-34
 APN: 13934111059

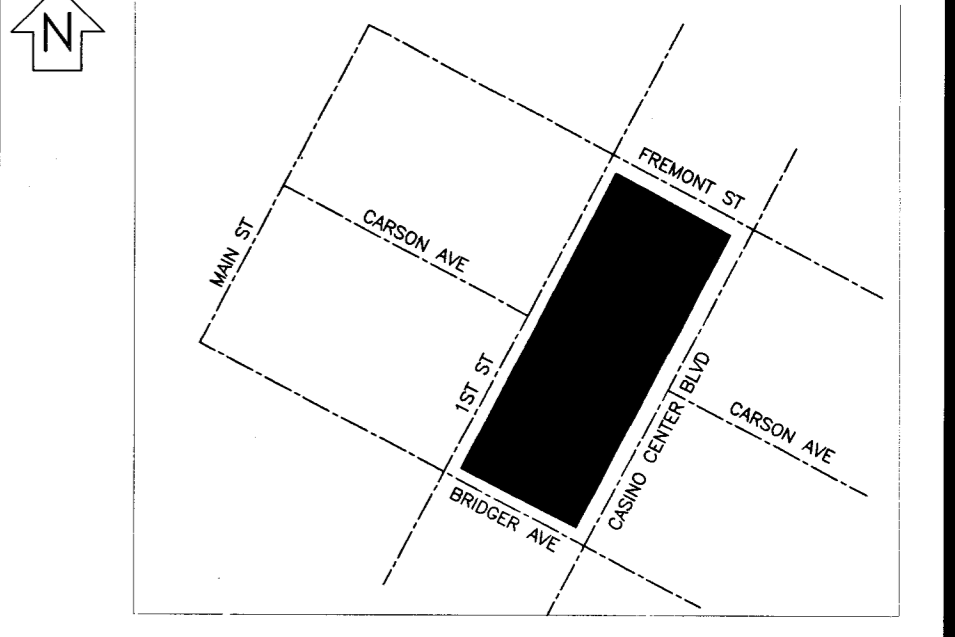

VICINITY MAP
(NOT TO SCALE)

EVERY EFFORT HAS BEEN MADE TO IDENTIFY ALL NPC FACILITIES. THE CUSTOMER SHALL CONFIRM THE EXISTENCE AND LOCATION OF THESE FACILITIES.

AVOID HITTING OVERHEAD POWER LINES. IT'S COSTLY.
 CALL BEFORE YOU DO OVERHEAD

AVOID CUTTING UNDERGROUND UTILITY LINES. IT'S COSTLY.
 Call before you Dig.

CALL 1-702-227-2929
 1-800-227-2600
 UNDERGROUND SERVICE (USA)

REVISIONS

NO.	DESCRIPTION	DATE	G.A.
1	ADD MANHOLES FOR BENDS AND ACCESS OUTSIDE OF VALET PARKING AREA, IN: NEW CIR. IN EX. MTS, BY DT	11/17/2006	
2	RECONFIGURE CUST SWITCHROOM, ADD MH TO REROUTE CONDUITS OUT OF MH-3 PER CUST REQUEST SEE DETAIL ON SHEET 10, BY DT	02/12/2007	
3	IN: RISER ON POLE P-30522 ON BRIDGER. RECONFIGURE PRI. WIRES AND POLES IN ALLEY OFF CARSON NORTH & EAST, BY DT	03/09/2007	
4	ADD CAP BANK TO FC-2655 PER PLANNING, BY DT	04/06/2007	
5	ADD POLE NUMBERS AND RISER DETAILS	05/11/2007	

TYPE OF EASEMENT:

<input type="checkbox"/>	AERIAL STANDARD	<input type="checkbox"/>	JPA NOTES:
<input type="checkbox"/>	UNDERGROUND	<input type="checkbox"/>	SPRINT CONTACT: LEN BELLOWS
<input type="checkbox"/>	AS BUILT UNDERGROUND	<input type="checkbox"/>	PHONE NUMBER: 244-7839
<input type="checkbox"/>	R.O.E./R/W-5-COM	<input type="checkbox"/>	DATE OF CONTACT: 03/23/2006
<input type="checkbox"/>	3rd PARTY	<input type="checkbox"/>	NPC TO SET NEW POLES
<input type="checkbox"/>	UNDERGROUND BY EXHIBIT	<input type="checkbox"/>	NPC TO STAKE NEW POLES
<input type="checkbox"/>	(N-DOT) PERMIT	<input type="checkbox"/>	NPC TO PROVIDE 6 POLES
<input type="checkbox"/>	(BLM) PERMIT	<input type="checkbox"/>	4 - 60 FT. CLASS H1
<input type="checkbox"/>	RAILROAD-UPRR-PERMIT	<input type="checkbox"/>	2 - 55 FT. CLASS STEEL
<input type="checkbox"/>	SO. NEVADA WATER PERMIT	<input type="checkbox"/>	1 - 40 FT. CLASS
<input type="checkbox"/>	NOT REQUIRED	<input type="checkbox"/>	NPC TO DIG POLE HOLES
<input type="checkbox"/>	Misc. Info.	<input type="checkbox"/>	NPC TO REMOVE EX. POLES
		<input type="checkbox"/>	REM: 11 POLES IN: 12 RISERS
		<input type="checkbox"/>	JPA#: P200600118

NPC INFORMATION:
 COORDINATOR: PATRICIA BROWN
 PHONE: 657-4337
 DESIGNER: DARRYL THOMAS
 DCA:
 INSPECTOR: 378-3725
 SCHEDULING: 657-4117, 657-4116, 657-4118

DISTRICT: LAS VEGAS

CUSTOMER INFORMATION:
 APPLICANT: GOLDEN NUGGET
 ENGINEER:
 CONTACT: RICH RIAL
 APPROVAL DATE:

GOVERNMENT INFORMATION:
 AGENCY: CITY OF LAS VEGAS
 APPROVAL DATE: 11/15/2006

NEVADA POWER COMPANY

GOLDEN NUGGET EXPANSION

AS BUILT EXISTING
 107N4611-2-NPC

PROJ. ID: 180976 SCALE: 1" = 40'
 SHEET #: 2 OF 10 DATE: 03/08/2006

105091

SEE MATCHLINE A
 SHEET 3 OF 9

LEGEND

	LE 407
	MA 401
	SH 1206
	SH 1212/GA 1202
	GA 1205
	GA 1201
	LE 402

PURPOSE OF PROJECT:
 REM. EXISTING FACILITIES FOR
 NEW CONSTRUCTION, ROUTE
 PRI. FEED

**CITY OF LAS VEGAS
 PERMIT REQUIRED***

CONTACT CLV LAND DEVELOPMENT (229-6371)
 CLV CONSTRUCTION SERVICES MUST BE
 NOTIFIED 24 HOURS PRIOR TO COMMENCING
 CONSTRUCTION (229-6337)

*NPC INSPECTOR MUST BE NOTIFIED BY
 FAX 48 HOURS PRIOR TO COMMENCING
 CONSTRUCTION & WILL VERIFY CITY PERMIT
 FOR WORK DONE IN STREETS OR SIDEWALK.
 FAX PERMIT TO:
 LAS VEGAS NORTH (HENDERSON): 558-4354
 LAS VEGAS SOUTH (HENDERSON): 558-4740
 LAS VEGAS SOUTH (SPRING VALLEY): 252-4828

CIVIL LINETYPE LEGEND

	PROPOSED	EXISTING
CENTERLINE		
PROPERTY LINE/ROW		
CURB		
EDGE OF PAVEMENT		
EDGE OF SIDEWALK		
SEWER LINE		
WATER LINE		
GAS LINE		
TELEPHONE LINE		
CABLE TV LINE		
STORM DRAIN LINE		
FIRE HYDRANT		
STREET LIGHT		
STREET LIGHT SERVICE		

* LINTYPES UTILIZED WHERE CONFLICT OCCURS WITH NPC FACILITIES.