
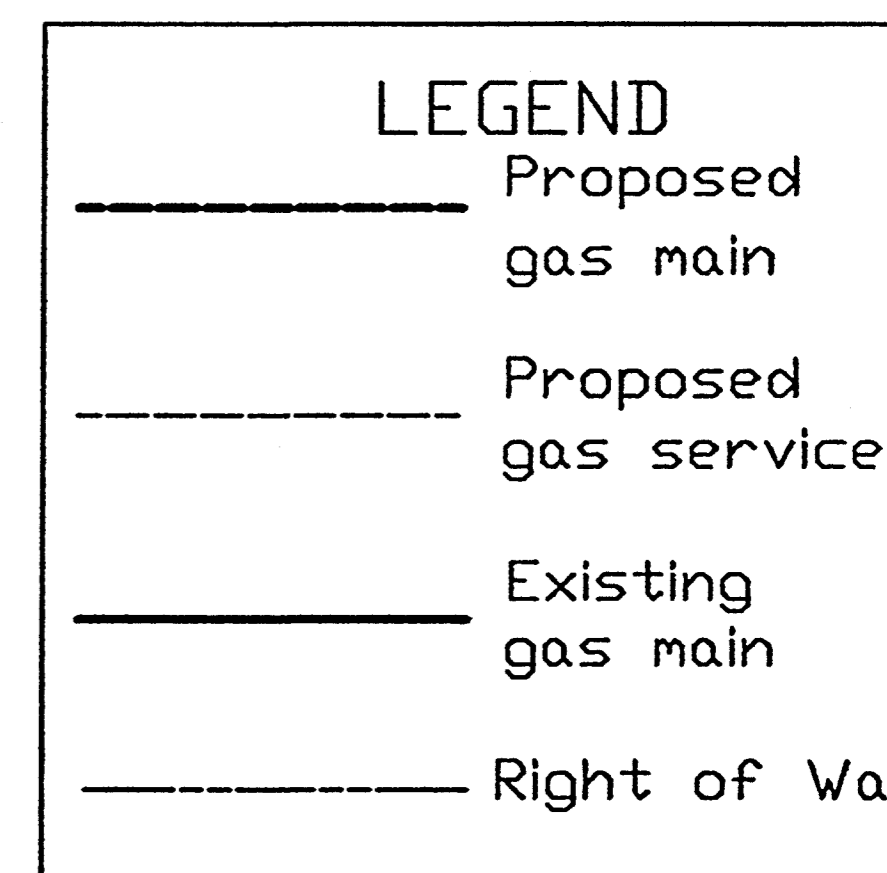
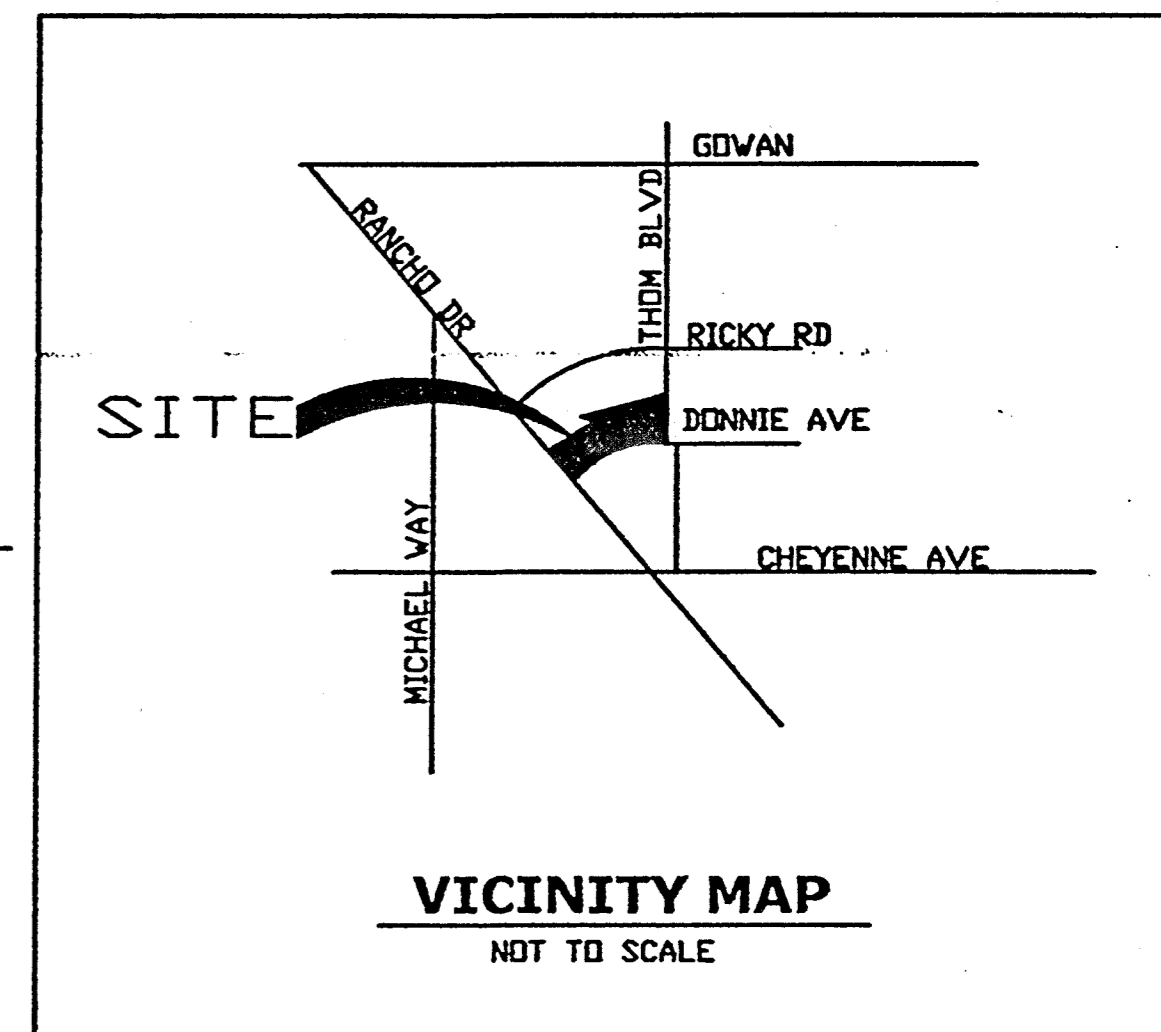
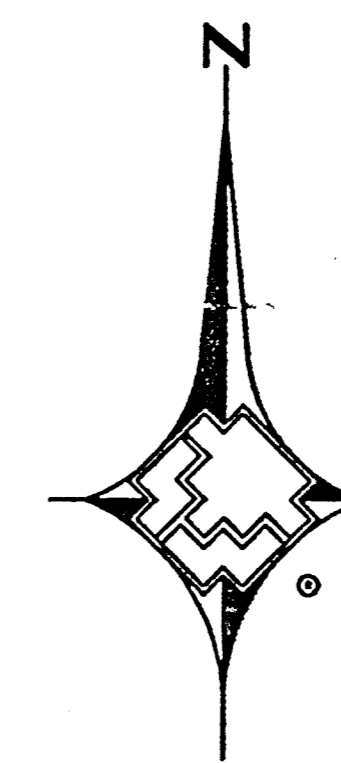


CLV TRENCH DETAIL
FOR UNIMPROVED AREAS ONLY

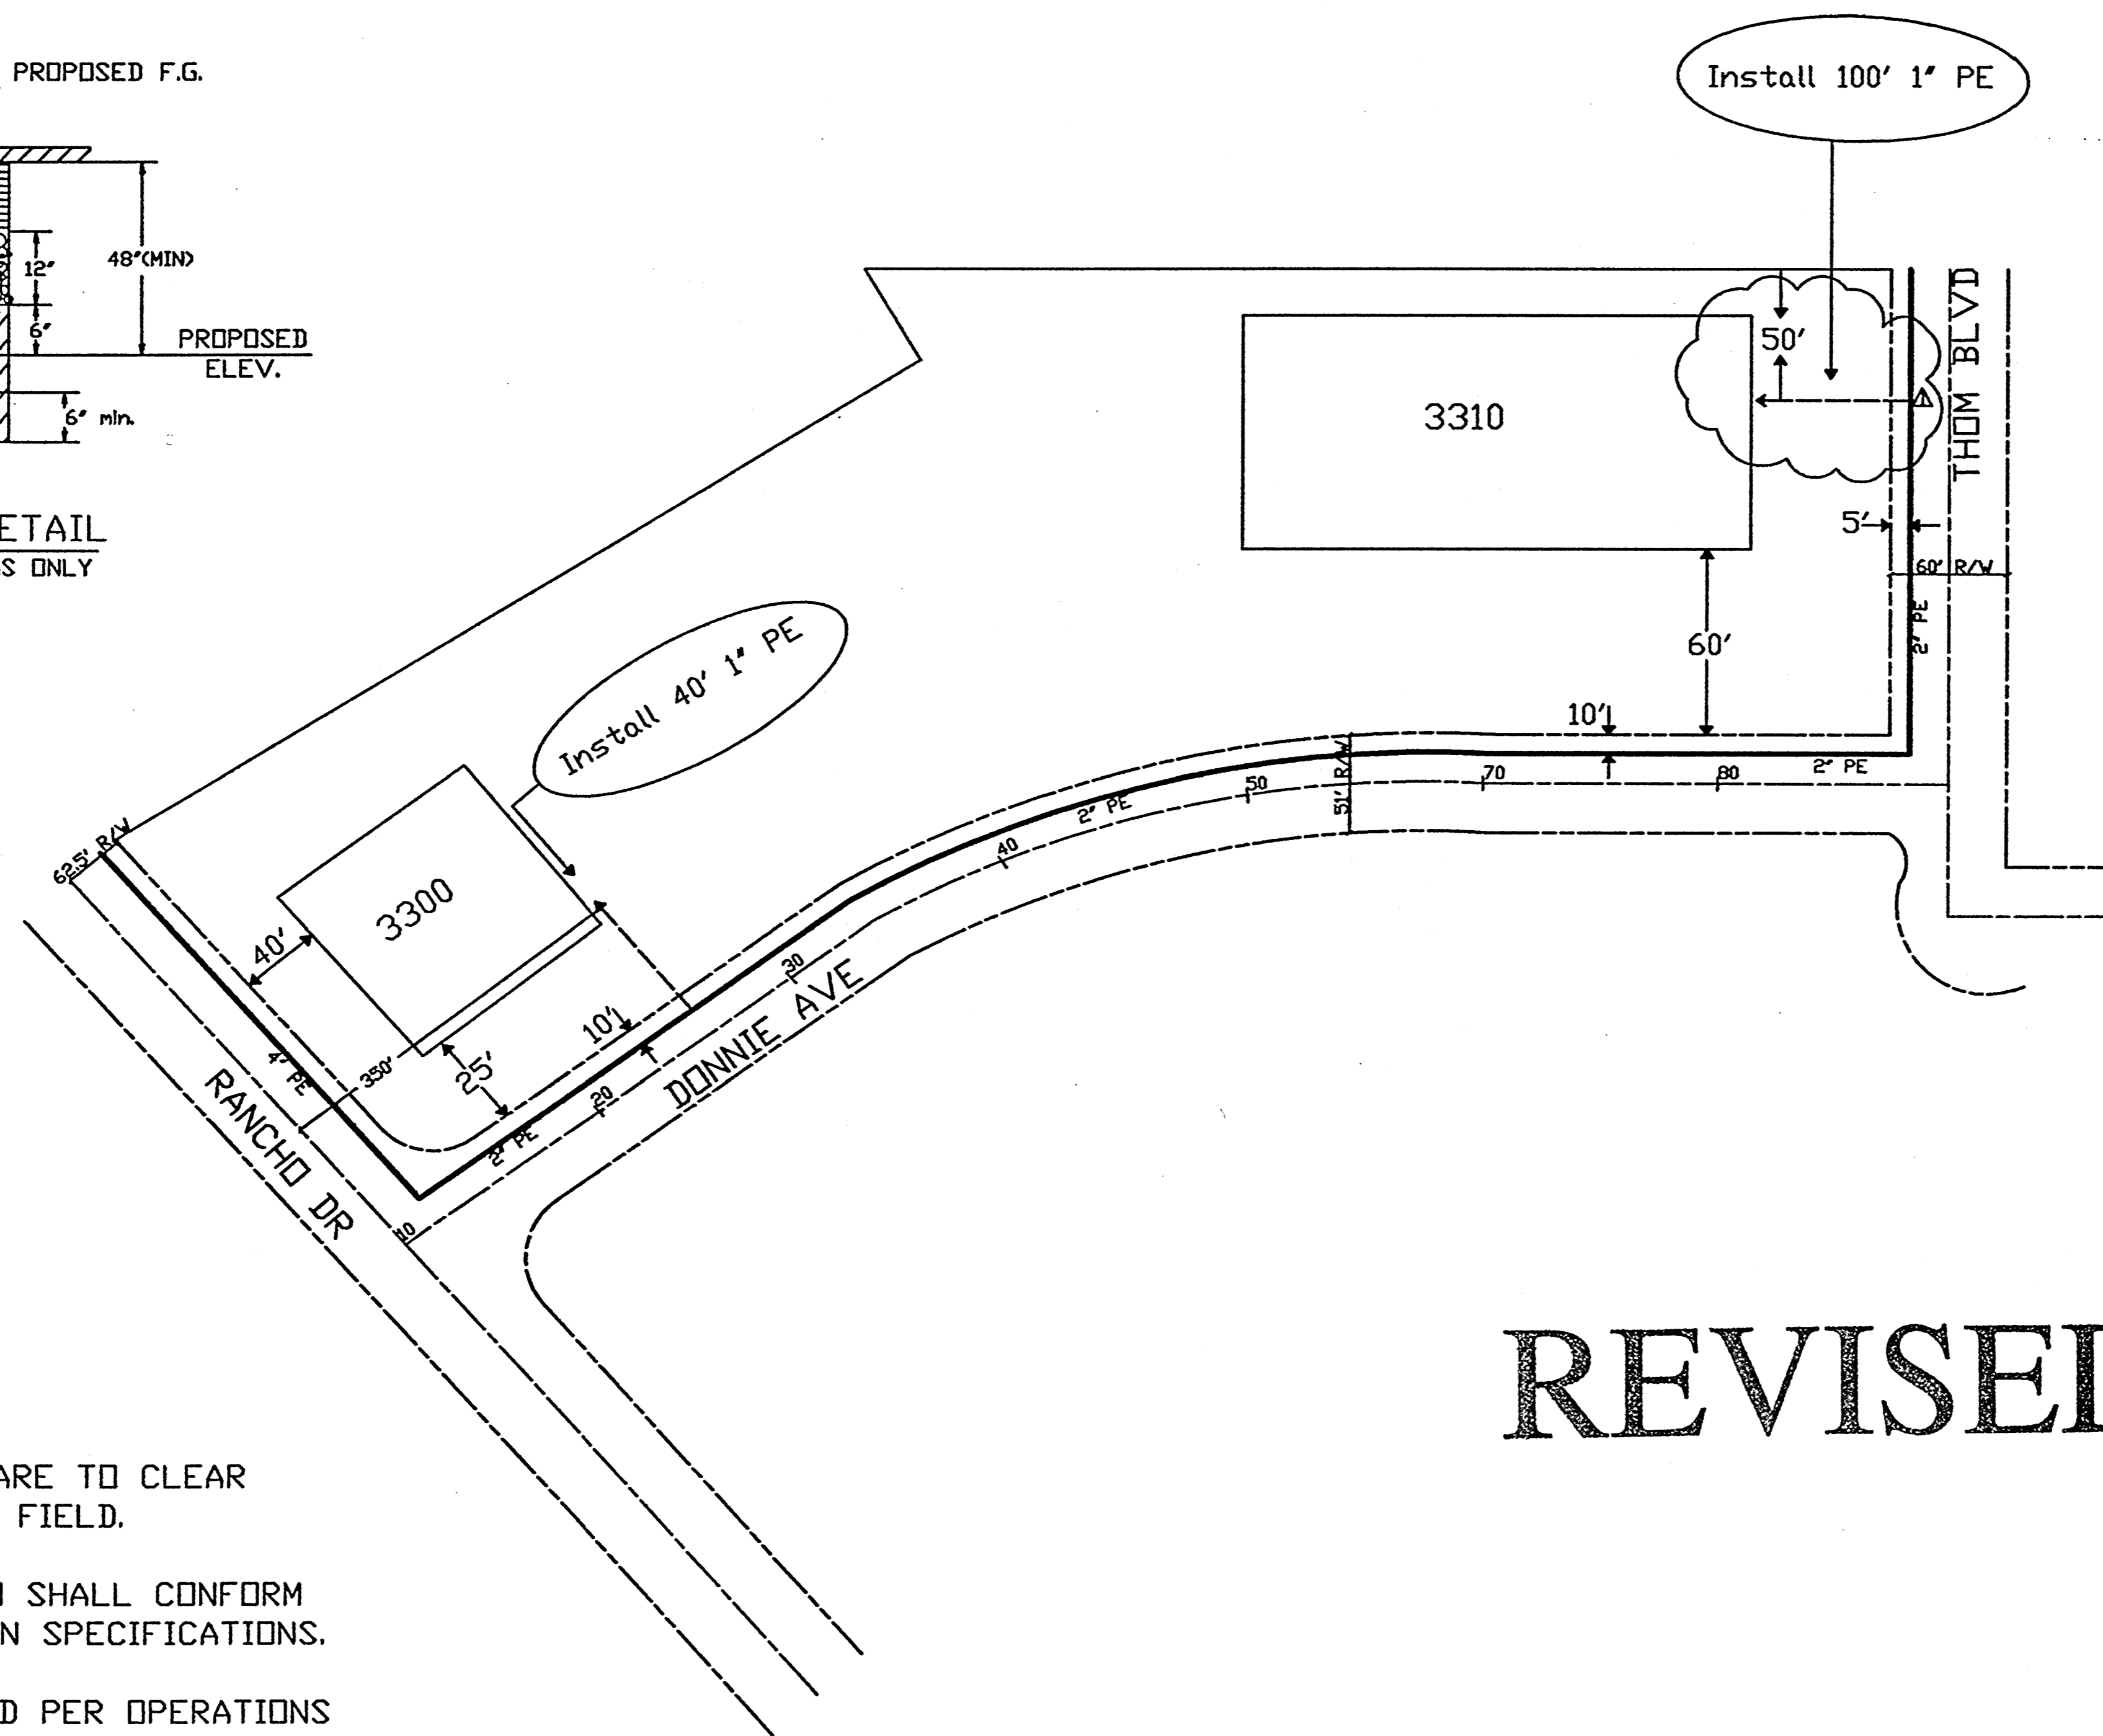

REVISED

CONSTRUCTION NOTES:

1. SUGGESTED GAS LOCATIONS ARE TO CLEAR SUBSTRUCTURES. LOCATE IN FIELD.
2. ALL PIPELINE CONSTRUCTION SHALL CONFORM TO APPLICABLE JURISDICTION SPECIFICATIONS.
3. GAS MAINS SHALL BE PURGED PER OPERATIONS MANUAL.
4. CITY OF LAS VEGAS PERMIT REQUIRED.
5. DO NOT SCALE THIS DRAWING.

City of
Las Vegas

Total footage located in Public ROW 20'

APPROVED FOR CONSTRUCTION
THIS APPROVAL IS FOR WORK IN CLV R/W OR CLV EASEMENTS ONLY. OBTAINING PERMISSION OR EASEMENTS FOR WORK SHOWN ON PRIVATE PROPERTY IS THE RESPONSIBILITY OF THE UTILITY.

Approval: orig. approved on 12/17/07 Date

CUSTOMERS: _____ CYCLE _____ ROUTE _____ AREA _____ LV _____

Line relocation 1" PE 140' 108506 		AS-BUILT DRAWING-PRESSURE TEST DATA PIPE DIA _____ TEST MEDIUM _____ TEST METHOD _____ PIPE LENGTH _____ <input type="checkbox"/> AIR <input type="checkbox"/> CHART PIPE TYPE _____ <input type="checkbox"/> NITROGEN <input type="checkbox"/> CHART HDL DURATION _____ <input type="checkbox"/> WATER GAUGE/ <input type="checkbox"/> SDAP PRESS REC SHH		VISUAL INSPECTION CERTIFICATION I HAVE VISUALLY INSPECTED ALL HEATED FUSIONS, SOLVENT CEMENT, MECHANICAL JOINTS, AND WELDS THAT I HAVE PERFORMED. NAME _____ DATE _____ _____ _____ _____		CONSTRUCTION INSPECTOR _____ FOREMAN _____ REVIEWED BY _____ PERMIT INFORMATION Tax Code Area-02-0200 CITY OF LAS VEGAS		ISOLATION AREA 27 W. R. NO. 717425 717433 LOCATION ATLAS #/TILE # x699 y534		ENGINEER/TECHNICIAN WILLIAM GRENNAN PHONE 702-365-2173 ACCOUNT REP. JOHN WRIGHT PHONE 702-528-7729 PROJECT CONTACT JOHN WRIGHT SHEET NO. 1 OF 1 SCALE N/A DATE 12/07/2007 DWN BY SWG CHKD BY _____ APPVD BY _____ TITLE 107N4834-SWG HABITAT RANCHO DR / DONNIE AVE	
REVISIONS NO. DESCRIPTION BY DATE APPVD.		PROPERTY UNITS UNIT NO. UNIT TYPE INSTL. RET. INSTL. RET. COMPLETED		TEST PRES. OPS/D TIME _____ START _____ END _____ DATE _____ PERFORMED BY _____		AS-BUILTS ACCEPTED BY _____ DATE _____ POSTED BY _____ DATE _____ POSTING O/C'D BY _____ DATE _____		PERMIT INFORMATION Tax Code Area-02-0200 CITY OF LAS VEGAS		ENGINEER/TECHNICIAN WILLIAM GRENNAN PHONE 702-365-2173 ACCOUNT REP. JOHN WRIGHT PHONE 702-528-7729 PROJECT CONTACT JOHN WRIGHT SHEET NO. 1 OF 1 SCALE N/A DATE 12/07/2007 DWN BY SWG CHKD BY _____ APPVD BY _____ TITLE 107N4834-SWG HABITAT RANCHO DR / DONNIE AVE	

#26-160 HABITAT CENTER 11-06045