


T.R.S: 2061-34
 APN: 13934301008

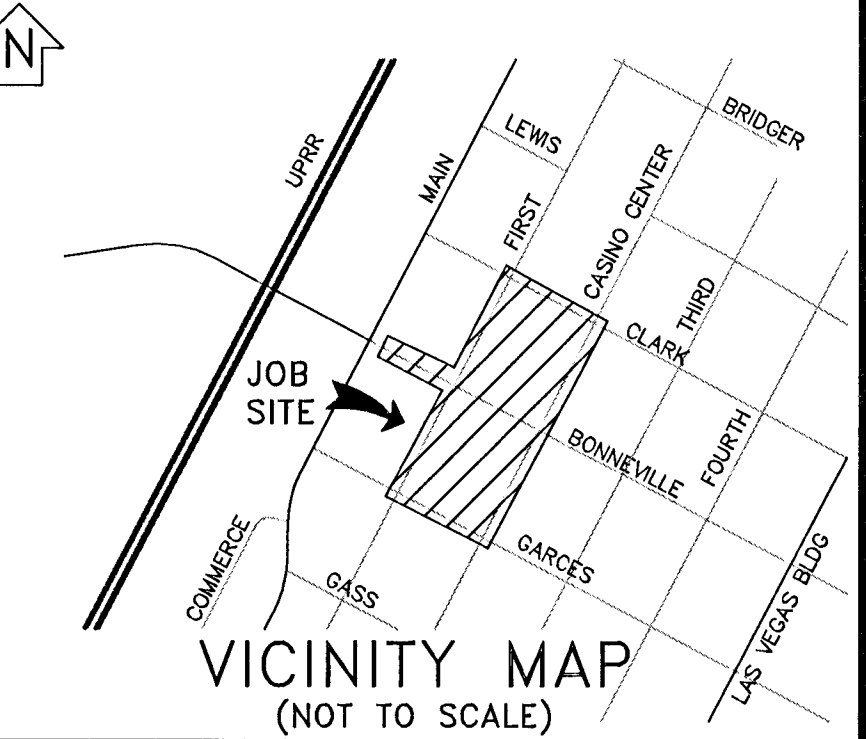

EVERY EFFORT HAS BEEN MADE TO IDENTIFY ALL NVE FACILITIES. THE CUSTOMER SHALL CONFIRM THE EXISTENCE AND LOCATION OF THESE FACILITIES.

AVOID HITTING OVERHEAD POWER LINES. IT'S COSTLY.

CALL BEFORE YOU DO OVERHEAD

Call before you Dig
 Avoid putting underground utility in jeopardy.

Call 811

1-800-227-2600
 CLARK COUNTY
 1-702-402-2929
 1-702-455-7544

NO.	DESCRIPTION	DATE	G.A.
1	PER FIELD CONFLICT, REVISED FUT. GA1209 CONDUIT LAYOUT ON THE NORTH SIDE OF GARCES WEST OF CASINO CENTER, SHEET 2 - JNC	12/16/2009	
2	IN: 1 RUN OF 500 TRI & HANDHOLE TO REFRESH S/L AT CLARK AND 3RD, CUST TO REM. & REPLACE SERVICE WIRE	07/09/2010	

OVERHEAD	
TYPE OF EASEMENT:	JPA NOTES:
<input type="checkbox"/> AERIAL <input type="checkbox"/> STANDARD <input type="checkbox"/> UNDERGROUND <input type="checkbox"/> AS BUILT UNDERGROUND <input type="checkbox"/> R.O.E./R/W-5-COM <input type="checkbox"/> 3rd PARTY <input type="checkbox"/> UNDERGROUND BY EXHIBIT <input type="checkbox"/> (N-DOT) PERMIT <input type="checkbox"/> (BLM) PERMIT <input type="checkbox"/> RAILROAD-UPRR-PERMIT <input type="checkbox"/> SD: NEVADA WATER PERMIT <input type="checkbox"/> NOT REQUIRED <input type="checkbox"/> Misc. Info.	<input type="checkbox"/> EMBARGO CONTACT: LEN BELLOWS <input type="checkbox"/> PHONE NUMBER: 702/244-7839 <input type="checkbox"/> DATE OF CONTACT: 12/03/2008 <input type="checkbox"/> TO SET NEW POLES <input type="checkbox"/> TO STAKE NEW POLES <input type="checkbox"/> TO PROVIDE POLES <input type="checkbox"/> -3 FT. CLASS I <input type="checkbox"/> -5 FT. CLASS II <input type="checkbox"/> -1 FT. CLASS IV <input type="checkbox"/> TO DIG POLE HOLES <input type="checkbox"/> NVE TO REMOVE EX. POLES <input type="checkbox"/> REMOVING 9 POLES AND CONVERTING THEM TO JG. DIST. <input type="checkbox"/> JPA#: P200800332

EXHIBIT 'A'	
NVE INFORMATION:	
COORDINATOR:	DOUG GIBSON
PHONE:	702/402-4331
DESIGNER:	JASON COOPER
DCA:	N/A
INSPECTION SCHEDULING:	402-3008
STAND BY:	402-4117, 402-4116, 402-4118
DISTRICT:	LAS VEGAS NORTH
CUSTOMER INFORMATION:	
APPLICANT:	FOREST CITY COMMERCIAL
ENGINEER:	
CONTACT:	STF / DAVE WAGNER 702/376-0526
APPROVAL DATE:	03/12/2009
GOVERNMENT INFORMATION:	
AGENCY:	CITY OF LAS VEGAS
APPROVAL DATE:	10/15/2009
FOR EACH SERVICE POINT (POINT OF DELIVERY), ENERGY FOR EACH TENANT SPACE WILL BE MEASURED THROUGH ONE WATTHOUR METER. ENERGY FOR ALL NON-TENANT SPACE WILL BE MEASURED THROUGH ONE WATTHOUR METER. CONTACT NVE METER OPERATIONS FOR MULTIPLE RATE CLASS INSTALLATIONS	

NVEnergy

RTC DOWNTOWN RELOCATION
 GARCES & CASINO CENTER

H#35279 Rev#10705241-47L

PROJ. ID: 190708 SCALE: 1" = 50'
 SHEET #: 3 OF 4 DATE: 09/03/2008

CITY OF LAS VEGAS PERMIT REQUIRED*

CONTACT CLV LAND DEVELOPMENT (228-8371)
 CLV CONSTRUCTION SERVICES MUST BE NOTIFIED 24 HOURS PRIOR TO COMMENCING CONSTRUCTION (228-8337)

*NVC INSPECTOR MUST BE NOTIFIED BY FAX 48 HOURS PRIOR TO COMMENCING CONSTRUCTION & WILL VERIFY CITY PERMIT FOR WORK DONE IN STREETS OR SIDEWALK.










FAX PERMIT TO:
 LAS VEGAS NORTH (702-4331)
 LAS VEGAS SOUTH (HENDERSON) 402-8983
 LAS VEGAS SOUTH (SPRING VALLEY) 402-8986

PURPOSE OF PROJECT:
 RELOCATE OVERHEAD AND STUB OUT FOR FUTURE WORK ORDERS ALONG CASINO CENTER BLVD

CIVIL LINETYPE LEGEND

	PROPOSED	EXISTING
CENTERLINE	---	---
PROPERTY LINE/ROW	---	---
CURB	---	---
EDGE OF PAVEMENT	---	---
EDGE OF SIDEWALK	---	---
SEWER LINE	---	---
WATER LINE	---	---
GAS LINE	---	---
TELEPHONE LINE	---	---
CABLE TV LINE	---	---
STORM DRAIN LINE	---	---
FIRE HYDRANT	---	---
STREET LIGHT	---	---
STREET LIGHT SERVICE	---	---

*LINETYPES UTILIZED WHERE CONFLICT OCCURS WITH NVC FACILITIES.

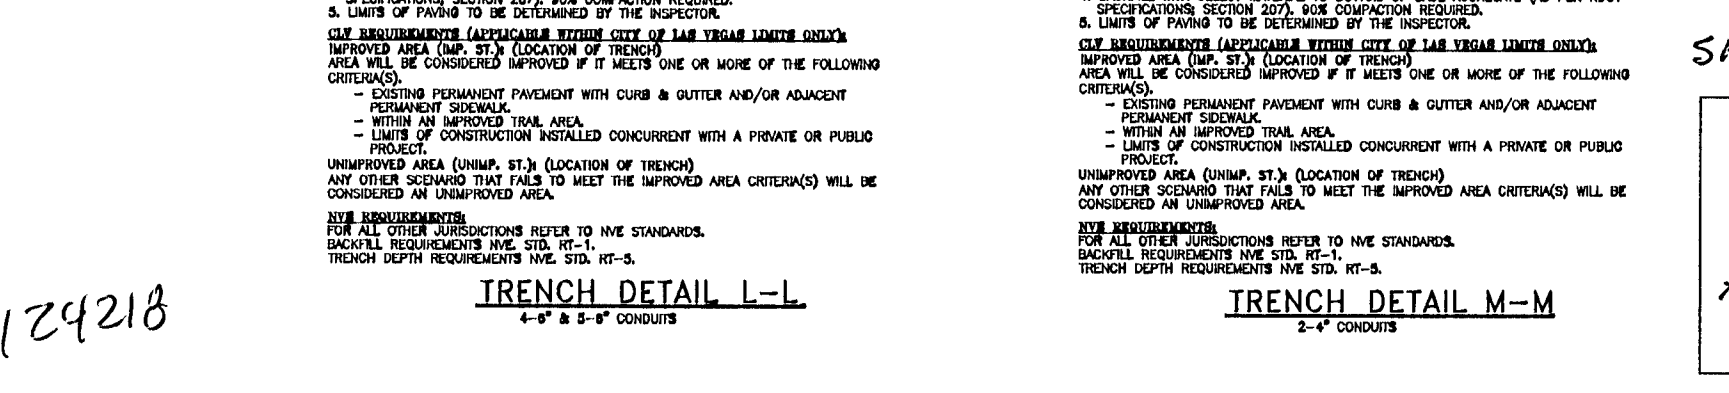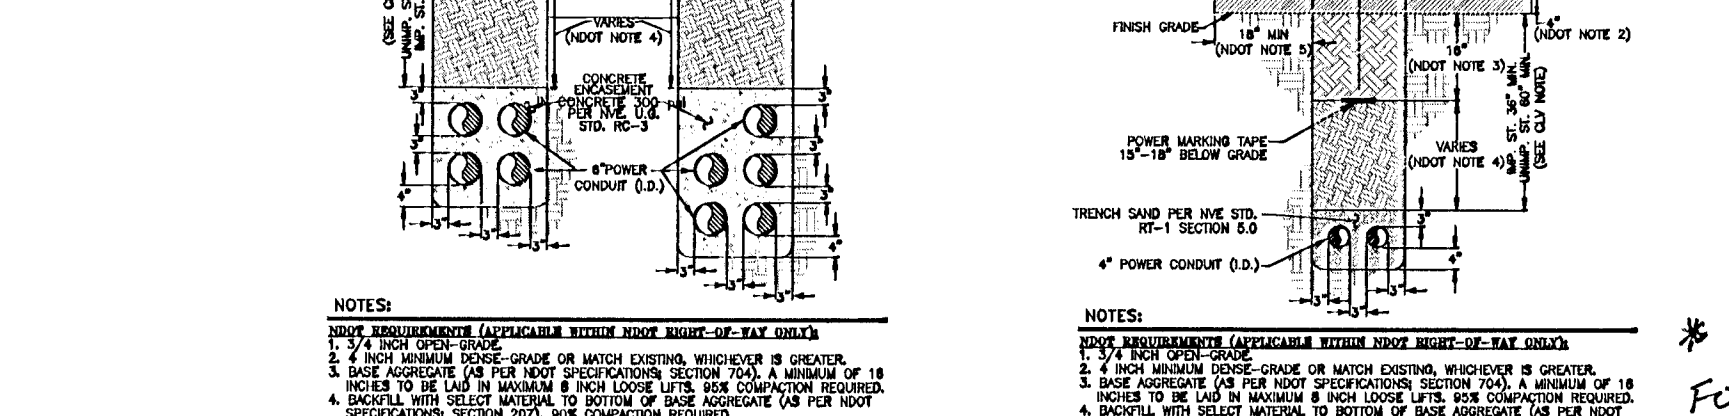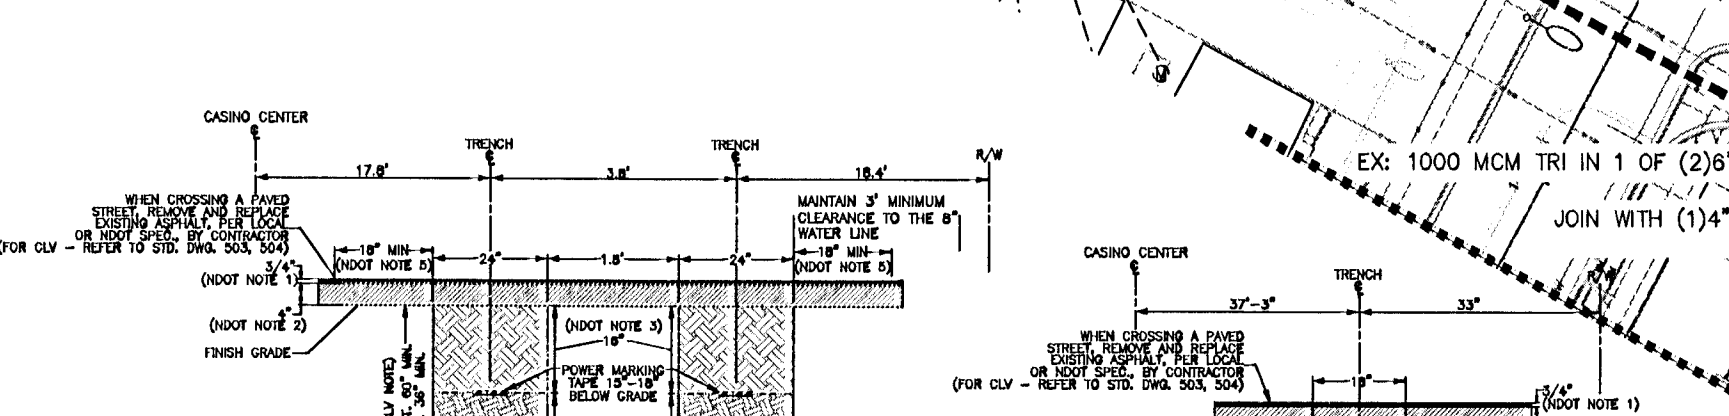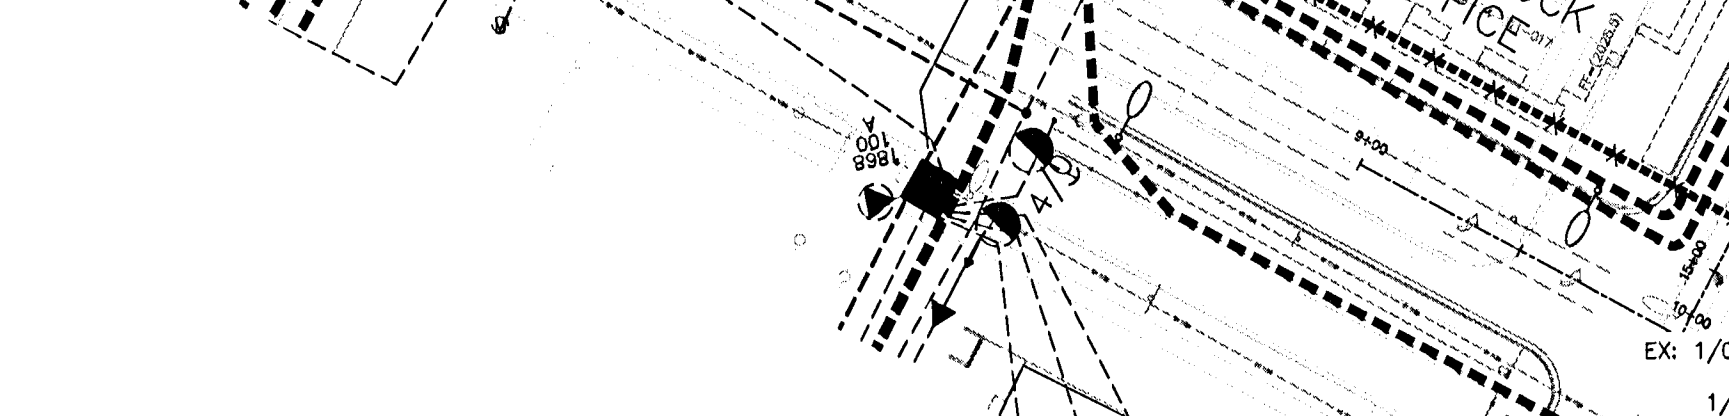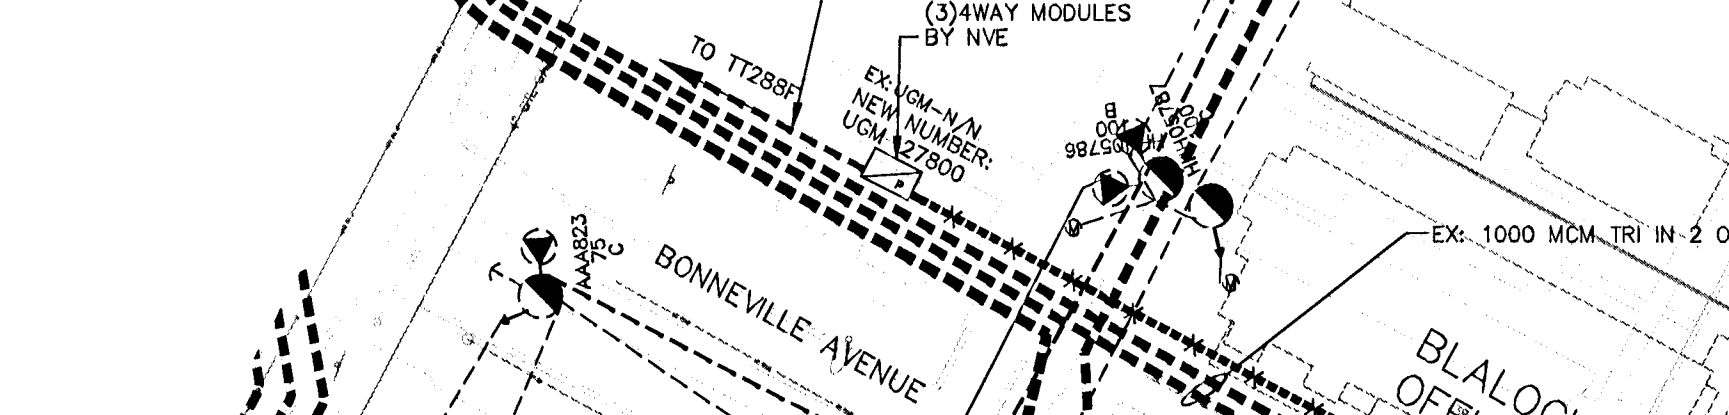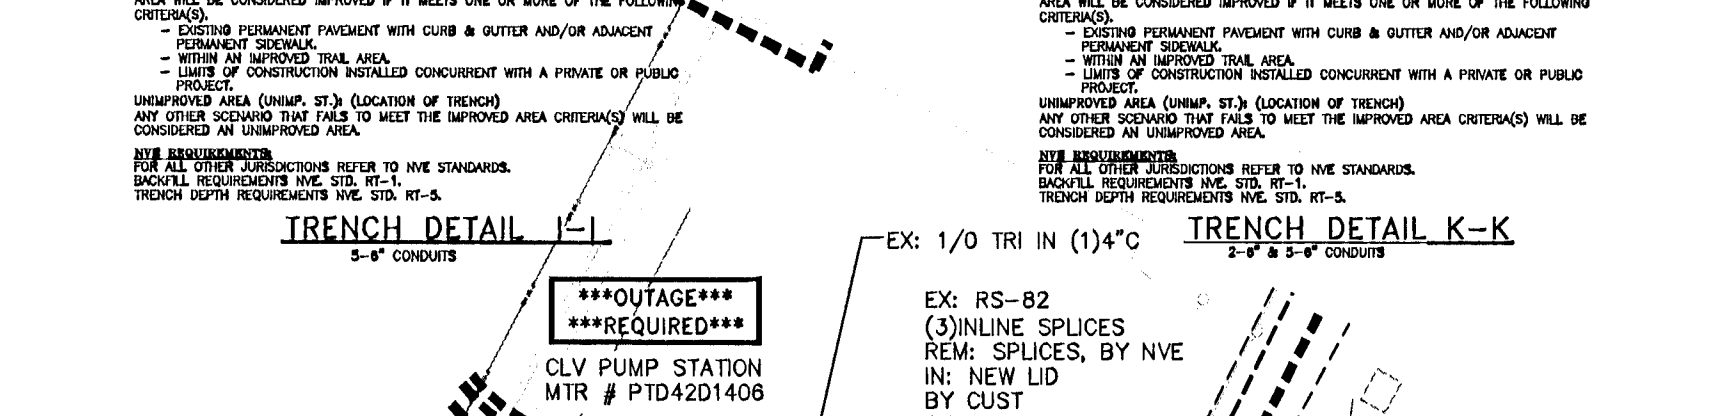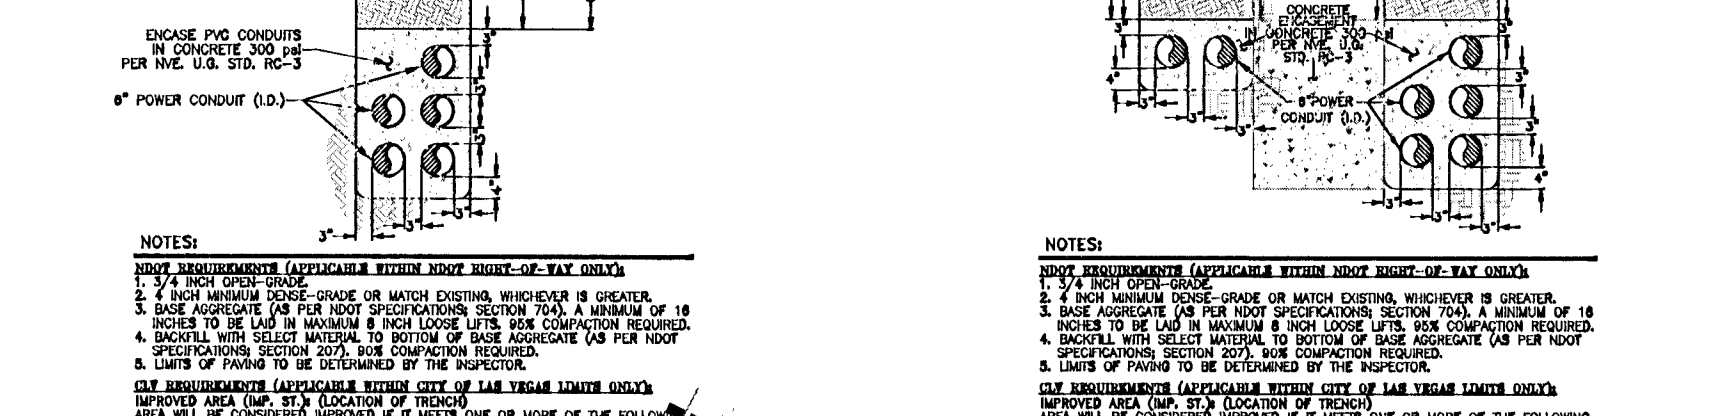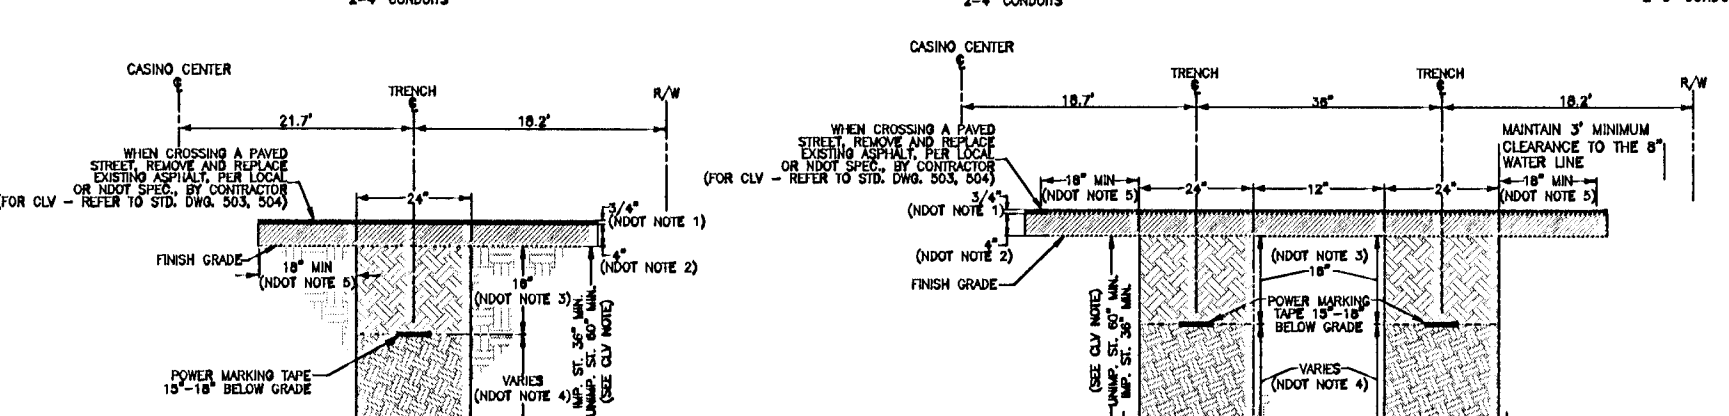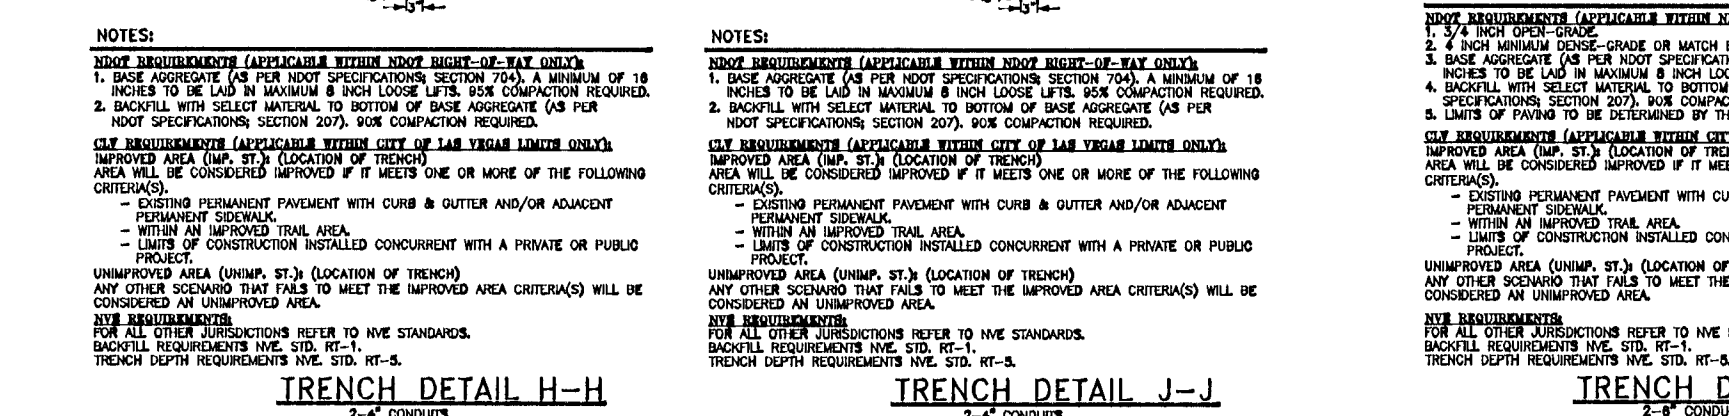

* L-REVISION H#38834 FOR A. SHEET RE-PLOTTED 7/12/2010

APPROVED FOR CONSTRUCTION

THIS APPROVAL IS FOR WORK IN CLV R/W & EASEMENT ONLY. OBTAINING PERMISSIONS OR EASEMENTS FOR WORK SHOWN ON PRIVATE PROPERTY IS THE RESPONSIBILITY OF THE UTILITY.

* Dave Wagner 7/12/2010

APPROVAL DATE