

Note:
All power poles that interfere with the proposed construction are to be relocated by others.

NOTE: THIS INTERSECTION NOT TO SCALE

Notes:
All utility companies shall be notified prior to beginning of construction.
Adjust top of existing manholes to finished grade.
Water valve boxes to be adjusted to finish grade by others.

For Traffic Signal Installation at the intersection of Washington Avenue and Highland Drive - See City of Las Vegas Drawing # 208-69.

Note:
For additional information - see enlarged drawing of intersection on Sheet No. 4.

PRIVATE ENGINEER'S NOTICE TO CONTRACTOR

THE EXISTENCE AND LOCATION OF ANY UNDERGROUND UTILITY PIPES OR STRUCTURES SHOWN ON THESE PLANS ARE OBTAINED BY A SEARCH OF THE AVAILABLE RECORDS. TO THE BEST OF OUR KNOWLEDGE THERE ARE NO EXISTING UTILITIES EXCEPT AS SHOWN ON THIS PLAN. THE CONTRACTOR IS REQUIRED TO TAKE PRECAUTIONARY MEASURES TO PROTECT THE UTILITY LINES SHOWN AND ANY OTHER LINES NOT RECORDED OR NOT SHOWN ON THIS DRAWING.

2060
2055
2050
2045

CLV BM # 414
Rivet and plate T.C.
12' North end curb and gutter, N.E. Owens and Highland.
Elevation 2053.612

NOTE: VALLEY GUTTER & CURB RETURNS AT MS WILLIAMS AVE. INTERSECTION REVISED BY CITY, SEE SHI. NO. 4.

APPROVALS

[Signature]
Director of Public Works
Date

[Signature]
Traffic Engineer
2-2-65
Date

PLAN OF STREETS
HIGHLAND DRIVE
BETWEEN
WEST BONANZA ROAD
AND
WEST OWENS AVENUE


SCALES: 1" = 50' HORIZ.
1" = 5' VERT.

CLARK COUNTY NEVADA

WORK ORDER 1810-1
DESIGNED CBT
CHECKED GAB
DATE 12-29-64

PREPARED BY ENGINEERING SERVICE CORPORATION
ENGINEERS - PLANNERS
1127 WEST WASHINGTON BLVD., LOS ANGELES 15, CALIF.
1802 LAS VEGAS BLVD., SOUTHWEST CORNER, LAS VEGAS, NEV. 89104

SHEET 2 OF 7 107-V-616

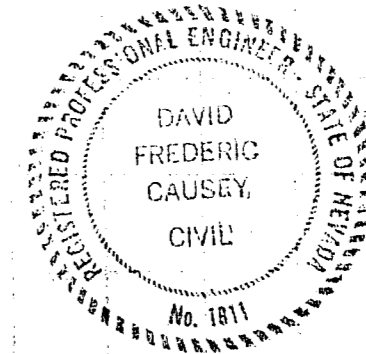

AS BUILT