


1" = 40' HORIZ. 1" = 5' VERT.

21" Ø & TYPE 'A'
 CHOP INLET
 TO = 33.50
 LE (IN) = 67.65
 LE (OUT) = 47.60


21" Ø & TYPE 'A'
 CHOP INLET
 TO = 48.00
 R.C. = 53.32

139+00 140+00 141+00 142+00 143+00 144+00 145+00 146+00 147+00 148+00 149+00

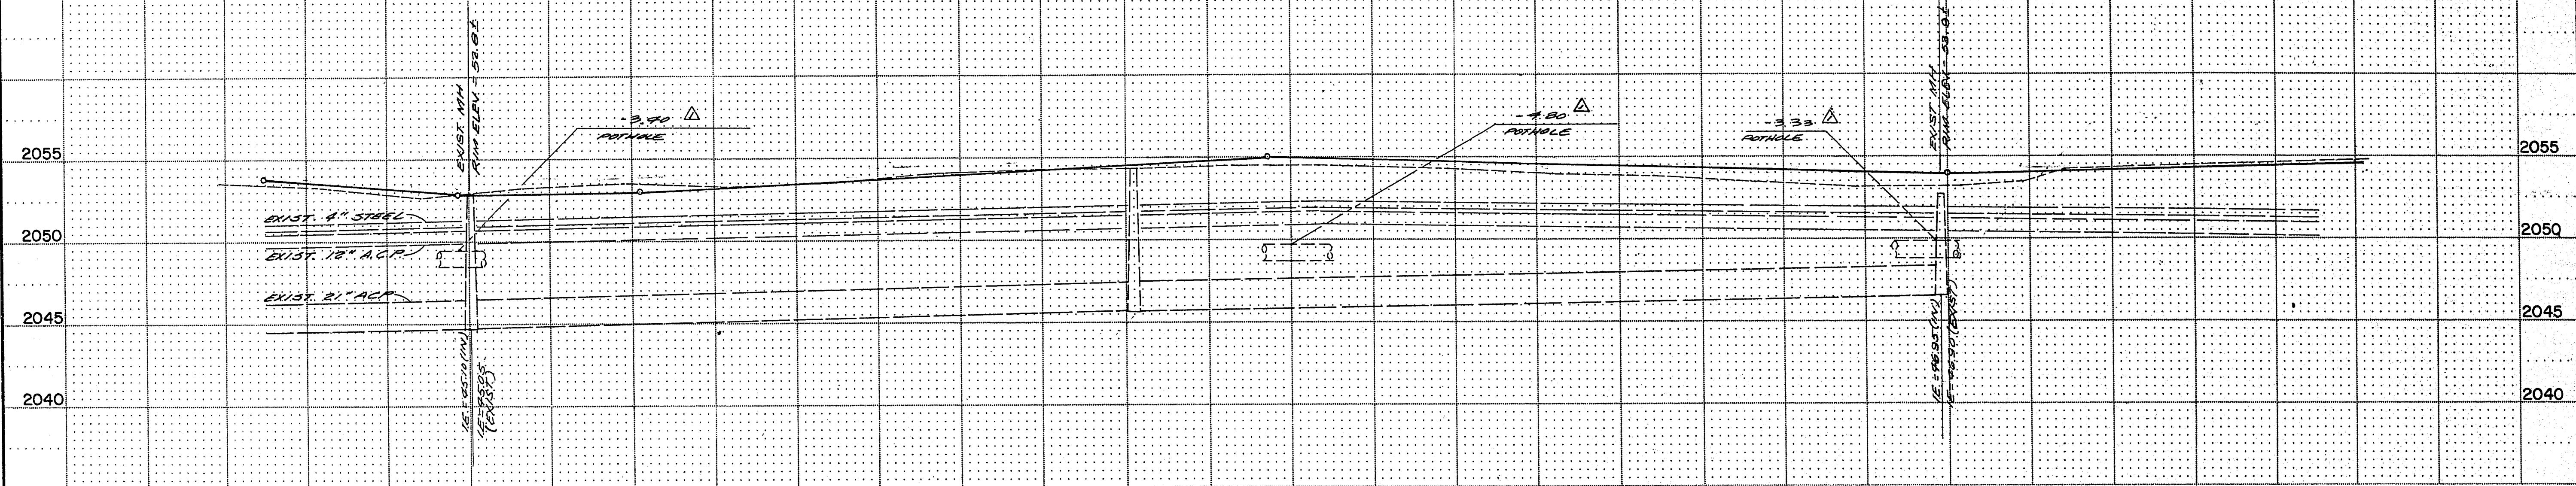


1" = 40' HORIZ. 1" = 5' VERT.

NOTE:
 POT HOLE DATA INDICATES DEPTHS FROM
 EXIST. FINISH GRADE TO TOP OF PIPE

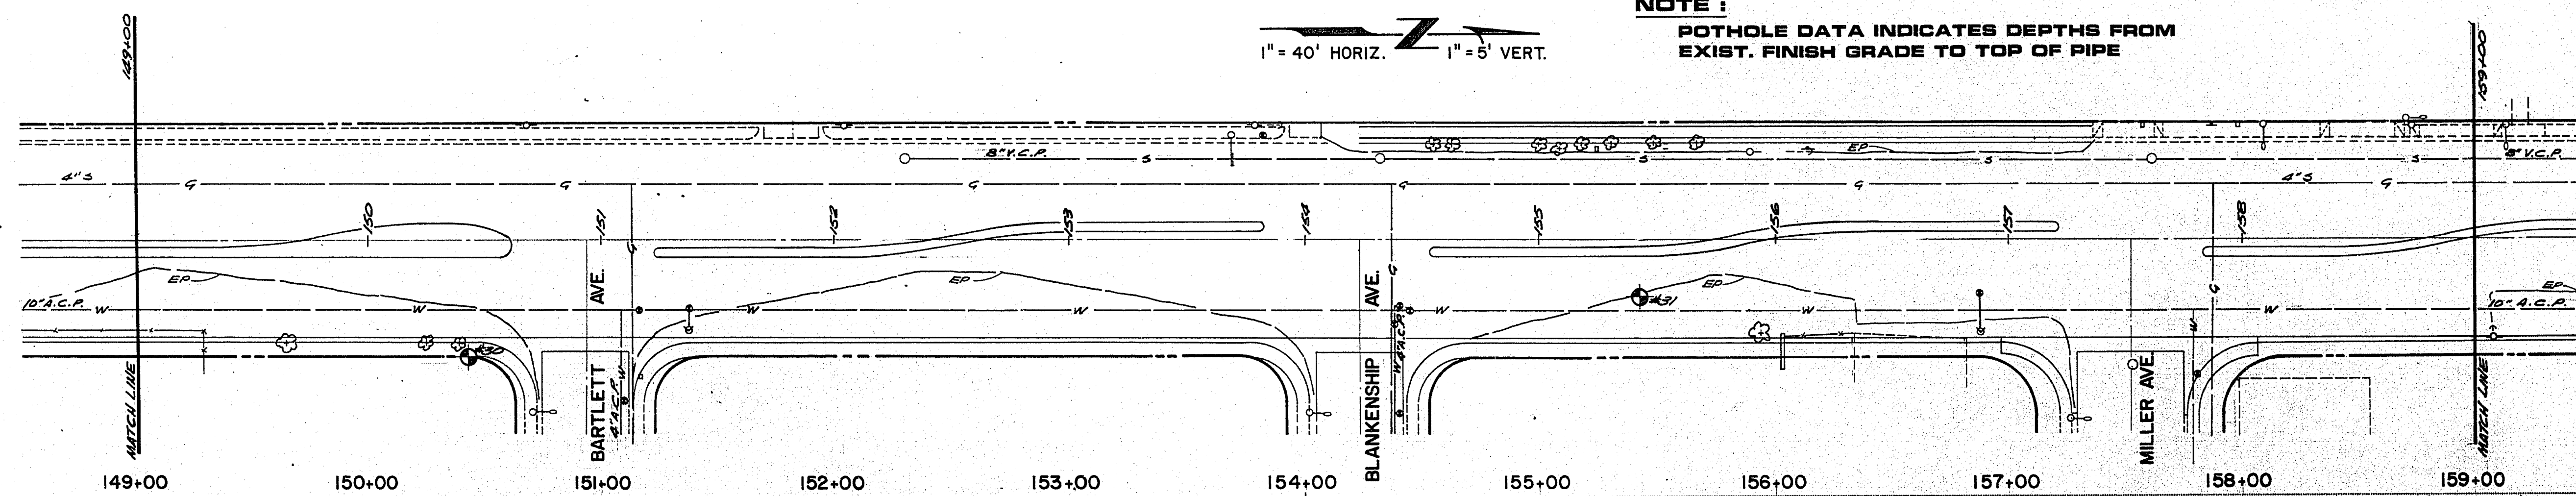

149+00 150+00 151+00 152+00 153+00 154+00 155+00 156+00 157+00 158+00 159+00

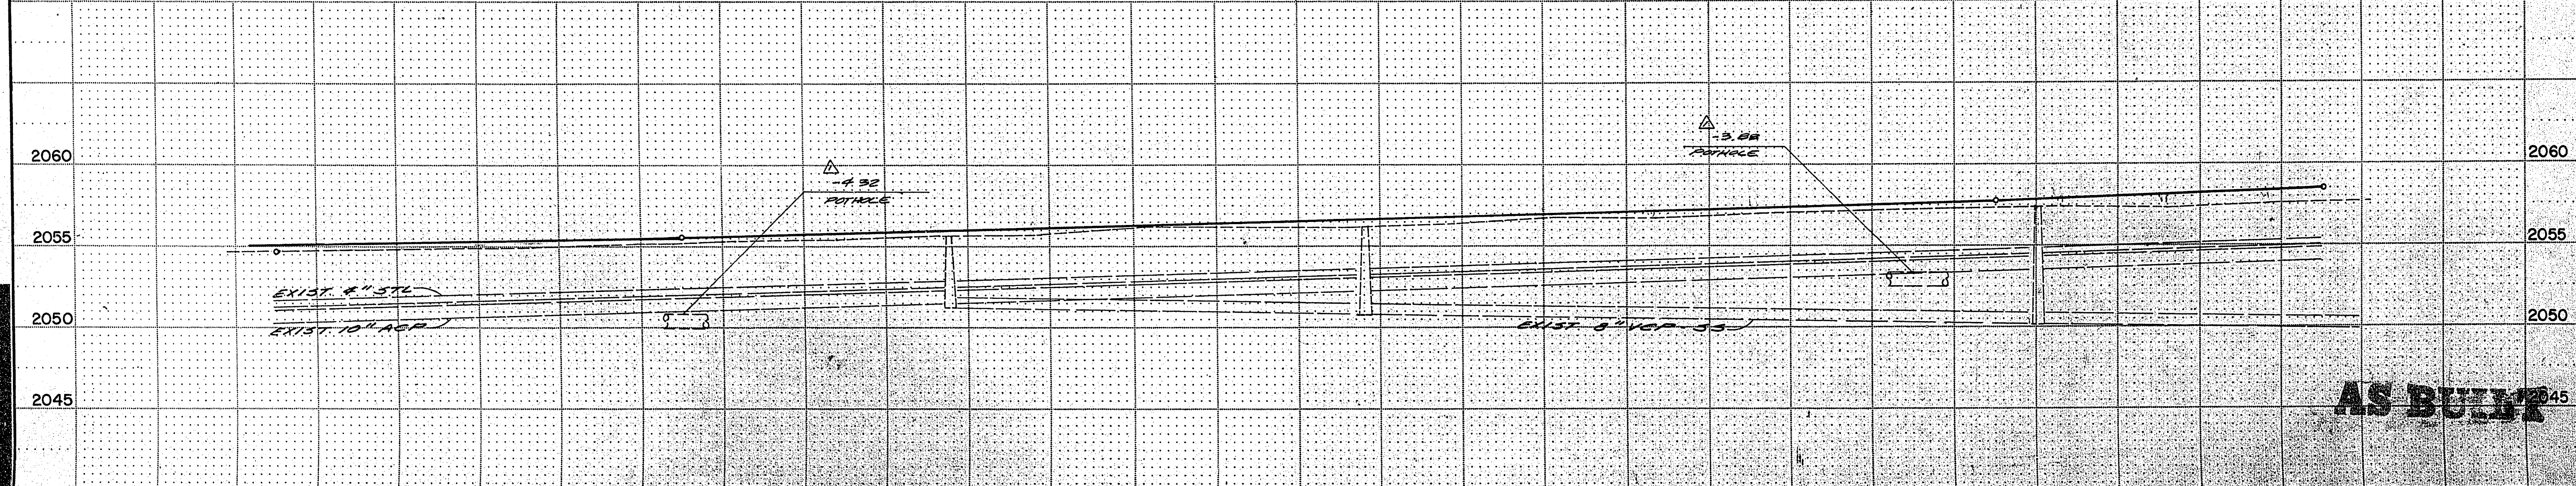

REVISIONS

NO.	DESCRIPTION/DATE	BY

1/24/84

SPARKS, NEVADA
 LAS VEGAS, NEVADA
 SEATTLE, WASHINGTON

incorporated

ENGINEERS/PLANNERS

CITY OF LAS VEGAS
 HIGHLAND DRIVE
 CHARLESTON BOULEVARD TO CAREY AVENUE
 STORM DRAIN
 139+00 TO 159+00

JOB NO. 2-0241-004-821
 DESIGNED DFP
 DRAWN TAM, SLE
 COMP.
 CHECKED
 DATE DECEMBER, 1982
 SHEET NO.

AS BUILT