






JOB NO. 620.232

8/84 DIETRICH-POST 65328

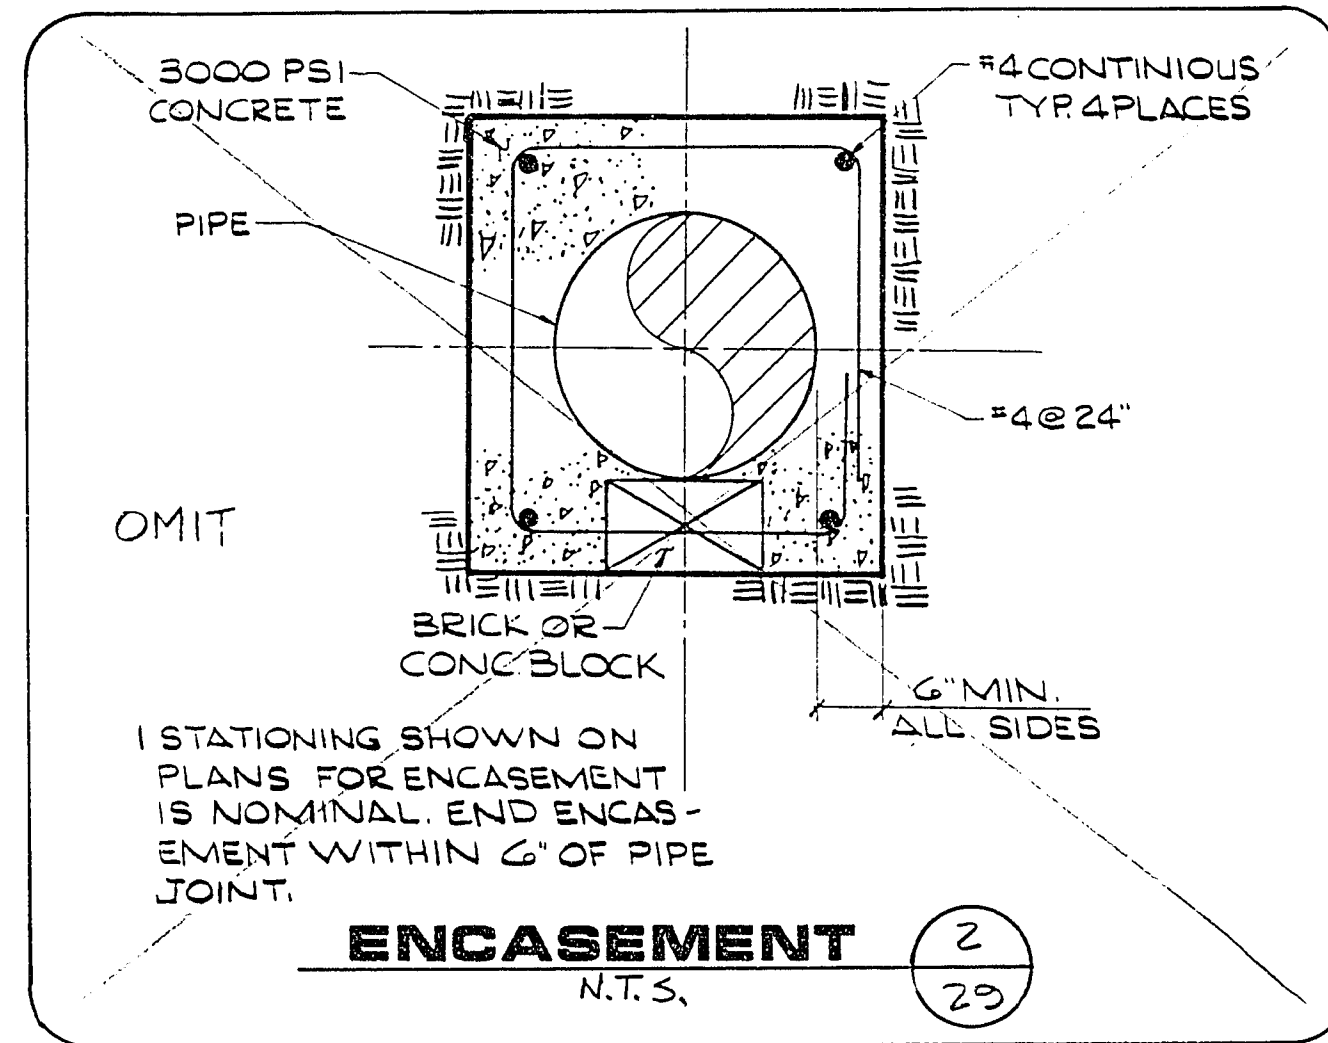

NOTES:

1. SLEEVES AND CONDUITS SHALL BE INSTALLED 18" BELOW FINISHED GRADE AND SHALL EXTEND 12" BEYOND BACK OF CURBS, WALLS AND PAVING.
2. CONTRACTOR SHALL RECORD LOCATIONS OF INSTALLED SLEEVES: A COPY OF THE FIELD NOTES SHALL BE GIVEN TO THIS ENGINEER FOLLOWING CONSTRUCTION.
3. HORIZONTAL LOCATION OF SLEEVES SHALL BE SHOWN ON DESIGN PLANS.

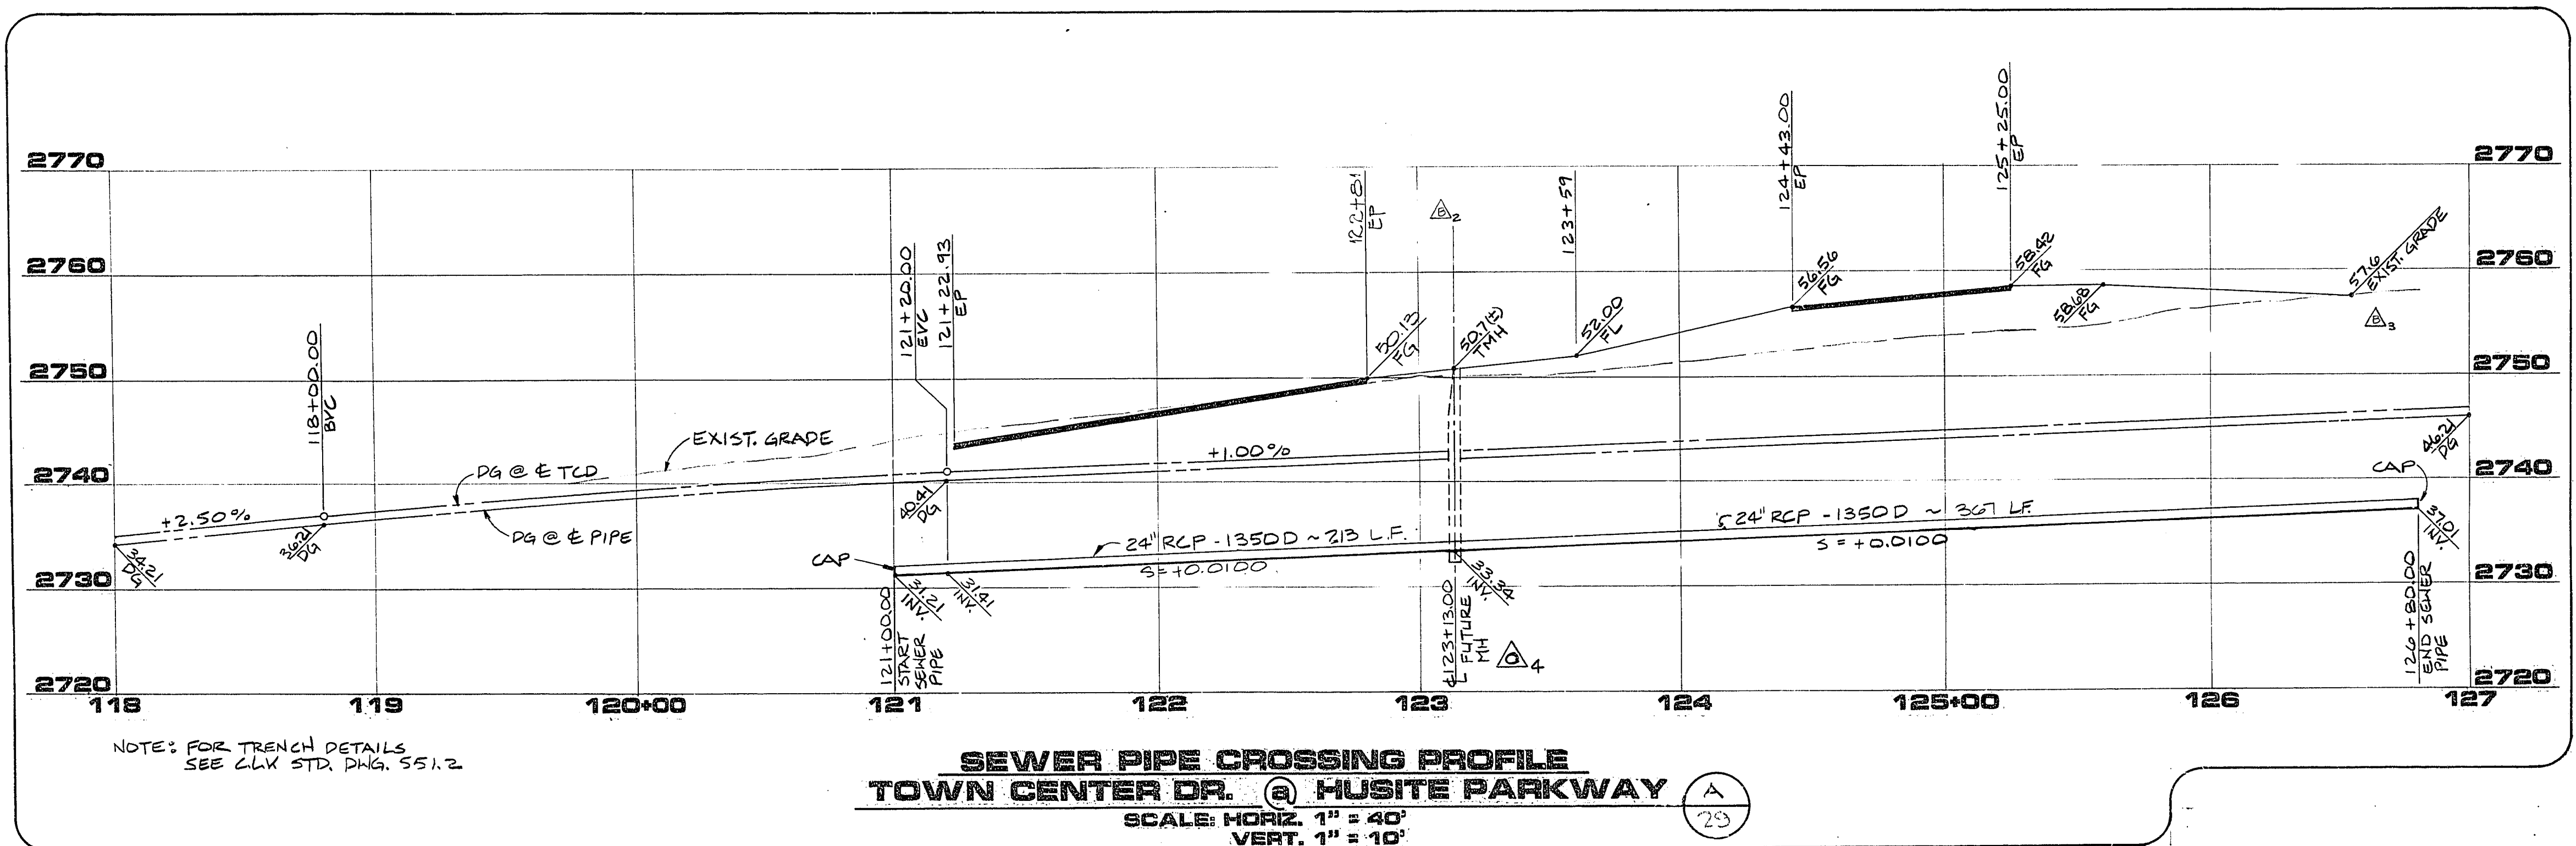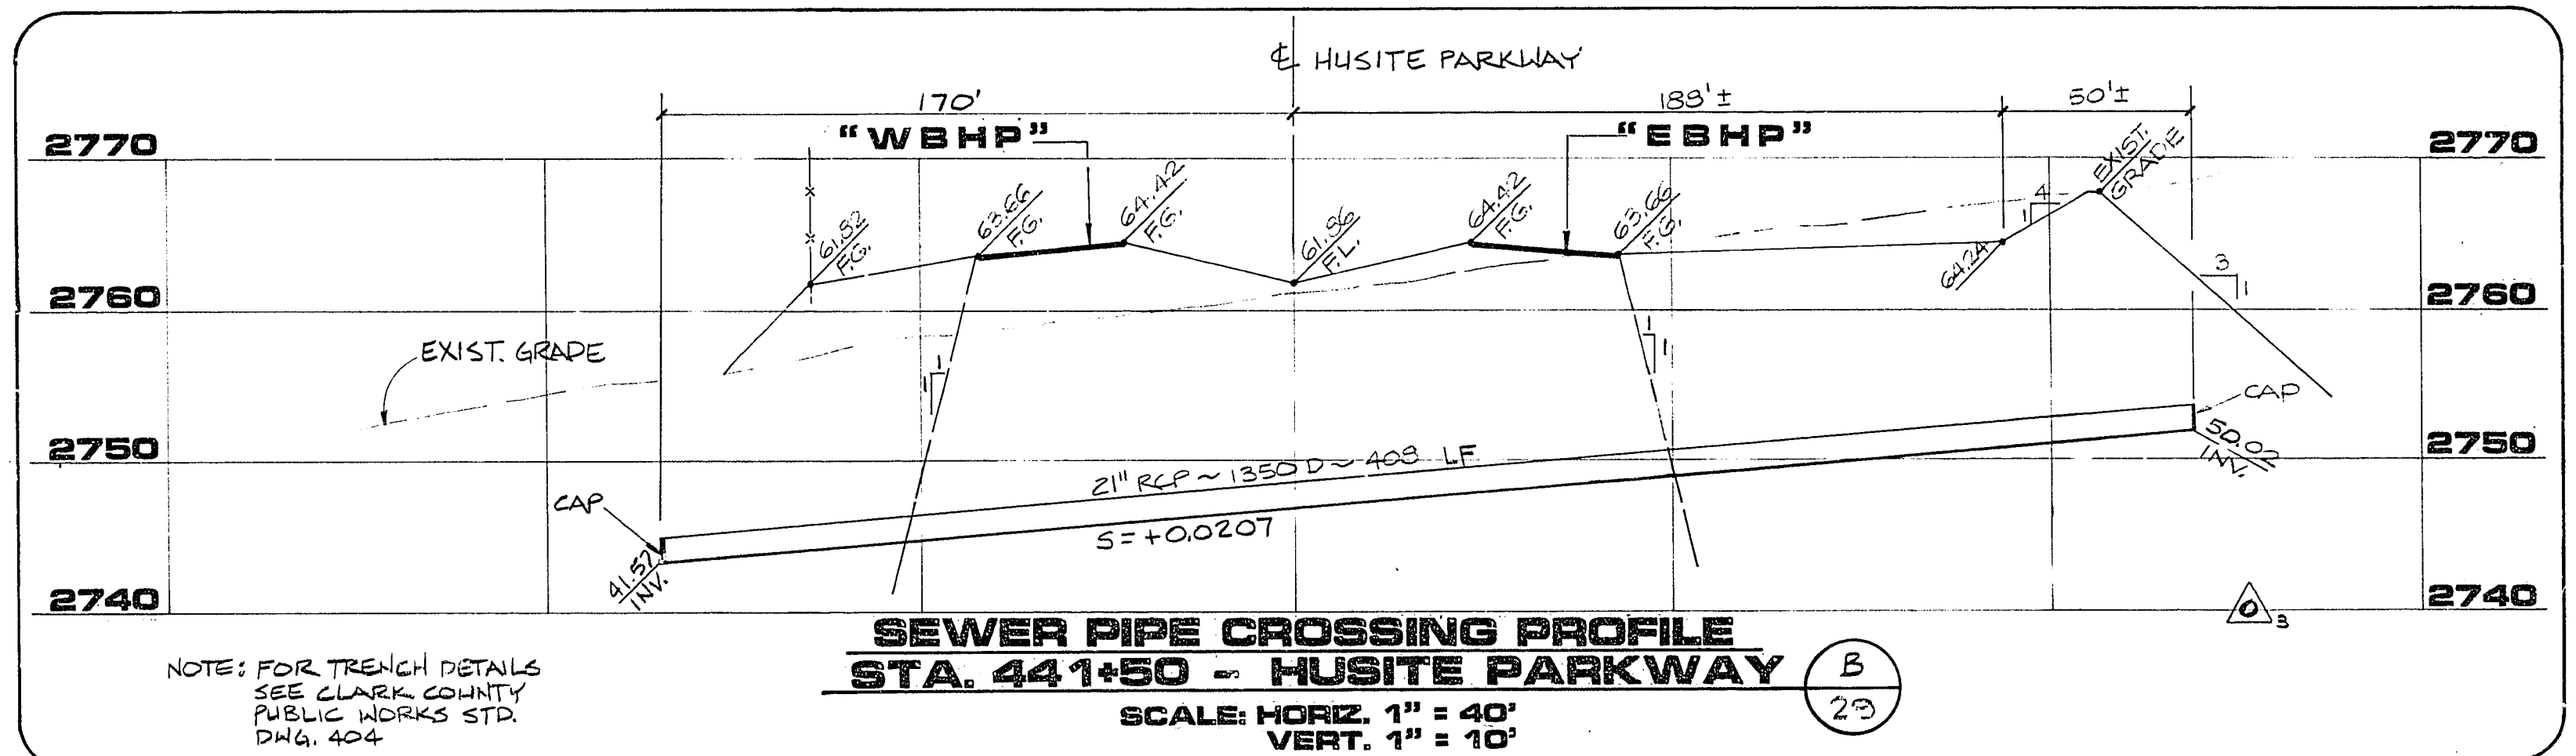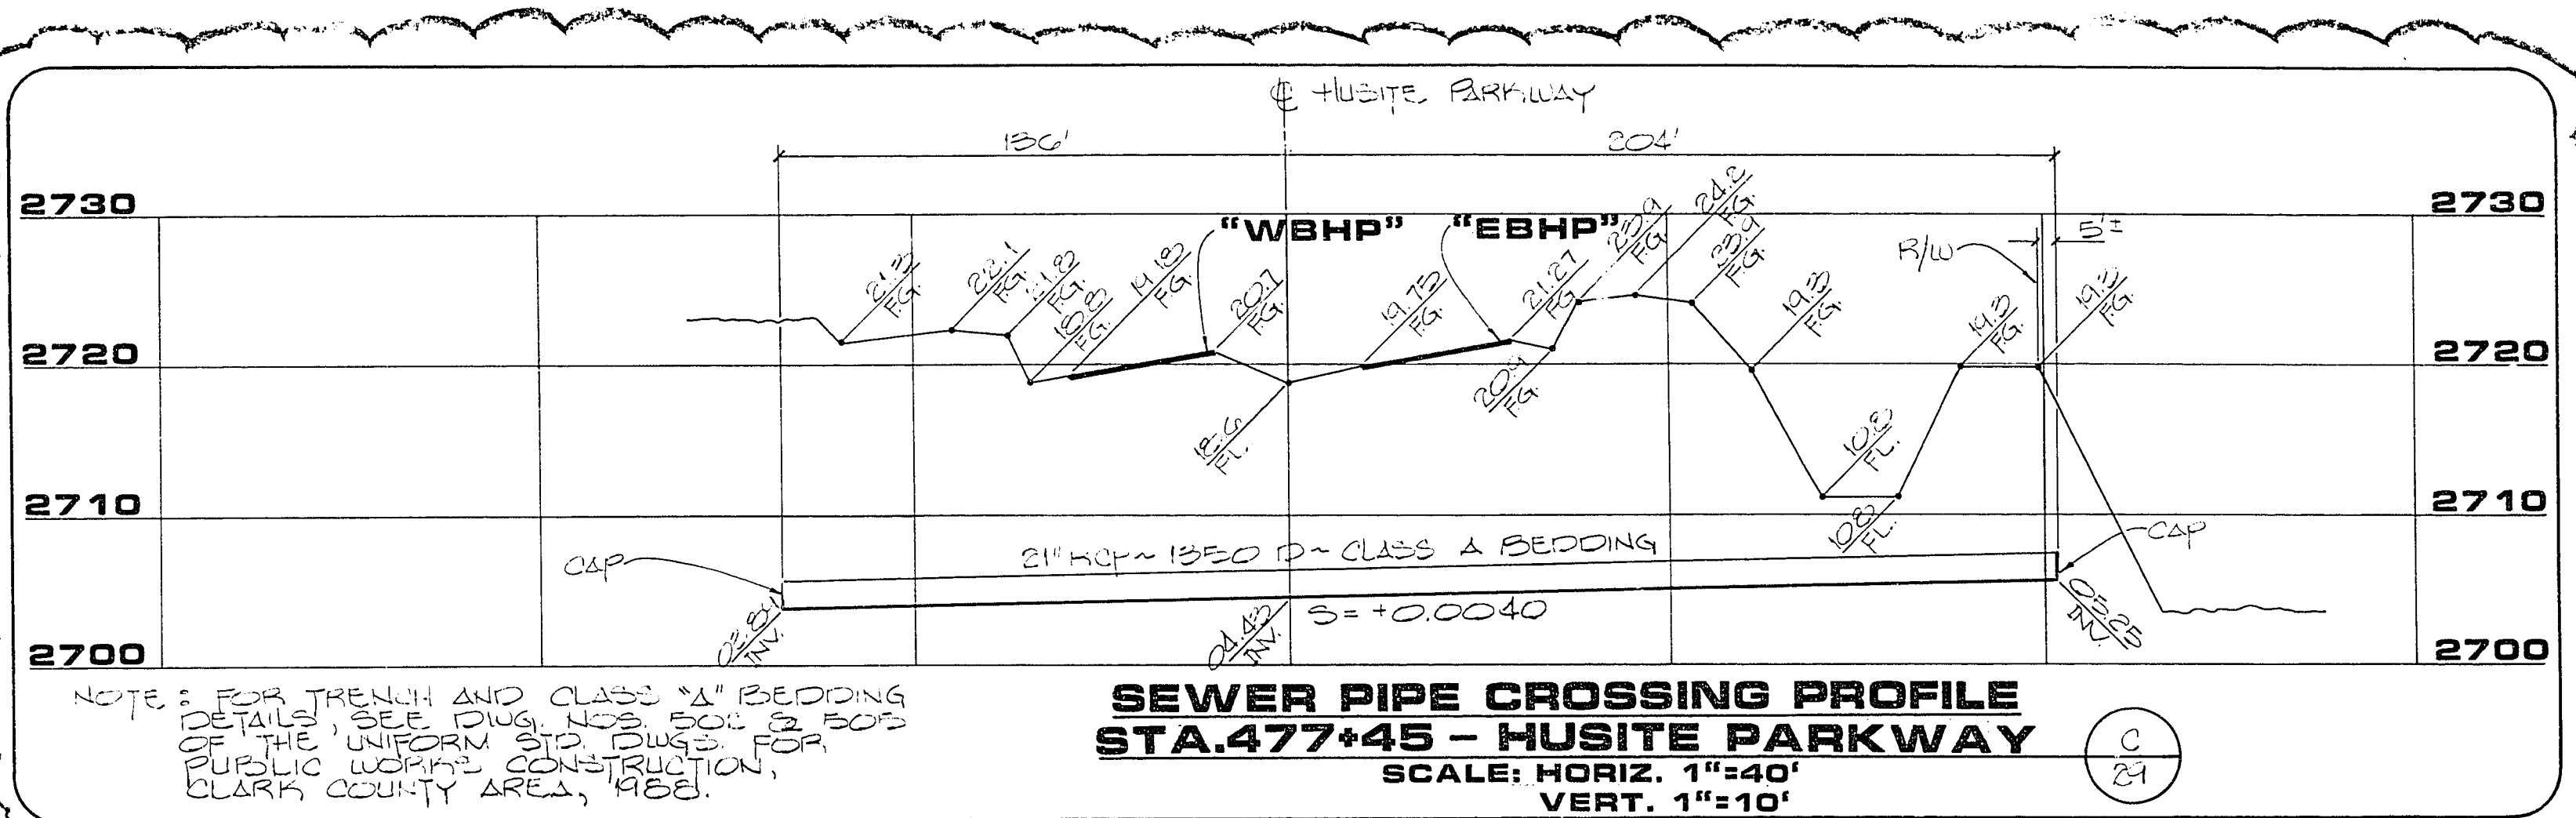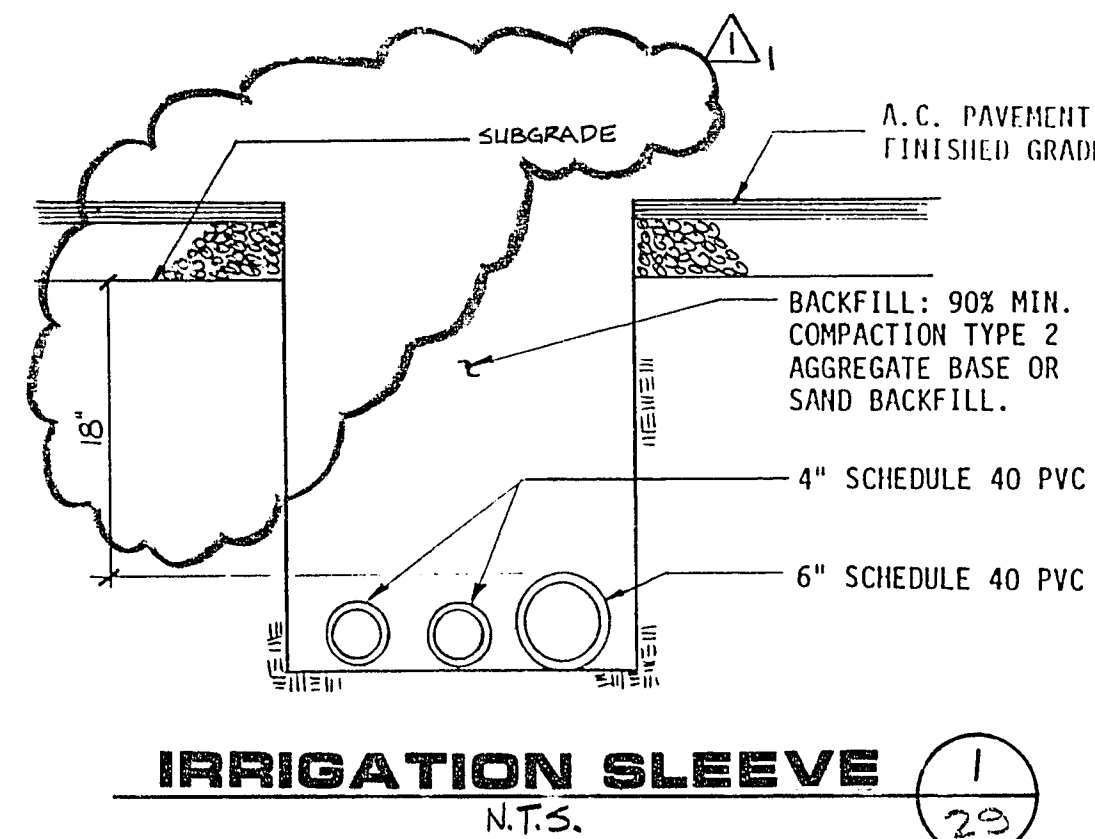


REV	DATE	DESCRIPTION
1	1/1/88	ISSUED FOR GMP
2	1/1/88	ISSUED FOR ADDENDUM NO. 1
3	1/1/88	ISSUED FOR CONSTRUCTION
4	1/1/88	ISSUE PER A.C.M. LETTER
5	1/1/88	ISSUE PER A.C.M. LETTER

RECOMMENDED:
DATE: 1/1/88
BY: [Signature]
CHECKED BY: [Signature]
DATE: 1/1/88
BY: [Signature]

1535 SOUTH RAINBOW BLVD. LAS VEGAS, NEVADA 89102

G.C. WALLACE, INC.
Engineering/Architecture

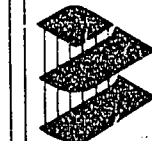

HOWARD HUGHES PROPERTIES
HUSITE PARKWAY

SEWER PIPE CROSSING PROFILES & DETAILS

SHEET
29

N/A
CLV CHIEF LAND DEVELOPMENT

DATE

OF 3 SHEETS

6-3-78

107-11571