

AS BUILT

BASIS OF BEARING



CONTROL MONUMENTS 208, 209 AND 211 AS SHOWN ON THAT CERTAIN MAP ON FILE IN THE CLARK COUNTY RECORDER'S OFFICE, IN FILE 92, PAGE 42 OF SURVEYS

Call before you Dig.
1-702-593-6111

Call before you Dig.
1-800-227-2800

TRAFFIC LEGEND

- 9" D3 STREET NAME SIGN (PER STD DWG 250)
- 30" STOP SIGN (R1-1) LOCATE AT BCR
- BLUE REFLECTIVE MARKER
- STREET SIGN AS NOTED PER PLAN

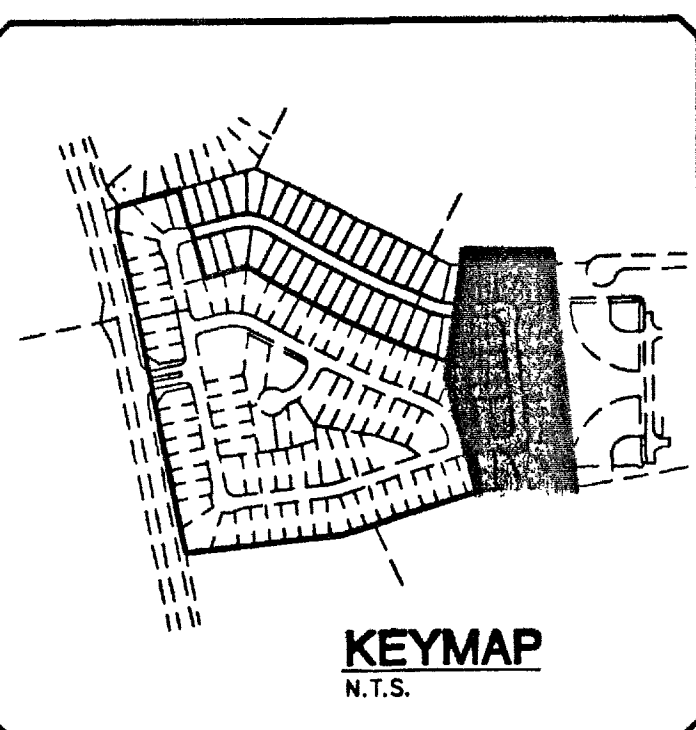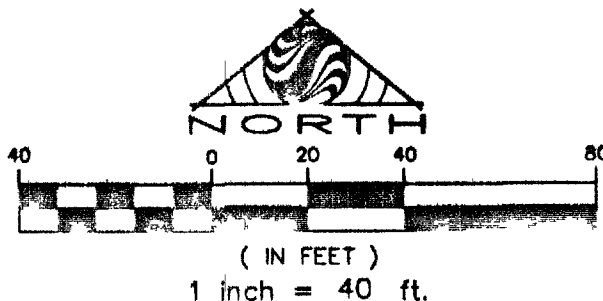

NOTE:
ADD 3100 TO ALL ELEVATIONS




SEE SHEET 2 FOR ABBREVIATIONS, LEGENDS AND ENGINEERS ESTIMATE OF QUANTITIES

REDUCED PRESSURE PRINCIPLE ASSEMBLY (1")

Approved Reduced Pressure Principle Assembly shall be installed per UDACS Plate No. 11A. No water shall be taken from service requiring backflow prevention until the Approved Reduced Pressure Principle Assembly has been successfully tested by the LVVWD.

Any block wall or other fence material shall be designed and constructed around the outside of the easements(s) to allow the District direct access from the adjacent right-of-way.

Easement shall be clearly marked or staked prior to the start of construction.

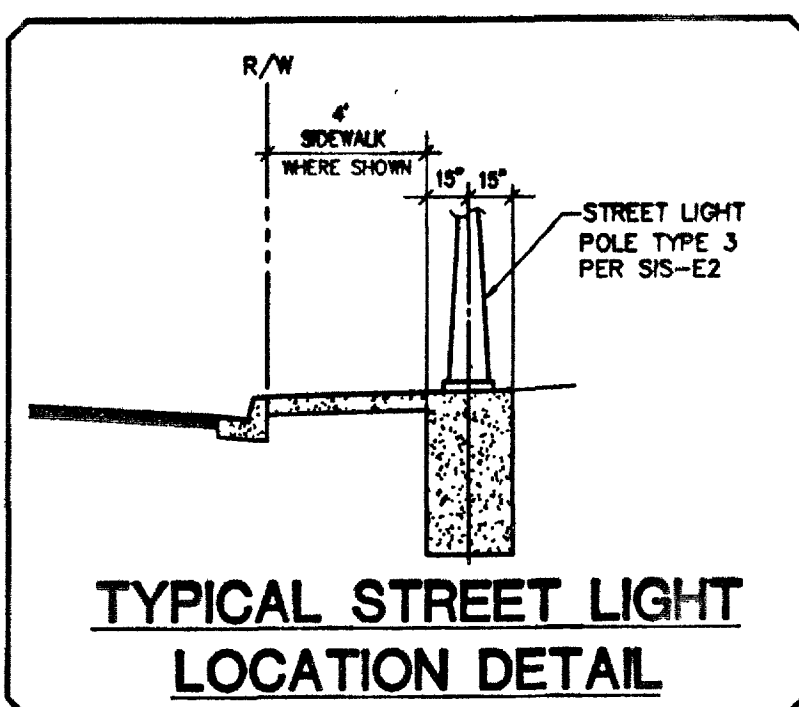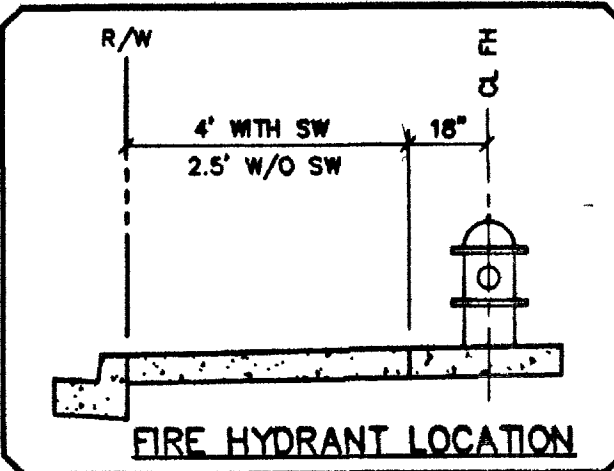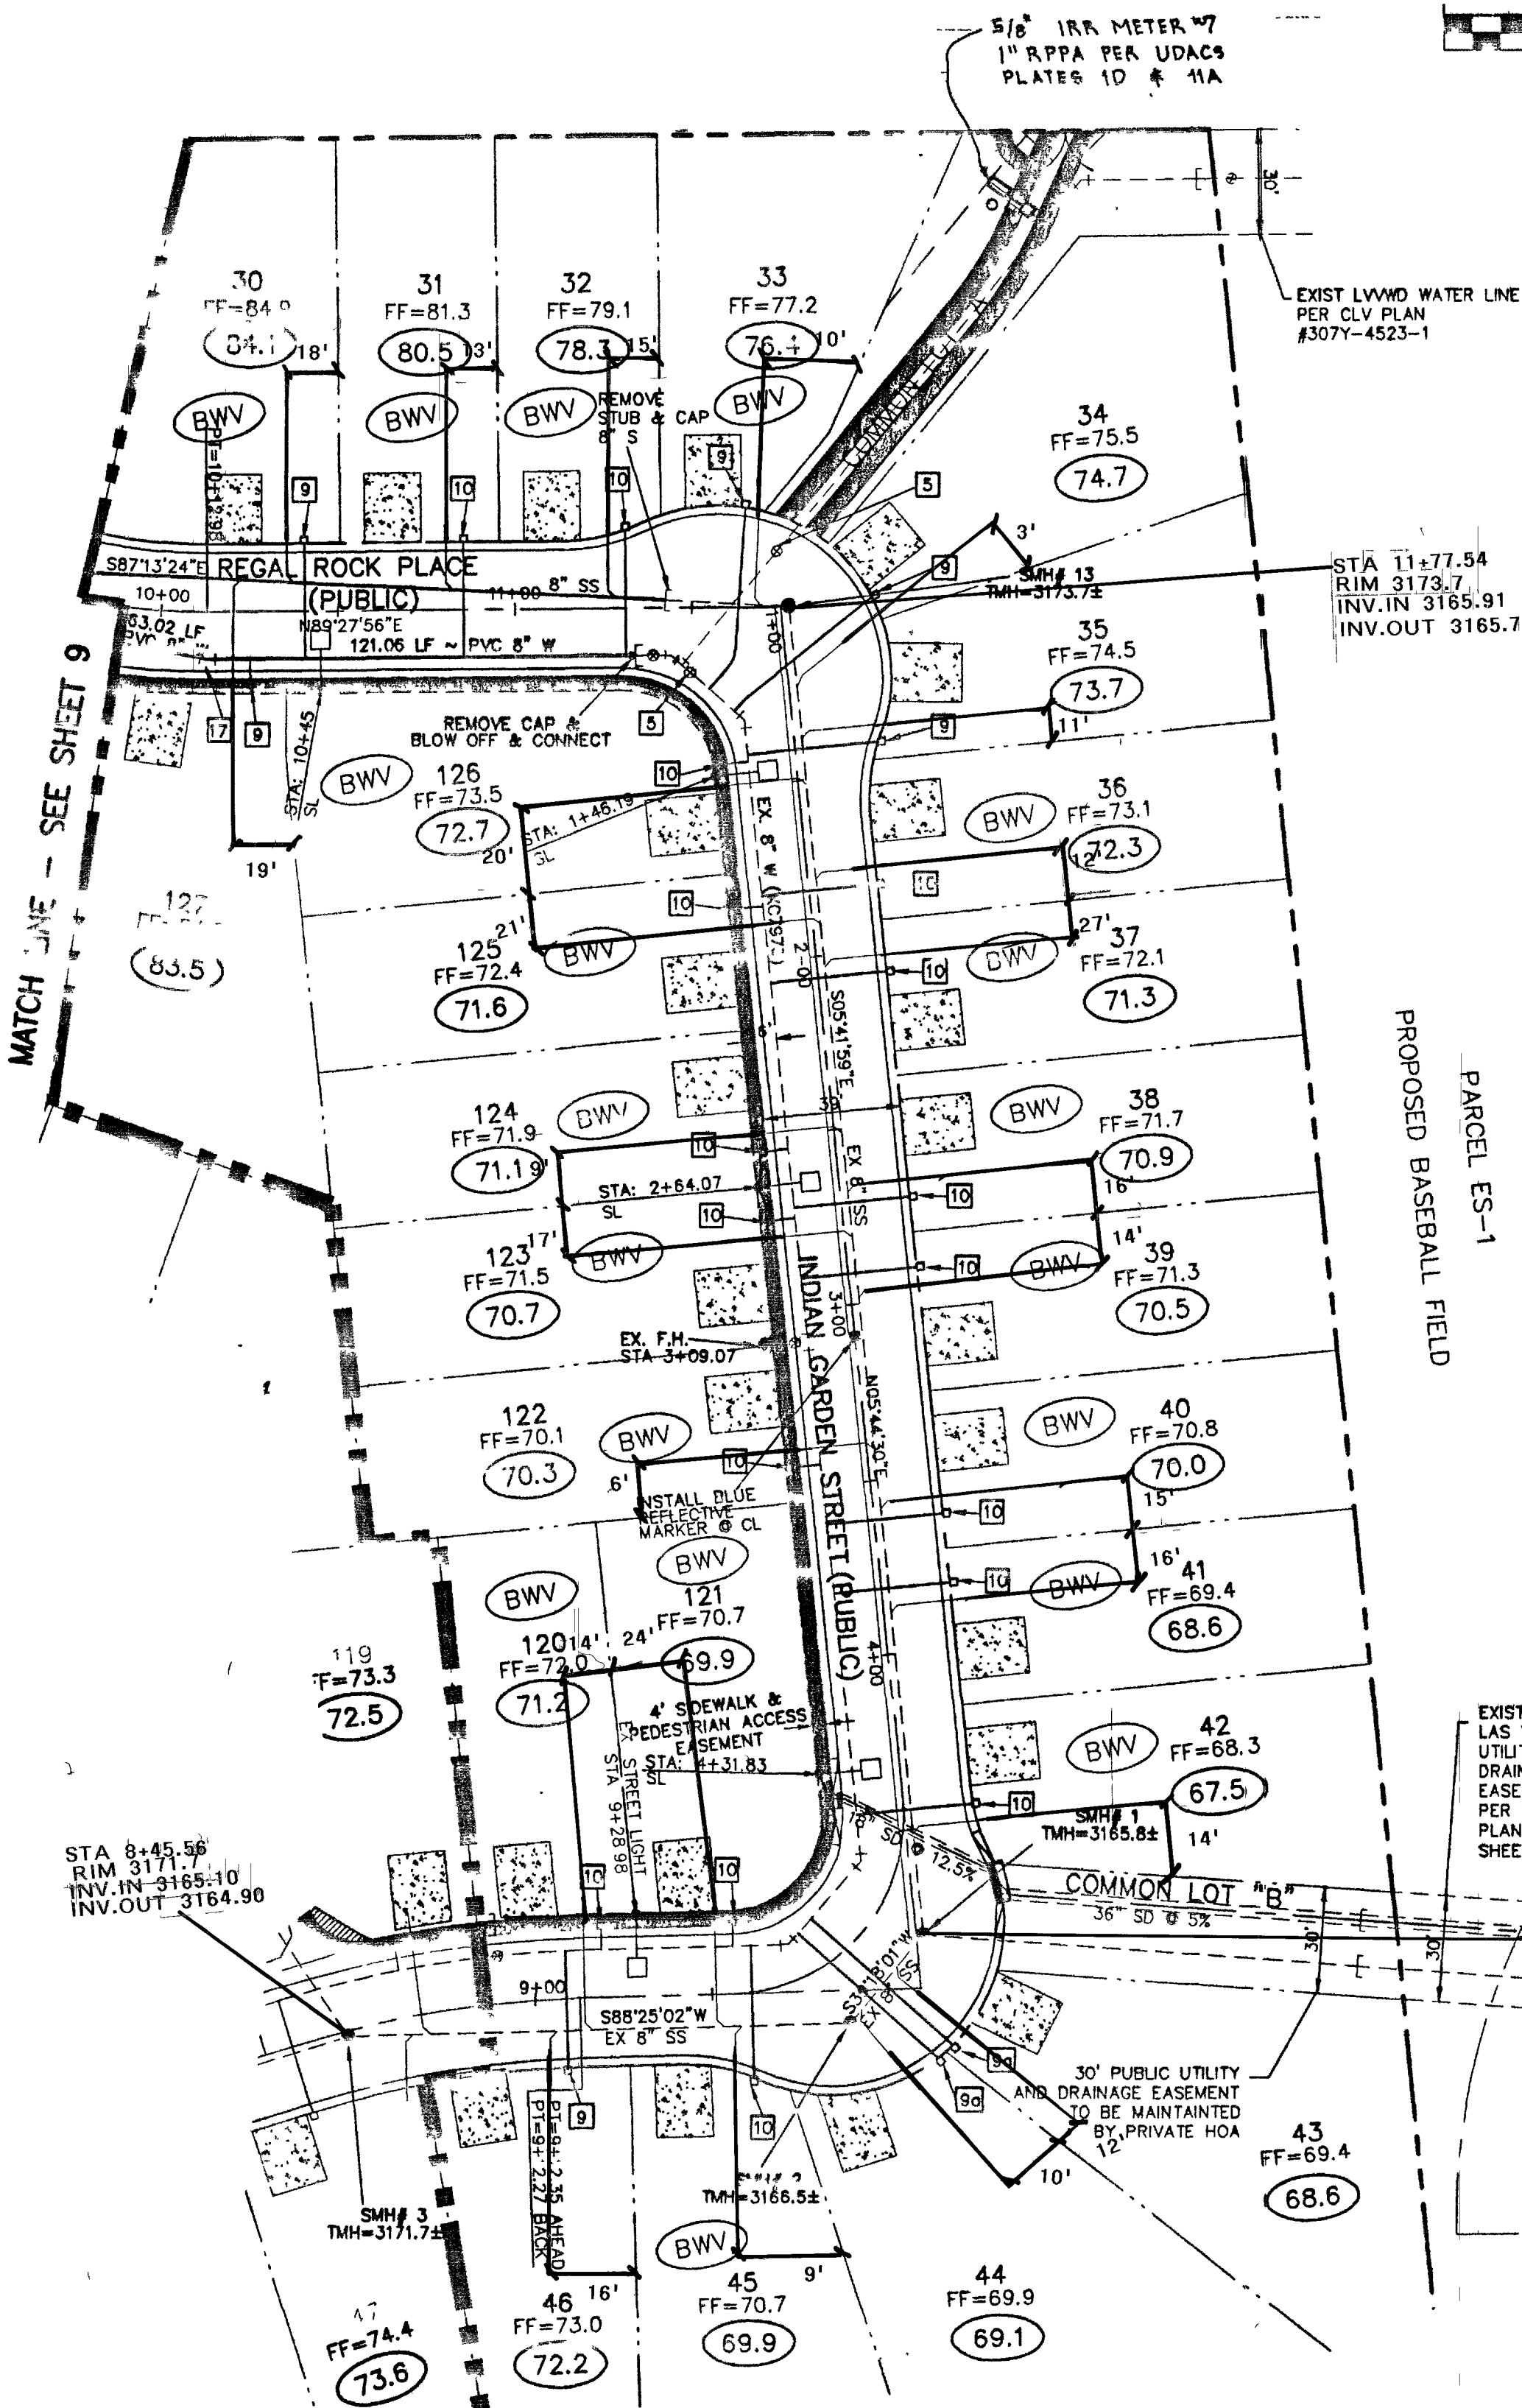

APPROVALS

CITY FIRE MARSHAL
LAS VEGAS VALLEY WATER DISTRICT

5/19/03
5/29/03

BASIS OF BEARING

CONTROL MONUMENTS 208, 209 AND 211 AS SHOWN ON THAT CERTAIN MAP ON FILE IN THE CLARK COUNTY RECORDER'S OFFICE, IN FILE 92, PAGE 42 OF SURVEYS

TRAFFIC LEGEND

- 9" D3 STREET NAME SIGN (PER STD DWG 250)
- 30" STOP SIGN (R1-1) LOCATE AT BCR
- BLUE REFLECTIVE MARKER
- STREET SIGN AS NOTED PER PLAN

SEWER FLOW CALCS


DAILY AVERAGE FLOW = 0.015 MGD
PEAK FLOW = 0.044 MGD

NO.	DESCRIPTION	DATE	APP'D
1	DESIGNED BY: S. YOUNGBERG	5/13/2003	
2	DRAWN BY: SES		
3	DESIGNED BY: RPS		
4	CHECKED BY: RWC		
5	ADA CHECKED: 88147032		
6	JOB NO.: 88147032		
7	SCALE: AS NOTED		

Starline Consulting Inc.
7201 West Charleston Blvd.
Las Vegas, NV 89115
Tel: 702.258.0115
Fax: 702.258.4956
www.starline.com

Pulte Homes
1993 VILLAGE CENTER CIRCLE, SUITE 250
LAS VEGAS, NEVADA 89134
(702) 258-7900

HILLSTONE AT THE SUMMERLIN VISTAS - UNIT 2 -
UTILITY & TRAFFIC PLAN AS BUILT

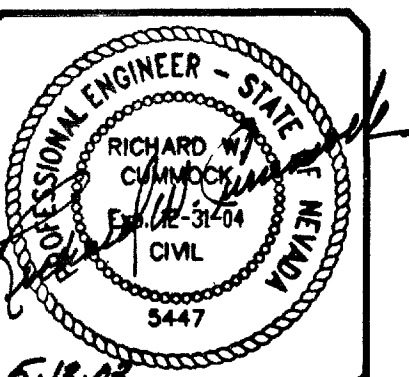

SHEET 10 of 10
C.L.V. DWG # 16744723-2