


CHEYENNE AVENUE

OUTER PARKWAY

DEL WEBB COMMUNITIES

DESERT SHORES

SUN CITY SUMMERLIN

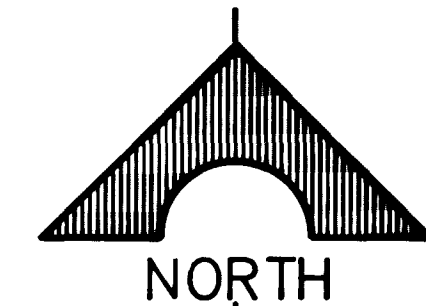

SCALE: 1"=1000'

SMOKE RANCH ROAD

LUCE RES.

SHEET LAYOUT

HILLS CENTER DRIVE  
SHT. 1-1  
SHT. 1-2  
SHT. 1-3  
SHT. 1-4

LAKE MEAD

BLVD.

DRIVE

HIGHWAY

VILLAGE 7

VILLAGE 1

TOWN CENTER DRIVE  
PHASE II

VILLAGE CENTER CIRCLE

VEGAS DRIVE

BUFFALO

ORAN K. GRAGSON

U. S. 95

TOWN CENTER DRIVE

RAMPART BLVD.

ANGEL PARK

DURANGO DRIVE

SUMMERLIN PARKWAY

WESTCLIFF DR.

RAINBOW BLVD.

RECORD DRAWINGS  
THESE PLANS SHOW RECORD INFORMATION RECEIVED FROM:  
CONTRACTOR: WELLS CARGO INC.  
DATE: 6/19/90  
THIS DATA MAY OR MAY NOT REFLECT THE ACTUAL FIELD LOCATIONS. ALL DATA SHOULD BE CONFIRMED PRIOR TO USE ON DEVELOPMENT OR ENGINEERING PLANS.


ANGEL PARK

NOTE: THESE PLANS ARE FOR THE PURPOSE OF ROADWAY IMPROVEMENTS AND UTILITIES (PAVEMENT WITH BASE, CURB AND GUTTER, STORM DRAIN, WATER, SEWER, ETC.). ALL ROADWAY AND LANDSCAPE AREAS HAVE BEEN PREVIOUSLY ROUGH GRADED. ANY LIMITS OF ROUGH GRADING SHOWN ARE FOR REFERENCE ONLY. FOR SCOPE AND LIMITS OF ROUGH GRADING, SEE "TOWN CENTER DRIVE - ROUGH GRADING" PACKAGE. FOR FINISH GRADING OF LANDSCAPE AREAS, SEE LANDSCAPE PACKAGE BY SMA GROUP.

CHARLESTON BLVD.

LIST OF DRAWINGS

- I-0 KEY MAP, VICINITY MAP AND LIST OF DRAWINGS
- I-1 PLAN & PROFILE STA. 51+56.60 TO 59+00.00
- I-2 PLAN & PROFILE STA. 59+00.00 TO 71+00.00
- I-3 PLAN & PROFILE STA. 71+00.00 TO 83+00.00
- I-4 PLAN & PROFILE STA. 83+00.00 TO 93+09.79
- I-5 STREET INTERSECTIONS
- I-6 STREET SECTIONS AND DETAILS
- I-7 STORM DRAIN NOTES, LATERALS AND DETAILS
- I-8 STORM DRAIN LATERALS
- I-9 STORM DRAIN DETAILS
- I-10 STORM DRAIN DETAILS
- I-11 TEMPORARY DRAINAGE CHANNEL & STORM DRAIN LATERALS

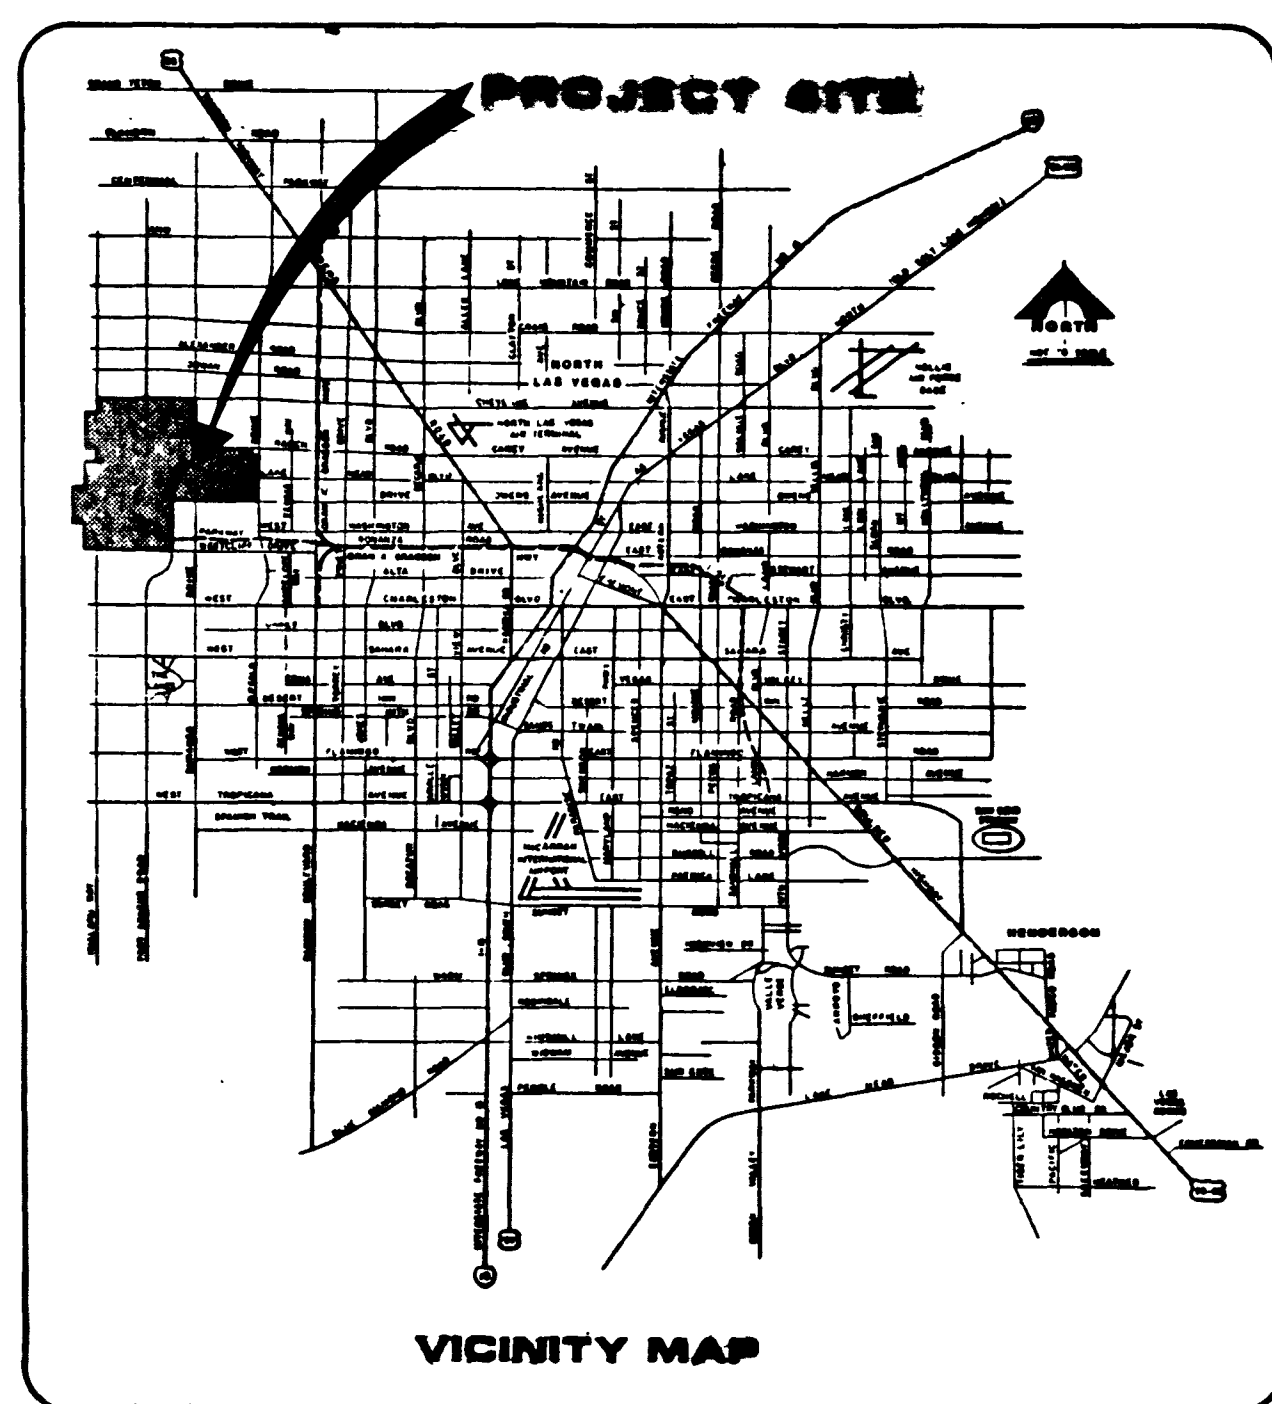

VICINITY MAP

REV	DATE	DESCRIPTION
1	6/19/90	ISSUED FOR BID
2	7/10/90	REVISIONS FOR CONSTRUCTION
3	7/10/90	RECORD DRAWINGS

RECORDED & RETURNED TO ARCHITECT  
 6638  
 RFE NO. 1000  
 CIVIL  
 G.C. WALLACE, INC.  
 Engineering/Architecture  
 1555 SOUTH RAINBOW BLVD., LAS VEGAS, NEVADA 89102

HOWARD HUGHES PROPERTIES  
 HILLS CENTER DRIVE  
 KEY MAP, VICINITY MAP  
 AND LIST OF DRAWINGS

SHEET 3

10

OF 23 SHEETS

2/12/89

JOB NO. 660.000

504 DIETRICH-POST 8280

2001

11-5-83 107-V1639-1

