

SUN CITY SUMMERLIN

DEL WEBB BLVD.

RECORD DRAWINGS
 THESE PLANS SHOW RECORD INFORMATION RECEIVED FROM:
 CONTRACTOR: WELLS CARGO INC.
 DATE: 6/19/90
 THIS DATA MAY OR MAY NOT REFLECT THE ACTUAL FIELD LOCATIONS. ALL DATA SHOULD BE CONFIRMED PRIOR TO USE ON DEVELOPMENT OR ENGINEERING PLANS.

FOR PLAN DETAILS OF 60" RCP SEE SHT. I-11; FOR PROFILE SEE 2/I-17

FOR PLAN DETAILS OF 36" RCP SEE SHT. I-11; FOR PROFILE SEE 2/I-17

SCALE: 1"=40'

NOTE: THESE PLANS ARE FOR THE PURPOSE OF ROADWAY IMPROVEMENTS AND UTILITIES (PAVEMENT WITH BASE, CURB AND GUTTER, STORM DRAIN, WATER, SEWER, ETC.). ALL ROADWAY AND LANDSCAPE AREAS HAVE BEEN PREVIOUSLY ROUGH GRADED. ANY LIMITS OF ROUGH GRADING SHOWN ARE FOR REFERENCE ONLY. FOR SCOPE AND LIMITS OF ROUGH GRADING, SEE "TOWN CENTER DRIVE - ROUGH GRADING" PACKAGE. FOR FINISH GRADING OF LANDSCAPE AREAS, SEE LANDSCAPE PACKAGE BY SMA GROUP.

BCR CURVE DATA

| CURVE | DELTA | RADIUS | LENGTH | TANGENT |
|-------|------------|---------|--------|---------|
| 1 | 10°59'17" | 300.00' | 57.53' | 28.86' |
| 2 | 180°00'00" | 2.83' | 8.89' | |
| 3 | 90°00'00" | 30.00' | 47.12' | 30.00' |

MATCH LINE = 59+00.00
SEE SHEET I-2

BEGIN CONSTRUCTION 51+56.60

FILL DITCH 51+56.60

HILLS CENTER DR.
 52+34.10 DI #1A-U
 5A 326+43.86 DI #1A-N
 I-7 326+43.86 DI #1A-N
 I-7 326+43.86 DI #1A-N



EXISTING IMPROVEMENTS

SEE DETAIL I-5 FOR INTERSECTION DETAIL

LAKE MEAD BLVD.

VILLAGE 1

VILLAGE 7

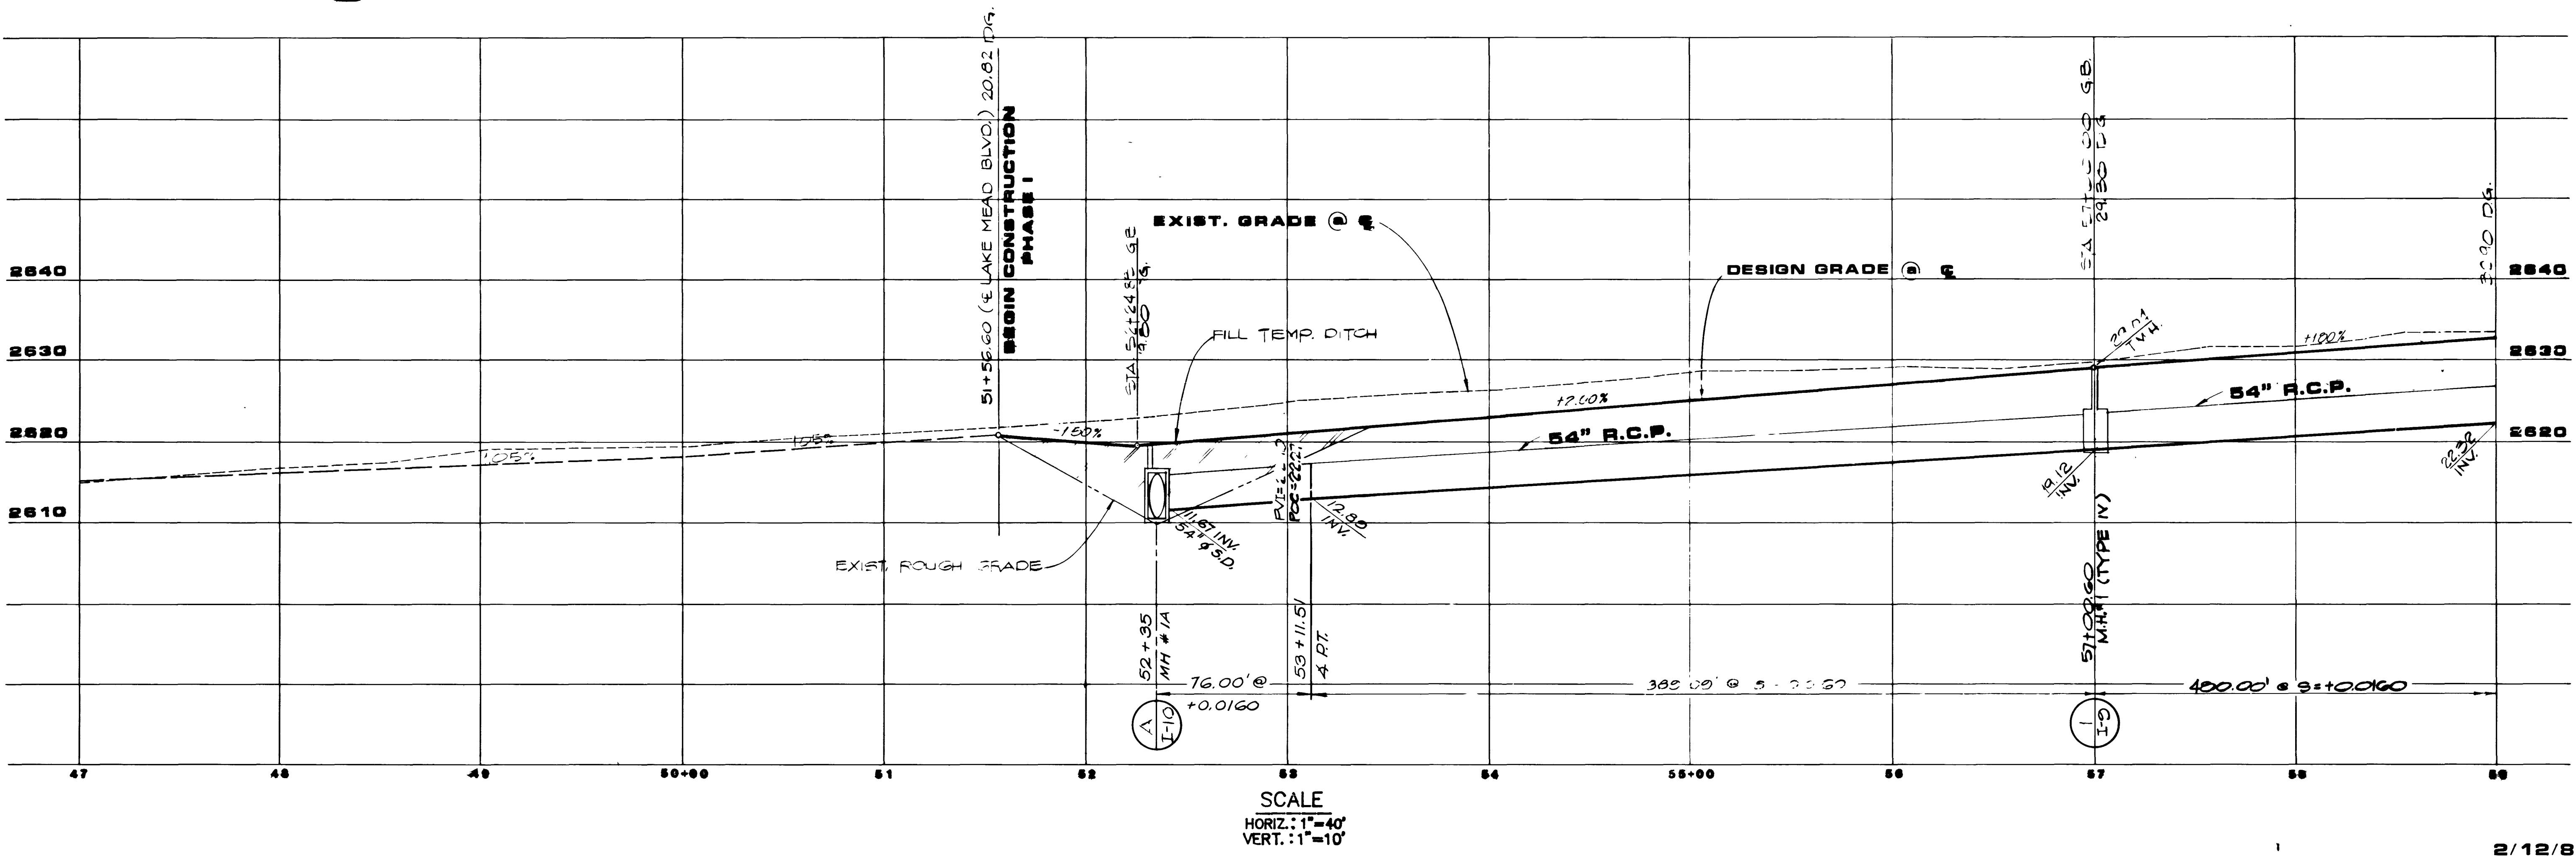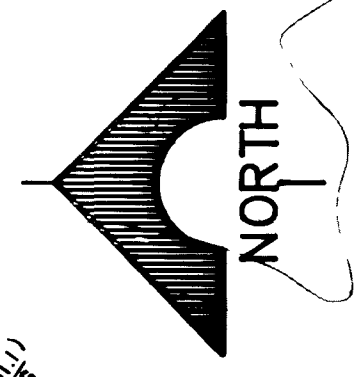

SCALE
HORIZ.: 1"=40'
VERT.: 1"=10'

61980 RECORD DRAWINGS

| REV | DATE | DESCRIPTION |
|-----|---------|-------------------------|
| 1 | 6/19/90 | ISSUED FOR BID |
| 2 | 6/19/90 | ISSUED FOR CONSTRUCTION |
| 3 | 6/19/90 | ENTERED PER G.W. LETTER |
| 4 | 6/19/90 | ENTERED PER G.W. LETTER |
| 5 | 6/19/90 | REVISION |

RECEIVED BY: [Signature]



DATE: 6/19/90

PROJECT: HOWARD HUGHES PROPERTIES
 HILLS CENTER DRIVE
 PLAN & PROFILE
 STA. 51+56.60 TO STA. 59+00.00

G.C. WALLACE, INC.
 Engineering/Architecture

SHEET 4
 OF 23 SHEETS

2/12/89

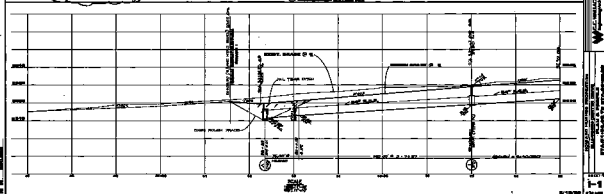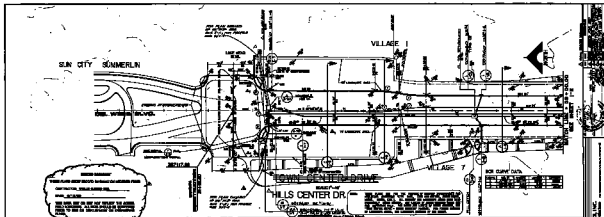

1:200

1/4" = 100'

DESIGNED BY: [Faded text]
 CHECKED BY: [Faded text]
 DATE: [Faded text]