


SCALE: 1"=40'

NOTE: THESE PLANS ARE FOR THE PURPOSE OF ROADWAY IMPROVEMENTS AND UTILITIES (PAVEMENT WITH BASE, CURB AND GUTTER, STORM DRAIN, WATER, SEWER, ETC.). ALL ROADWAY AND LANDSCAPE AREAS HAVE BEEN PREVIOUSLY ROUGH GRADED. ANY LIMITS OF ROUGH GRADING SHOWN ARE FOR REFERENCE ONLY. FOR SCOPE AND LIMITS OF ROUGH GRADING, SEE "TOWN CENTER DRIVE - ROUGH GRADING" PACKAGE. FOR FINISH GRADING OF LANDSCAPE AREAS, SEE LANDSCAPE PACKAGE BY SMA GROUP.

BCR CURVE DATA

CURVE NO.	DELTA	RADIUS	LENGTH	TANGENT
1	90°00'00"	1.00'	1.57'	
2				
3				
4				
5				
6	03°25'07"	5991.67'	357.50'	178.80'
7	03°25'07"	6000.00'	358.00'	179.05'
8	03°25'07"	6008.33'	358.50'	179.30'
9	03°25'07"	6035.00'	360.09'	180.10'
10	03°25'07"	5965.00'	355.91'	178.00'

RECORD DRAWINGS  
 THESE PLANS SHOW RECORD INFORMATION RECEIVED FROM:  
 CONTRACTOR: \_\_\_\_\_  
 DATE: \_\_\_\_\_  
 THIS DATA MAY OR MAY NOT REFLECT THE ACTUAL FIELD LOCATIONS. ALL DATA SHOULD BE CONFIRMED PRIOR TO USE ON DEVELOPMENT OR ENGINEERING PLANS.

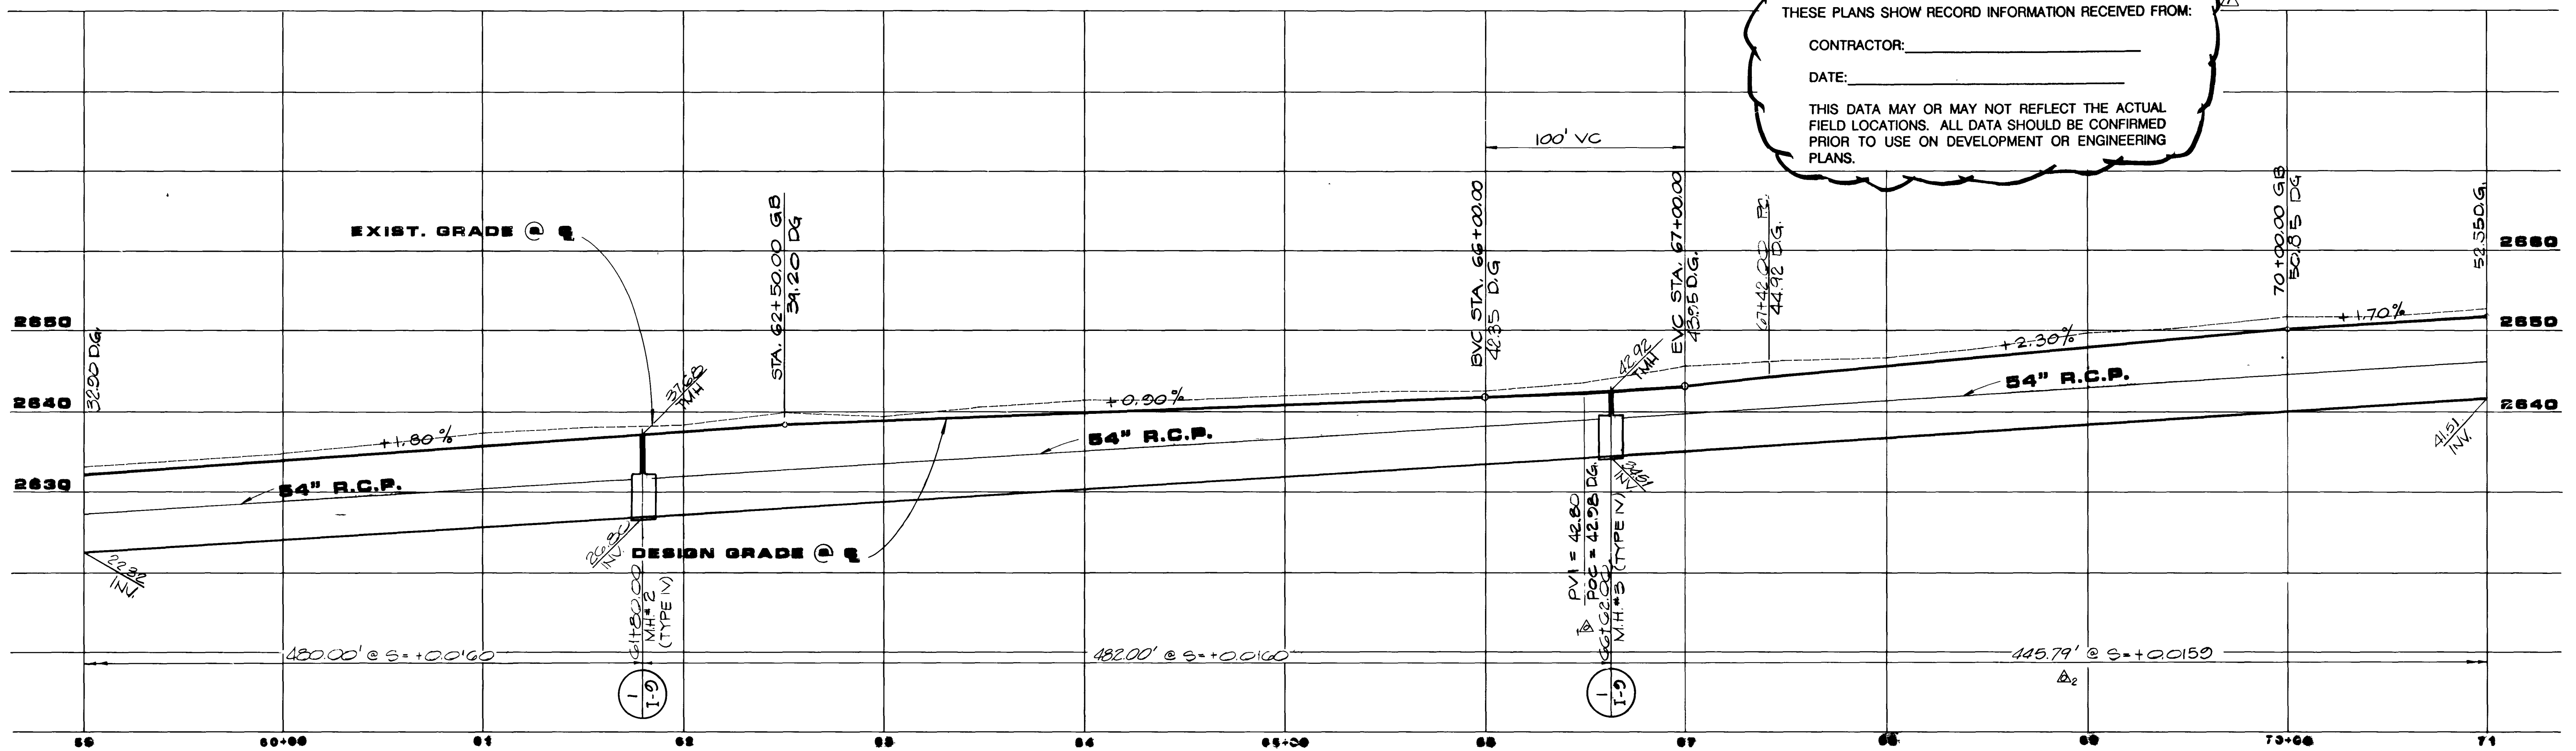

SCALE  
 HORIZ.: 1"=40'  
 VERT.: 1"=10'

REV.	DATE	DESCRIPTION
1	2/12/89	ISSUED FOR BID
2	2/12/89	ISSUED FOR CONSTRUCTION
3	2/12/89	ISSUED PER G.C.D. LETTER
4	2/12/89	ISSUED PER G.C.D. LETTER
5	2/12/89	RECORD DRAWINGS

G.C. WALLACE, INC.  
 Engineering/Architecture

HOWARD HUGHES PROPERTIES  
 HILLS TOWN CENTER DRIVE  
 PLAN & PROFILE  
 STA. 59+00.00 TO STA. 71+00.00

SHEET 5  
 OF 23 SHEETS

JOB NO. 880.888

1998

11-3-70

107-VI689-1

2/12/89

