


SEE SHEET 1-3
MATCH LINE - 83+00.00

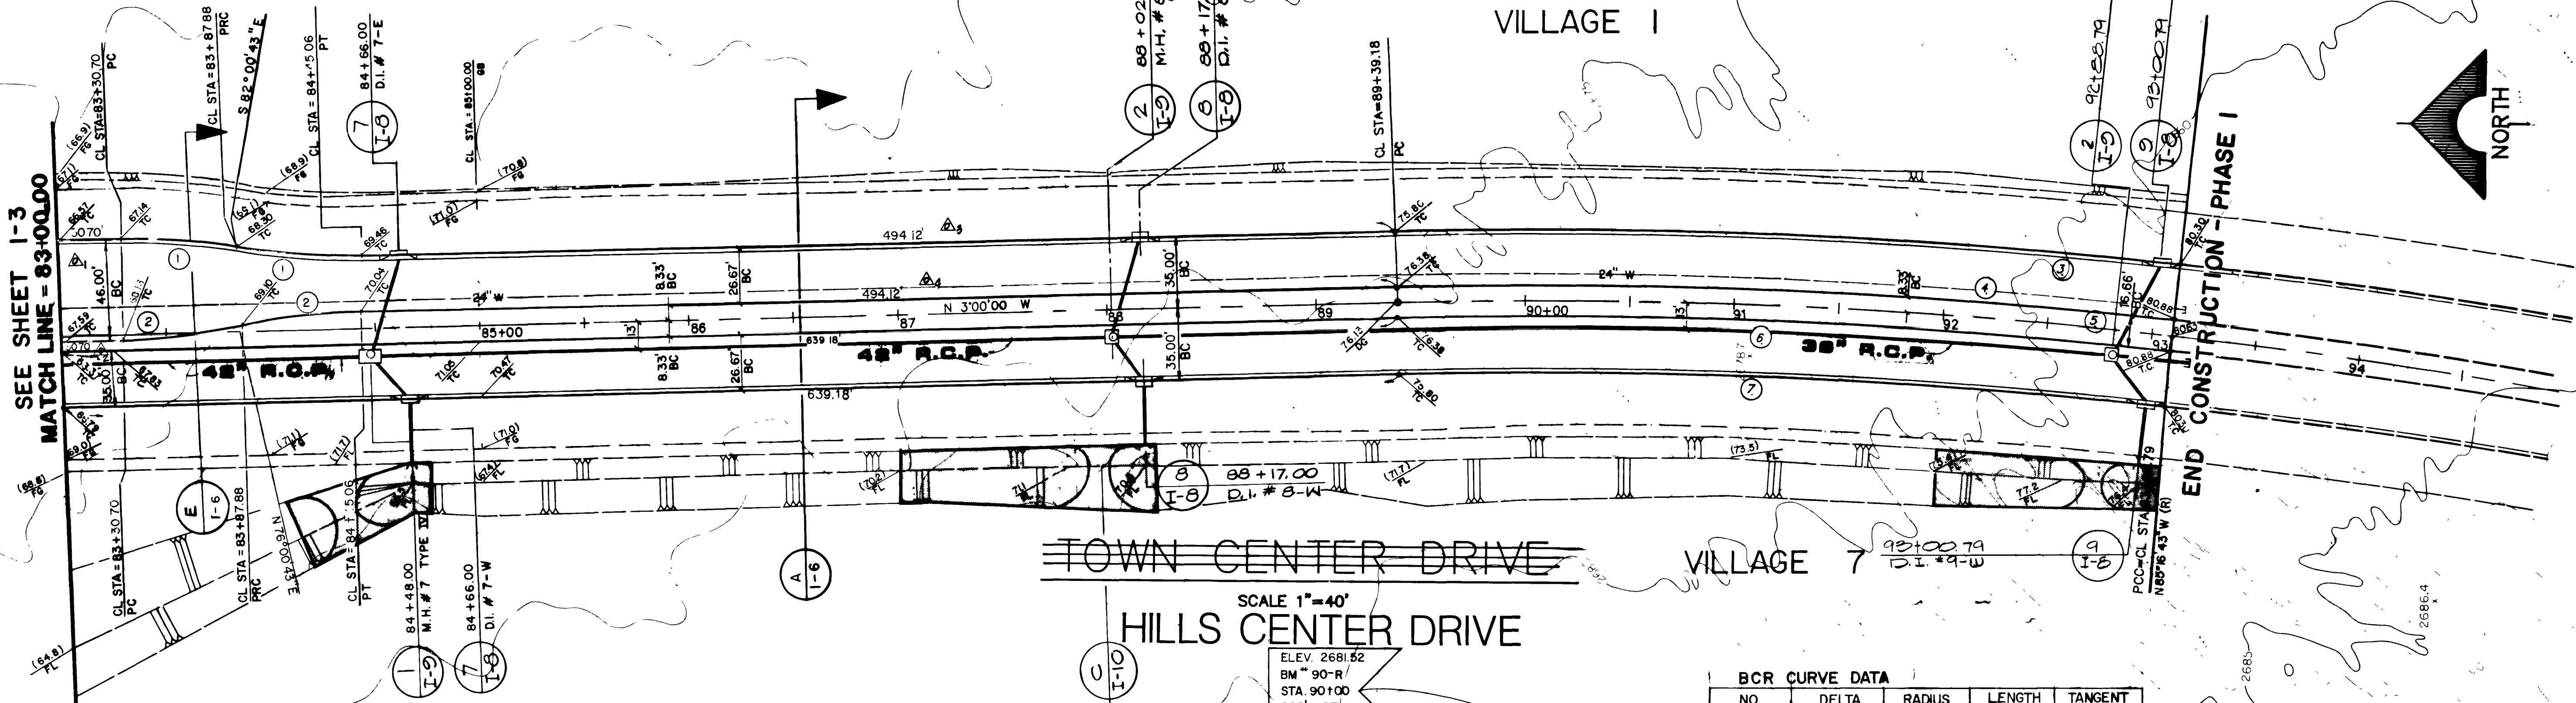

NOTE: THESE PLANS ARE FOR THE PURPOSE OF ROADWAY IMPROVEMENTS AND UTILITIES (PAVEMENT WITH BASE, CURB AND GUTTER, STORM DRAIN, WATER, SEWER, ETC.). ALL ROADWAY AND LANDSCAPE AREAS HAVE BEEN PREVIOUSLY ROUGH GRADED. ANY LIMITS OF ROUGH GRADING SHOWN ARE FOR REFERENCE ONLY. FOR SCOPE AND LIMITS OF ROUGH GRADING, SEE "TOWN CENTER DRIVE - ROUGH GRADING" PACKAGE. FOR FINISH GRADING OF LANDSCAPE AREAS, SEE LANDSCAPE PACKAGE BY SWA GROUP.


SCALE 1"=40'

ELEV 2681.52
BM * 90-R
STA. 90+00
200' I RT.
5/8" REBAR

BCR CURVE DATA

NO.	DELTA	RADIUS	LENGTH	TANGENT
1	10°59'17"	300.00'	57.53'	28.86'
2	10°59'17"	300.00'	57.53'	28.86'
3	07°43'18"	2785.00'	375.33'	187.95'
4	07°43'18"	2758.33'	371.73'	186.15'
5	07°43'18"	2750.00'	370.61'	185.57'
6	07°43'18"	2741.67'	369.49'	185.02'
7	07°43'18"	2745.00'	368.89'	184.22'

RECORD DRAWINGS
THESE PLANS SHOW RECORD INFORMATION RECEIVED FROM:
CONTRACTOR: WELLS CARGO INC.
DATE: 6/19/90
THIS DATA MAY OR MAY NOT REFLECT THE ACTUAL FIELD LOCATIONS. ALL DATA SHOULD BE CONFIRMED PRIOR TO USE ON DEVELOPMENT OR ENGINEERING PLANS.

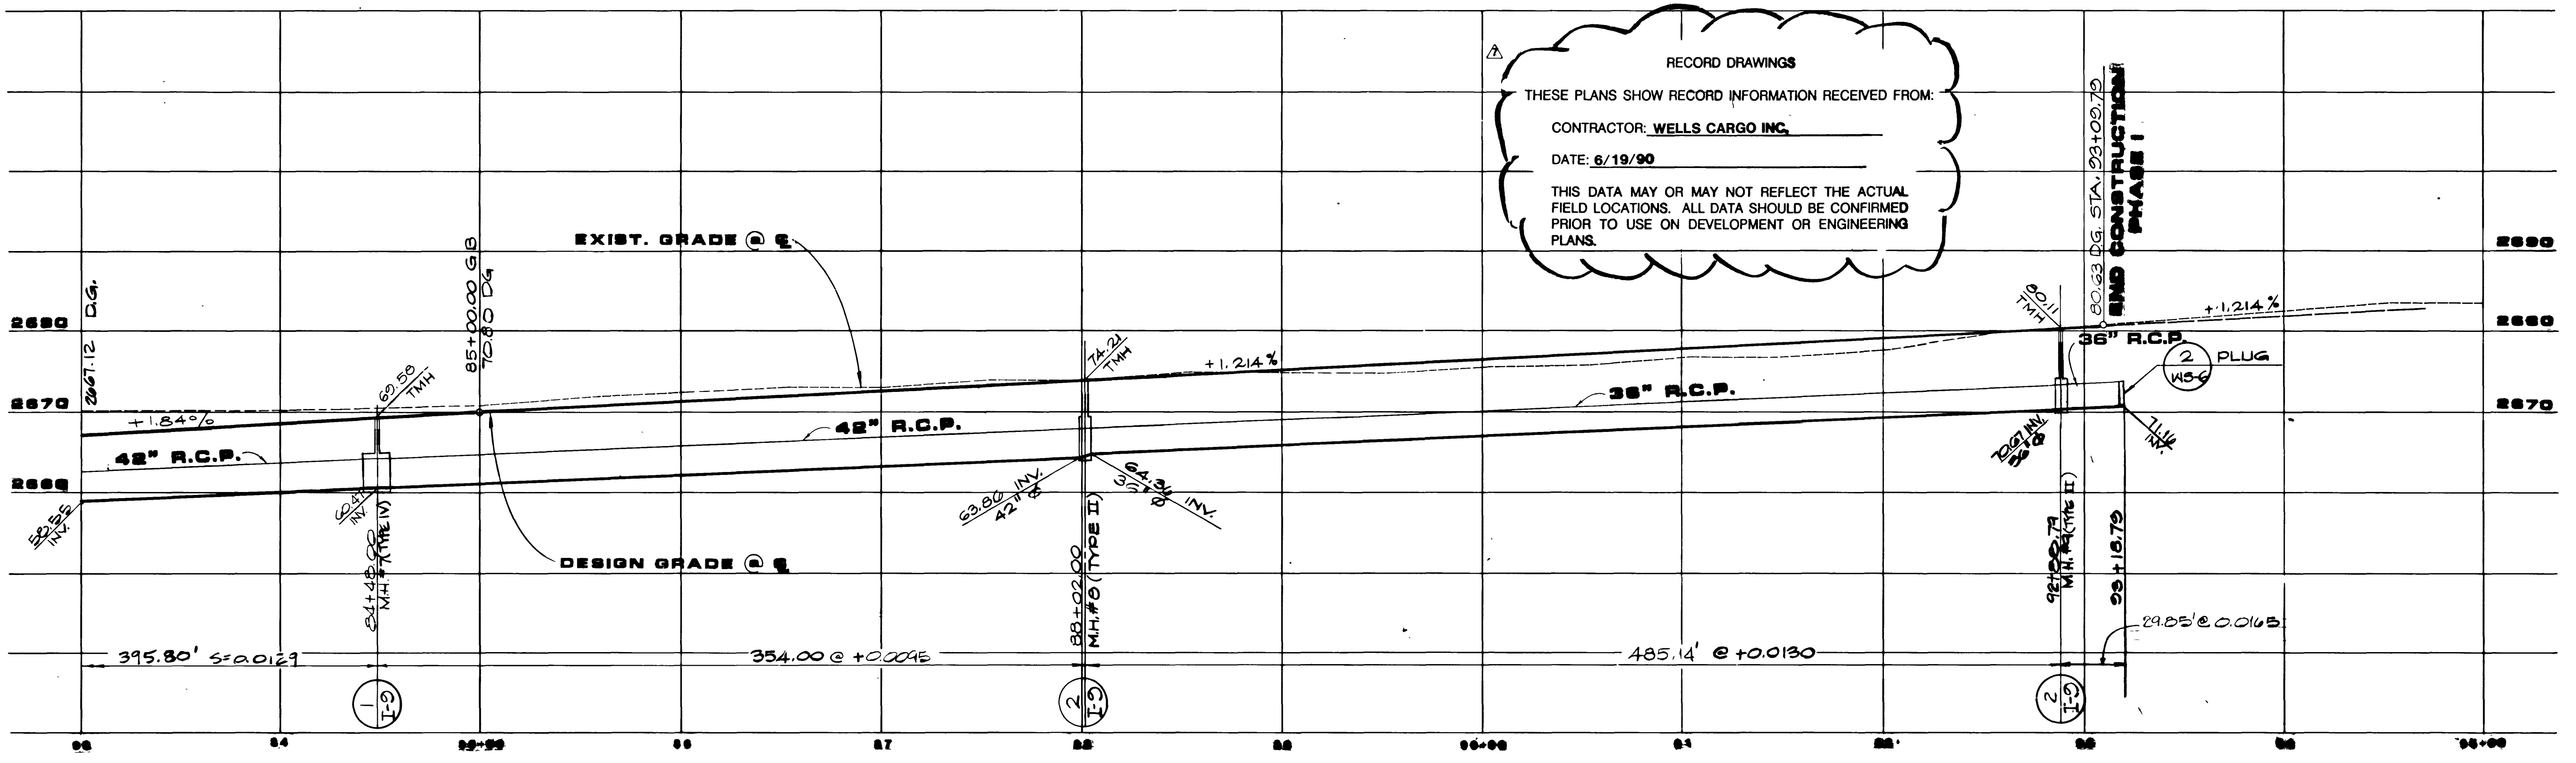

SCALE
HORIZ. : 1"=40'
VERT. : 1"=10'

REV	DATE	DESCRIPTION
1	6/19/90	ISSUED FOR BID
2	6/19/90	ISSUED FOR CONSTRUCTION
3	6/19/90	RECORD DRAWINGS

1555 SOUTH RAINBOW BLVD. LAS VEGAS, NEVADA 89102
G.C. WALLACE, INC.
Engineering/Architecture

MOWARD HUGHES PROPERTIES
HILLS-CORNER CENTER DRIVE
PLAN & PROFILE
SHEET 7 OF 23 SHEETS

2/12/89

JOB NO. 880.888

1996

11-384

107-V16394

