
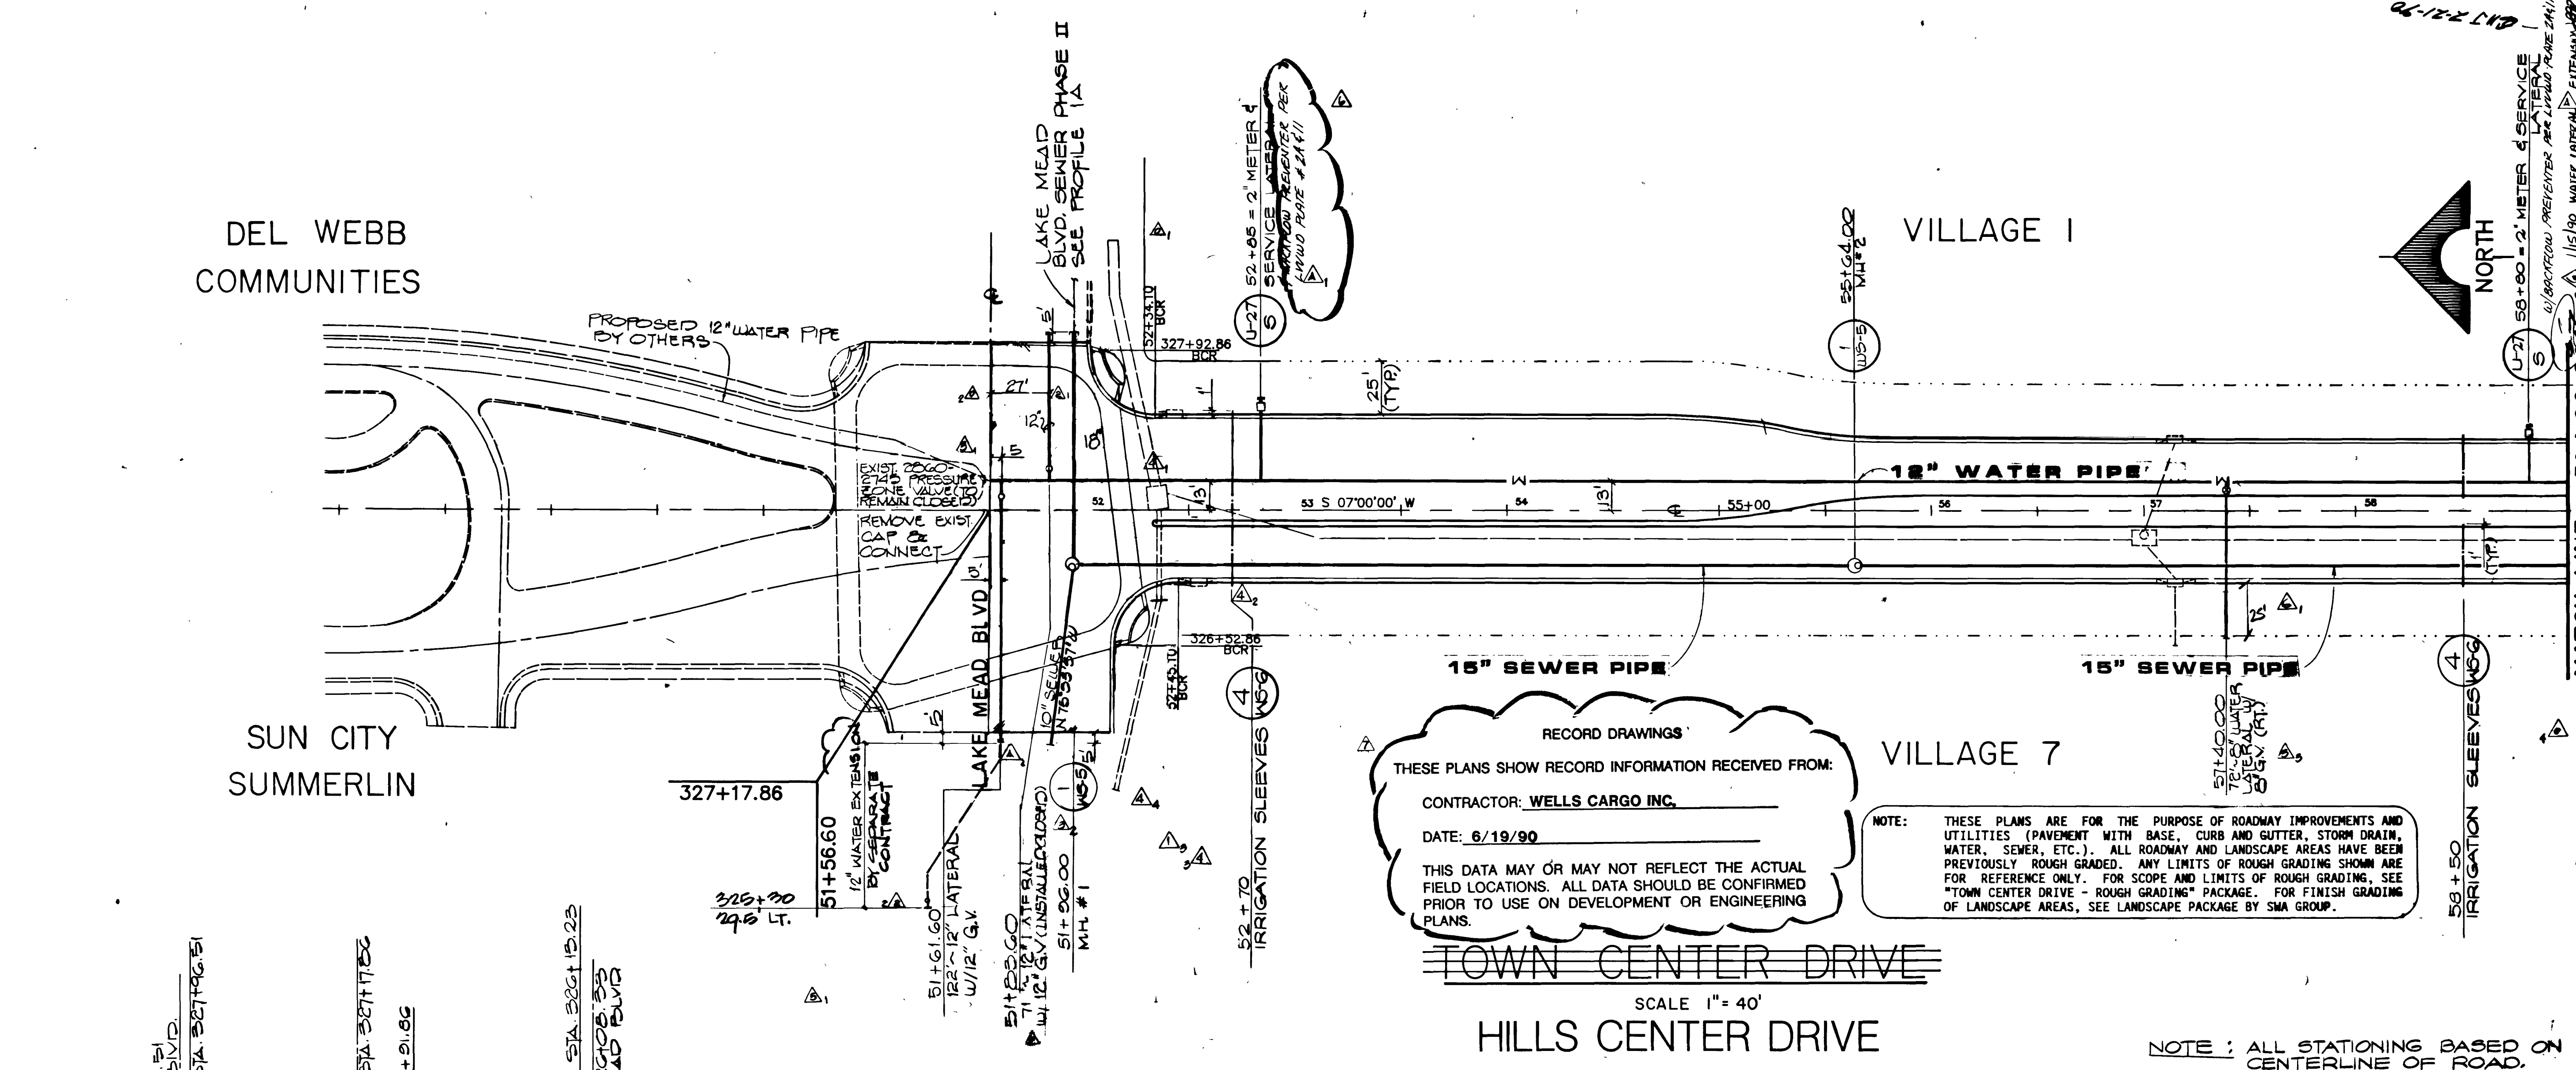


DEL WEBB COMMUNITIES

SUN CITY SUMMERLIN

VILLAGE I

VILLAGE 7

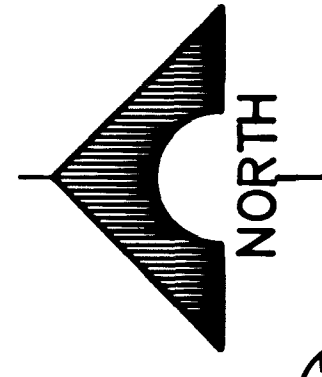


RECORD DRAWINGS
 THESE PLANS SHOW RECORD INFORMATION RECEIVED FROM:
 CONTRACTOR: WELLS CARGO INC.
 DATE: 6/19/90
 THIS DATA MAY OR MAY NOT REFLECT THE ACTUAL FIELD LOCATIONS. ALL DATA SHOULD BE CONFIRMED PRIOR TO USE ON DEVELOPMENT OR ENGINEERING PLANS.

NOTE: THESE PLANS ARE FOR THE PURPOSE OF ROADWAY IMPROVEMENTS AND UTILITIES (PAVEMENT WITH BASE, CURB AND GUTTER, STORM DRAIN, WATER, SEWER, ETC.). ALL ROADWAY AND LANDSCAPE AREAS HAVE BEEN PREVIOUSLY ROUGH GRADED. ANY LIMITS OF ROUGH GRADING SHOWN ARE FOR REFERENCE ONLY. FOR SCOPE AND LIMITS OF ROUGH GRADING, SEE "TOWN CENTER DRIVE - ROUGH GRADING" PACKAGE. FOR FINISH GRADING OF LANDSCAPE AREAS, SEE LANDSCAPE PACKAGE BY SMA GROUP.

TOWN CENTER DRIVE
 HILLS CENTER DRIVE
 SCALE 1" = 40'

NOTE: ALL STATIONING BASED ON CENTERLINE OF ROAD.

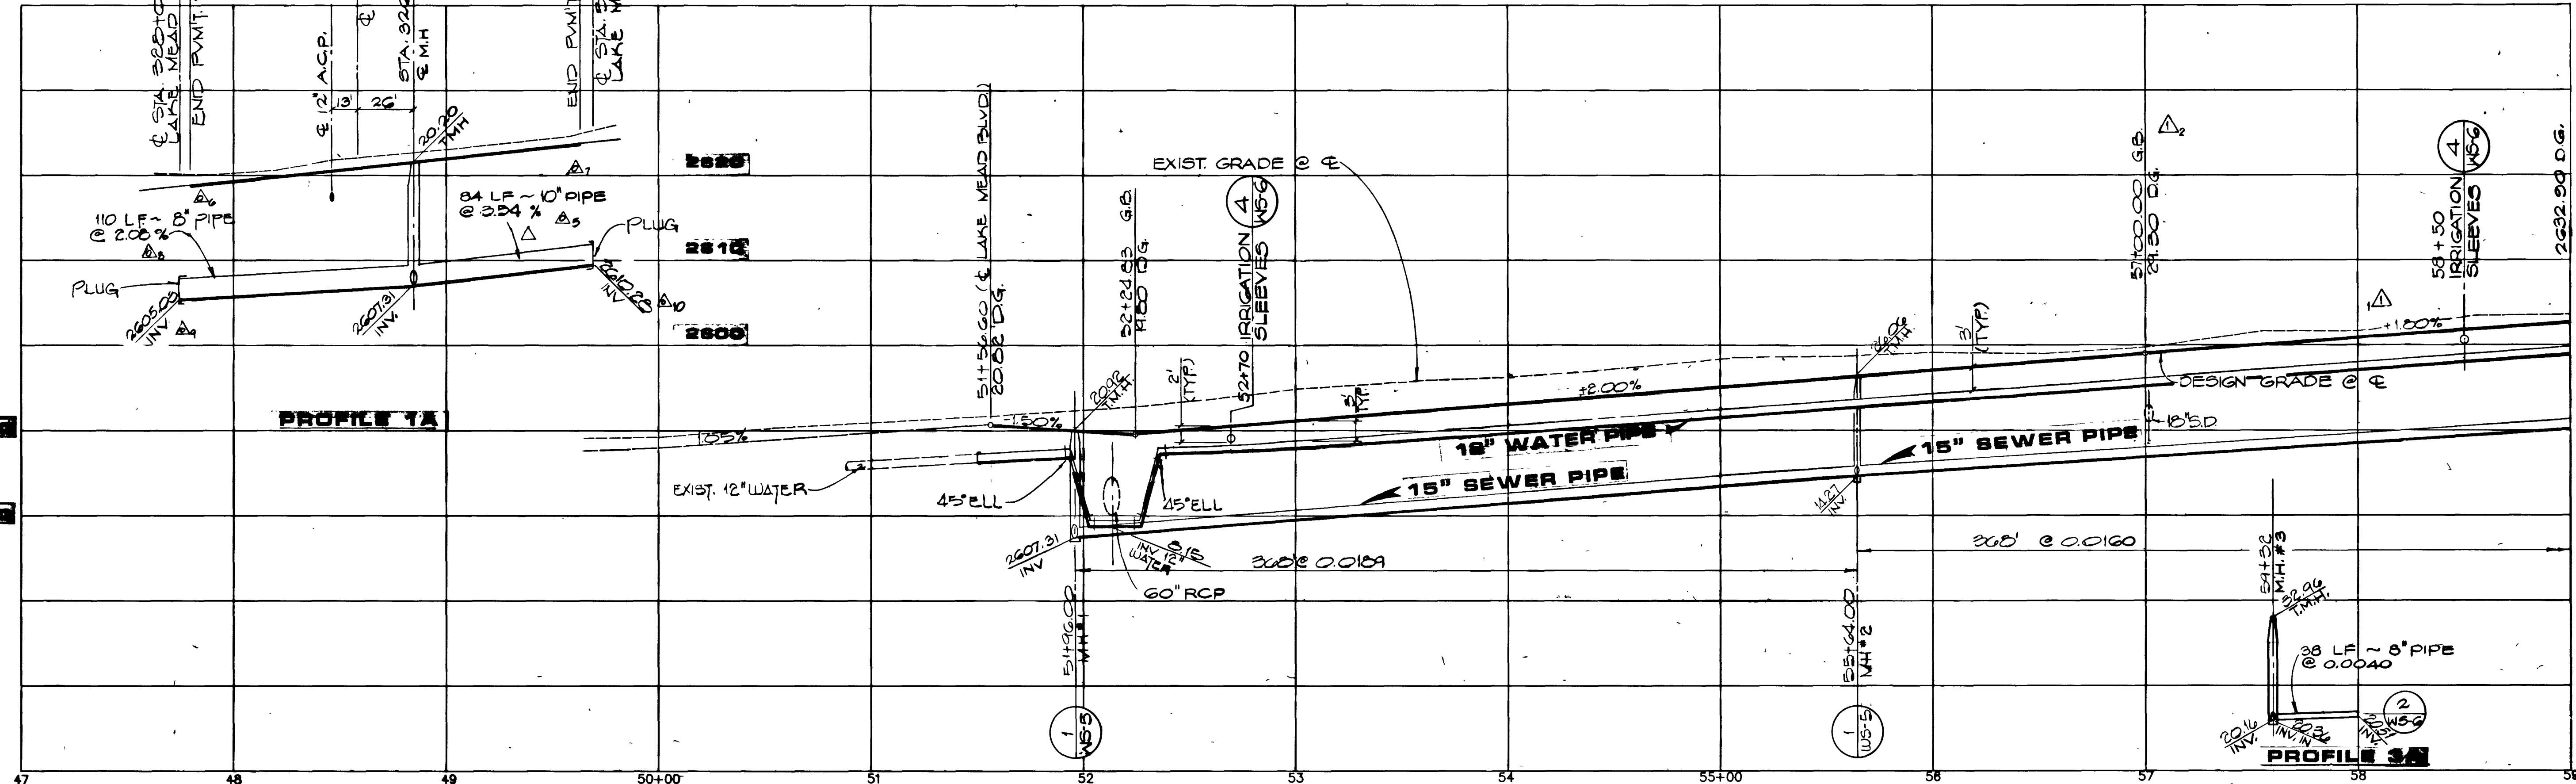

SCALE
 HORIZ. - 1" = 40'
 VERT. - 1" = 10'

APPROVAL
[Signature]
 L.V.V.W.B. DATE 8/24/88

2/12/89

REV	DATE	DESCRIPTION
1	08/24/88	ISSUED PER SCU LETTER
2	08/24/88	ISSUED PER SCU LETTER
RECORD DRAWINGS
 THESE PLANS SHOW RECORD INFORMATION RECEIVED FROM:
 CONTRACTOR: WELLS CARGO INC.
 DATE: 6/19/90
 THIS DATA MAY OR MAY NOT REFLECT THE ACTUAL FIELD LOCATIONS. ALL DATA SHOULD BE CONFIRMED PRIOR TO USE ON DEVELOPMENT OR ENGINEERING PLANS.

HOWARD HUGHES PROPERTIES
 HILLS CENTER DRIVE
 WATER AND SEWER PLAN & PROFILE
 SHEET 76
 OF 25 SHEETS

JOB NO. 880788

694 DIETRICH-POST 60328

1987

11-3-97

107-V1639-1

DEL WEBB
COMMUNITIES

SUN CITY
SUMMERLIN

VILLAGE 1

VILLAGE 7


10' EASEMENT

10' EASEMENT

THIS EASEMENT
SHALL BE USED EXCLUSIVELY FOR
RECREATIONAL PURPOSES.
NO OTHER USES ARE PERMITTED.
NO STRUCTURES, UTILITIES OR
OTHER IMPROVEMENTS SHALL BE
PLACED ON THIS EASEMENT.

TOWN CENTER DRIVE
HALF OF
HILLS CENTER DRIVE

NOTED: ALL EASEMENTS BASED ON
CERTIFICATE OF RECORD.

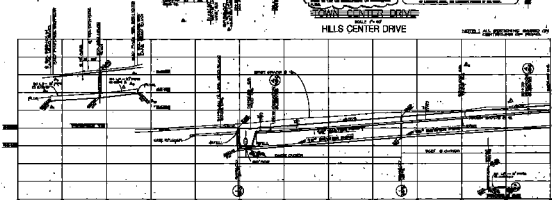

WILLIAMS, INC.