


JOB NO. 680.888

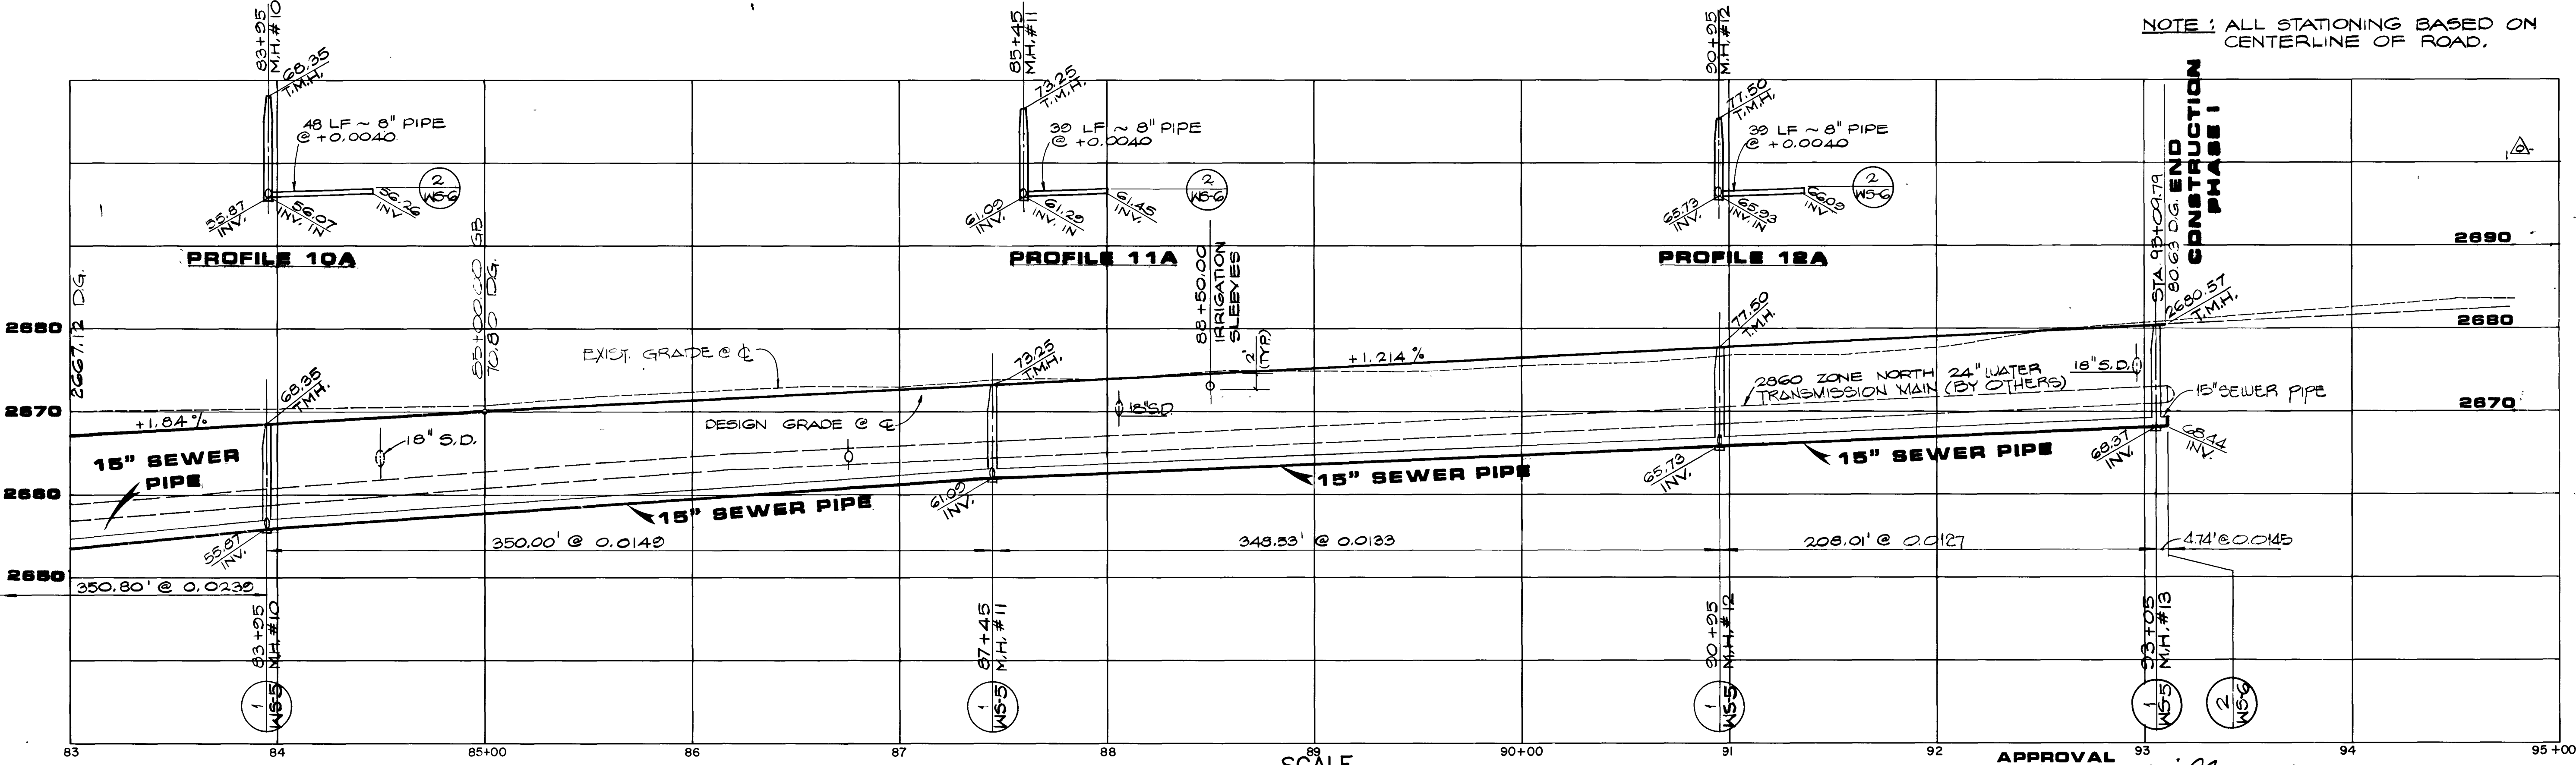

SCALE  
HORIZ. - 1"=40'  
VERT. - 1"=10'


APPROVAL  
*[Signature]*  
L.V.V.W.D. DATE 3/24/88

2/12/89

SHEET 19  
OF 25 SHEETS

CURVE DATA

NO.	Δ	R	L	T	DESCRIPTION
1	3° 14' 47"	2,724.00'	154.35'	77.10'	SEWER
2	4° 22' 31"	2,724.00'	208.01'	104.06'	SEWER
3	7° 43' 18"	2,750.00'	370.61'	185.50'	STREET CENTERLINE

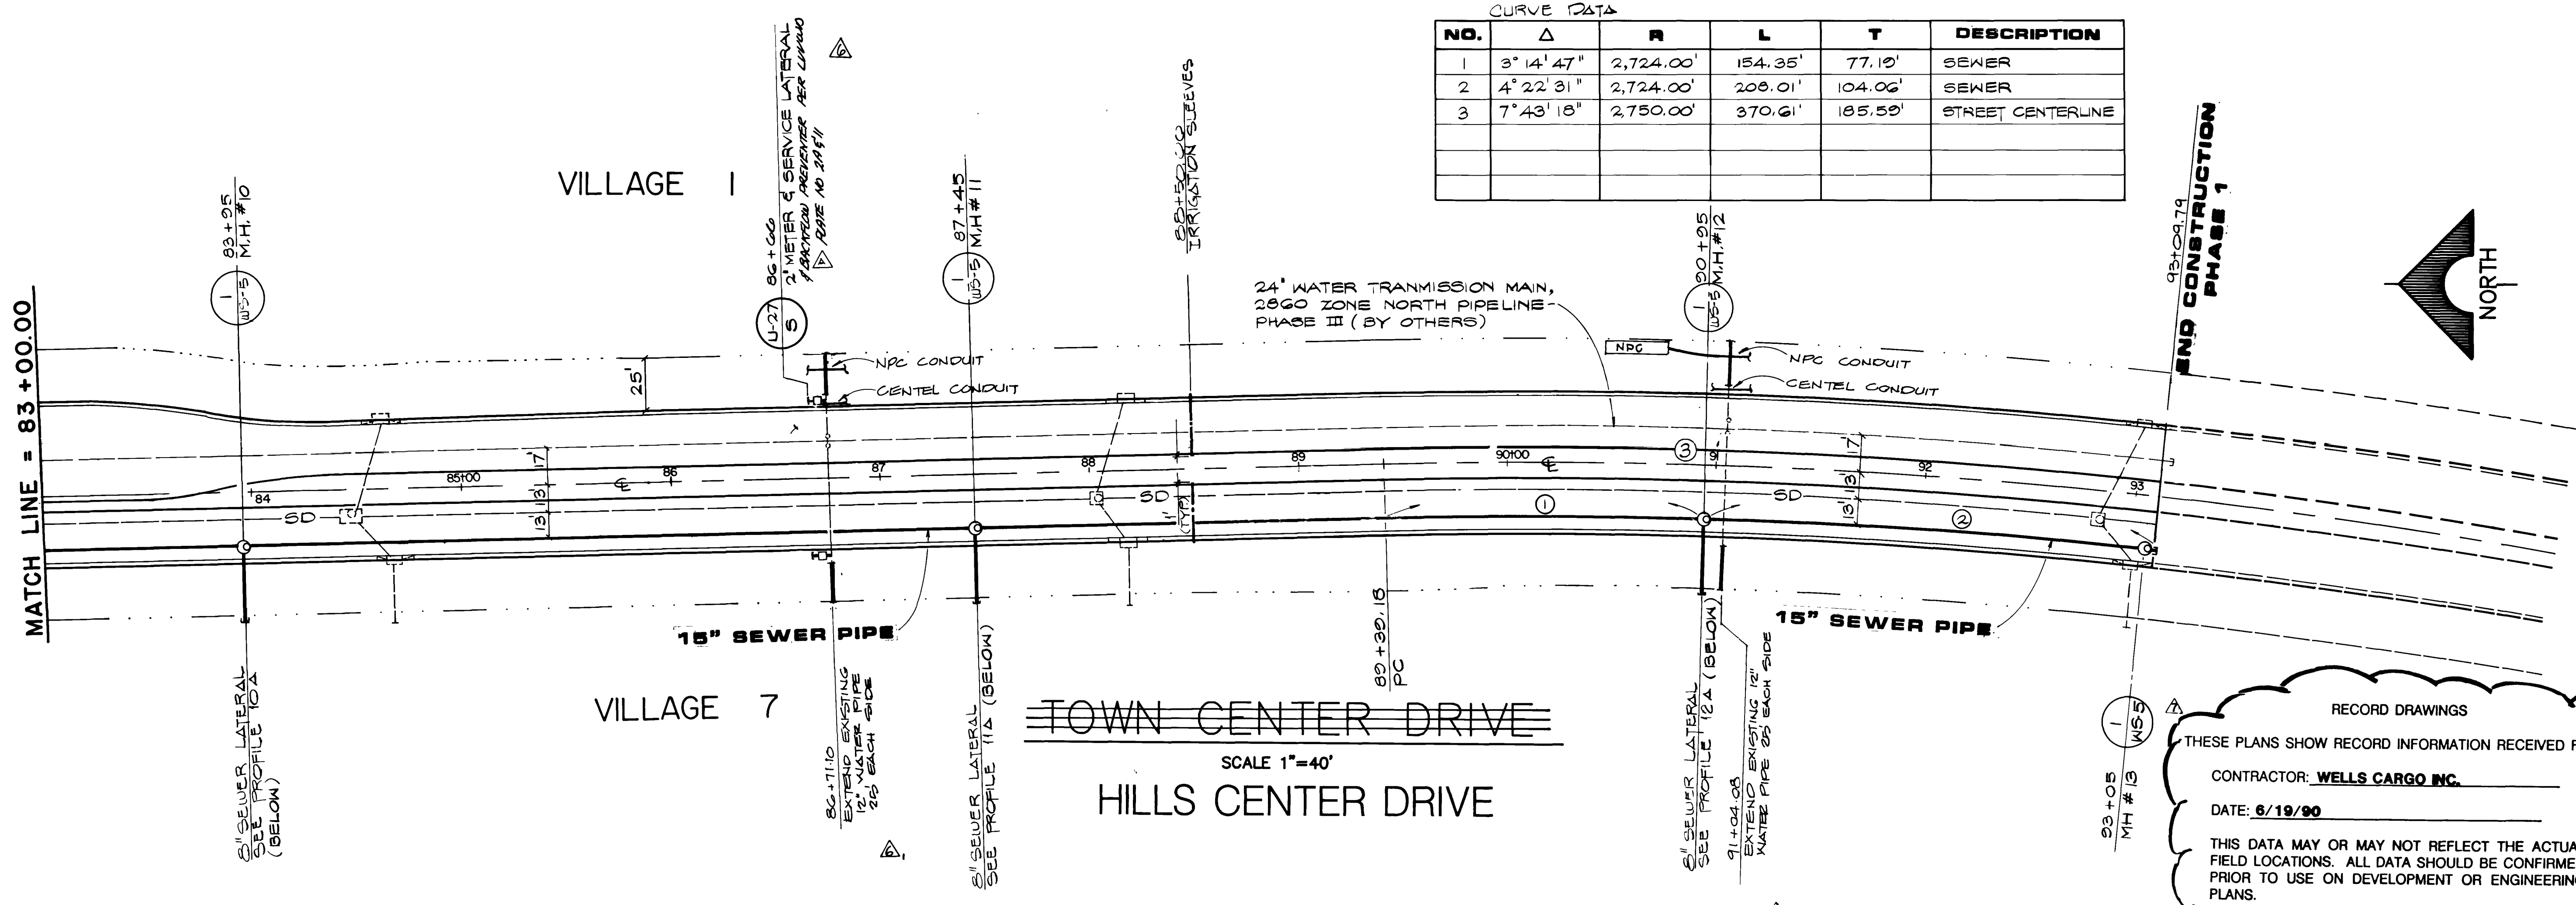

RECORD DRAWINGS  
THESE PLANS SHOW RECORD INFORMATION RECEIVED FROM:  
CONTRACTOR: WELLS CARGO INC.  
DATE: 6/19/90  
THIS DATA MAY OR MAY NOT REFLECT THE ACTUAL FIELD LOCATIONS. ALL DATA SHOULD BE CONFIRMED PRIOR TO USE ON DEVELOPMENT OR ENGINEERING PLANS.

NOTE: THESE PLANS ARE FOR THE PURPOSE OF ROADWAY IMPROVEMENTS AND UTILITIES (PAVEMENT WITH BASE, CURB AND GUTTER, STORM DRAIN, WATER, SEWER, ETC.). ALL ROADWAY AND LANDSCAPE AREAS HAVE BEEN PREVIOUSLY ROUGH GRADED. ANY LIMITS OF ROUGH GRADING SHOWN ARE FOR REFERENCE ONLY. FOR SCOPE AND LIMITS OF ROUGH GRADING, SEE "TOWN CENTER DRIVE - ROUGH GRADING" PACKAGE. FOR FINISH GRADING OF LANDSCAPE AREAS, SEE LANDSCAPE PACKAGE BY SMA GROUP.

NOTE: ALL STATIONING BASED ON CENTERLINE OF ROAD.

REVISIONS

NO.	DATE	DESCRIPTION
1	3/24/88	ISSUED FOR CONSTRUCTION
2	3/24/88	ISSUED FOR CONSTRUCTION
3	3/24/88	ISSUED FOR CONSTRUCTION
4	3/24/88	ISSUED FOR CONSTRUCTION
5	3/24/88	ISSUED FOR CONSTRUCTION

DESIGNER: *[Signature]*  
CHECKED: *[Signature]*  
DATE: 3/24/88

1555 SOUTH RAINBOW BLVD., LAS VEGAS, NEVADA 89102

**G.C. WALLACE, INC.**  
Engineering/Architecture

HOWARD HUGHES PROPERTIES  
HILLS CENTER DRIVE  
WATER AND SEWER PLAN & PROFILES  
STA 83+00.00 TO 95+00.75

SHEET 19  
OF 25 SHEETS

1984

11-3-150 107-11639-1

