



SCALE  
1" = 40' Hor.  
1" = 5' Vert.

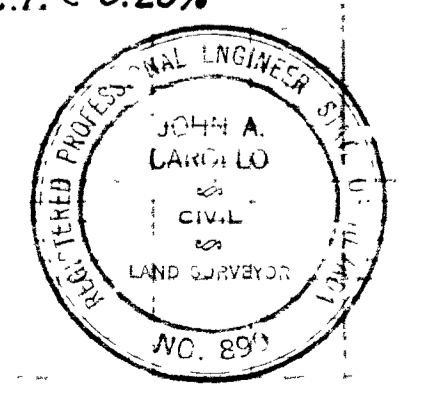

JOHN A. CAROLLO CONSULTING ENGINEERS PHOENIX, ARIZONA			
LAS VEGAS NEVADA			
INTERCEPTOR SEWERS CEDAR AVE. INTERCEPTOR			
DESIGNED G.C.W.	CHECKED G.C.W.	DATE 11-17-59	DRAWING NO. NO. 891
DRAWN G.C.W.	TRACED G.C.W.	REVISED	SHEET NO. 2 of 5

367-W-251

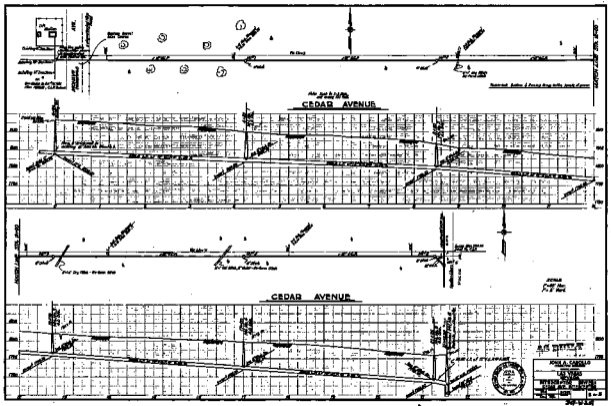

No. 24 & 25  
**CEDAR AVENUE**

**CEDAR AVENUE**

**AS BUILT**  
 JOHN A. CARROLL  
 CIVIL ENGINEER  
 1000 10th Street  
 St. Paul, Minn.  
 1912

