

3+600

CHARLESTON BLVD


3+700

COMMERCE



- LEGEND**
- SIGNAL HEAD
 - SIGNAL HEAD WITH BACKPLATE
 - MAST ARM OVERHEAD SIGNAL WITH BACKPLATE
 - SIGNAL STANDARD
 - No. 3 1/2 TRAFFIC SIGNAL PULL BOX
 - LOOP DETECTOR
 - CONDUIT

<p>Call before you Dig. 1-800-277-2600 <small>UNDERGROUND SERVICE (USA)</small></p>	<p>Call before you Overhead 563-6111 <small>OVERHEAD SERVICE (USA)</small></p>
--	---

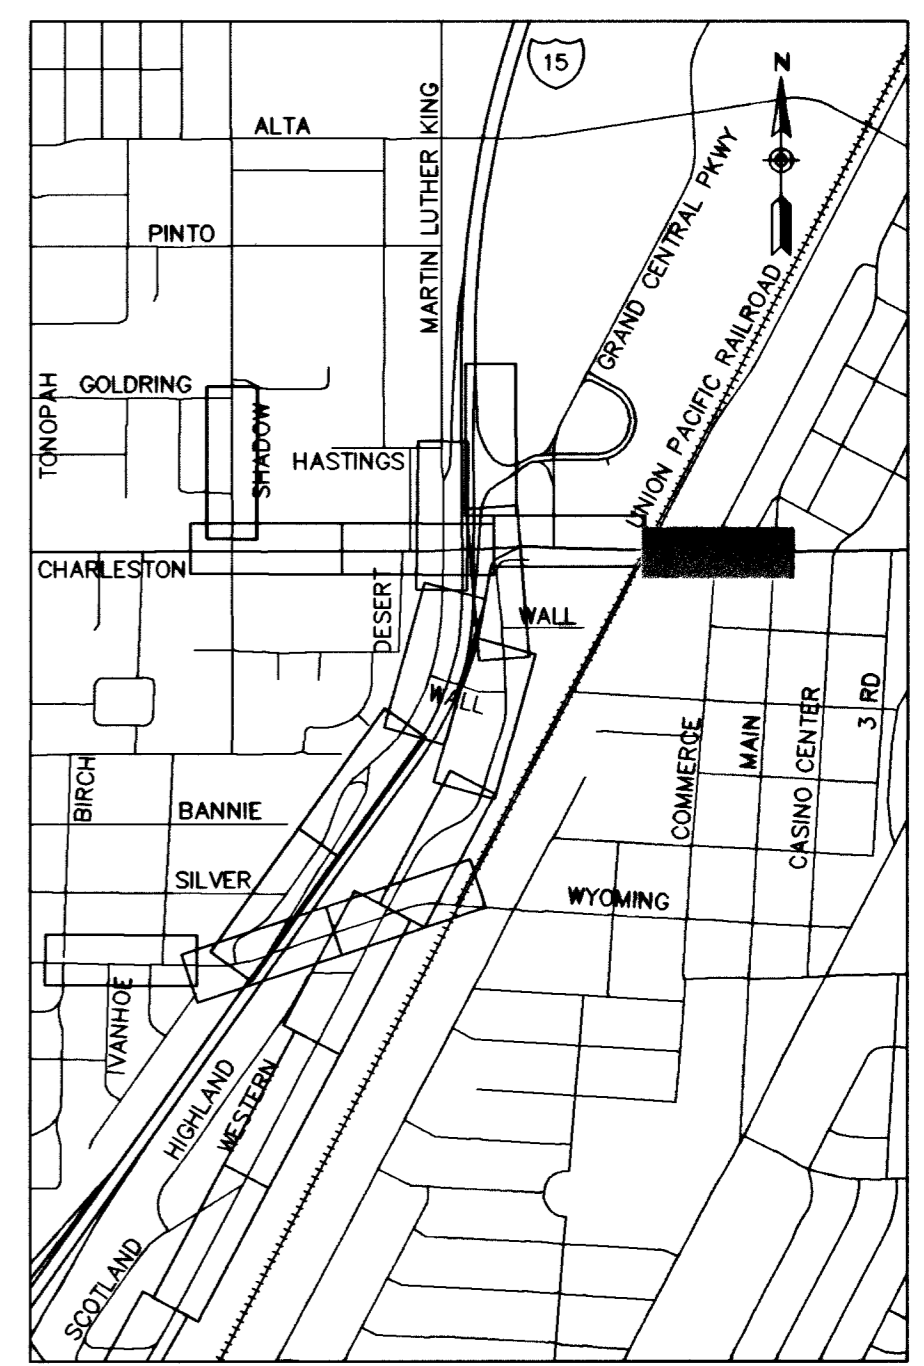

DATE	REVISIONS	PROJECT #	SCALE (V)	DATE	DESIGN BY
4/30/03	RECORD DRAWING	31604	N/A	DEC 17, 1999	KFN
		PARSONS BRINCKERHOFF <small>Las Vegas, Nevada</small>			
<p>DEPARTMENT OF PUBLIC WORKS</p> <p>I-15 FREEWAY CHANNEL SIGNALIZATION PLAN</p> <p>CHARLESTON & COMMERCE</p>					
DRAWING No. T-16					240
RECORD DRAWING METRIC					241