


- LEGEND
- SIGNAL HEAD
 - SIGNAL HEAD WITH BACKPLATE
 - MAST ARM OVERHEAD SIGNAL WITH BACKPLATE
 - SIGNAL STANDARD
 - No. 3 1/2 TRAFFIC SIGNAL PULL BOX
 - LOOP DETECTOR
 - CONDUIT

Call before you Dig.
1-800-277-2600
UNDERGROUND SERVICE (USA)


Call before you Overhead
563-6111
OVERHEAD SERVICE (USA)

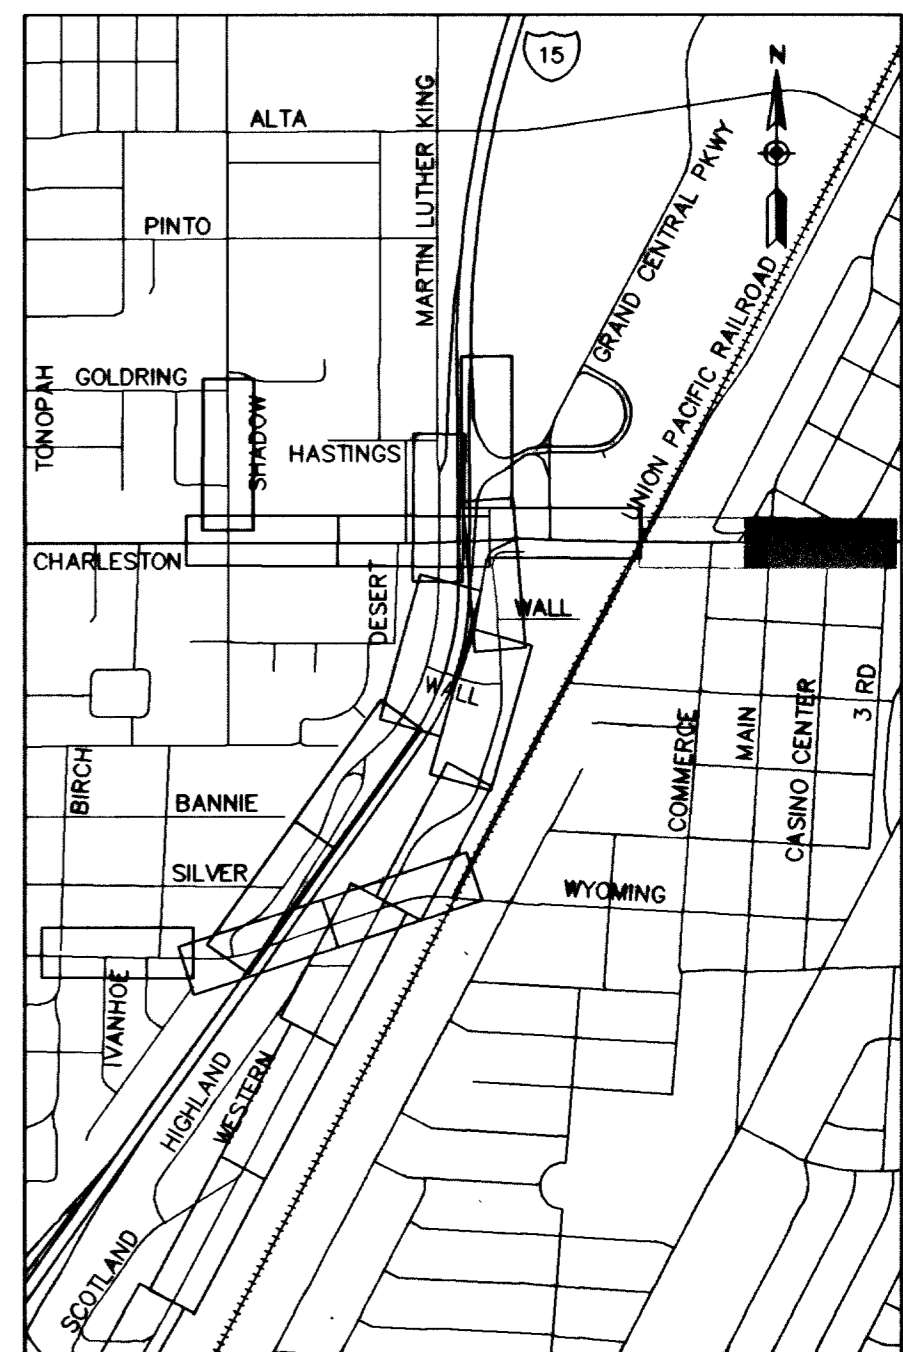


RECORD DRAWING METRIC

DATE	REVISIONS
4/20/03	RECORD DRAWING

SCALE (H) 1:200	SCALE (V) N/A	PROJECT # 31604
F.L.D. Bk. # N/A	DATE DEC 17, 1999	DESIGN BY KFN

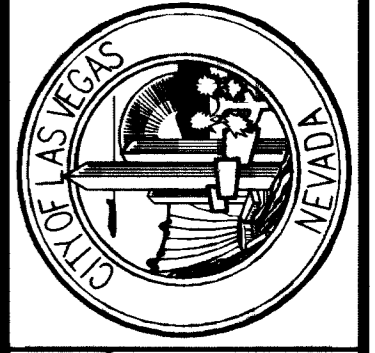

DEPARTMENT OF PUBLIC WORKS
I-15 FREEWAY CHANNEL
SIGNALIZATION PLAN
CHARLESTON & MAIN/CASINO CENTER

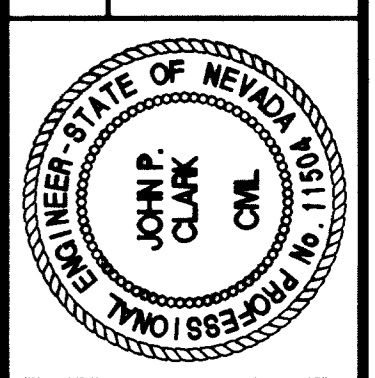

DRAWING No. 241
T-17

327-V254