
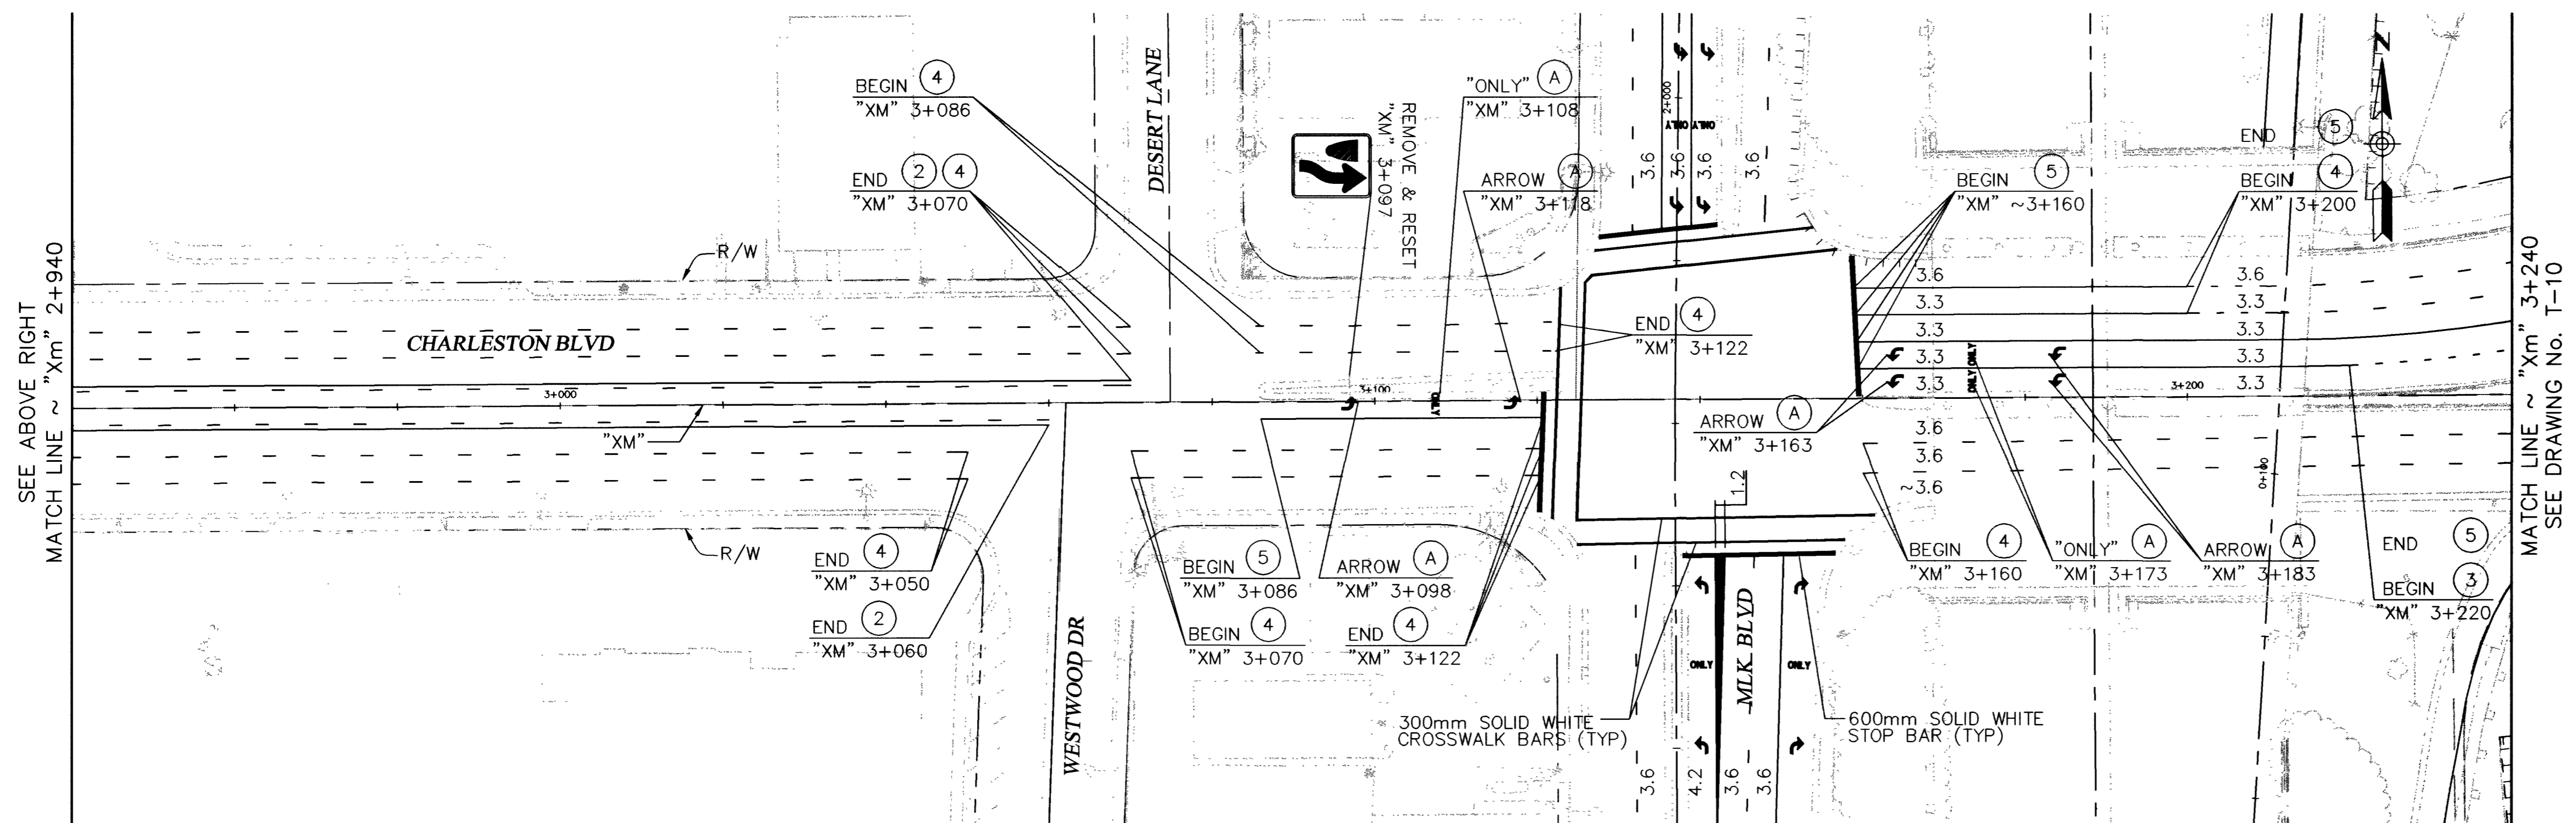



PERMANENT PAVEMENT DELINEATION LEGEND

- ① TYPE 1 CENTERLINE PER CCPW USD DWG 244
- ② TYPE 2 CENTERLINE PER CCPW USD DWG 244
- ③ DROP LANE LINE PER CCPW USD DWG 246A
- ④ TYPE 4 LANE LINE PER CCPW USD DWG 244A
- ⑤ STORAGE LANE LINE PER CCPW USD DWG 246A
- Ⓐ INSTALL "ARROWS", "ONLY", & "STOP" USING TYPE 2 MARKING FILM

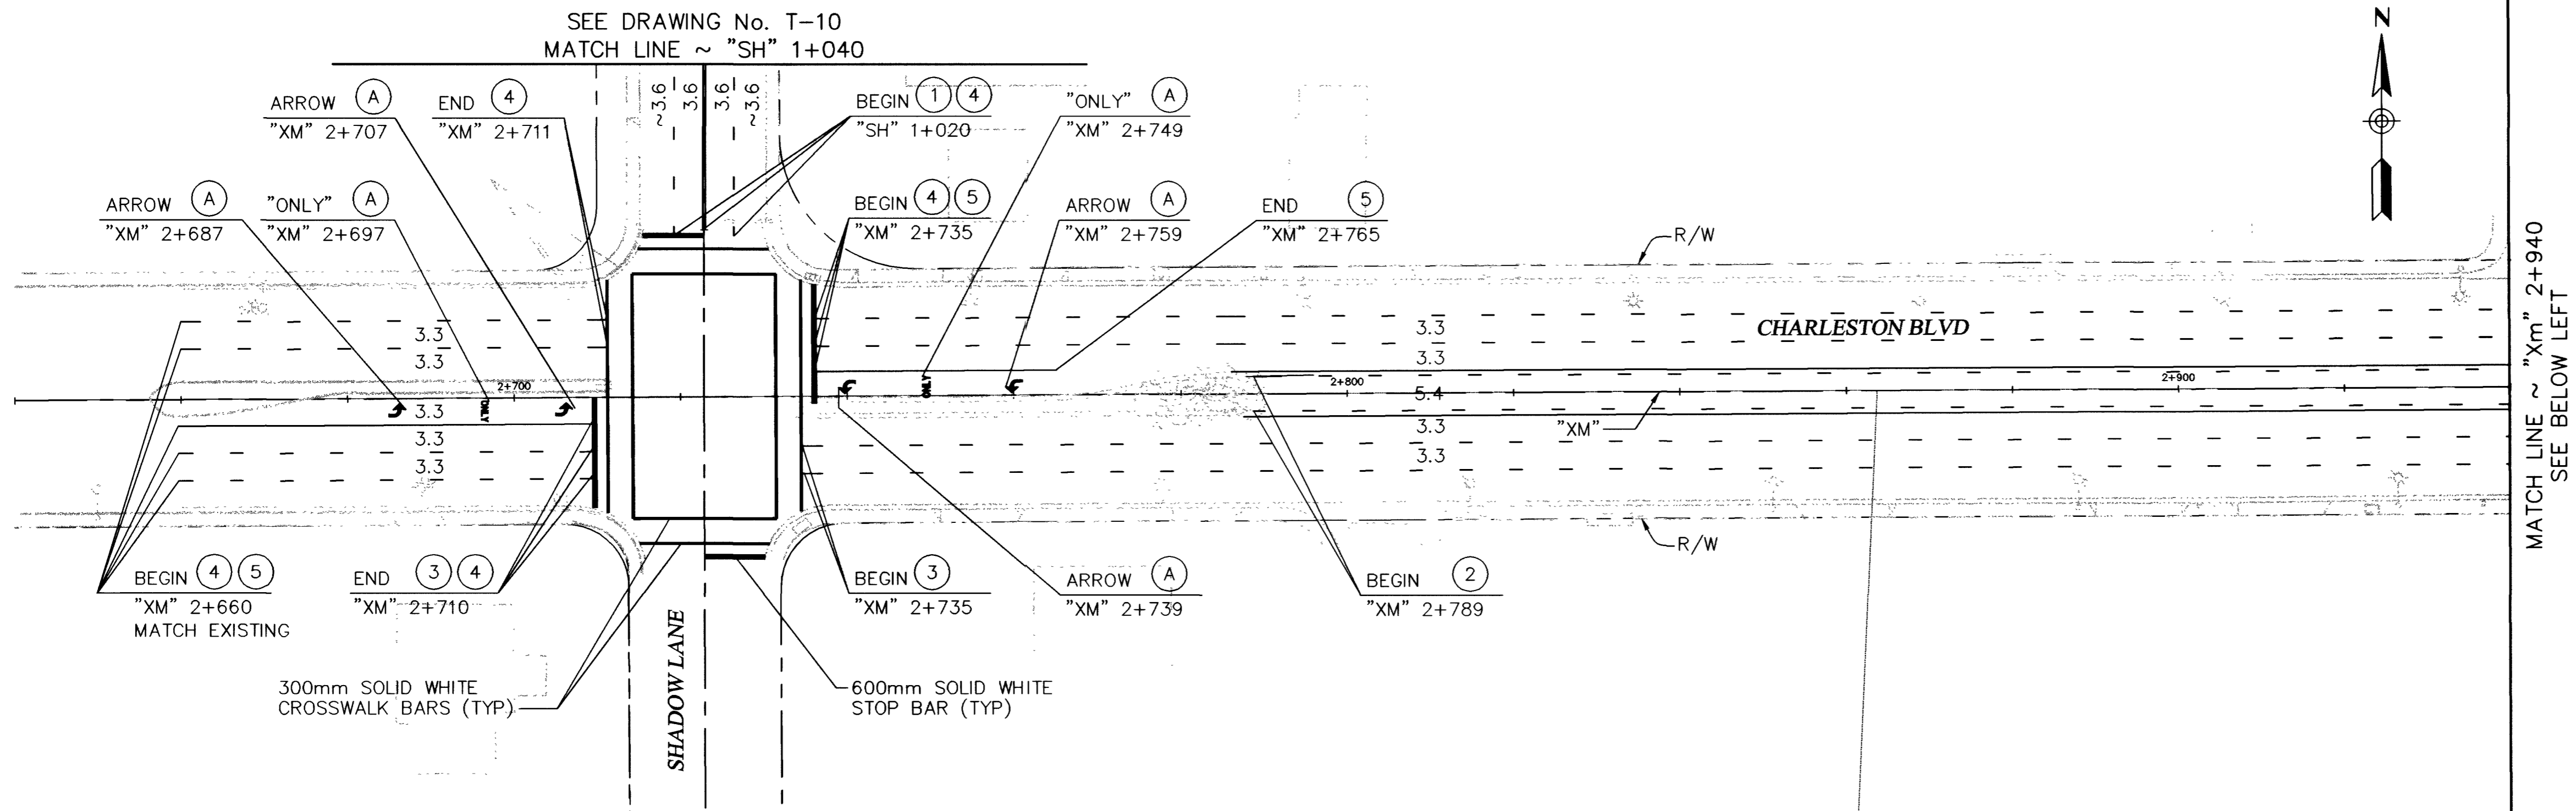


Call before you Dig. 1-800-277-2600 UNDERGROUND SERVICE (USA)

Call before you Overhead 563-6111 OVERHEAD SERVICE (USA)

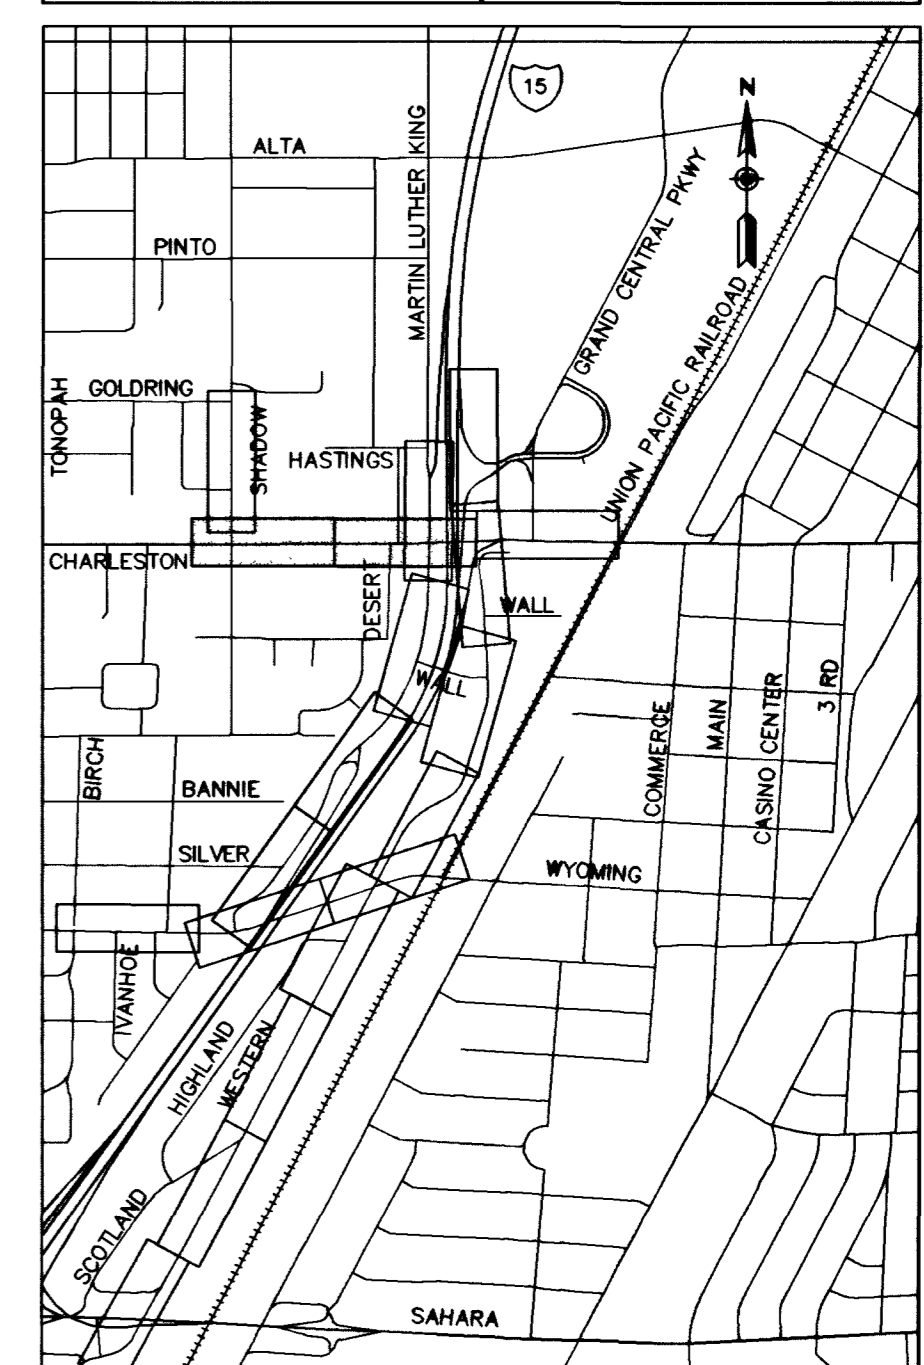

DATE	REVISIONS
4/30/03	RECORD DRAWING

SCALE (H)	SCALE (V)	PROJECT #	DESIGN BY
1:500	N/A	31864	KFN
FLD. Bk. #	DATE	DATE	DATE
N/A	N/A	DEC 17, 1999	

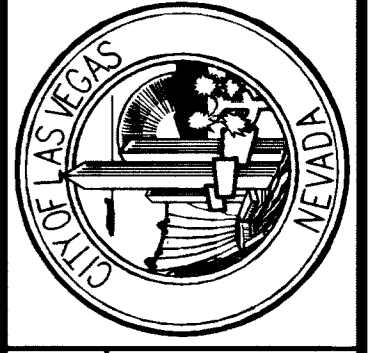


DEPARTMENT OF PUBLIC WORKS

I-15 FREEWAY CHANNEL

SIGNING AND STRIPING PLAN

"Xm" 2+660 TO "Xm" 3+240

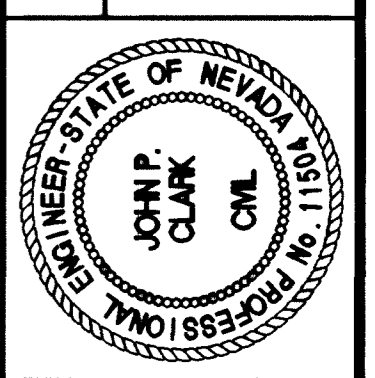

DRAWING No. 233

T-9