
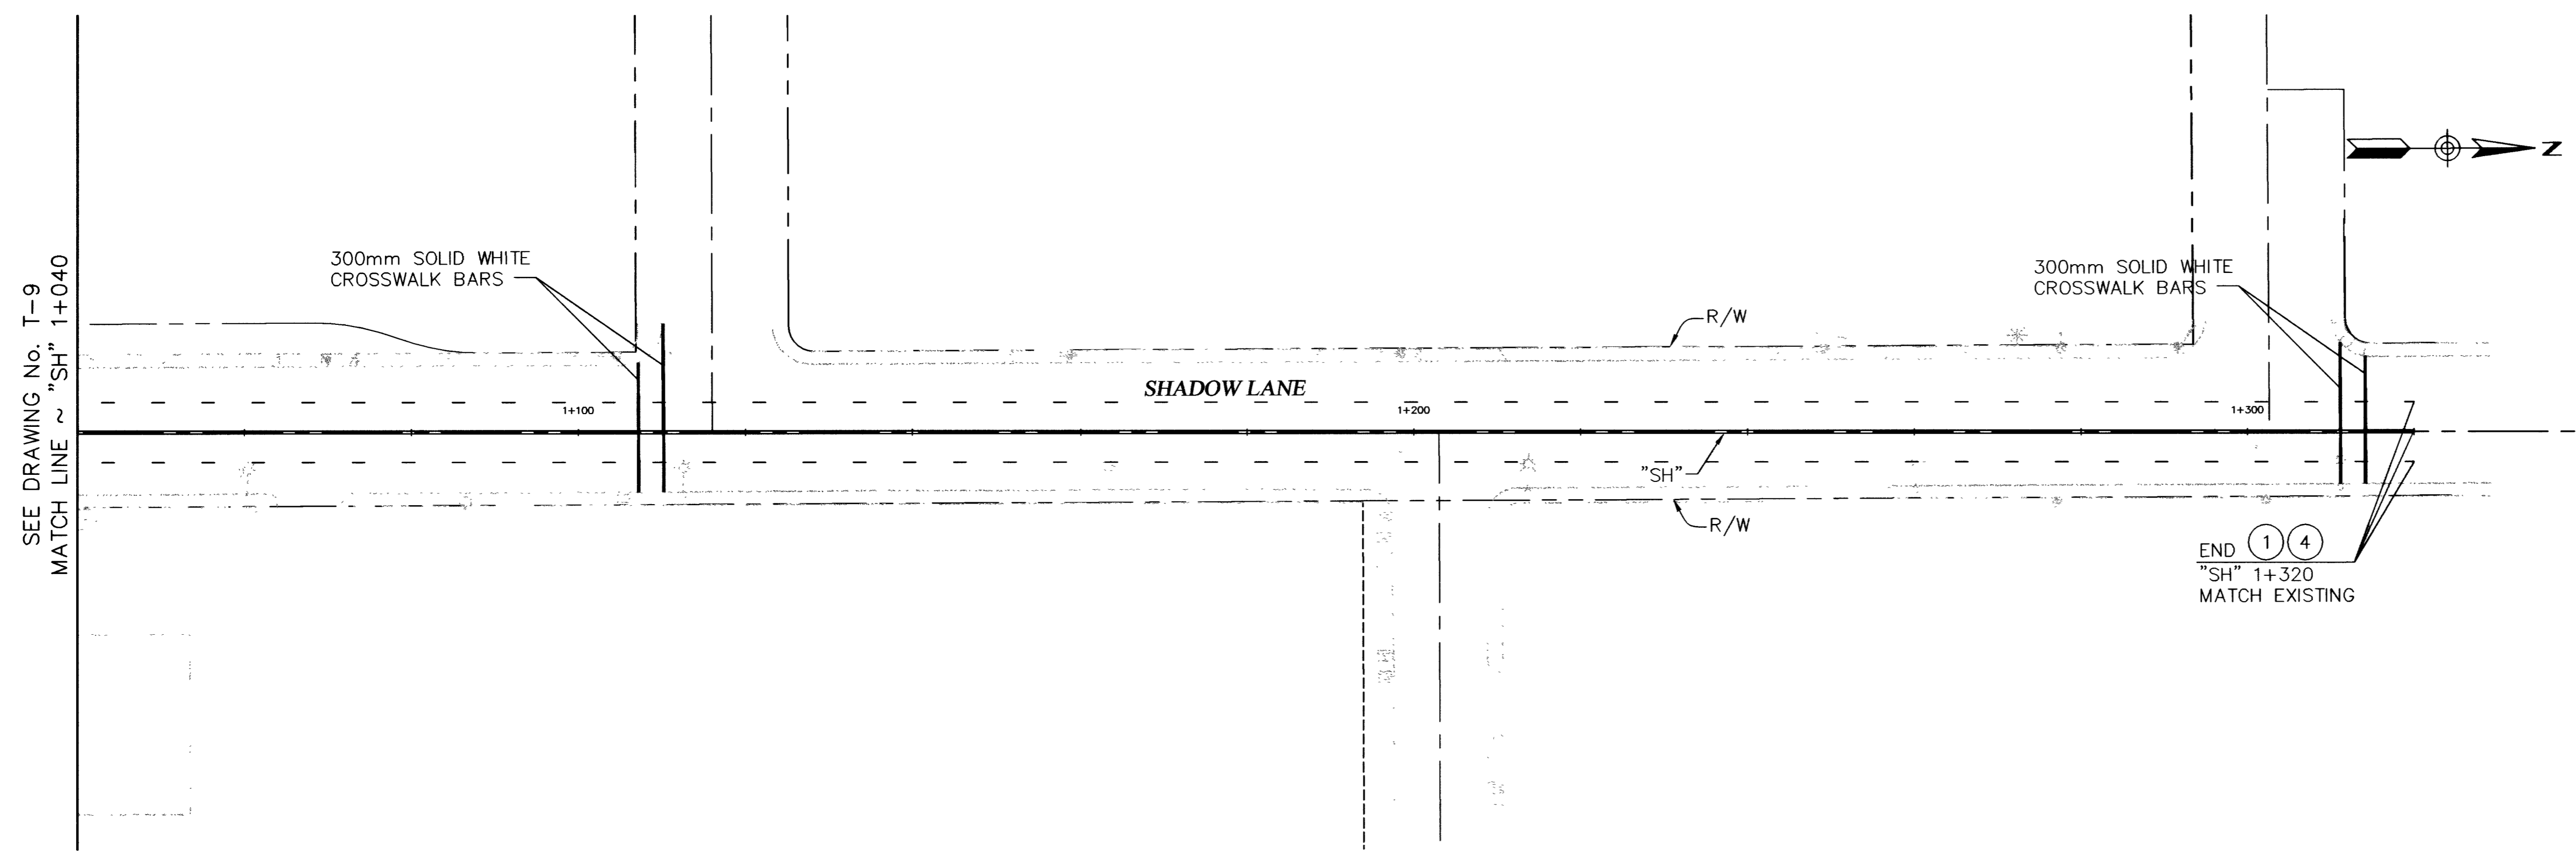



PERMANENT PAVEMENT DELINEATION LEGEND

- ① TYPE 1 CENTERLINE PER CCPW USD DWG 244
- ② STORAGE LANE LINE PER CCPW USD DWG 246A
- ③ DROP LANE LINE PER CCPW USD DWG 246A
- ④ TYPE 4 CENTERLINE PER CCPW USD DWG 244
- Ⓐ INSTALL "ARROWS", "ONLY", & "STOP" USING TYPE 2 MARKING FILM

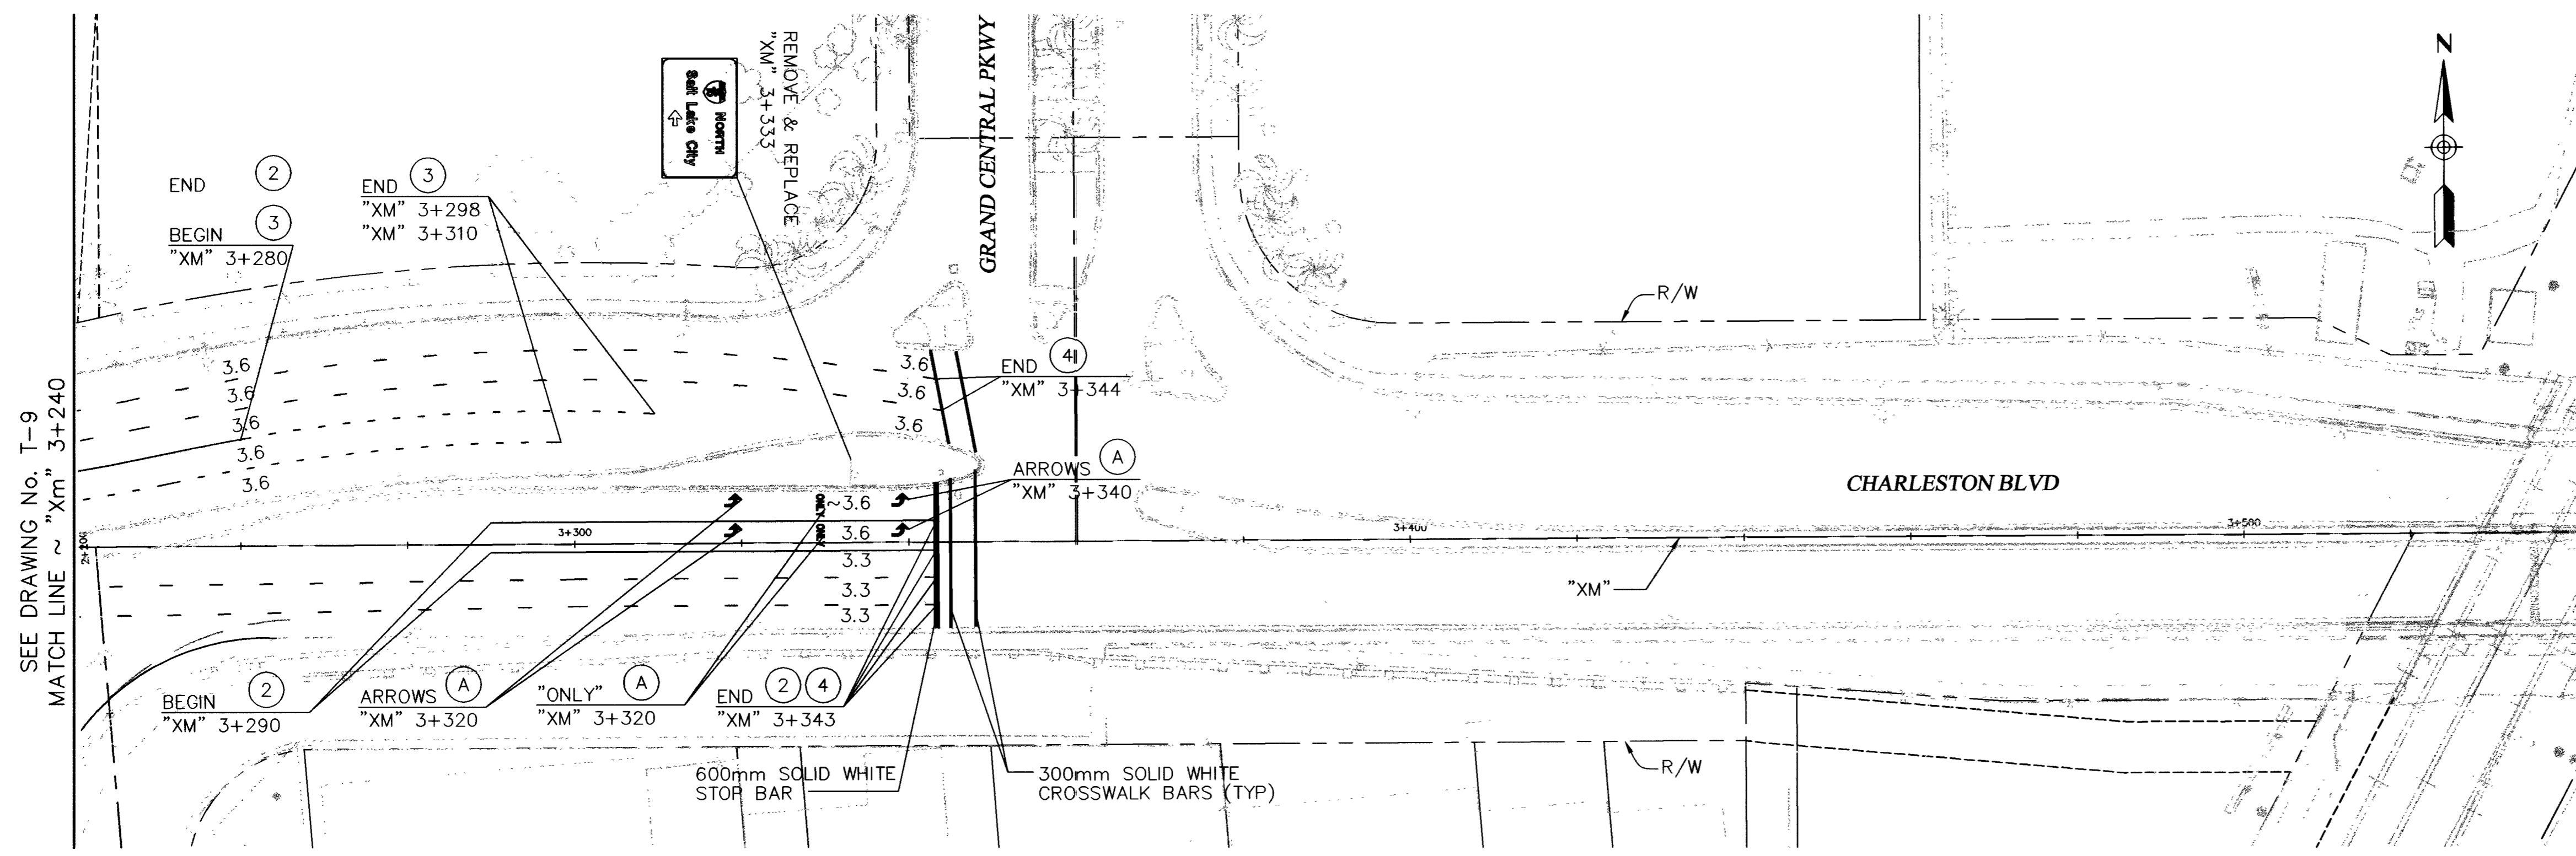

Call before you Dig. 1-800-277-2600 UNDERGROUND SERVICE (USA)

Call before you Overhead 563-6111 OVERHEAD SERVICE (USA)

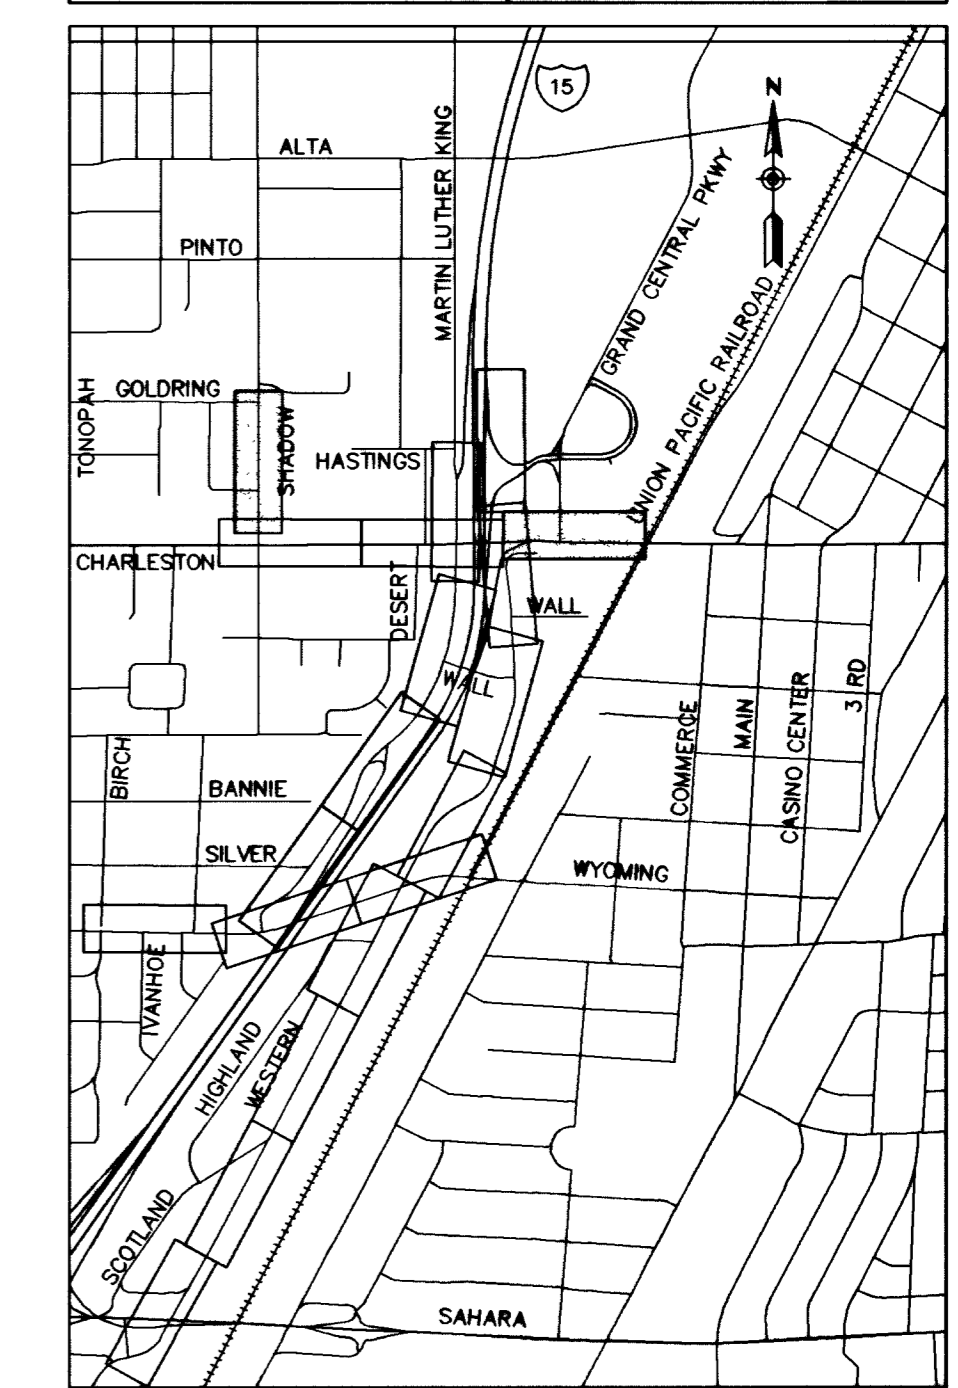

DATE	1/20/03
REVISIONS	
RECORD DRAWING	
PROJECT #	31604
SCALE (V)	N/A
SCALE (H)	1:500
DATE	DEC 17, 1999
DESIGN BY	KFN
F.L.D. BK. #	N/A

PARSONS BRINCKERHOFF
Las Vegas, Nevada

STATE OF NEVADA
REGISTERED PROFESSIONAL ENGINEER
JOHN CLARK
CIVIL
LICENSE NO. 10001

DEPARTMENT OF PUBLIC WORKS
I-15 FREEWAY CHANNEL
SIGNING AND STRIPING PLAN
"Xm" 3+240 AND "SH" 0+940

DRAWING No. 234
T-10
241