
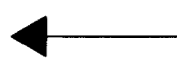
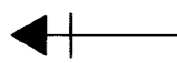



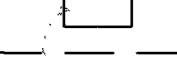
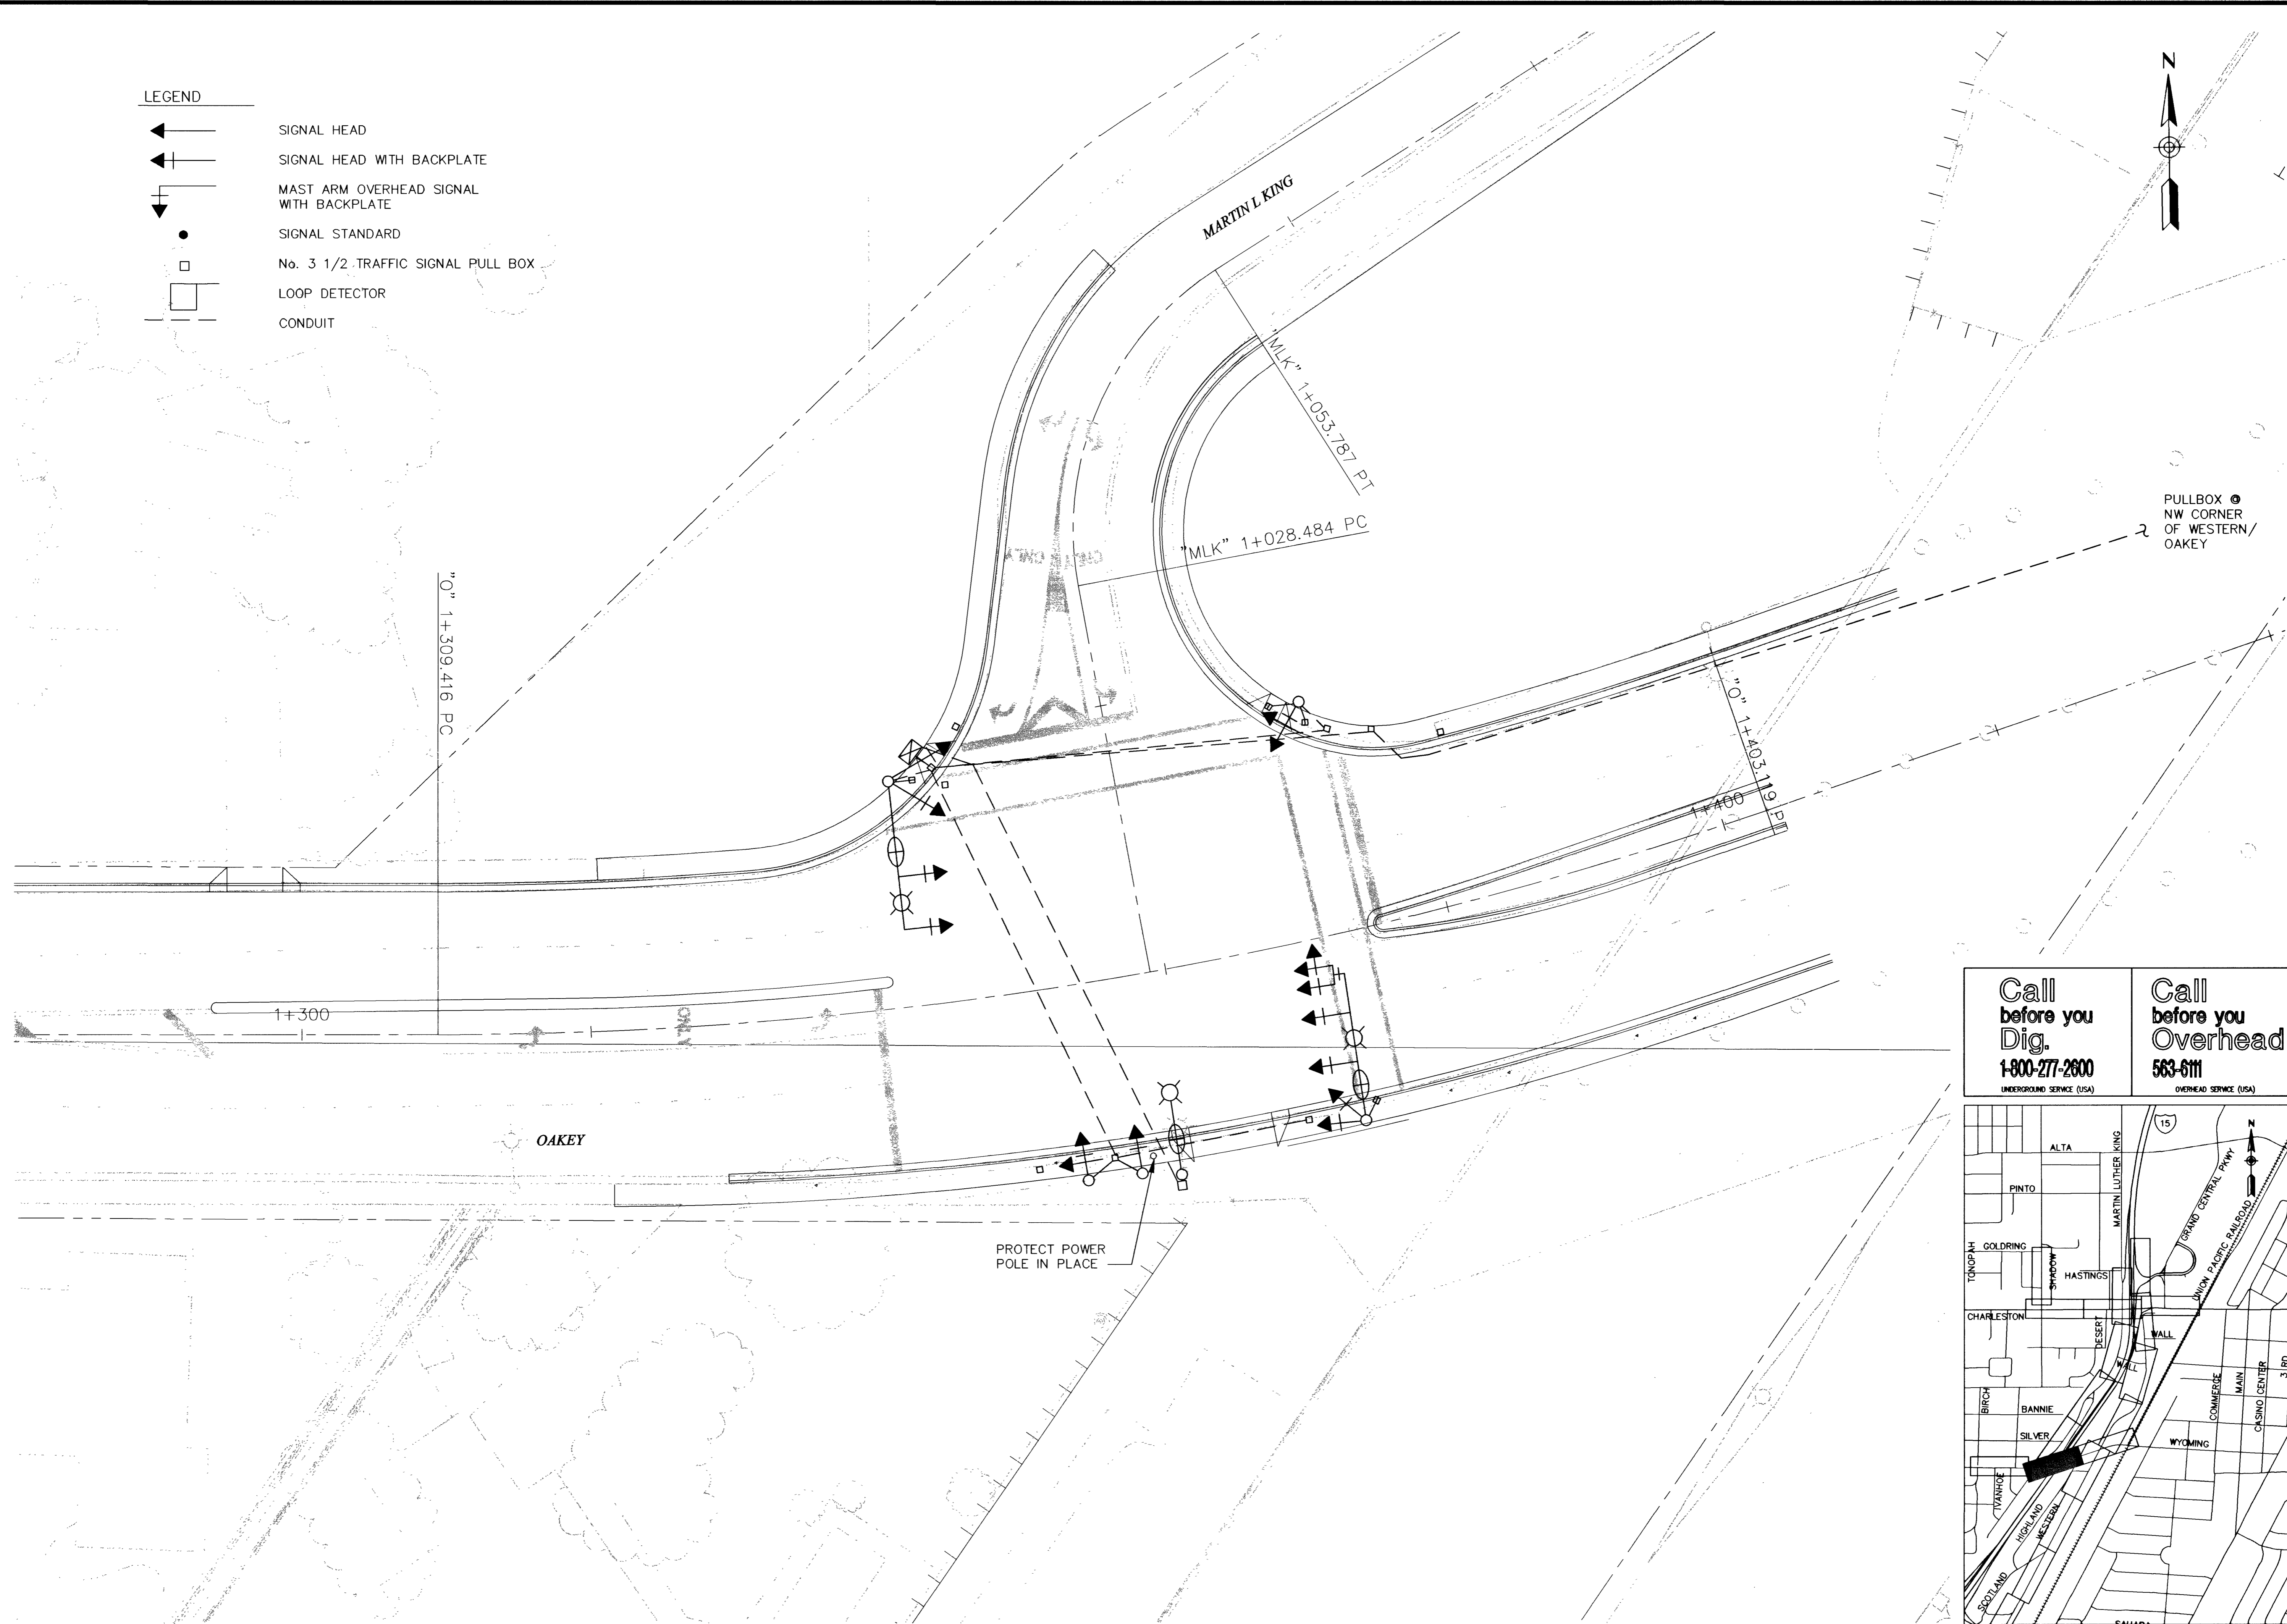


LEGEND


-  SIGNAL HEAD
-  SIGNAL HEAD WITH BACKPLATE
-  MAST ARM OVERHEAD SIGNAL WITH BACKPLATE
-  SIGNAL STANDARD
-  No. 3 1/2 TRAFFIC SIGNAL PULL BOX
-  LOOP DETECTOR
-  CONDUIT

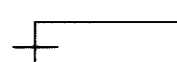

PULLBOX ●  
NW CORNER  
OF WESTERN/  
OAKEY

Call before you Dig.  
1-800-277-2600  
UNDERGROUND SERVICE (USA)

Call before you Overhead  
563-6111  
OVERHEAD SERVICE (USA)

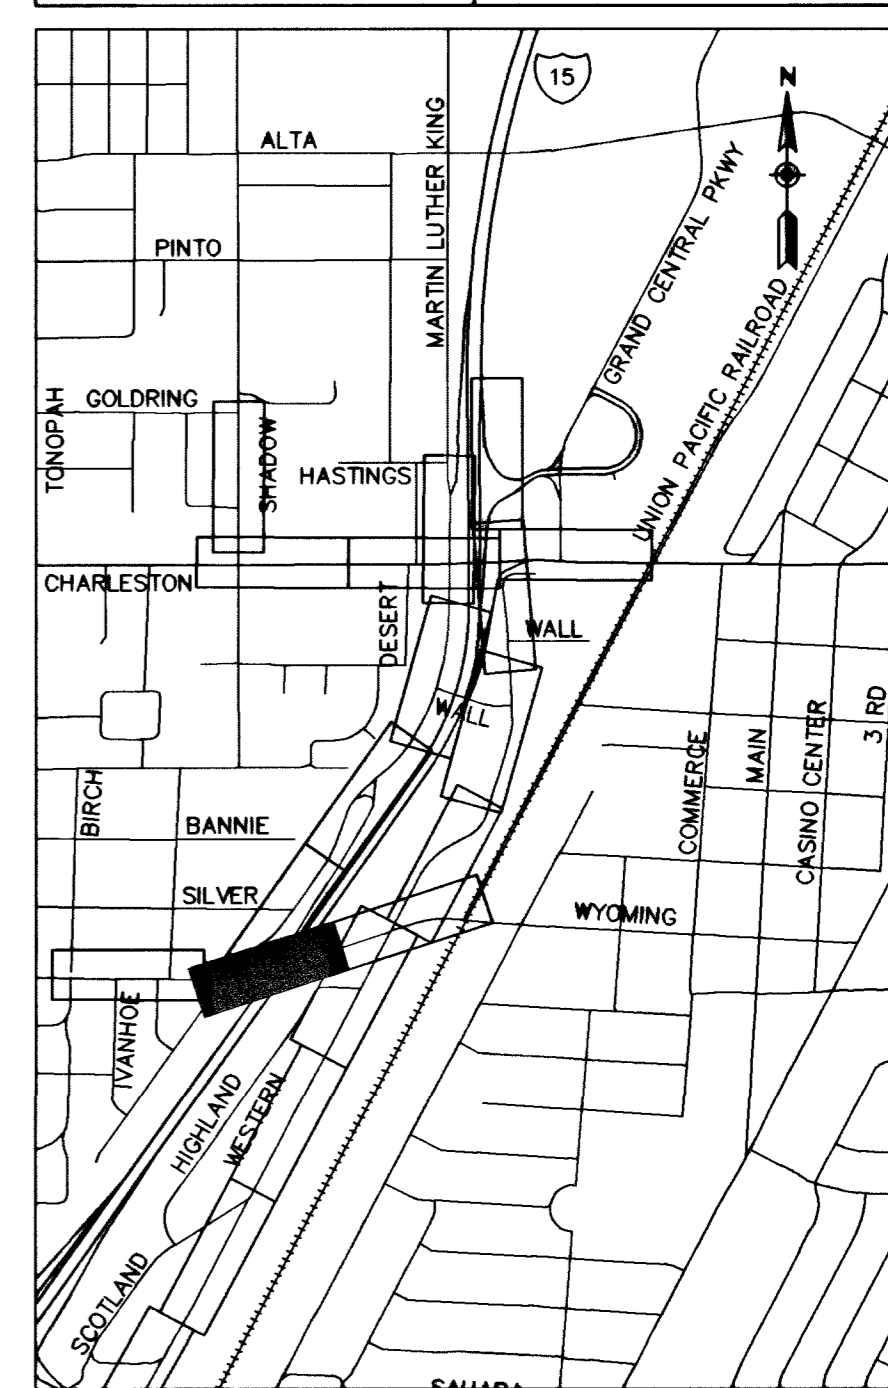


DATE	REVISIONS
4/20/03	RECORD DRAWING

SCALE (H)	SCALE (V)	PROJECT #	DESIGN BY
1:200	N/A	31604	KFN
F.L.D. Bk. #	DATE	DATE	DATE
N/A	DEC 17, 1999	DEC 17, 1999	DEC 17, 1999



**DEPARTMENT OF PUBLIC WORKS**  
I-15 FREEWAY CHANNEL  
SIGNALIZATION PLAN  
OAKEY & MARTIN LUTHER KING

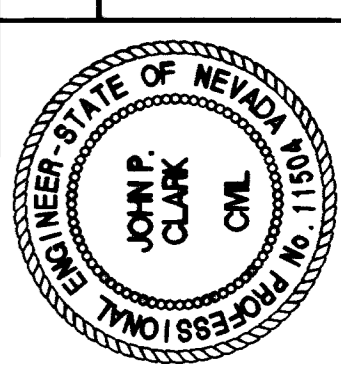

DRAWING No. 235  
**T-11**

**RECORD DRAWING METRIC**

52692