


LEGEND


- ← SIGNAL HEAD
- ←+ SIGNAL HEAD WITH BACKPLATE
- └─ MAST ARM OVERHEAD SIGNAL WITH BACKPLATE
- SIGNAL STANDARD
- No. 3 1/2 TRAFFIC SIGNAL PULL BOX
- LOOP DETECTOR
- CONDUIT

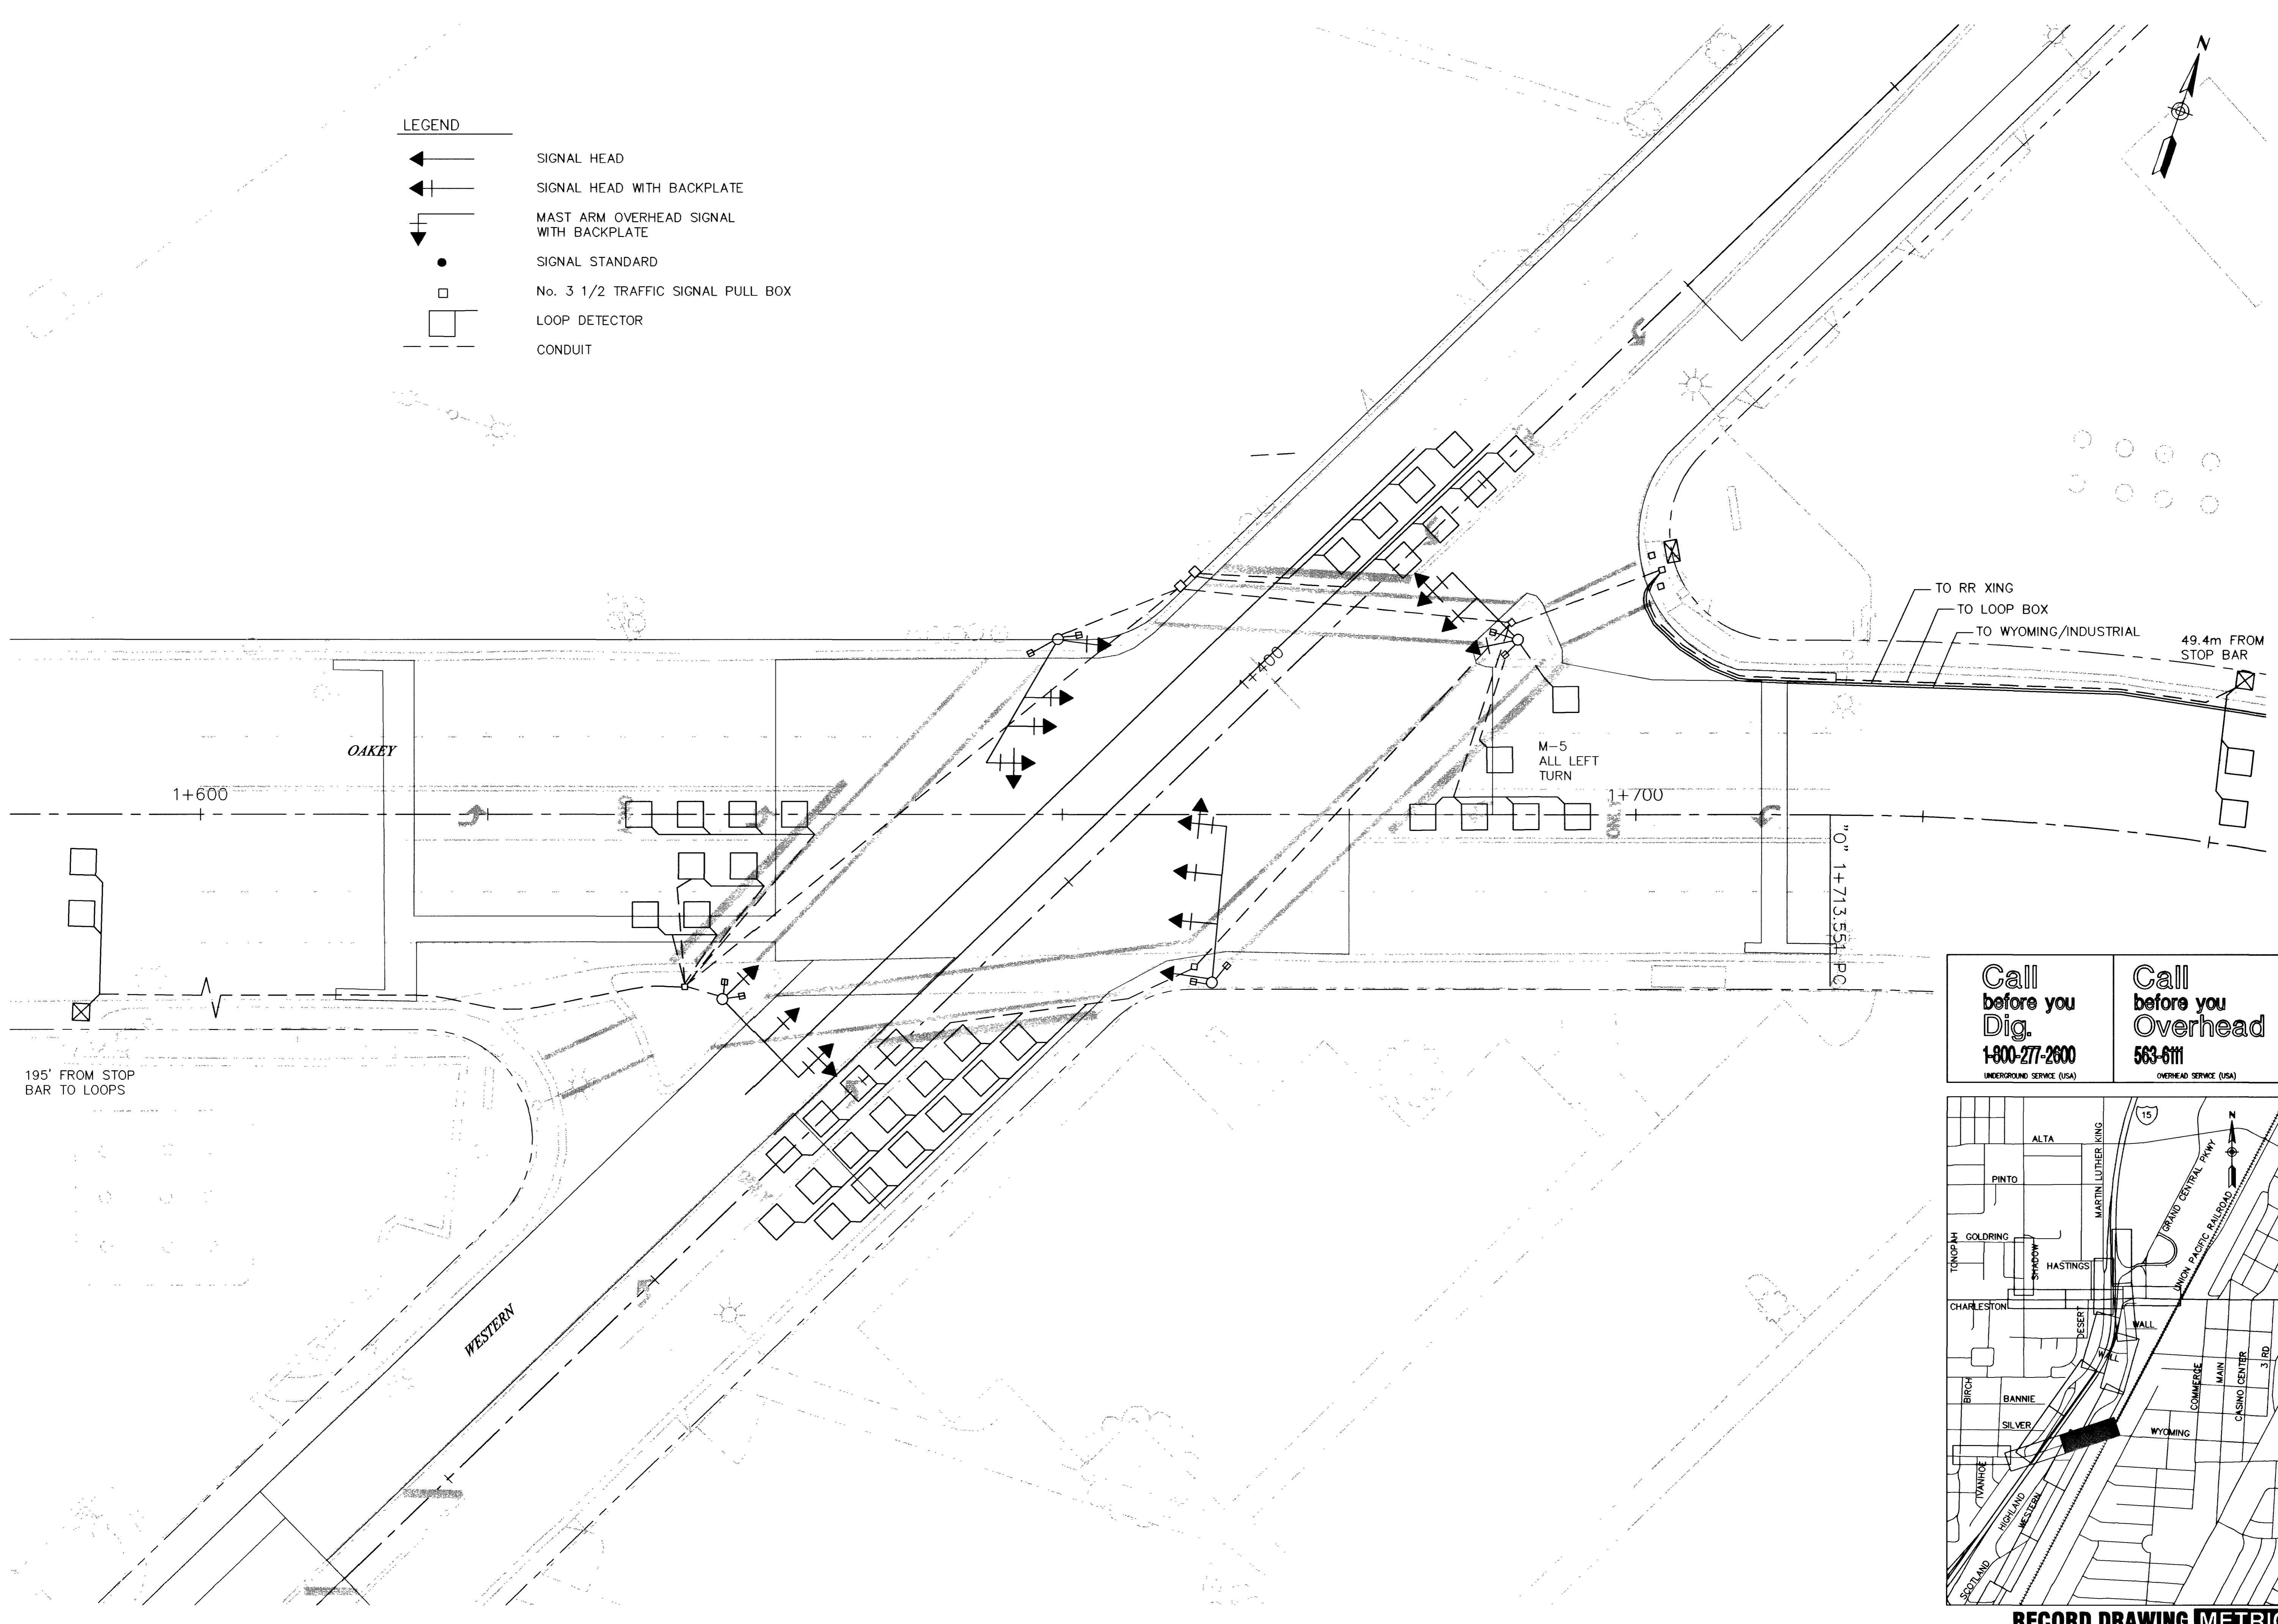

195' FROM STOP BAR TO LOOPS


**Call before you Dig.**  
1-800-277-2600  
UNDERGROUND SERVICE (USA)

**Call before you Overhead**  
563-6111  
OVERHEAD SERVICE (USA)

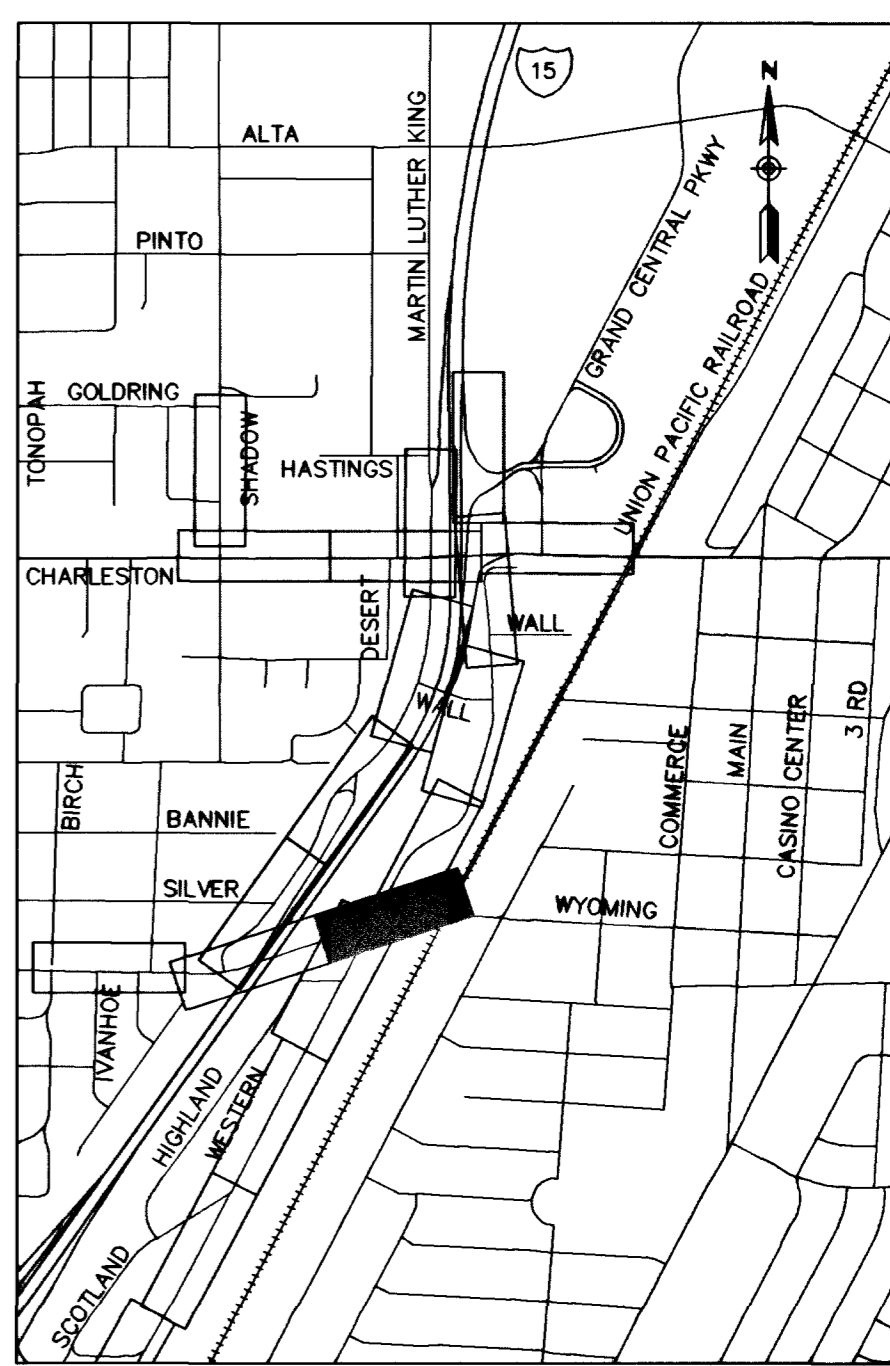


DATE	REVISIONS
7/20/03	RECORD DRAWING

SCALE (H)	1:200	SCALE (V)	N/A	PROJECT #	31604
F.L.D. Bk. #	N/A	DATE	DEC 17, 1999	DESIGN BY	KFN

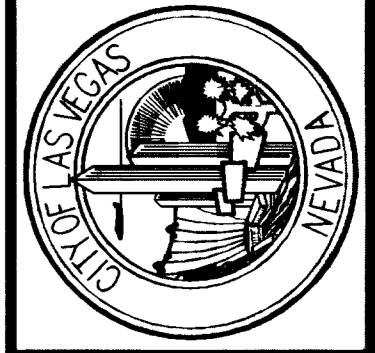

**DEPARTMENT OF PUBLIC WORKS**  
I-15 FREEWAY CHANNEL  
SIGNALIZATION PLAN  
OAKLEY & WESTERN

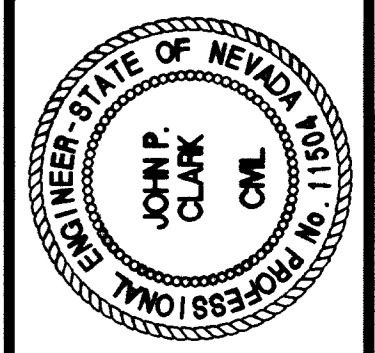

DRAWING No. 236  
**T-12**  
241

**RECORD DRAWING METRIC**

52693

