


REVISIONS	DATE
RECORD DRAWING	4/30/03

SCALE (H) N/A	SCALE (V) N/A	PROJECT # 31604
F.L.D. BK. # N/A	DATE DEC 17, 1999	DESIGN BY DWR



DEPARTMENT OF PUBLIC WORKS
 I-15 FREEWAY CHANNEL
 TRAFFIC DETOUR PLAN FOR
 WALL STREET CLOSURE

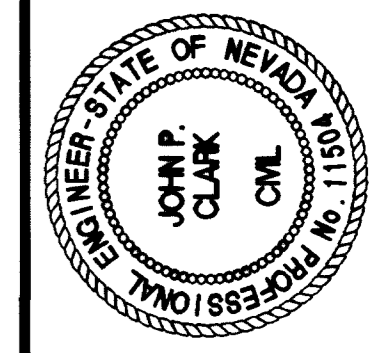

DRAWING No. 209
 TC-2 241

RECORD DRAWING METRIC